


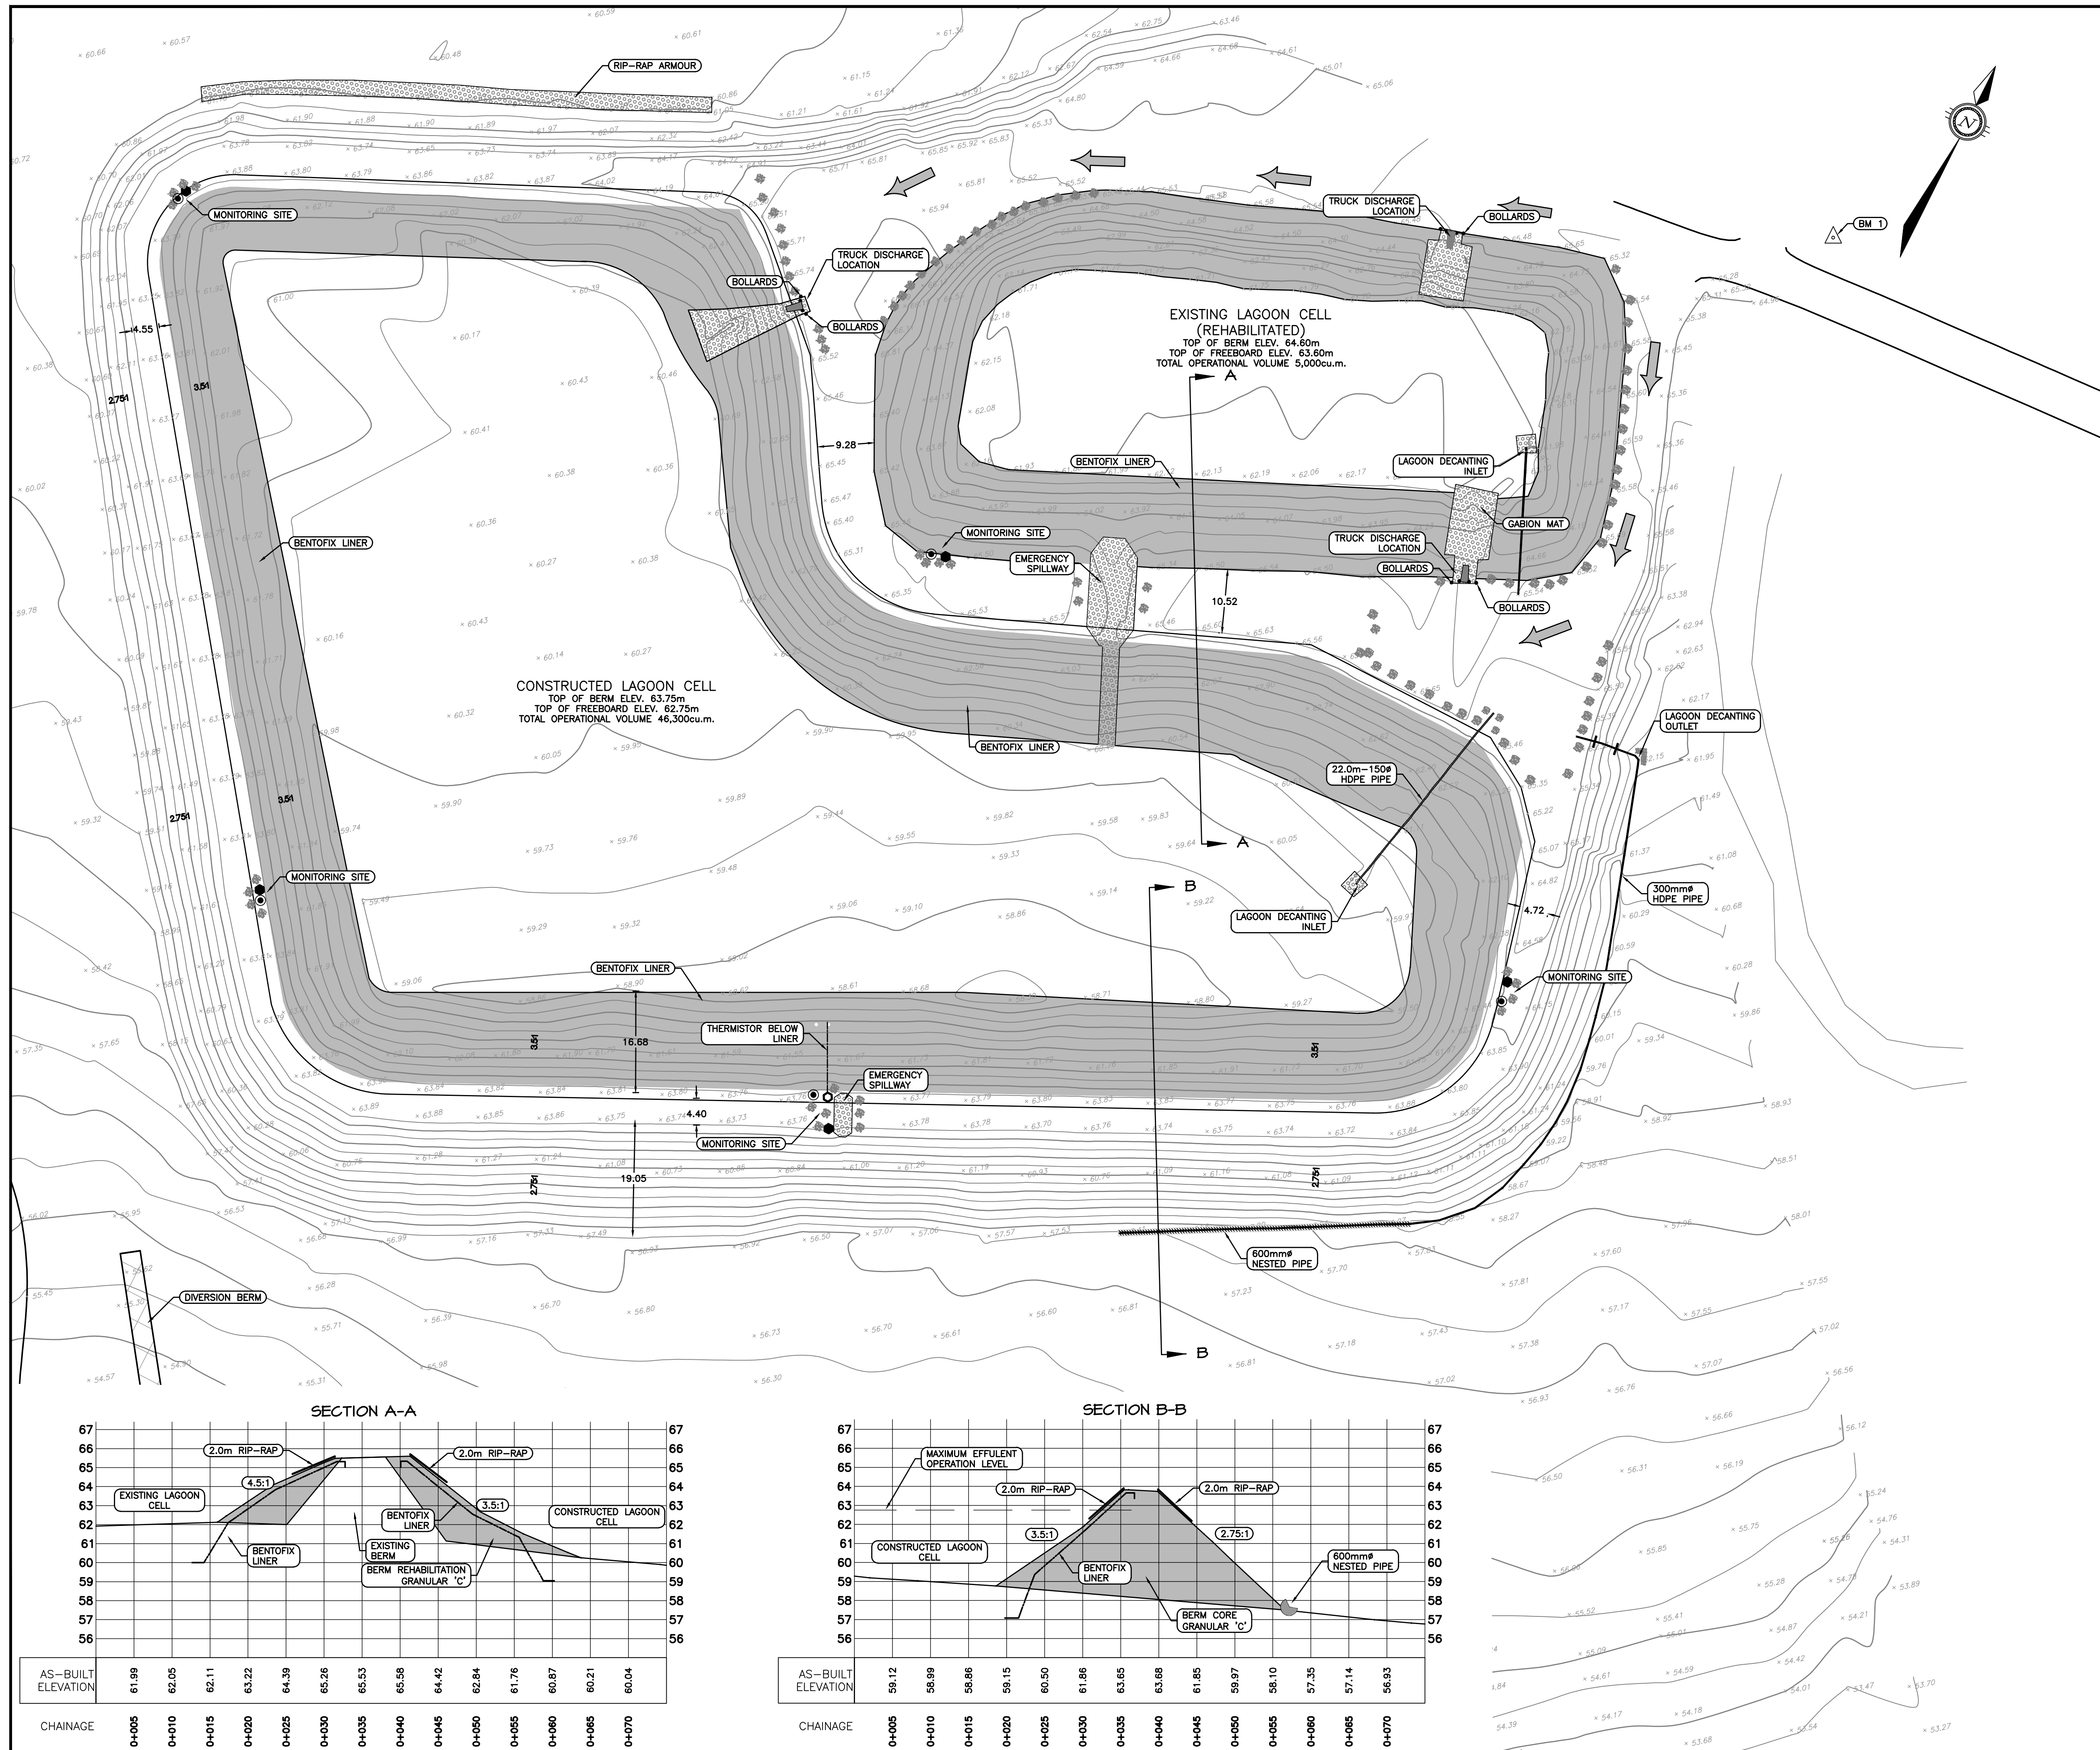

LEGEND

●

MONITORING WELL (SAMPLING POINT)

●

THERMISTOR

○

THERMISTOR BELOW LINER

10

SPOT ELEVATION

AB

BOULDER

GABION MAT

BENTOFIX LINER

TRUCK ROUTE

AS-BUILT

DATE: DECEMBER 31st, 2011

BENCH MARK

BM 1

ELEV. = 65.16

RE-BAR SET NEAR THE INTERSECTION OF THE LAGOON ACCESS ROAD AND METAL DUMP ACCESS ROAD. NORTH-EAST OF THE LAGOON SITE.

REVISIONS			
No.	DESCRIPTION	DATE	BY APP'D
6	AS-BUILT	31/12/11	MEB SLB
5	AS-CONSTRUCTED 2011	18/11/11	MEB SLB
4	AS-CONSTRUCTED	02/12/10	MEB SLB
3	ISSUED FOR CONSTRUCTION	15/06/09	MMR SLB
2	REVISED FOR TENDER	28/05/08	MMR SLB
1	ISSUED FOR TENDER	28/04/08	MMR SLB

DRAWINGS ORIGINALLY SEALED BY
S.L.BURDEN, P.eng. OF
exp. SERVICES Inc.
MAY 28TH, 2008

Trow Associates Inc.

100-2650 Queensview Drive
Ottawa, Ont. K2B 8H6

PHONE: (613) 688-1889
FAX: (613) 225-7337

CLIENT

GOVERNMENT OF NUNAVUT

PROJECT

CLYDE RIVER
WASTEWATER LAGOON

TITLE

SITE PLAN

design by

SAD

drawn by

MEB

checked by

SLB

date

30/08/2007

scale

HORIZ 1:500

project no.

OTCD00019055A

drawing no.

SP-2