
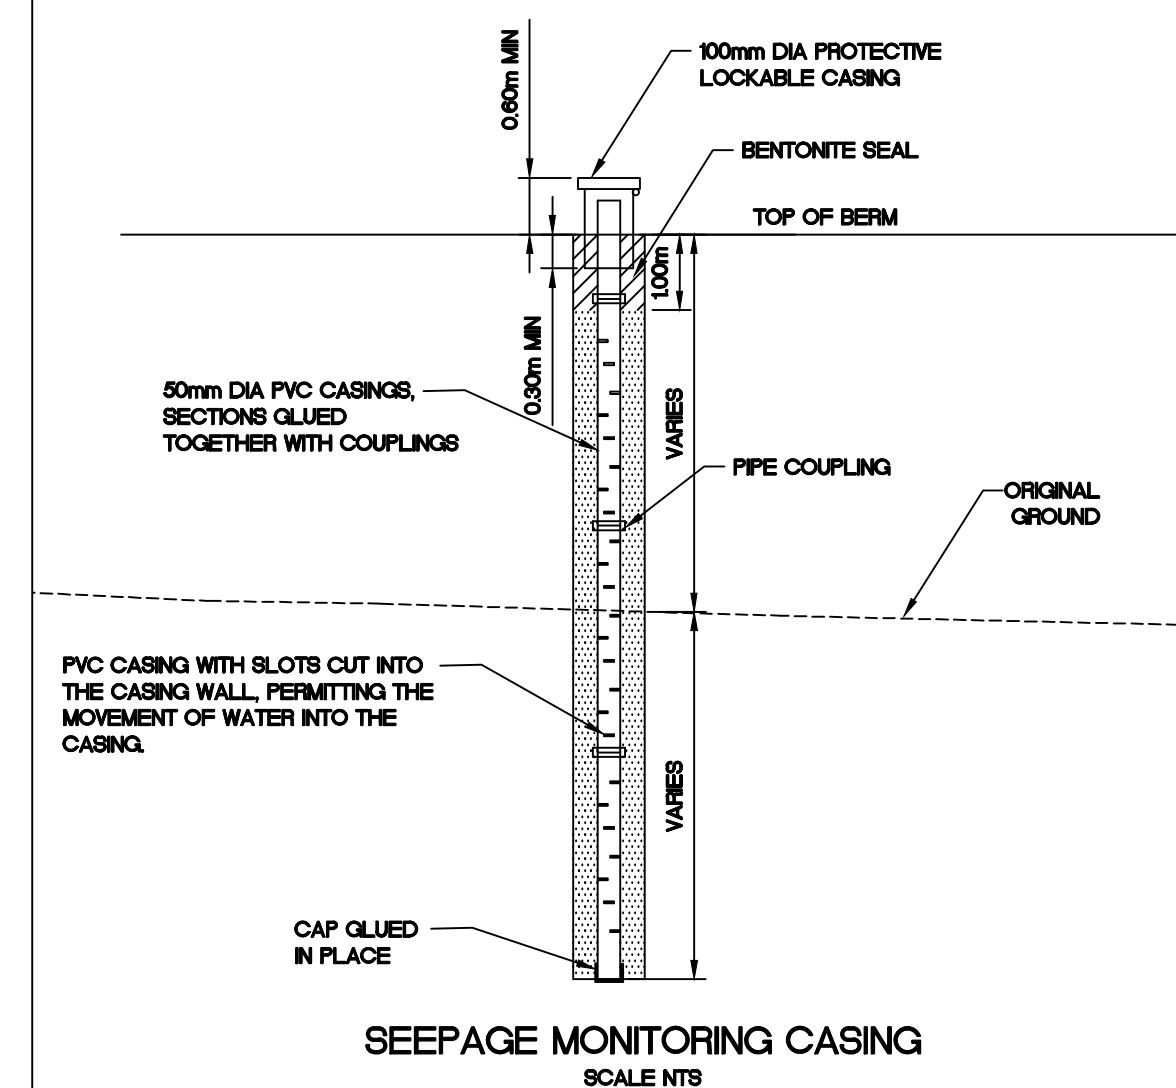
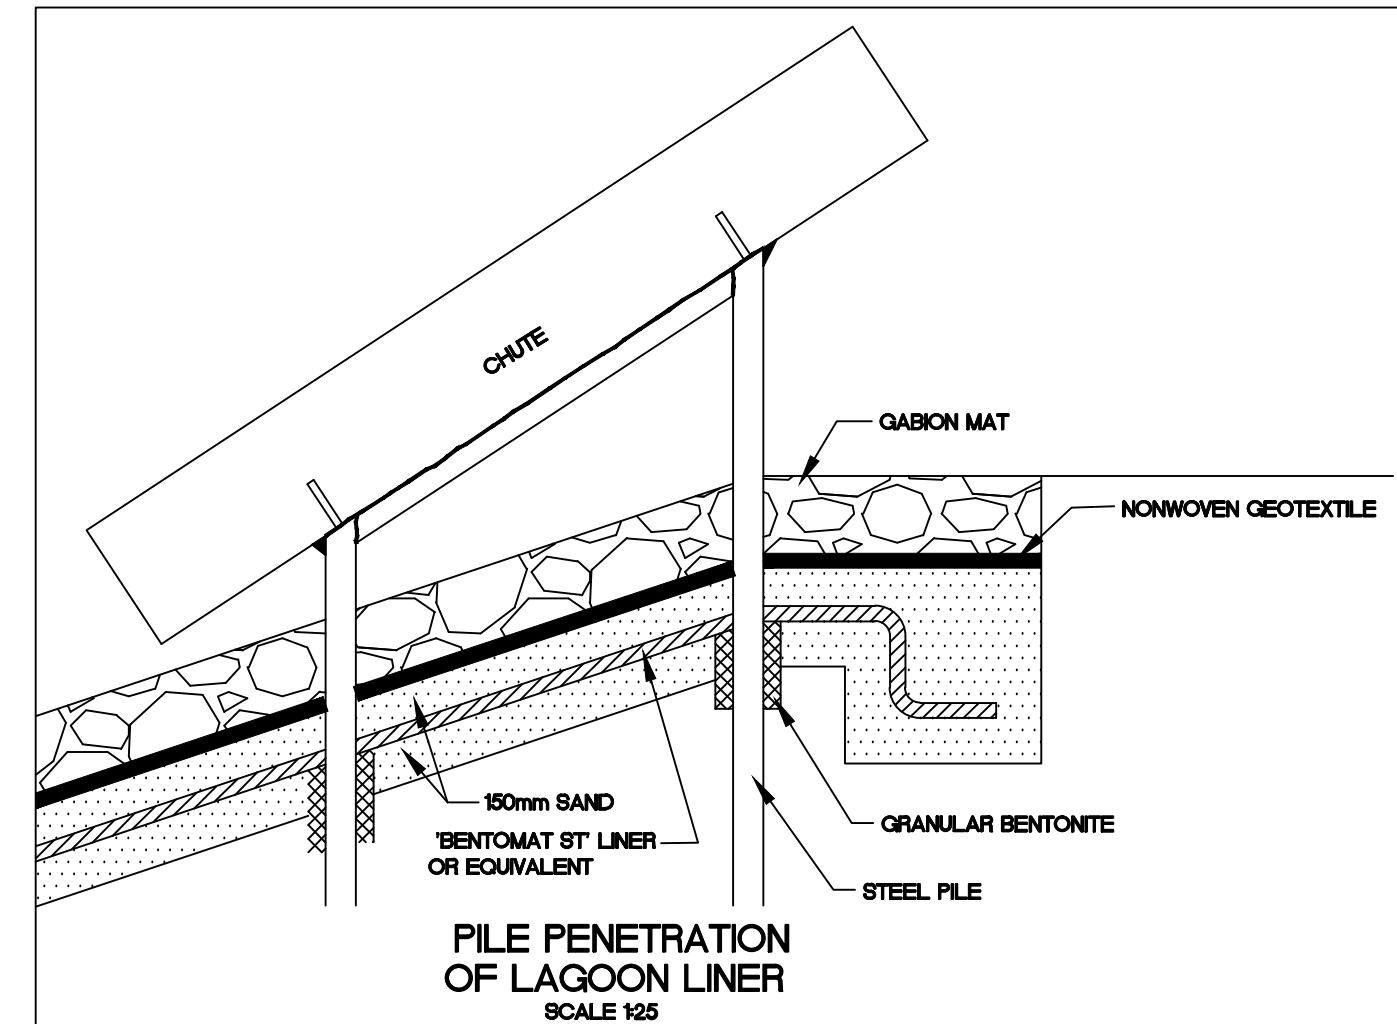
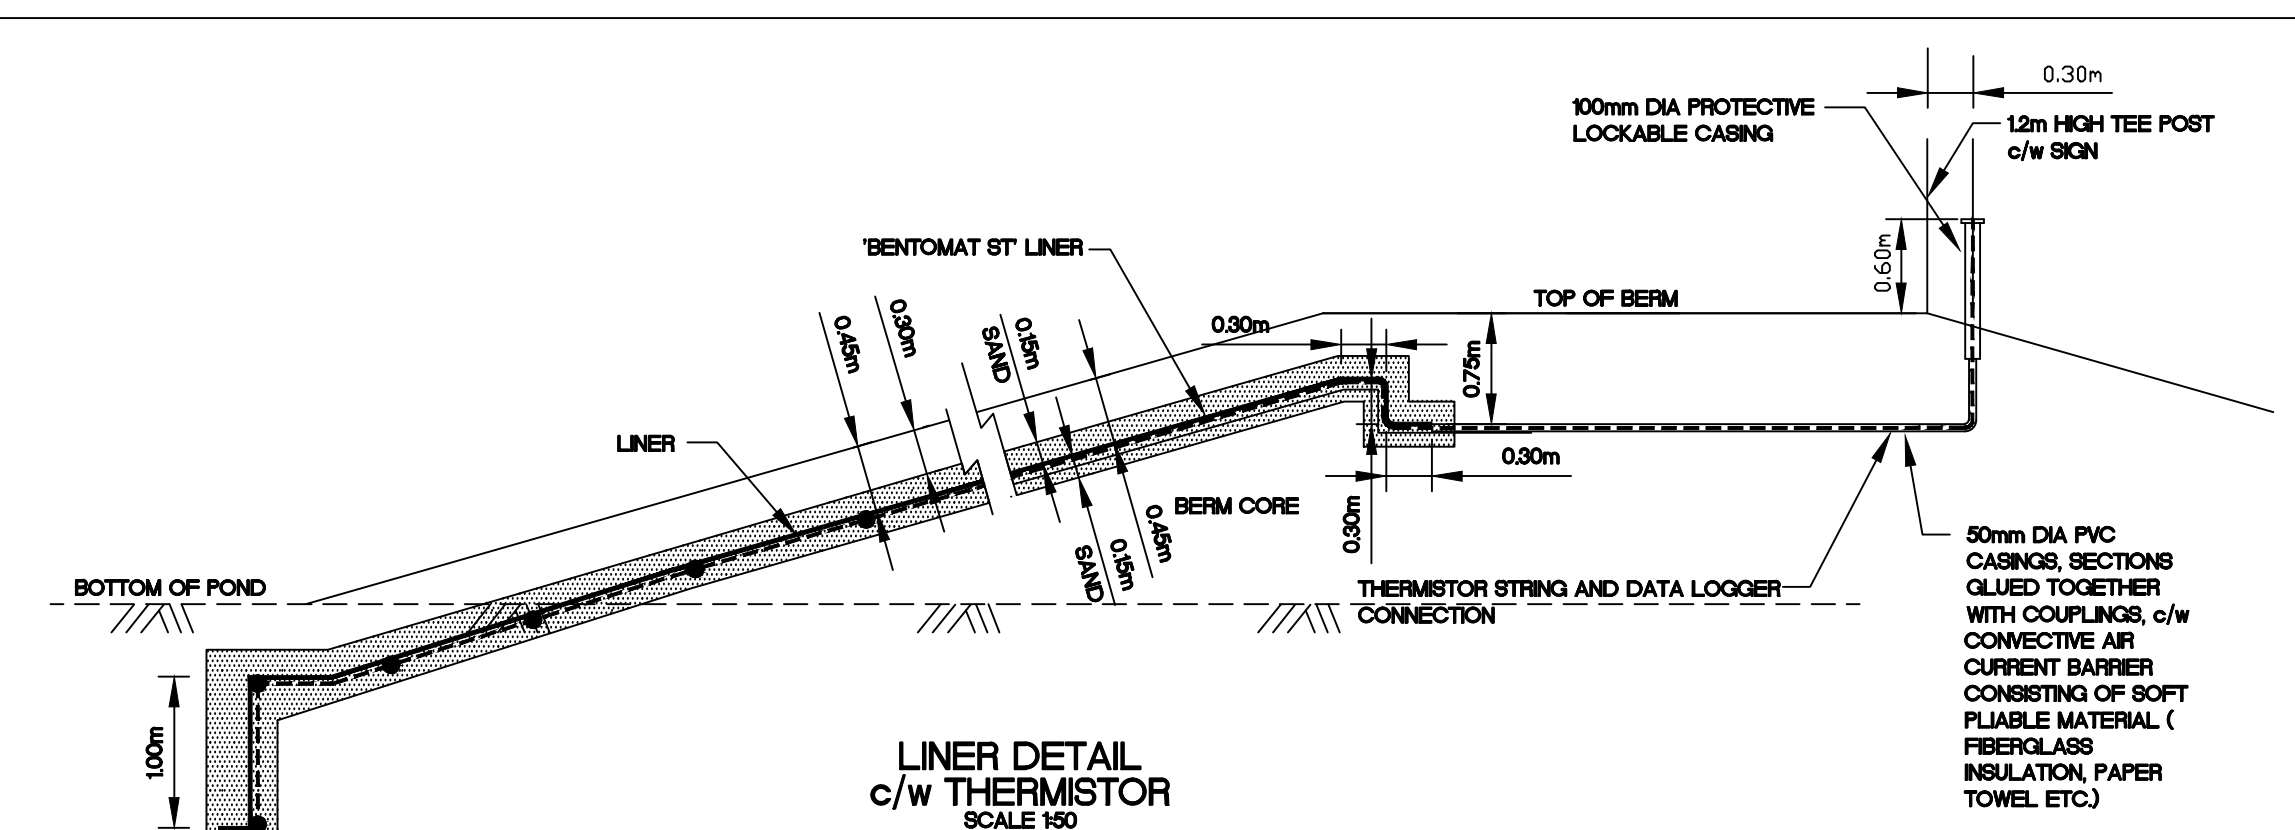
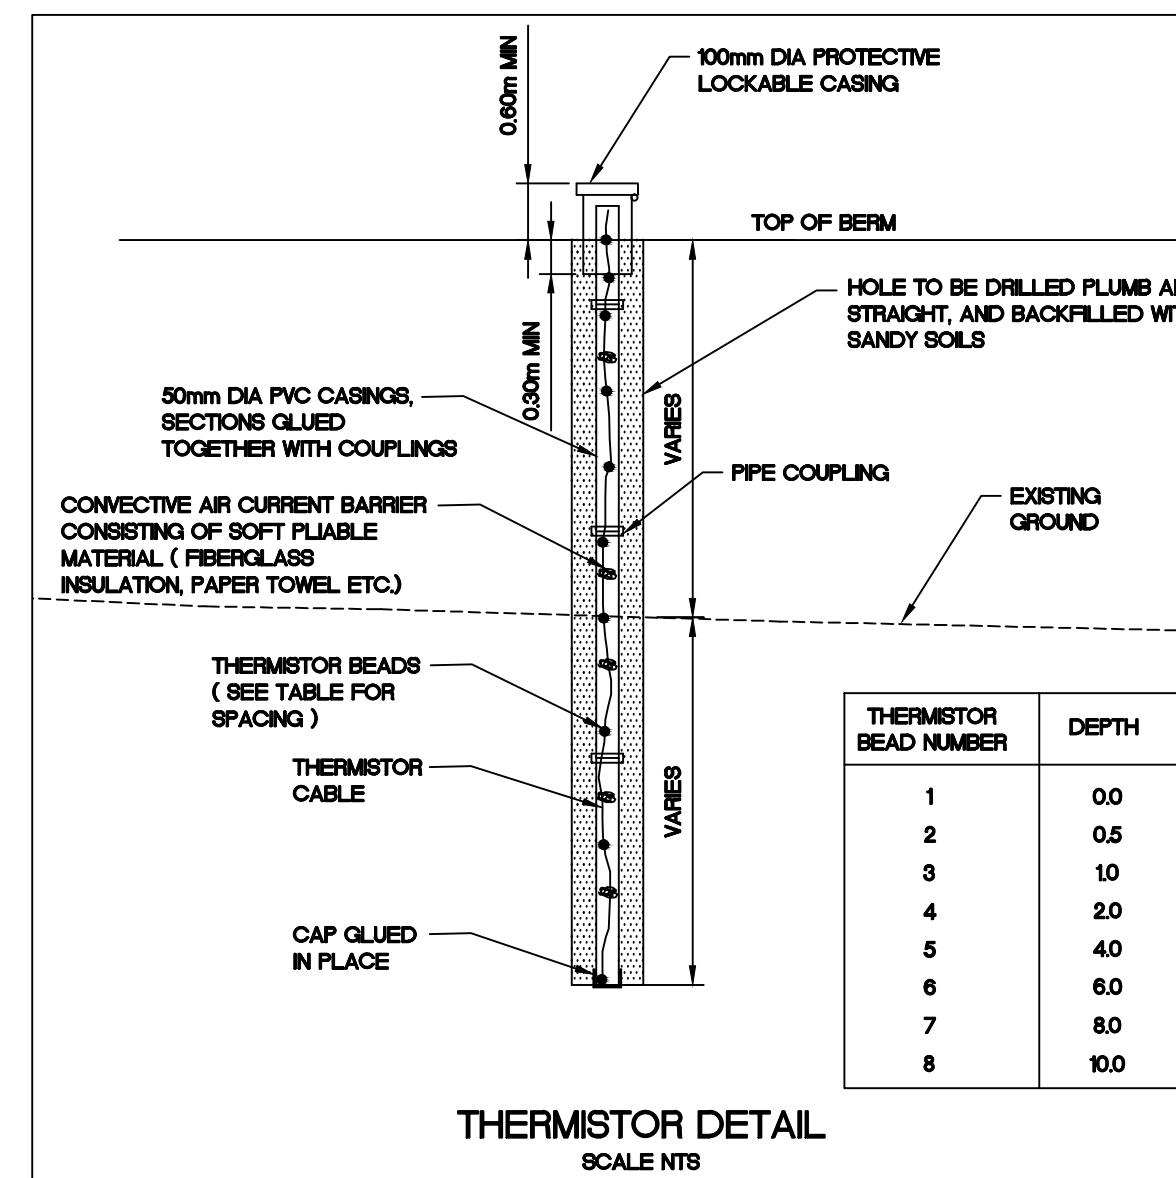
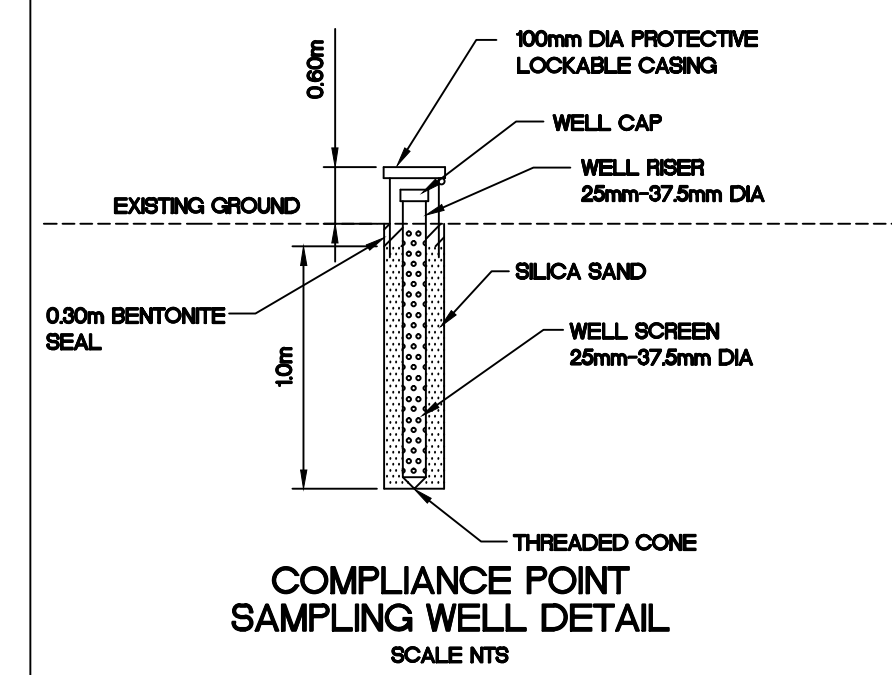
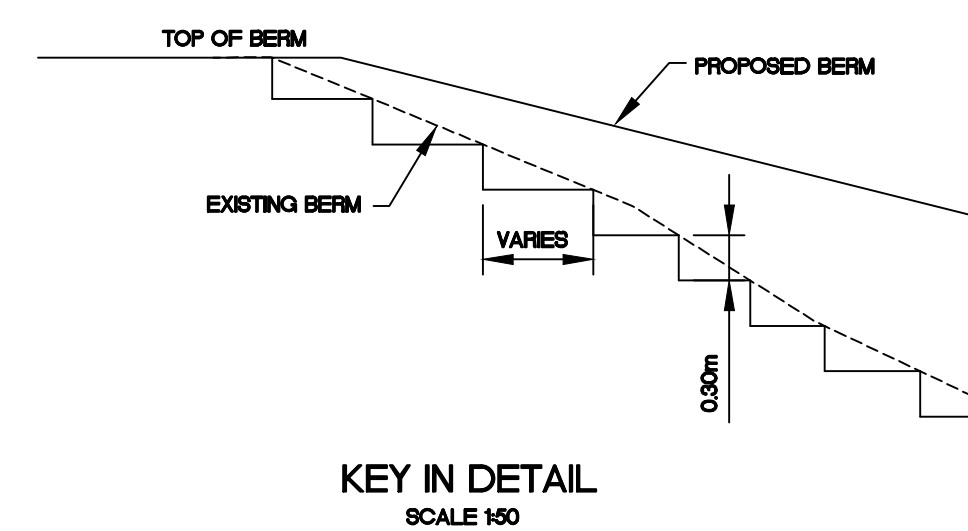
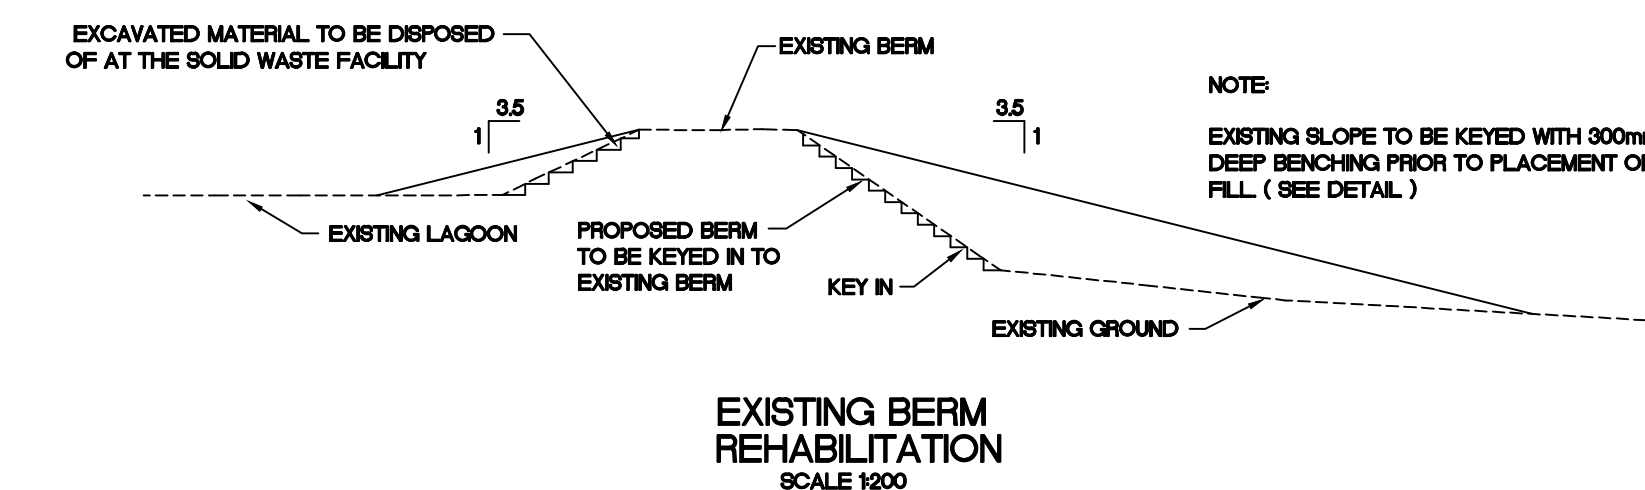
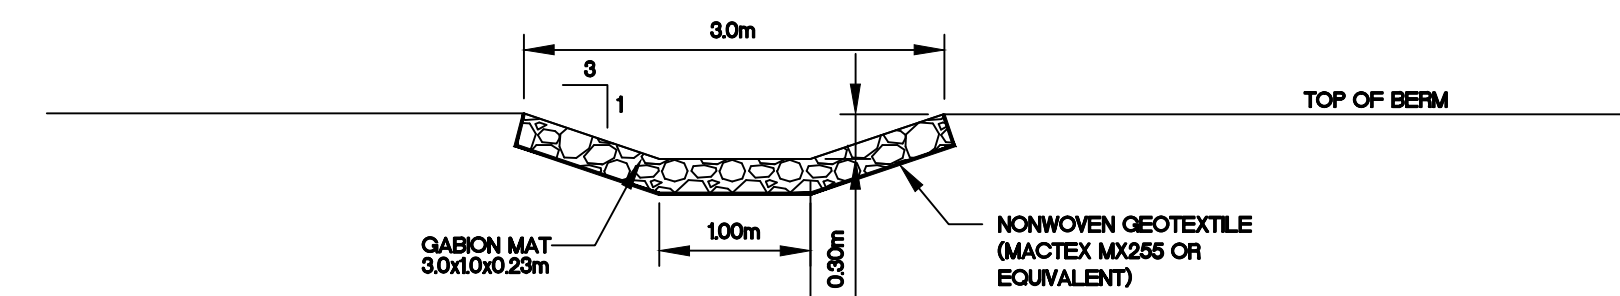
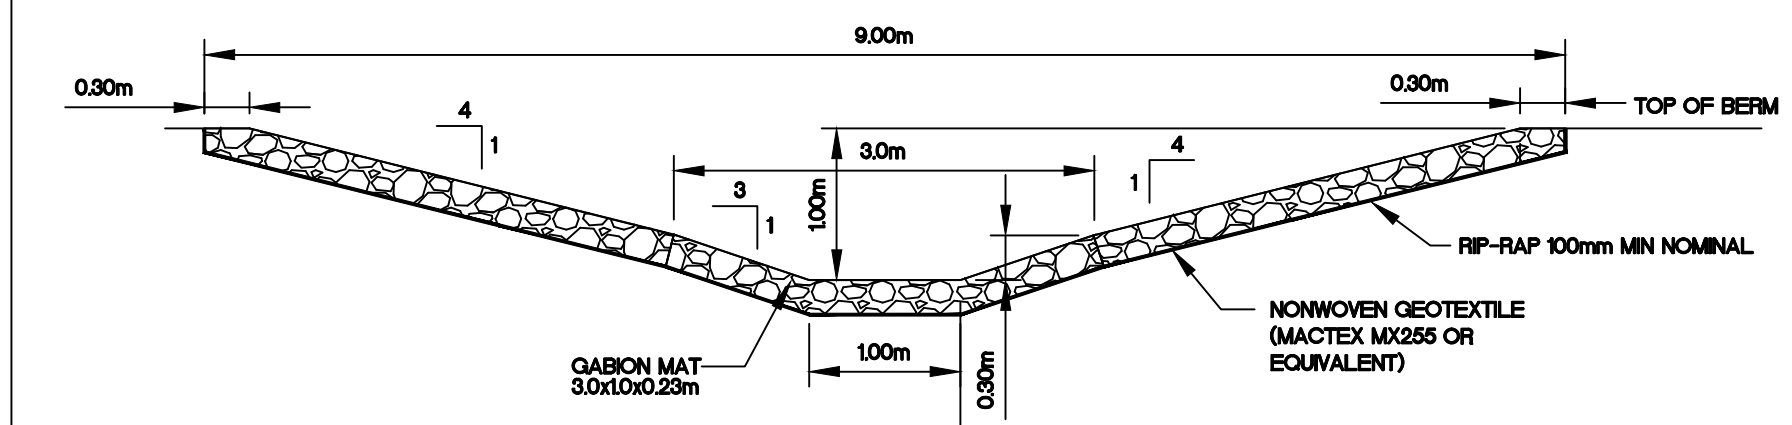
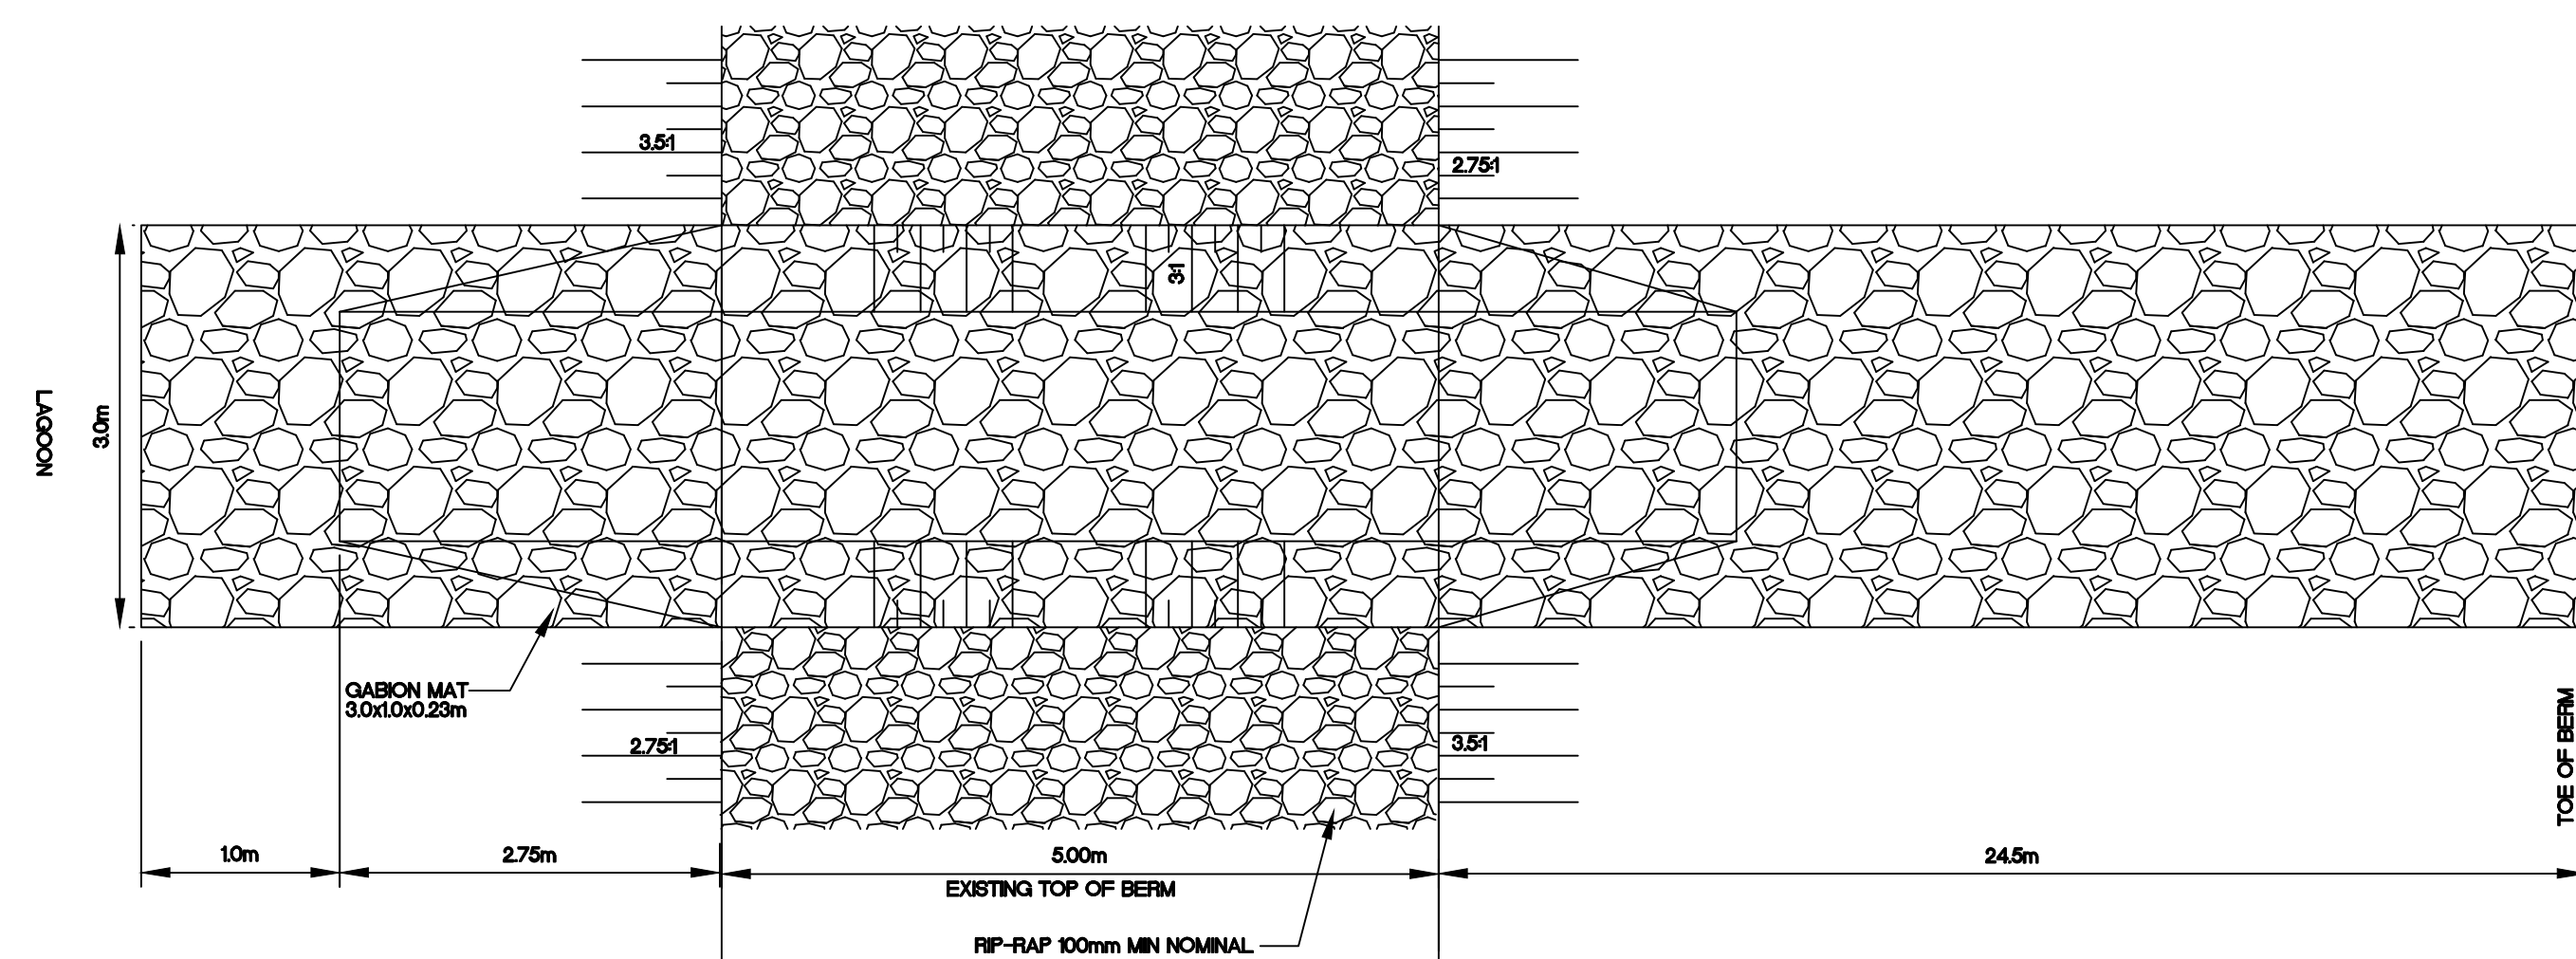


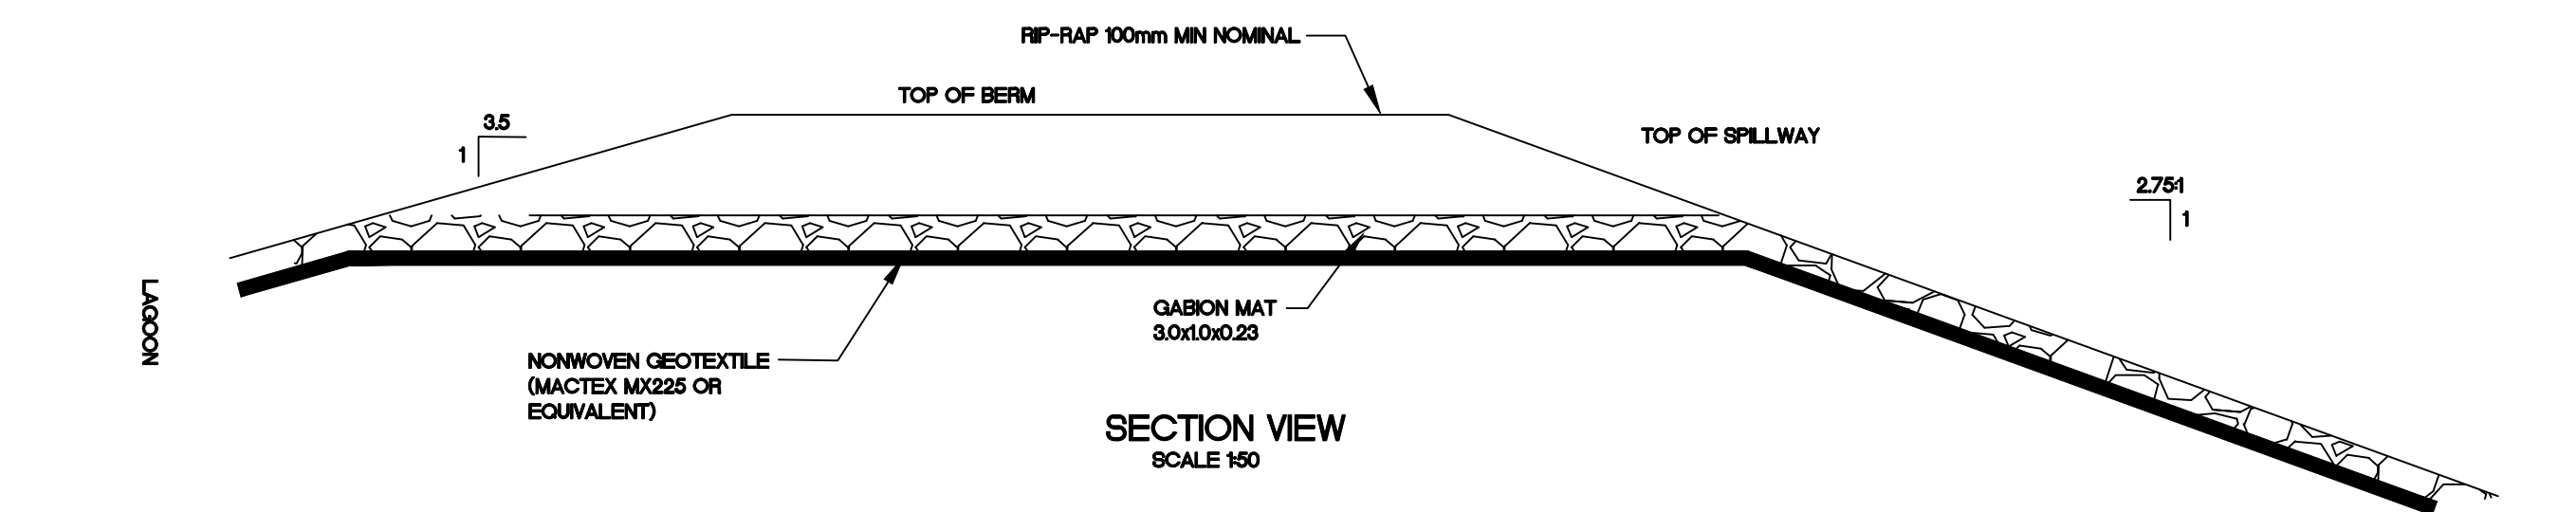

AS-BUILT

DATE: DECEMBER 31st, 2011

6	AS-BUILT	31/12/11	MEB	SLB	
5	AS-CONSTRUCTED 2011	18/11/11	MEB	SLB	
4	AS-CONSTRUCTED	02/12/10	MEB	SLB	
3	ISSUED FOR CONSTRUCTION	15/06/09	MMR	SLB	
2	REVISED FOR TENDER	28/05/08	MMR	SLB	
1	ISSUED FOR TENDER	28/04/08	MMR	SLB	
No.	DESCRIPTION	DATE	BY	APP'D	
R E V I S I O N S					

DRAWINGS ORIGINALLY
SEALED BY
S.L.BURDEN, P.eng. OF
exp. SERVICES Inc.
MAY 28TH, 2008

 **Trow** Associates Inc.
100-2650 Queensview Drive PHONE: (613) 688-1899
Ottawa, Ont. K2B 8H6 FAX: (613) 225-7337

CLIENT

GOVERNMENT OF NUNAVUT

PROJECT

CLYDE RIVER
WASTE WATER
LAGOON

DETAILS

design by	S.A.D.	project no. OTCD19055A drawing no. DE-1
drawn by	M.M.R.	
checked by	S.L.B.	
date	14/12/07	
scale	AS SHOWN	