




LOCATION: GJOA HAVEN, NUNAVUT


PROJECT NO:11-5029

DATE: SEPTEMBER 2012

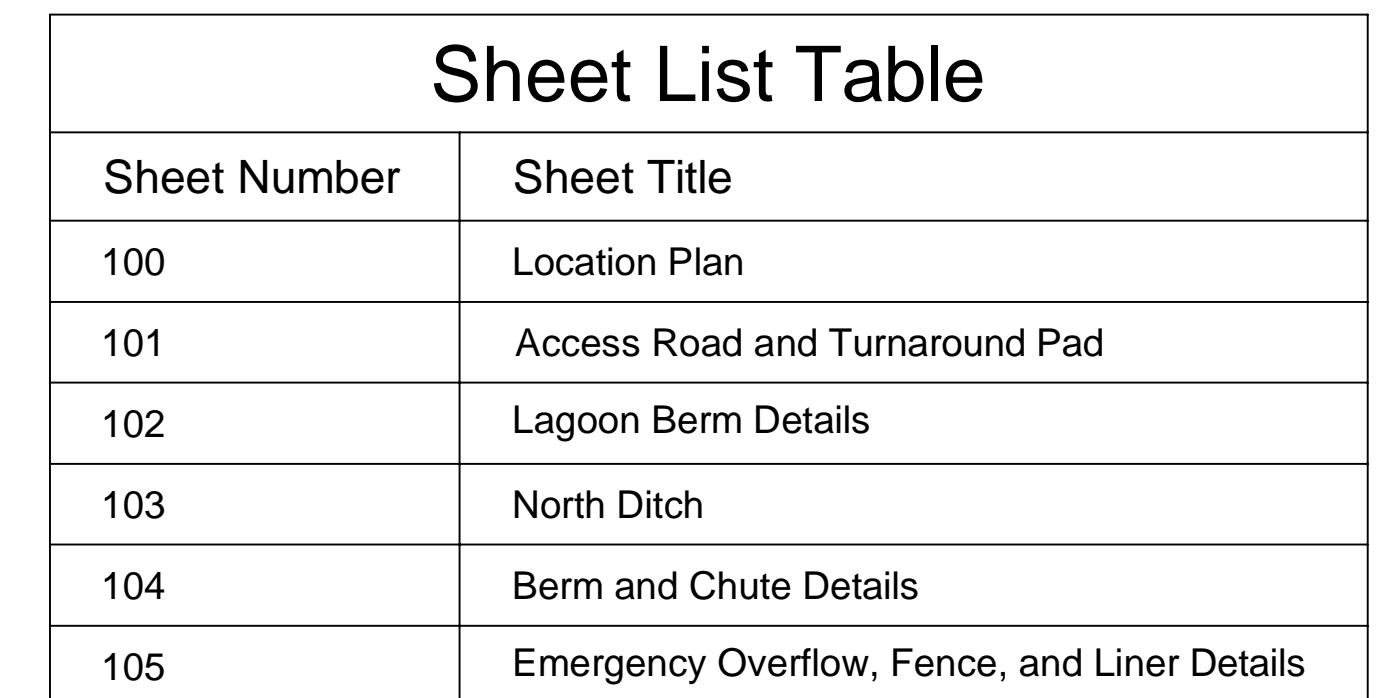


DILLON CONSULTING LIMITED 4920 47TH STREET, YELLOWKNIFE NT, X1A 2P1, PHONE 867 920 4555


Users: information, matty, g... Date: 1/23/2015
C:\Users\matty\Documents\Projects\GJOA HAVEN SEWAGE LAGOON\Access Road.dwg - 101 Access Road

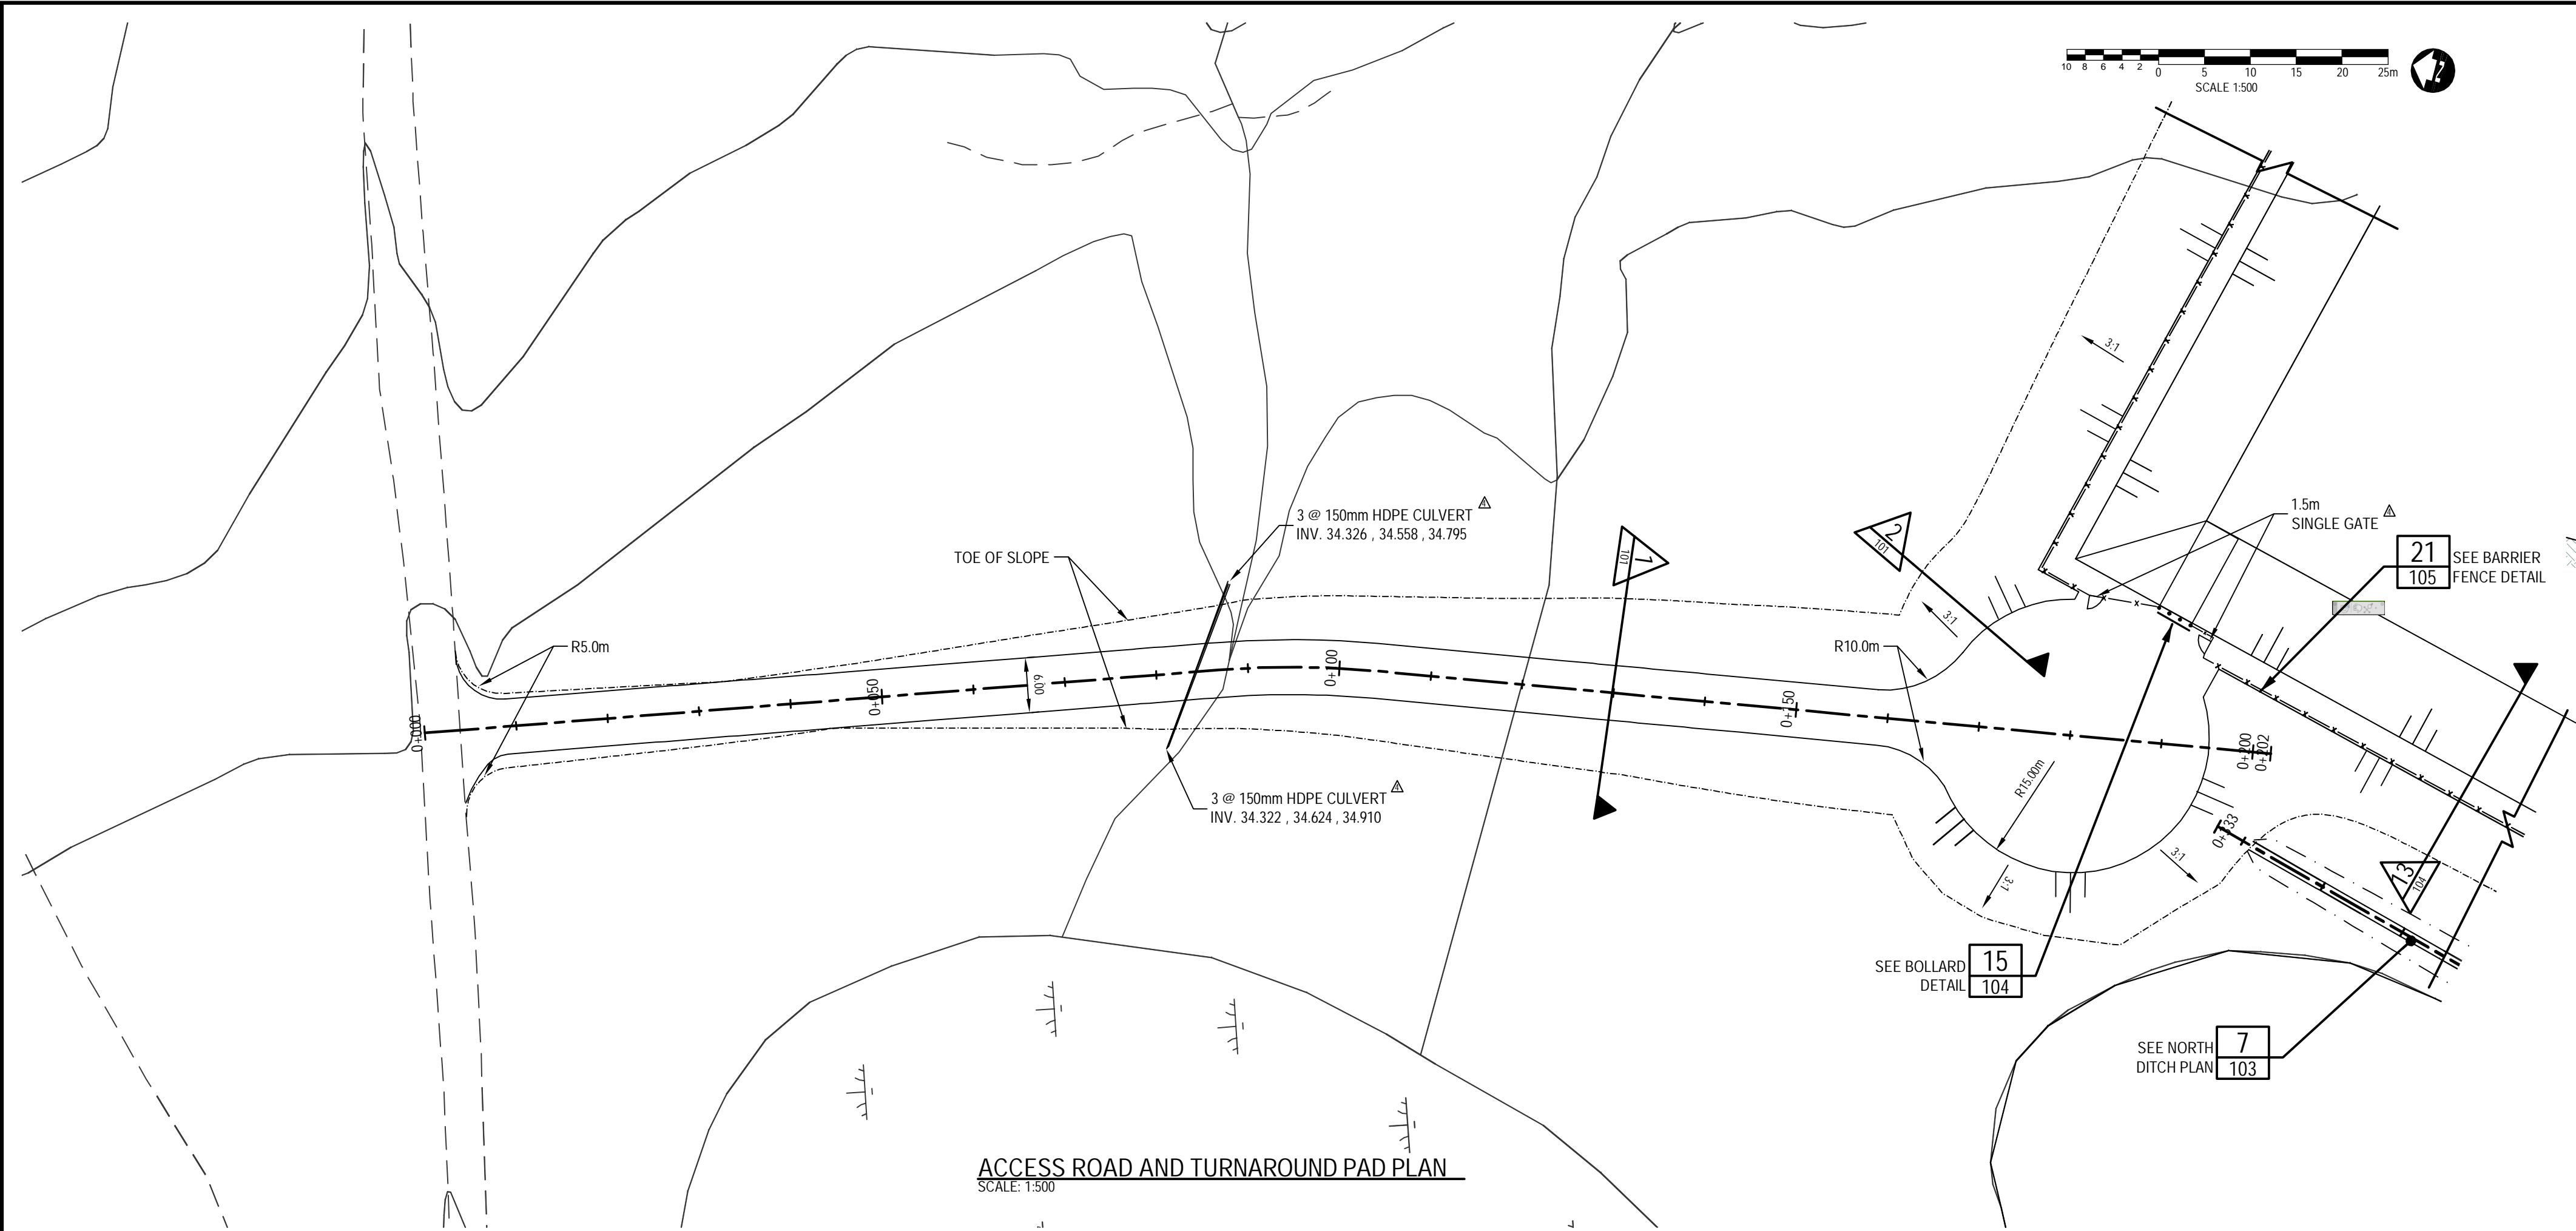


ACCESS ROAD AND TURNAROUND PAD PLAN
SCALE: 1:500

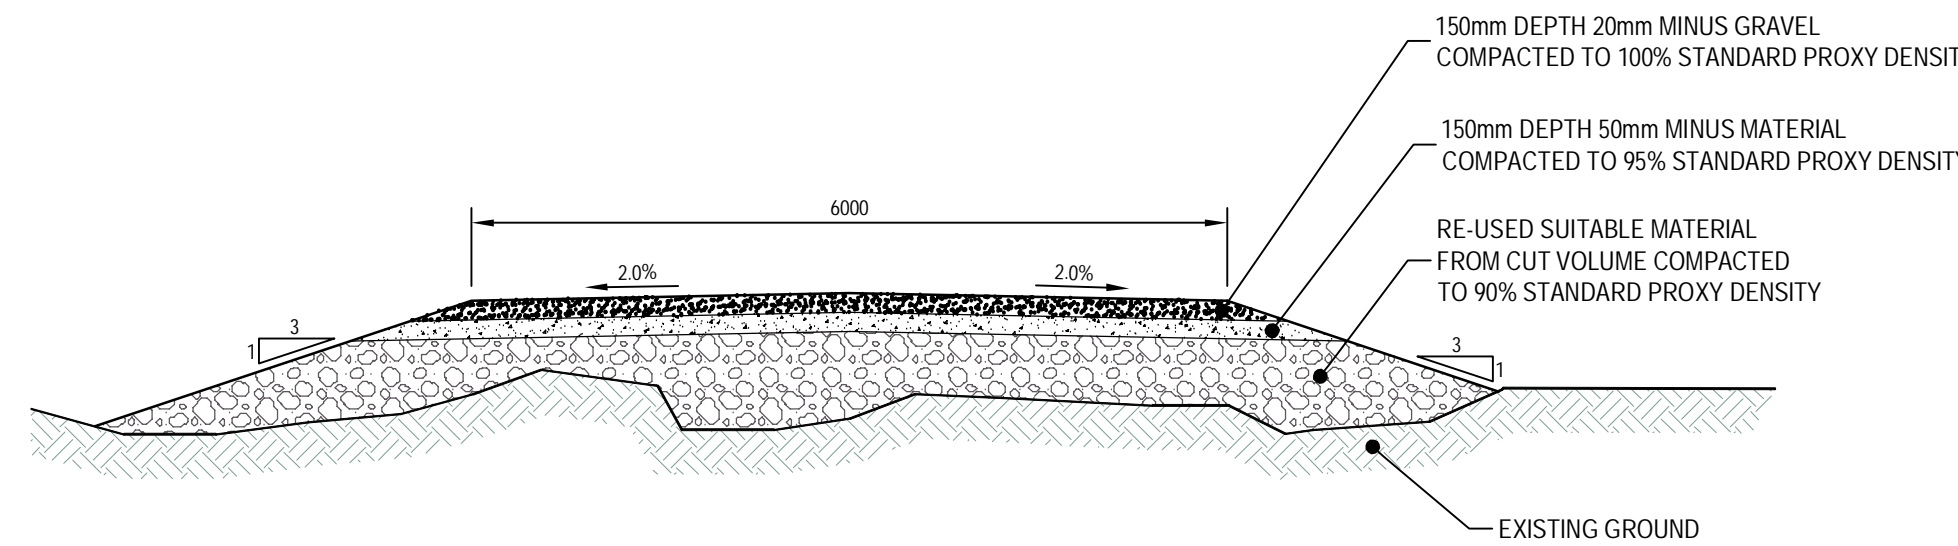

TYPICAL ROAD SECTION
SCALE: 1:60

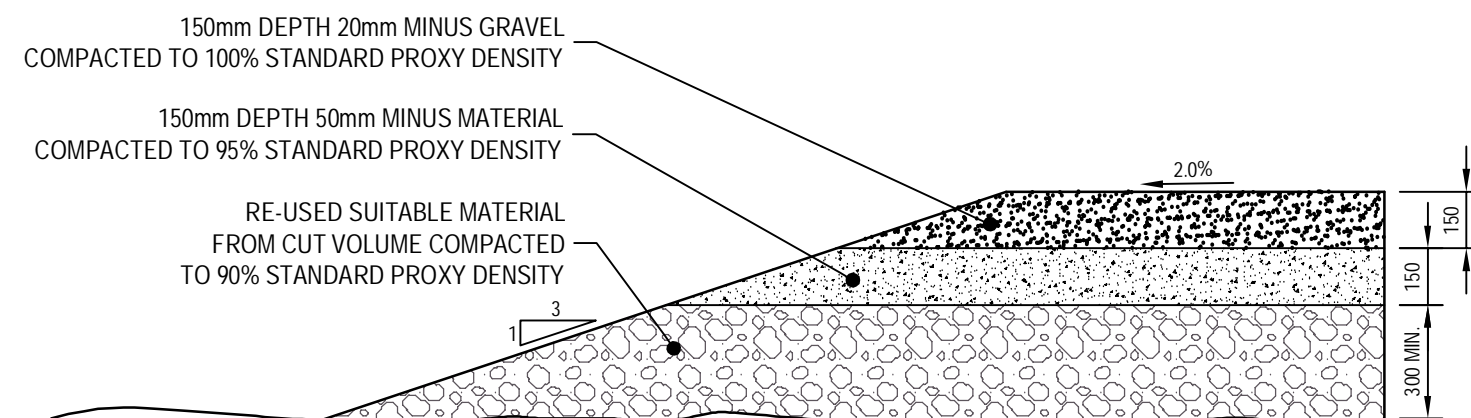


TURNAROUND PAD SECTION
SCALE: 1:20

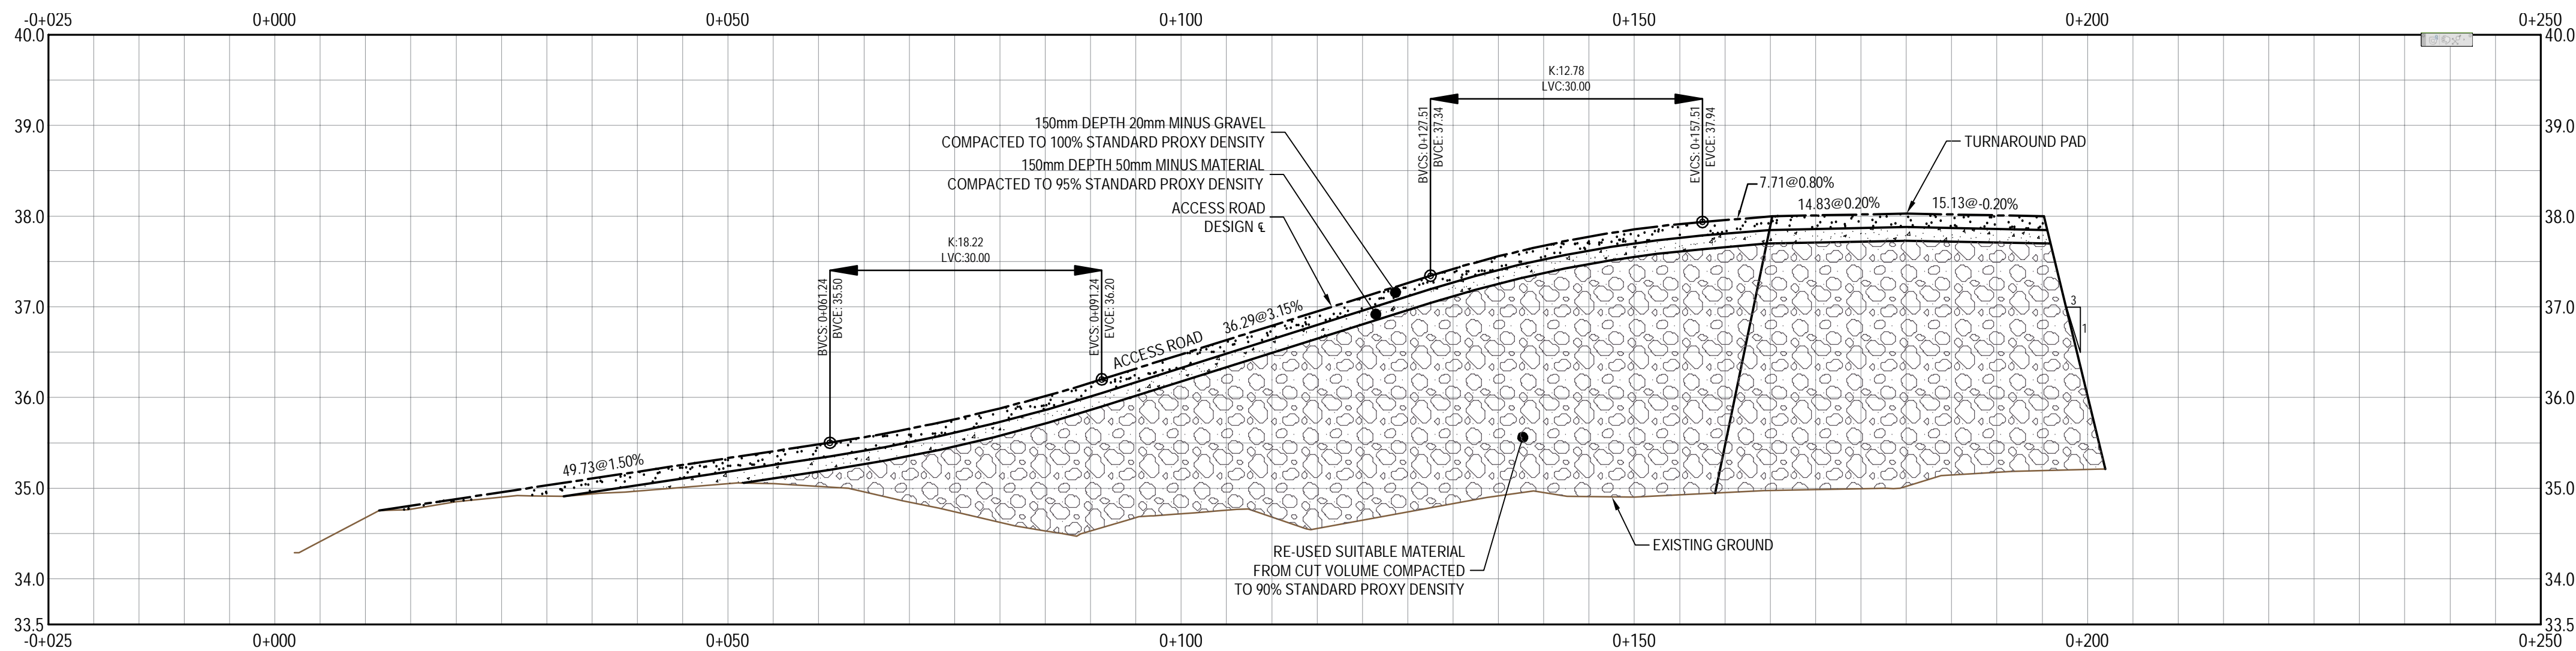

ACCESS ROAD AND TURNAROUND PAD PROFILE
SCALE: H:1500 V:150

THIS RECORD DOCUMENT HAS BEEN PREPARED BASED IN PART UPON INFORMATION FURNISHED BY OTHERS. DILLON CONSULTING LTD. CANNOT ASSURE THE ACCURACY OF OTHERS' INFORMATION AND THIS IS NOT RESPONSIBLE FOR THE ACCURACY OF THIS RECORD DOCUMENT OR FOR ANY ERROR OR OMISSION THAT MAY HAVE BEEN INCORPORATED INTO IT. AS A RESULT, THOSE RELYING ON THIS RECORD DOCUMENT ARE ADVISED TO OBTAIN INDEPENDENT VERIFICATION OF ITS ACCURACY BEFORE APPLYING IT FOR ANY PURPOSE.

THE ASSOCIATION OF
PROFESSIONAL ENGINEERS,
GEOLOGISTS AND GEOPHYSICISTS
OF THE NORTHWEST TERRITORIES
**PERMIT NUMBER
P 010**
DILLON CONSULTING
LIMITED

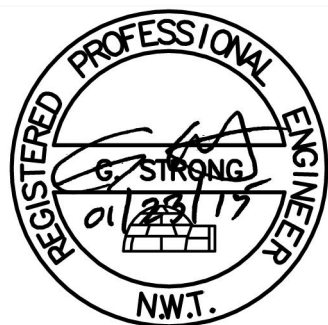


RECORD DRAWING
APPROVED BY: *G. Strong* DATE: Jan 29/15



No.	ISSUED FOR	MO	DAY	YR	BY
1	RECORD DRAWING	01	13	14	GS
2	RE-ISSUED FOR TENDER, REVISION 1	09	18	12	GS
3	ISSUED FOR TENDER	04	13	12	GS
4	ISSUED FOR INTERNAL REVIEW	04	11	12	GS

DESIGN	JMS	REVIEWED BY	GS
DRAWN	CH/TPW	CHECKED BY	GS
DATE	JANUARY 2014		
SCALE	AS SHOWN		



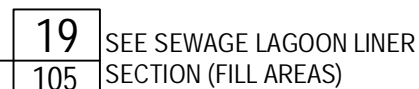
GJOA HAVEN SEWAGE LAGOON GJOA HAVEN, NUNAVUT		PROJECT NUMBER 11-5029-1000
ACCESS ROAD AND TURNAROUND PAD		SHEET NUMBER 101

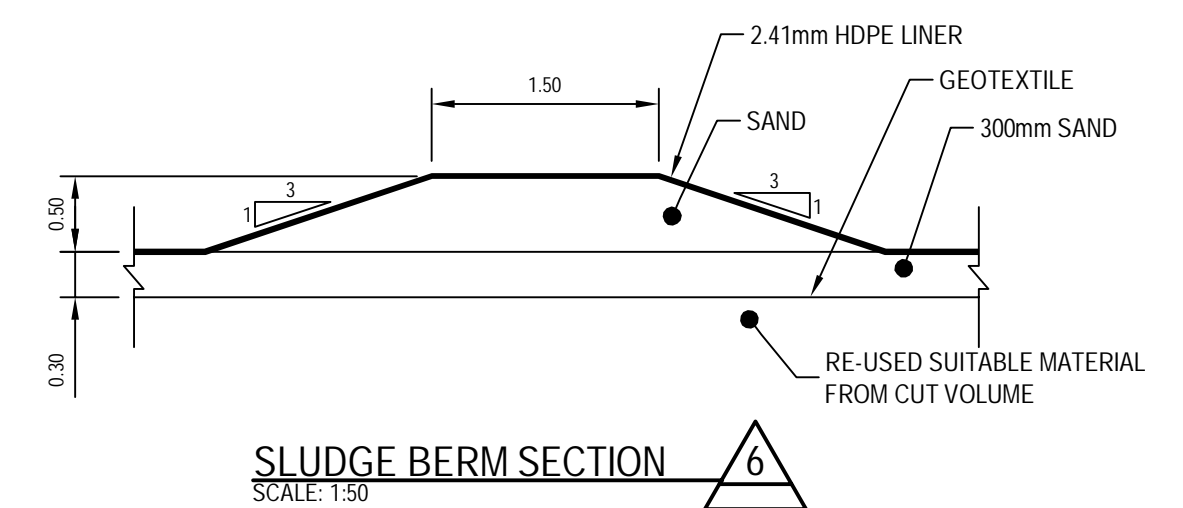

<p>GJOA HAVEN SEWAGE LAGOON GJOA HAVEN, NUNAVUT</p>		<p>PROJECT NUMBER 11-5029-1000</p>
<p>LAGOON BERM DETAILS</p>		<p>SHEET NUMBER 102</p>




GJOA HAVEN SEWAGE LAGOON GJOA HAVEN, NUNAVUT		PROJECT NUMBER 11-5029-1000
BERM AND CHUTE DETAILS		SHEET NUMBER 104

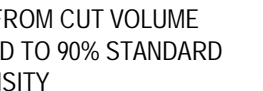

19




20

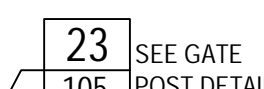

21



22

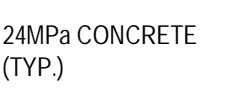

23

THE ASSOCIATION OF
PROFESSIONAL ENGINEERS,
GEOLOGISTS and GEOPHYSICISTS
OF THE NORTHWEST TERRITORIES

PERMIT NUMBER
P 010

DILLON CONSULTING
LIMITED



										DESIGN	REVIEWED BY
										JMS	GS
										ERWIN	CHECKED BY
										CH/TPW	GS
A	RECORD DRAWINGS					01	13	14	GS	DATE	
3	RE-ISSUED FOR TENDER, REVISION 1					09	18	12	GS		JANUARY 2014
2	ISSUED FOR TENDER					04	13	12	GS	SCALE	
1	ISSUED FOR INTERNAL REVIEW					04	11	12	GS		AS SHOWN
No.	ISSUED FOR					MO	DAY	YR	BY		

<p>GJOA HAVEN SEWAGE LAGOON GJOA HAVEN, NUNAVUT</p>		<p>PROJECT NUMBER 11-5029-1000</p>
<p>EMERGENCY OVERFLOW, FENCE, AND LINER DETAILS</p>		<p>SHEET NUMBER 105</p>