




exp Services Inc.

t: +1.613.688.1899 | f: +1.613.225.7330
 2650 Queensview Drive, Unit 100
 Ottawa, ON K2B 8H6
 Canada

www.exp.com

• BUILDINGS • EARTH & ENVIRONMENT • ENERGY •
 • INDUSTRIAL • INFRASTRUCTURE • SUSTAINABILITY •

scale NTS	CLIENT: GOVERNMENT OF NUNAVUT	project no. OTT-00209248-A0
date 20/08/2013	TITLE: EXISTING FACILITIES DAM SAFETY REVIEW KIMMIRUT, NUNAVUT	FIG 01
drawn by M.KELLEY		

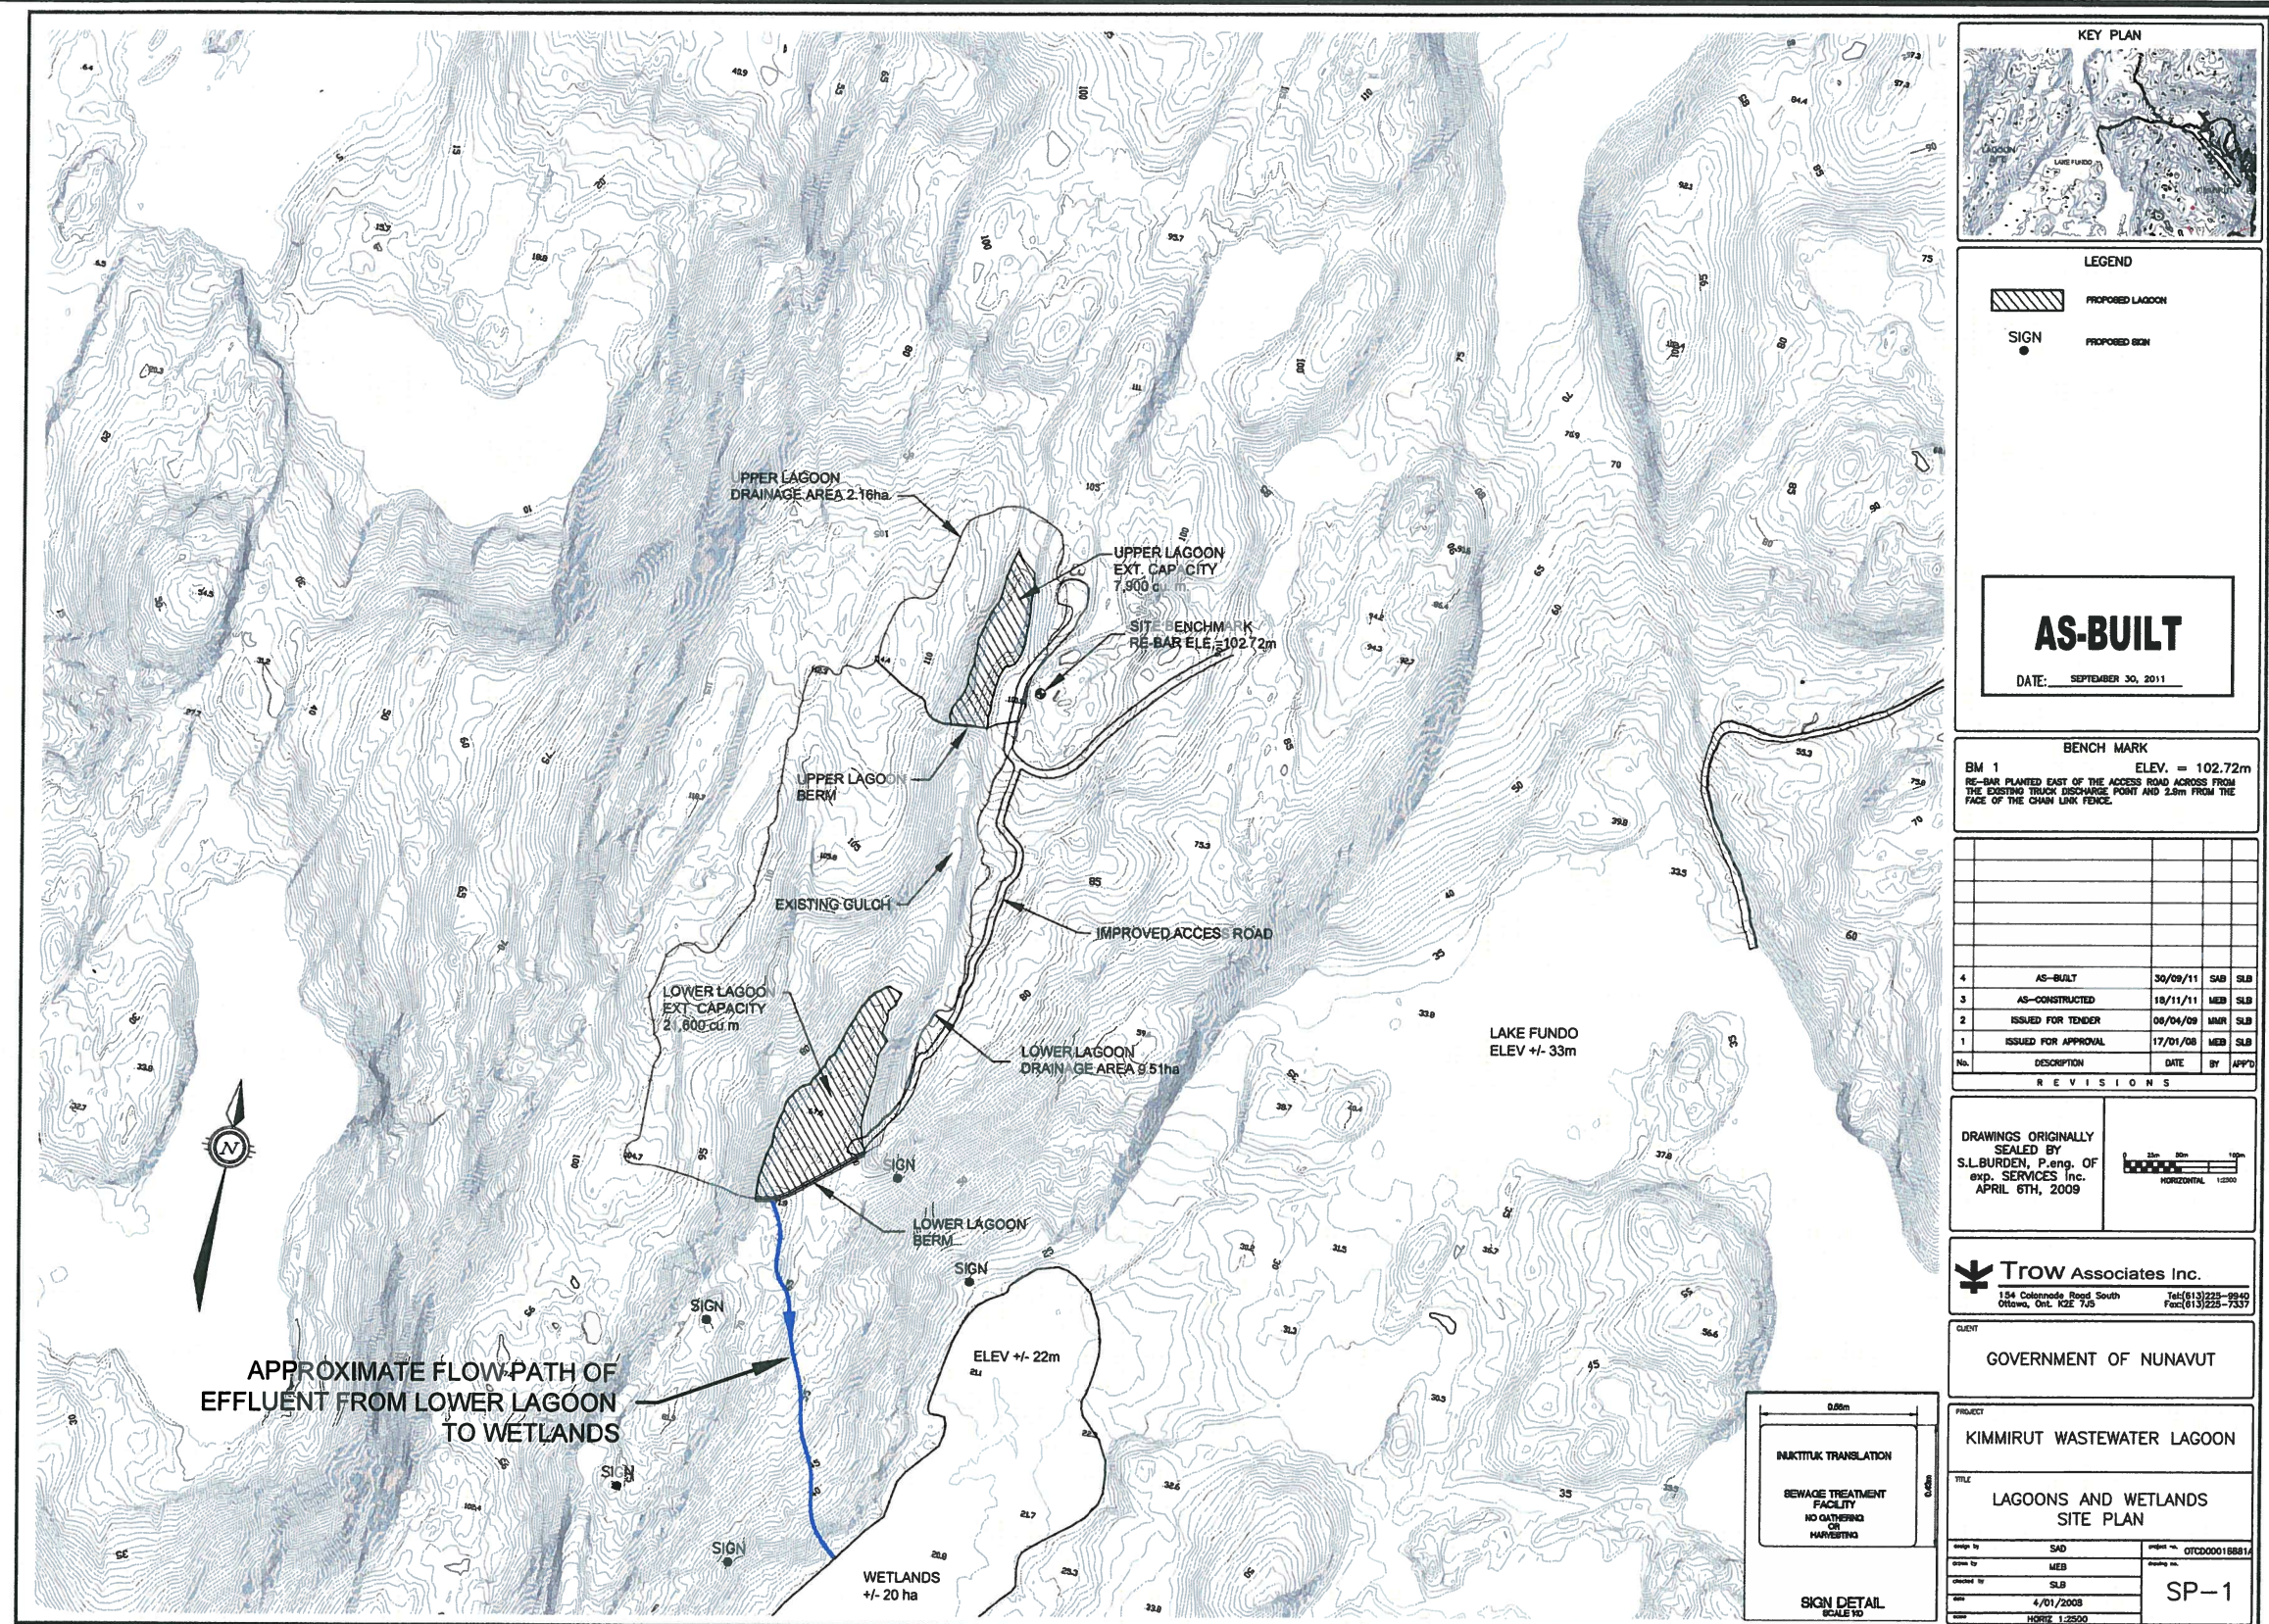




exp Services Inc.

t: +1.613.688.1899 | f: +1.613.225.7330
2650 Queensview Drive, Unit 100
Ottawa, ON K2B 8H6
Canada

www.exp.com

• BUILDINGS • EARTH & ENVIRONMENT • ENERGY •
• INDUSTRIAL • INFRASTRUCTURE • SUSTAINABILITY •

scale	NTS	CLIENT:	GOVERNMENT OF NUNAVUT	project no.	OTT-00209248-A0
date	20/08/2013	TITLE:	LAGOONS AND WETLANDS SITE PLAN DAM SAFETY REVIEW KIMMIRUT, NUNAVUT		
drawn by	E.A.				FIG 02

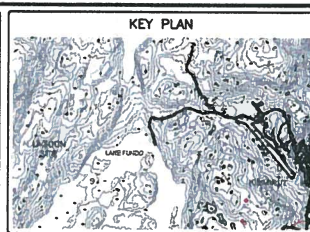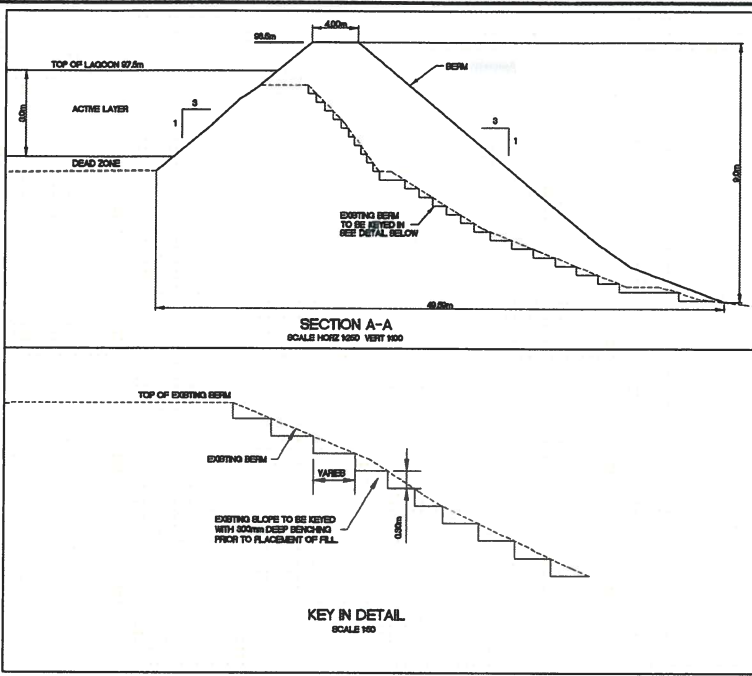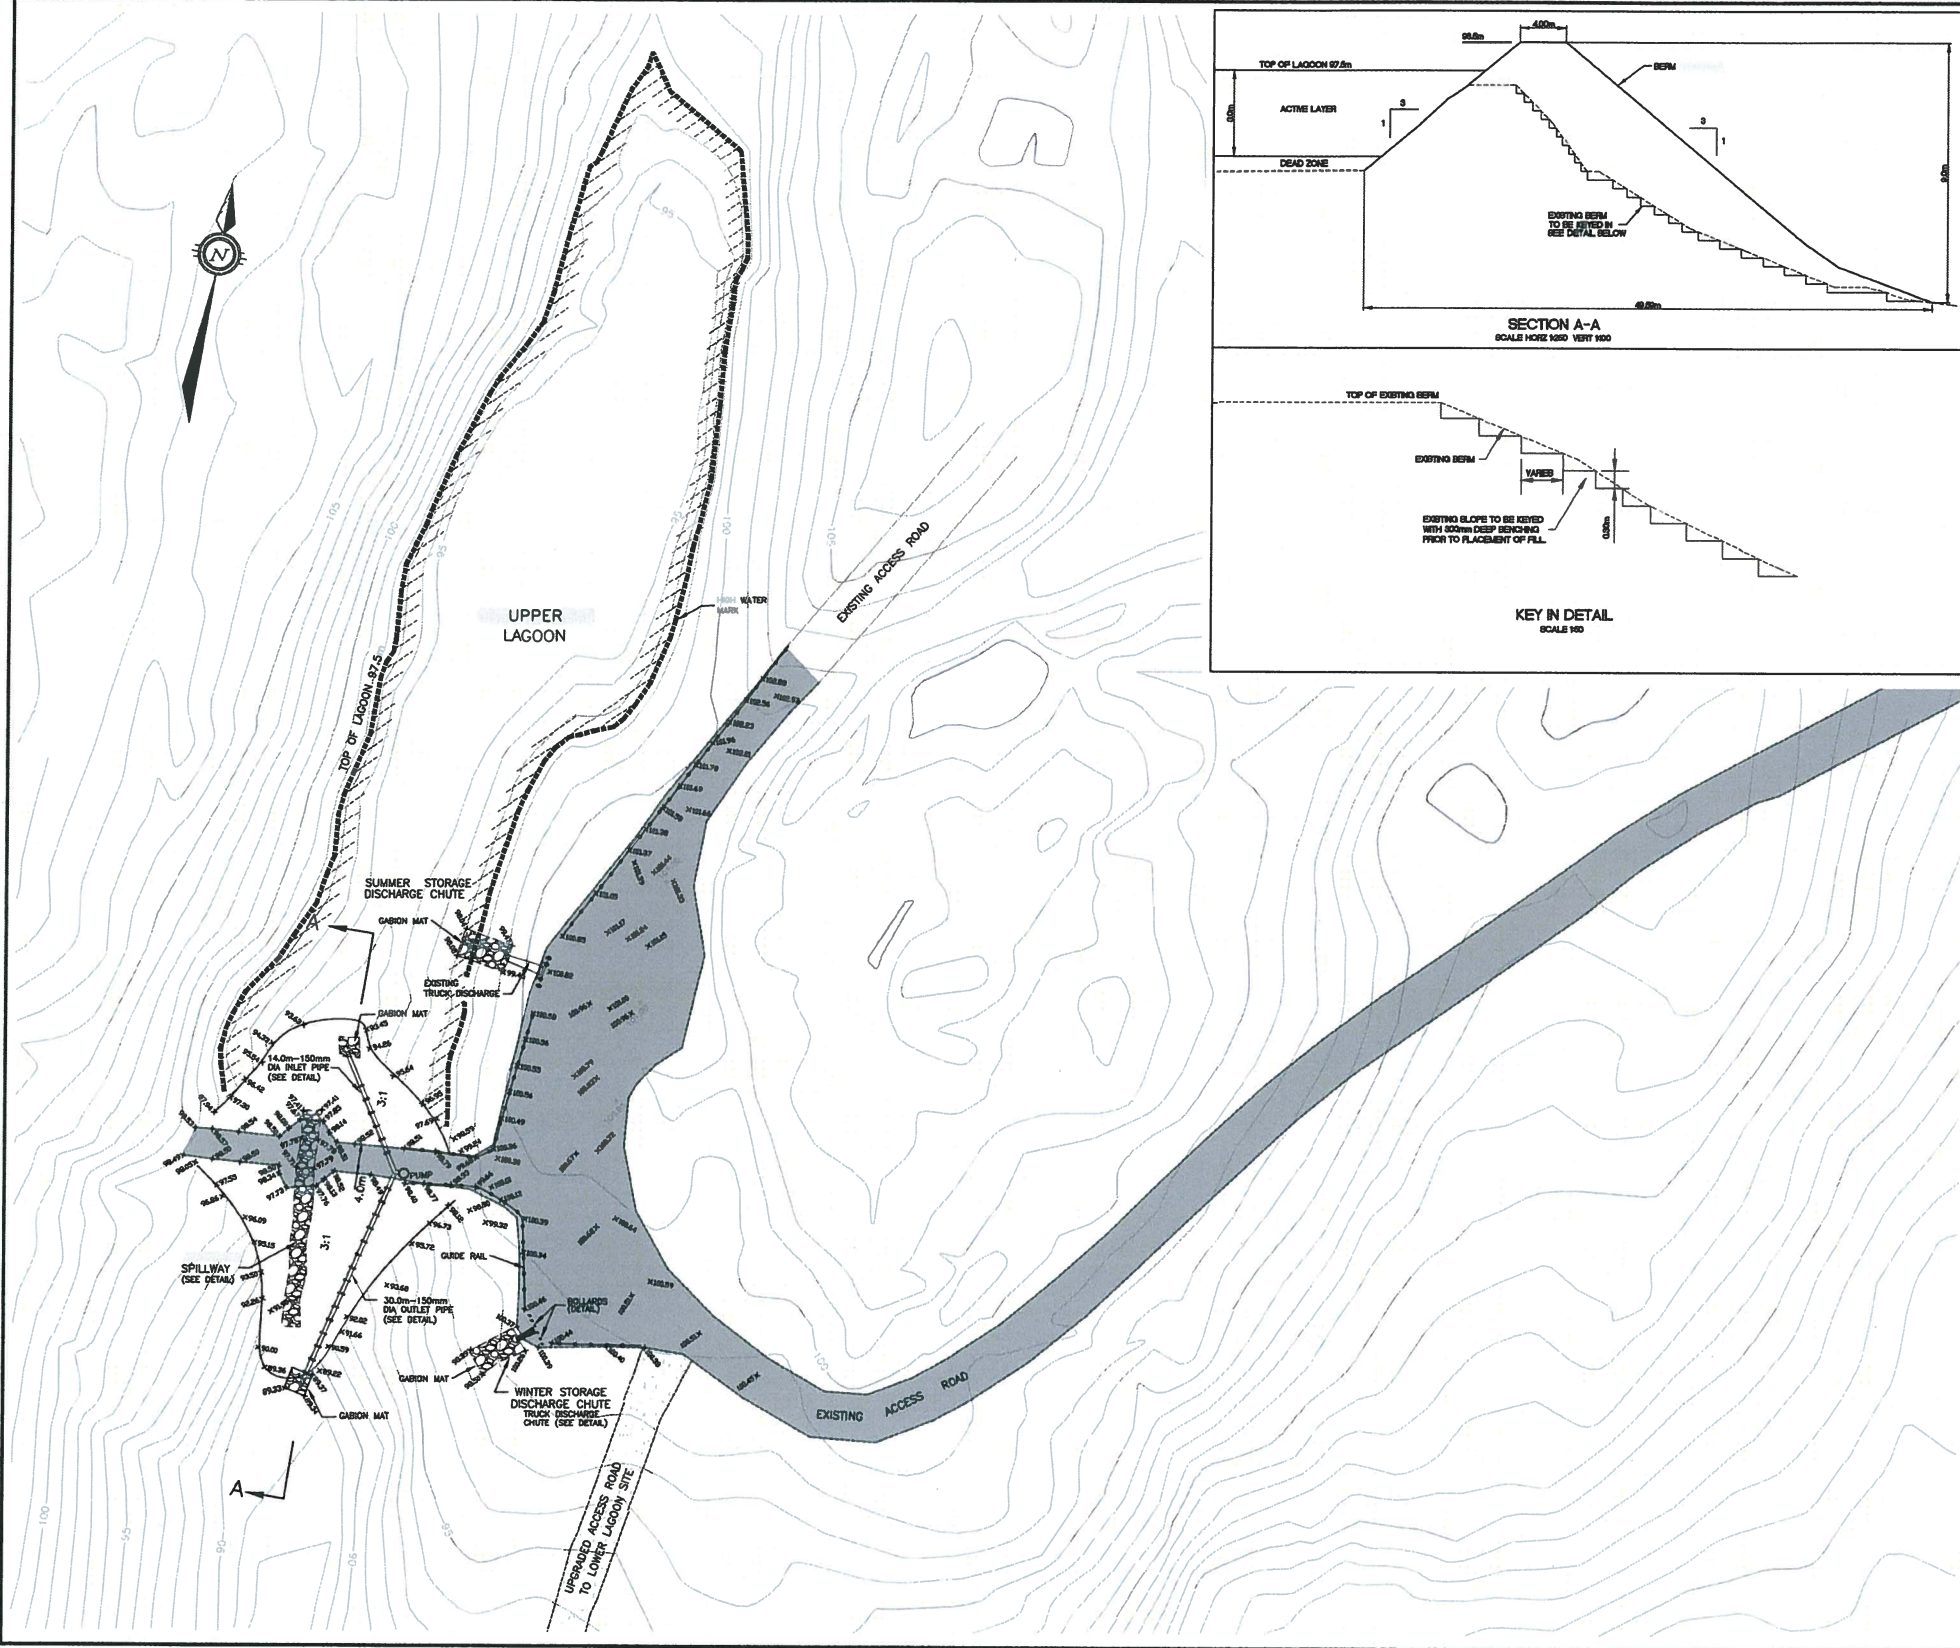

LEGEND

AS-BUILT

DATE: SEPTEMBER 30, 2011

BENCH MARK

BM 1 ELEV. = 102.72m
RE-BM PLANNED EAST OF THE ACCESS ROAD ACROSS FROM THE EXISTING TRUCK DISCHARGE POINT AND 2.5m FROM THE FACE OF THE CHAIN LINK FENCE.

NO.	DESCRIPTION	DATE	BY	APP'D
4	AS-BUILT	30/09/11	SHB	SLB
3	AS-CONSTRUCTED	18/11/11	MEB	SLB
2	ISSUED FOR TENDER	06/04/09	MAR	SLB
1	ISSUED FOR APPROVAL	17/01/08	MEB	SLB

DRAWINGS ORIGINALLY SEALED BY
S.L.BURDEN, P.Eng. OF
exp. SERVICES Inc.
APRIL 6TH, 2009

Trow Associates Inc.
154 Colonnade Road South
Ottawa, Ont. K2E 7J5
Tel: (613) 225-9900
Fax: (613) 225-7337

CLIENT
GOVERNMENT OF NUNAVUT

PROJECT
KIMMIRUT WASTEWATER LAGOON

TITLE
UPPER LAGOON
SITE PLAN

Design by	SAD	Project No.	OTC0000188814
Drawn by	MEB		
Checked by	SLB		
Date	4/01/2008		
Scale	1:400		




SP-2



exp Services Inc.
t: +1.613.688.1899 | f: +1.613.225.7330
2650 Queensview Drive, Unit 100
Ottawa, ON K2B 8H6
Canada
www.exp.com

- BUILDINGS • EARTH & ENVIRONMENT • ENERGY •
- INDUSTRIAL • INFRASTRUCTURE • SUSTAINABILITY •

scale	NTS	CLIENT:	GOVERNMENT OF NUNAVUT	project no.	OTT-00209248-A0
date	20/08/2013	TITLE:	UPPER LAGOON SITE PLAN DAM SAFETY REVIEW KIMMIRUT, NUNAVUT		
drawn by	E.A.				FIG 03

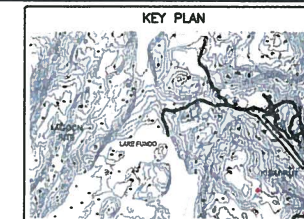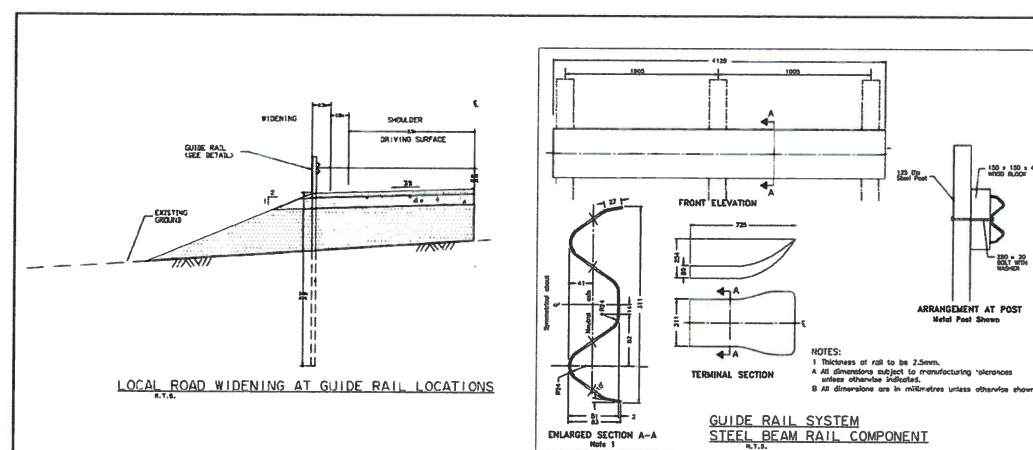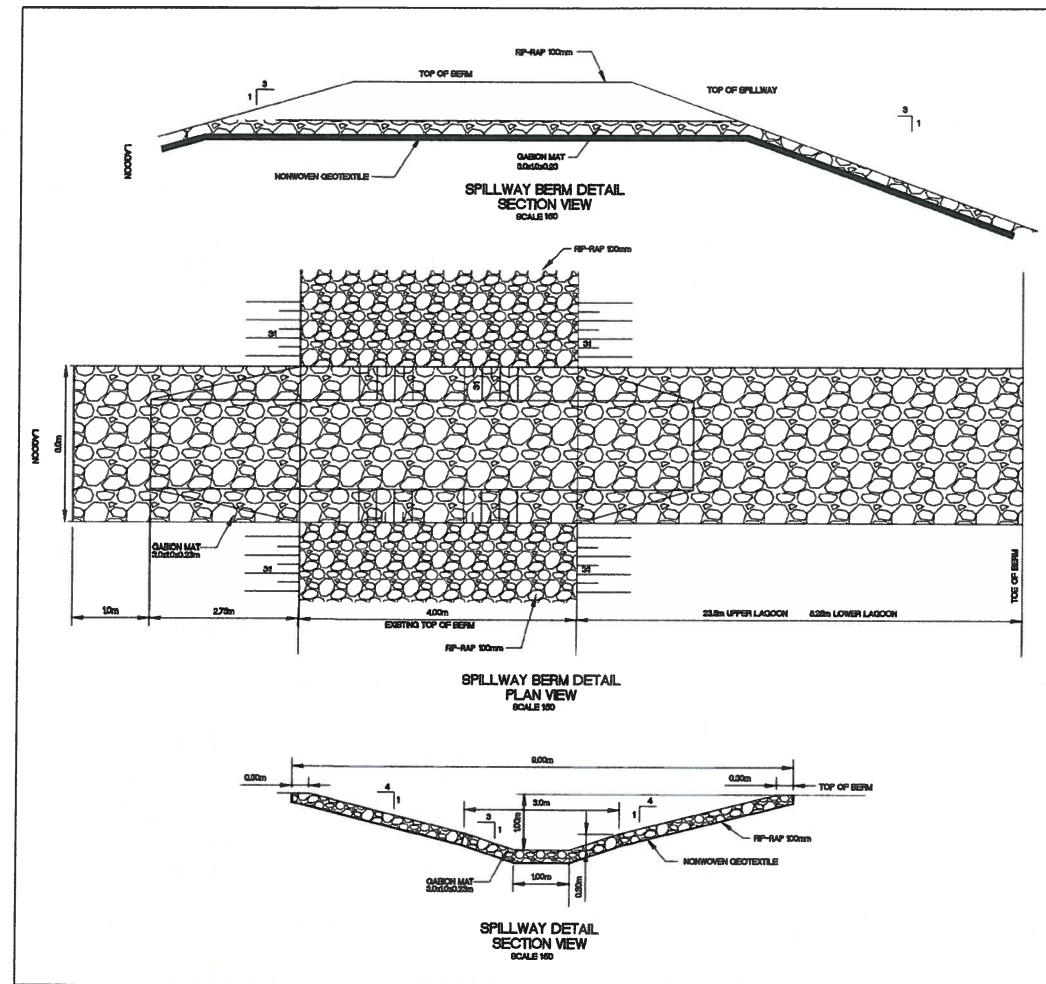

LEGEND

AS-BUILT

DATE: SEPTEMBER 30, 2011

BENCH MARK

BM 1 ELEV. = 102.72m
RE-BAW PLANTED EAST OF THE ACCESS ROAD ADJACENT FROM THE EXISTING TRUCK DISCHARGE POINT AND 2.8m FROM THE FACE OF THE CHAIN LINK FENCE.

No.	DESCRIPTION	DATE	BY	APP'D
4	AS-BUILT	30/09/11	SHB	SLB
3	AS-CONSTRUCTED	18/11/11	MEB	SLB
2	ISSUED FOR TENDER	08/04/09	MAR	SLB
1	ISSUED FOR APPROVAL	17/01/08	MEB	SLB

REVISIONS

DRAWINGS ORIGINALLY
SEALED BY
S.L.BURDEN, P.Eng. OF
exp. SERVICES Inc.
APRIL 6TH, 2009

Trow Associates Inc.
154 Colonnade Road South
Ottawa, Ont. K2E 7J8
Tel: (613) 225-9940
Fax: (613) 225-7337

GOVERNMENT OF NUNAVUT

PROJECT
KIMMIRUT WASTEWATER LAGOON

TITLE
DETAILS

designed by	SAD	project no.	OTC0000188816
drawn by	MEB	drawing no.	DE-2
checked by	SLB		
date	4/01/2008		
notes	AS SHOWN		





exp Services Inc.

t: +1.613.688.1899 | f: +1.613.225.7330
2650 Queensview Drive, Unit 100
Ottawa, ON K2B 8H6
Canada

www.exp.com

- BUILDINGS • EARTH & ENVIRONMENT • ENERGY •
- INDUSTRIAL • INFRASTRUCTURE • SUSTAINABILITY •

scale	NTS	CLIENT:	GOVERNMENT OF NUNAVUT	project no.	OTT-00209248-A0
date	20/08/2013	TITLE:	SPILLWAY DETAILS DAM SAFETY REVIEW KIMMIRUT, NUNAVUT		
drawn by	E.A.				FIG 04

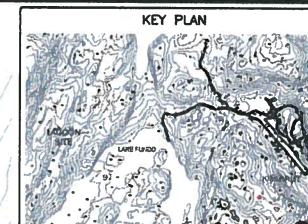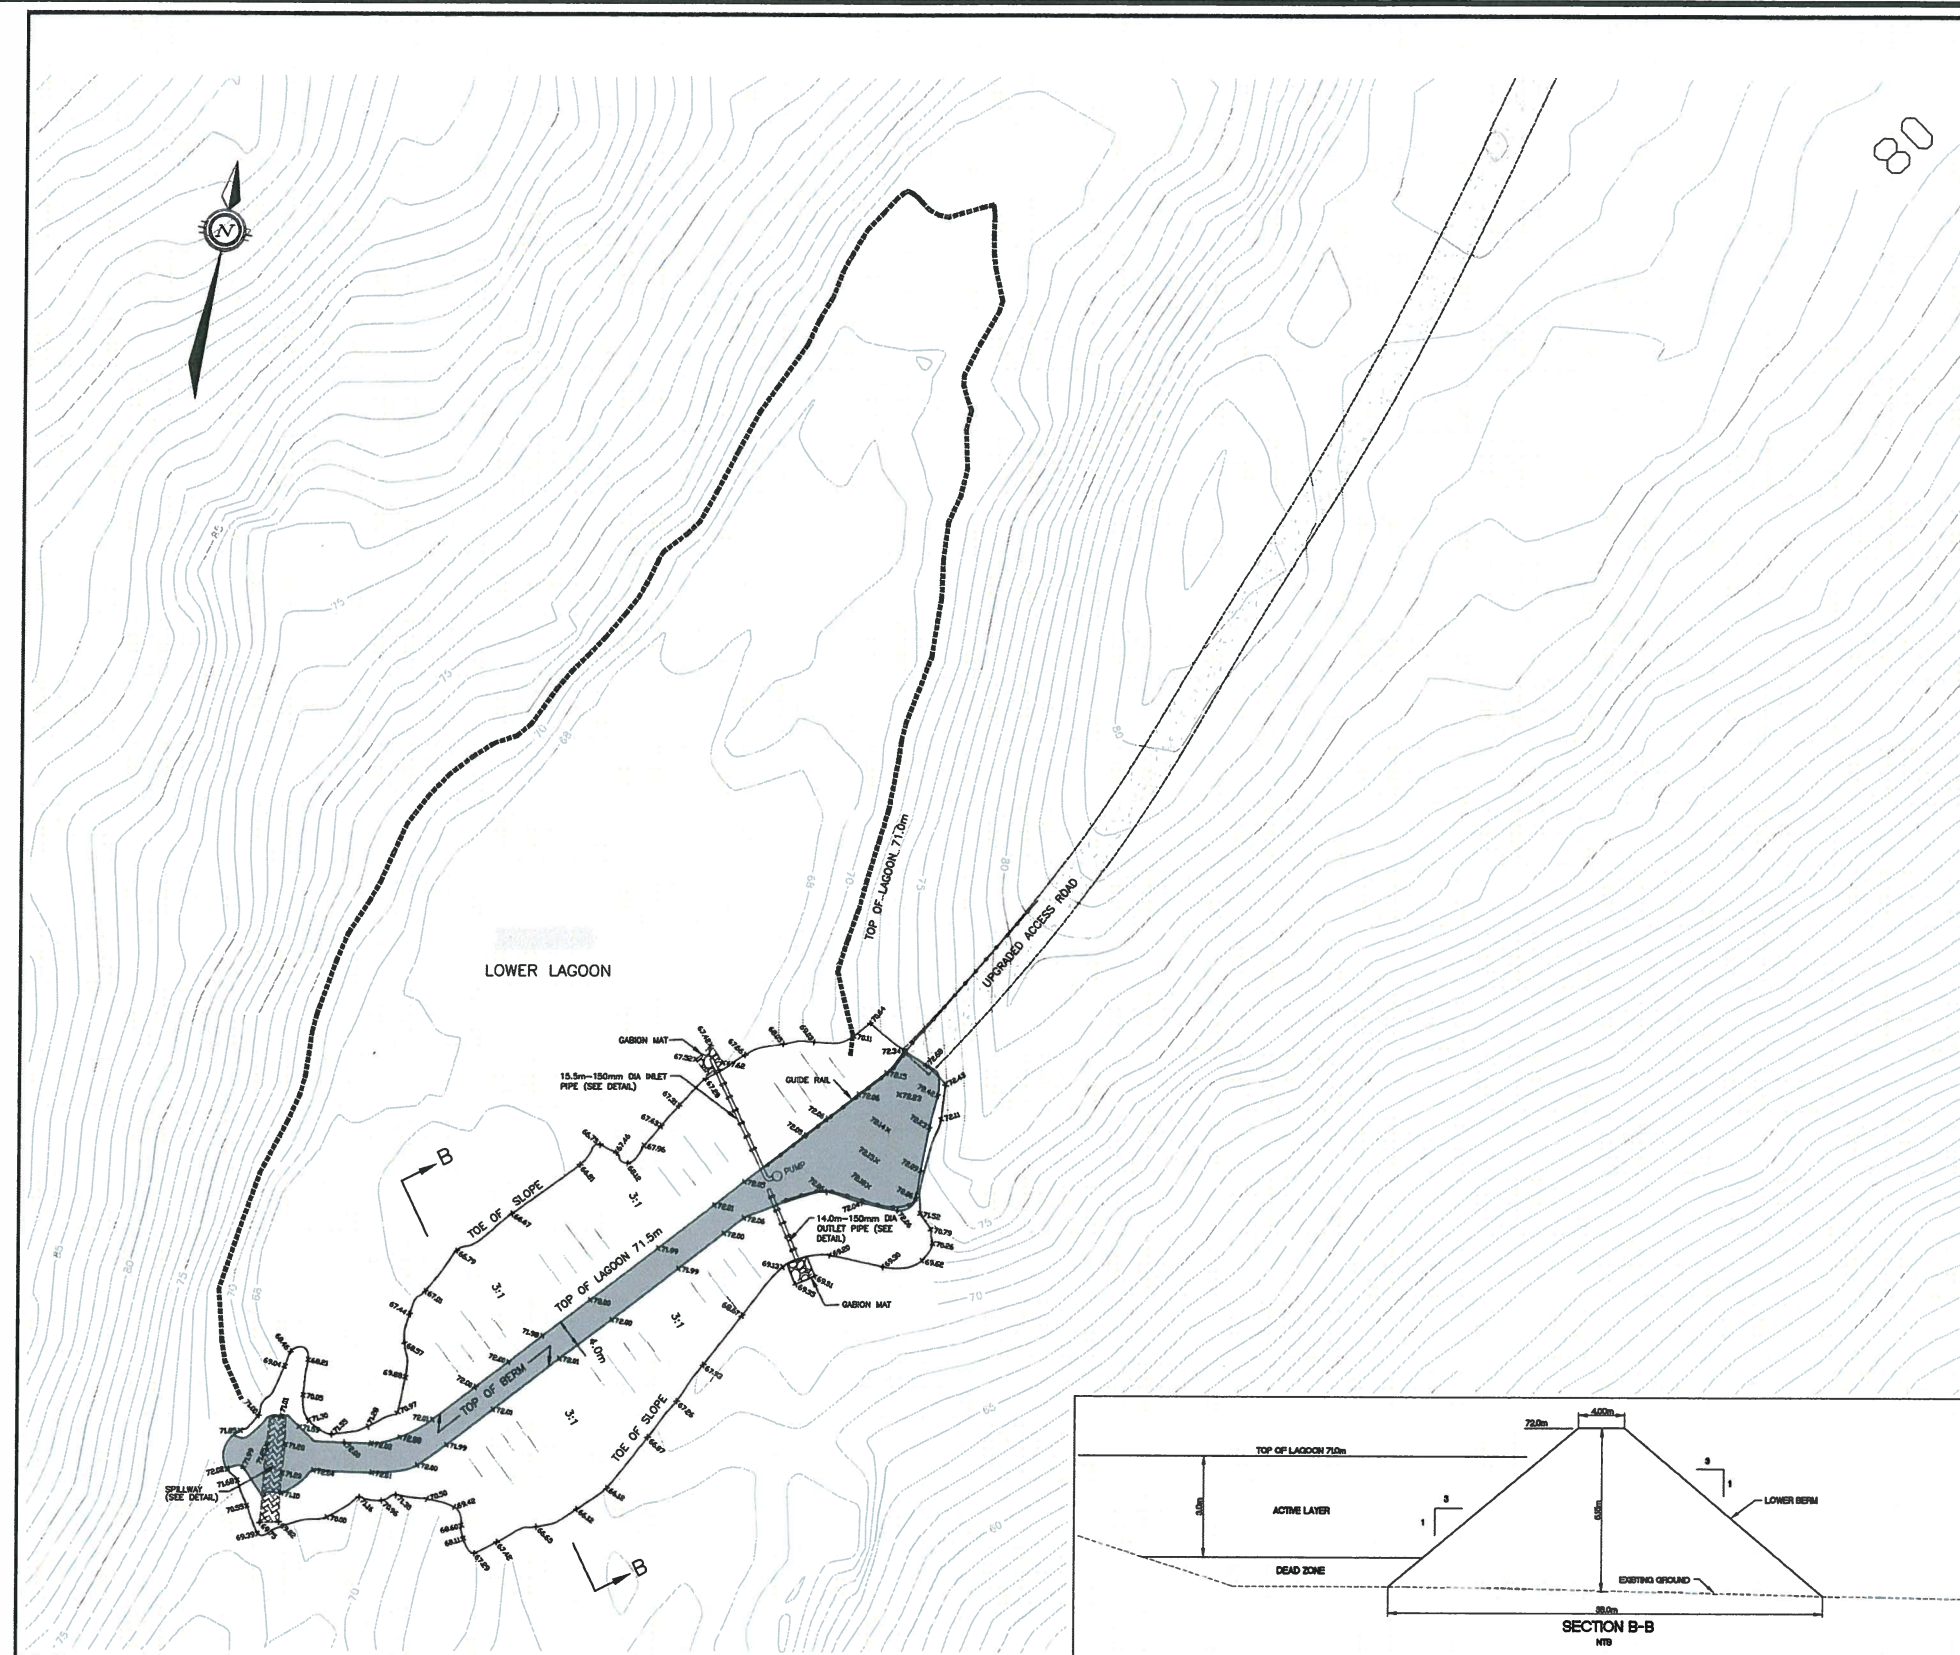

LEGEND

AS-BUILT

DATE: SEPTEMBER 30, 2011

BENCH MARK
 BM 1 ELEV. = 102.72m
 RE-BAR PLANTED EAST OF THE ACCESS ROAD ACROSS FROM THE EXISTING TRUCK DISCHARGE POINT AND 2.5m FROM THE FACE OF THE CHAIN LINK FENCE.

No.	DESCRIPTION	DATE	BY	APP'D
4	AS-BUILT	30/09/11	SAB	SLB
3	AS-CONSTRUCTED	18/11/11	MEB	SLB
2	ISSUED FOR TENDER	06/04/09	MAR	SLB
1	ISSUED FOR APPROVAL	17/01/08	MEB	SLB

DRAWINGS ORIGINALLY SEALED BY
 S.L.BURDEN, P.Eng. OF
 exp. SERVICES Inc.
 APRIL 6TH, 2009

Trow Associates Inc.
 154 Colborne Road South
 Ottawa, Ont. K2E 7J5
 Tel: (613) 223-9940
 Fax: (613) 223-7337


CLIENT
 GOVERNMENT OF NUNAVUT

PROJECT
 KIMMIRUT WASTEWATER LAGOON

TITLE
 LOWER LAGOON
 SITE PLAN

Design by: SAB
 Drawn by: MEB
 Checked by: SLB
 Date: 4/01/2008
 Scale: HORIZ. 1:400


Project No: OTT0000188514
 Drawing No: SP-3

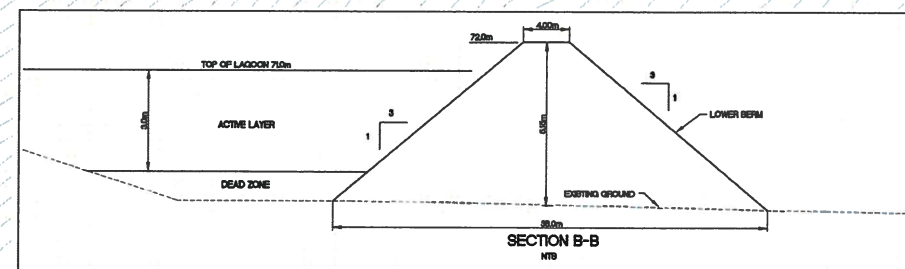

exp Services Inc.
 t: +1.613.688.1899 | f: +1.613.225.7330
 2650 Queensview Drive, Unit 100
 Ottawa, ON K2B 8H6
 Canada
 www.exp.com

- BUILDINGS • EARTH & ENVIRONMENT • ENERGY •
- INDUSTRIAL • INFRASTRUCTURE • SUSTAINABILITY •

scale NTS	CLIENT: GOVERNMENT OF NUNAVUT	project no. OTT-00209248-A0
date 20/08/2013	TITLE: LOWER LAGOON SITE PLAN DAM SAFETY REVIEW KIMMIRUT, NUNAVUT	FIG 05
drawn by E.A.		

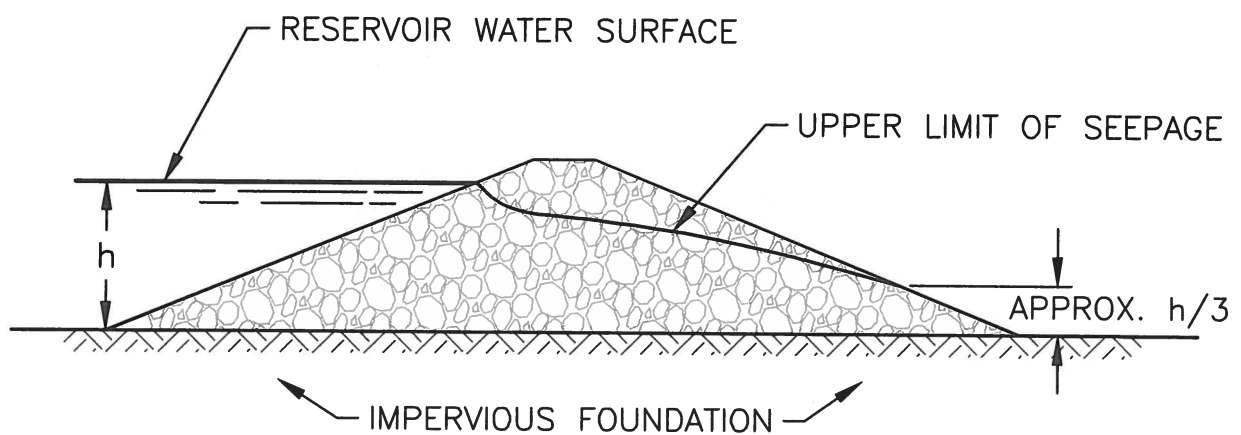


exp Services Inc.

t: +1.613.688.1899 | f: +1.613.225.7330
2650 Queensview Drive, Unit 100
Ottawa, ON K2B 8H6
Canada

www.exp.com

• BUILDINGS • EARTH & ENVIRONMENT • ENERGY •
• INDUSTRIAL • INFRASTRUCTURE • SUSTAINABILITY •


scale NTS	CLIENT: GOVERNMENT OF NUNAVUT	project no. OTT-00209248-A0
date 20/08/2013	TITLE: UPPER LIMIT OF SEEPAGE THROUGH DAM DAM SAFETY REVIEW KIMMIRUT, NUNAVUT	FIG 06
drawn by E.A.		

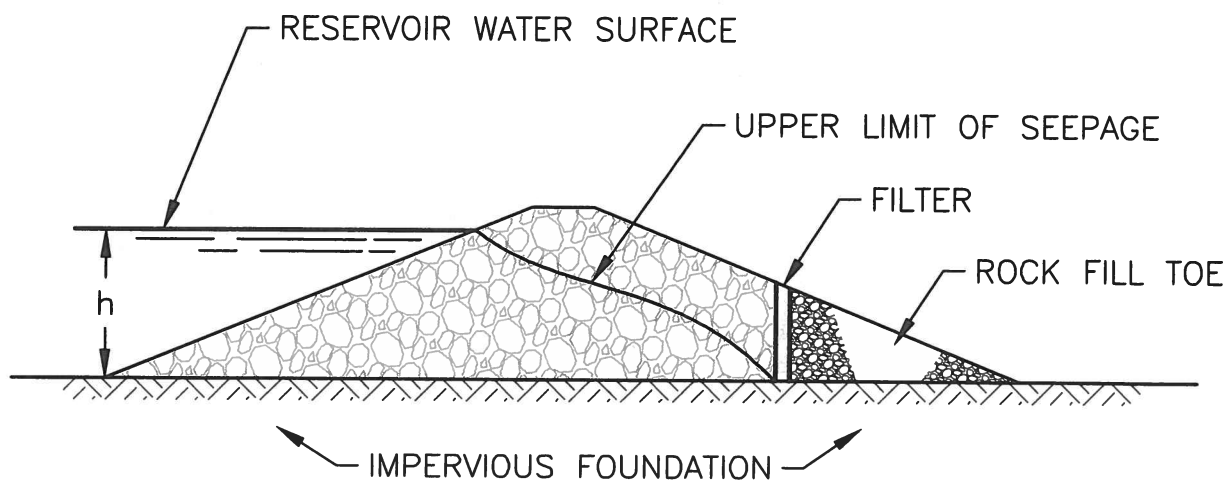

exp Services Inc.
 t: +1.613.688.1899 | f: +1.613.225.7330
 2650 Queensview Drive, Unit 100
 Ottawa, ON K2B 8H6
 Canada
www.exp.com

• BUILDINGS • EARTH & ENVIRONMENT • ENERGY •
 • INDUSTRIAL • INFRASTRUCTURE • SUSTAINABILITY •

scale NTS	CLIENT: GOVERNMENT OF NUNAVUT	project no. OTT-00209248-A0
date 20/08/2013	TITLE: ROCKFILL TOE REMEDIATION OPTION DAM SAFETY REVIEW KIMMIRUT, NUNAVUT	FIG 07
drawn by E.A.		

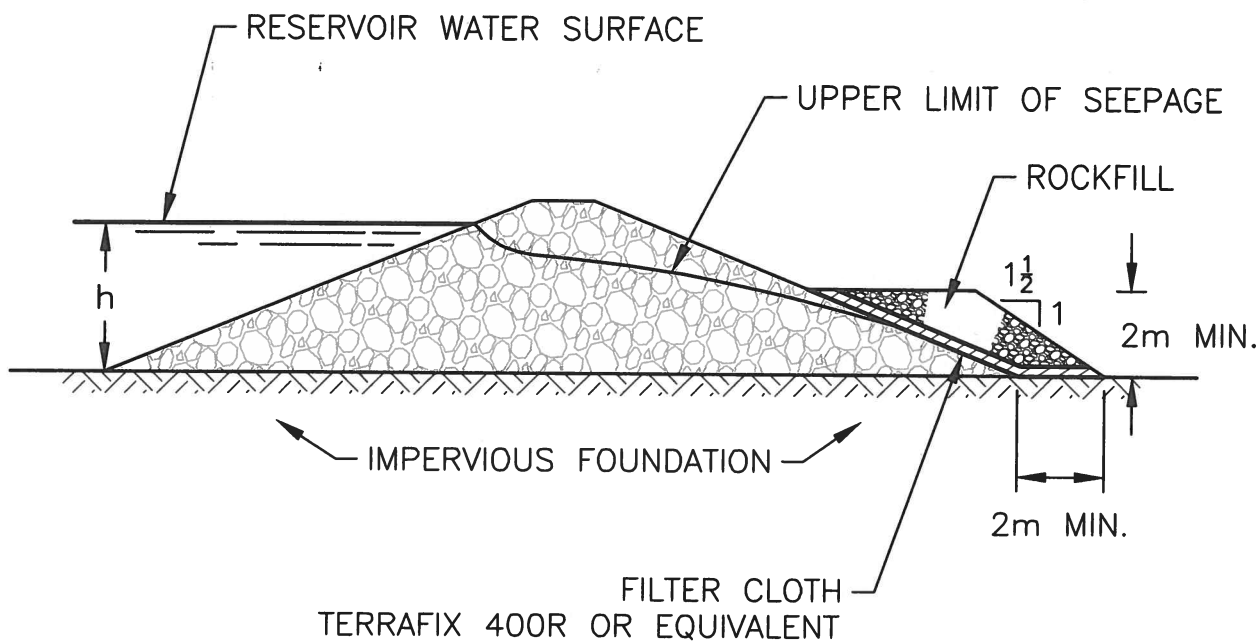

exp Services Inc.

t: +1.613.688.1899 | f: +1.613.225.7330
2650 Queensview Drive, Unit 100
Ottawa, ON K2B 8H6
Canada

www.exp.com

• BUILDINGS • EARTH & ENVIRONMENT • ENERGY •
• INDUSTRIAL • INFRASTRUCTURE • SUSTAINABILITY •

scale NTS	CLIENT: GOVERNMENT OF NUNAVUT	project no. OTT-00209248-A0
date 20/08/2013	TITLE: ROCKFILL BENCH REMEDIATION OPTION DAM SAFETY REVIEW KIMMIRUT, NUNAVUT	FIG 08
drawn by E.A.		