
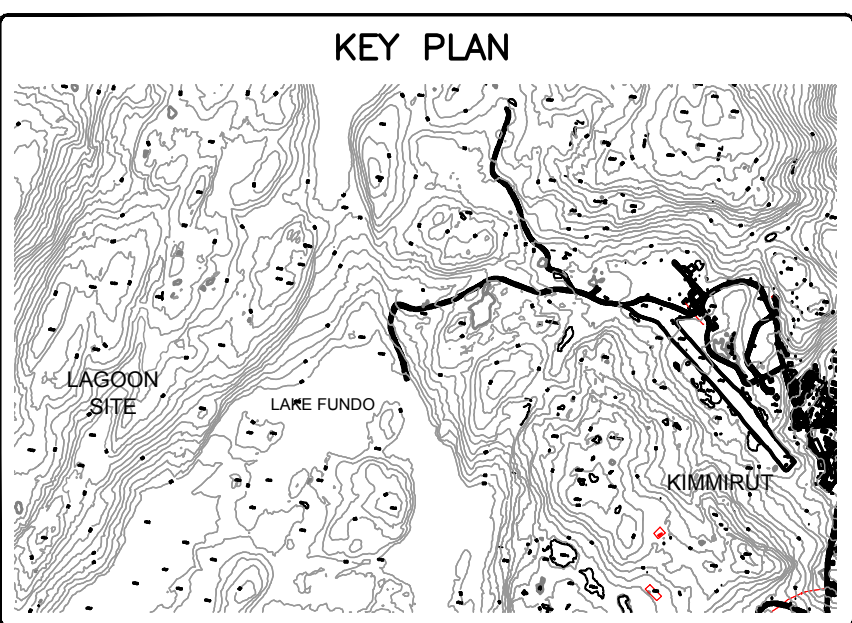
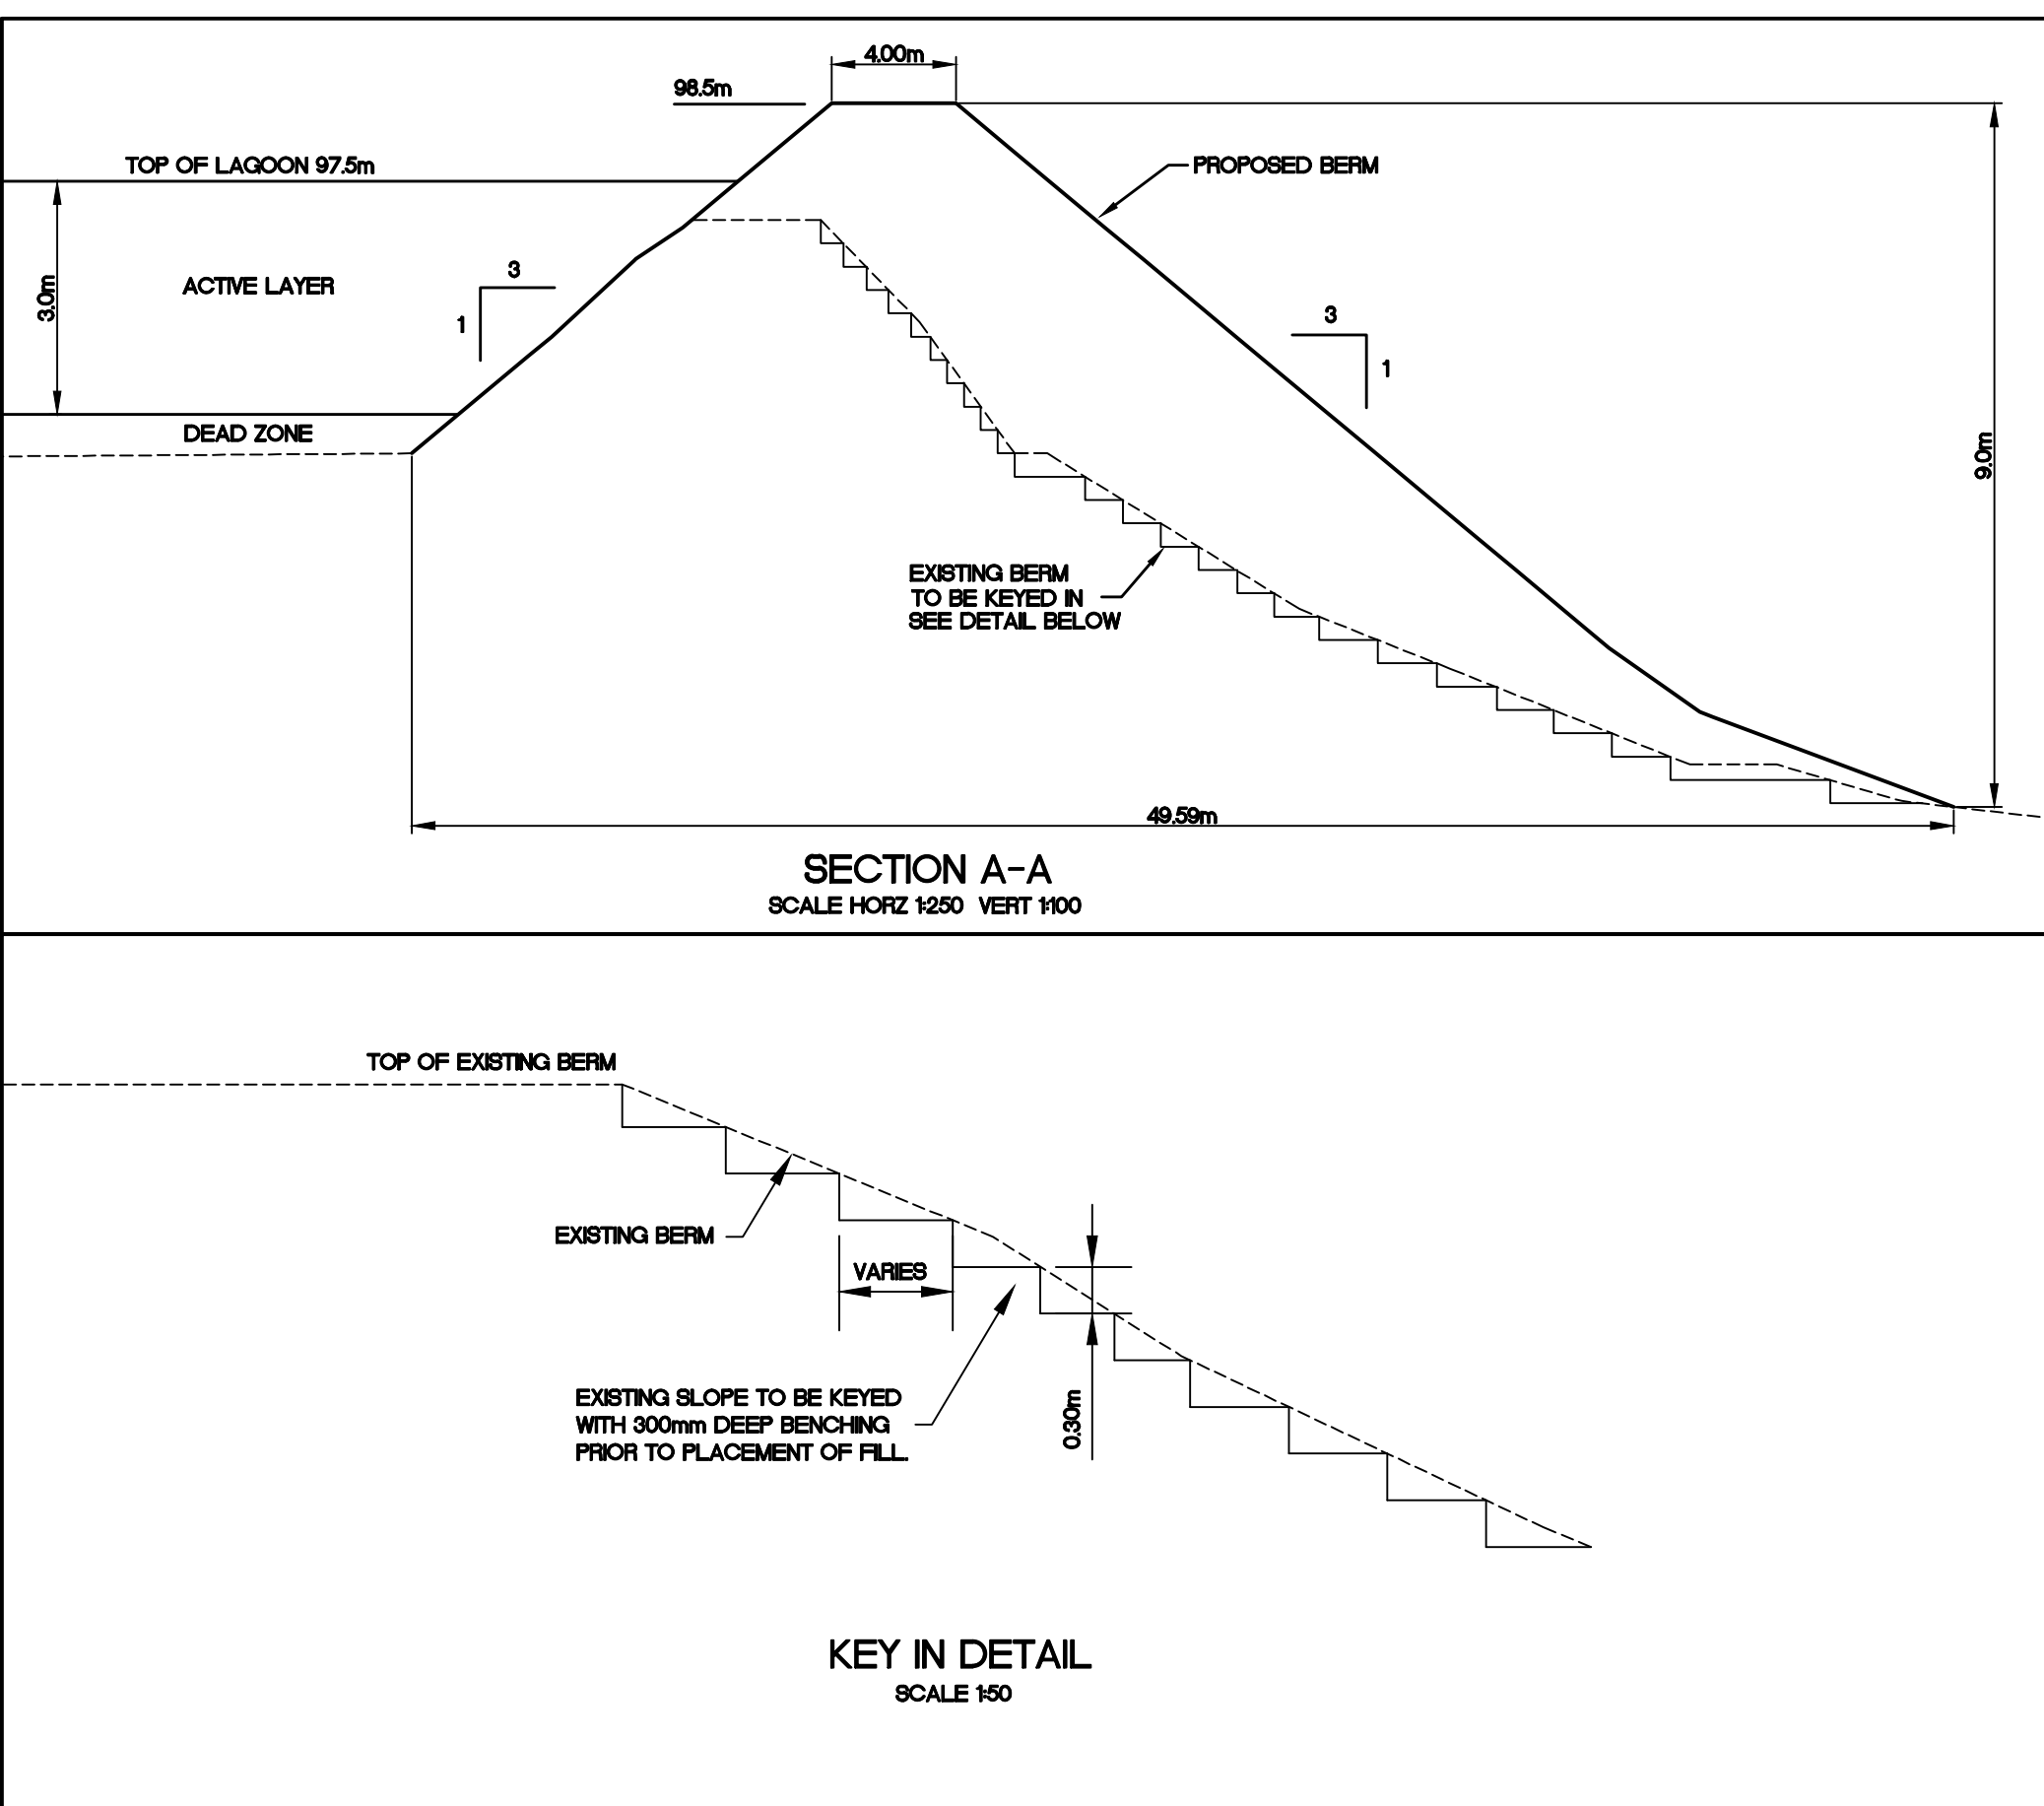
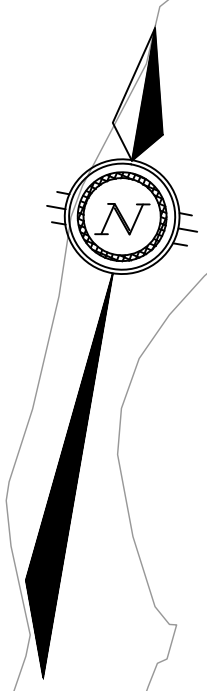


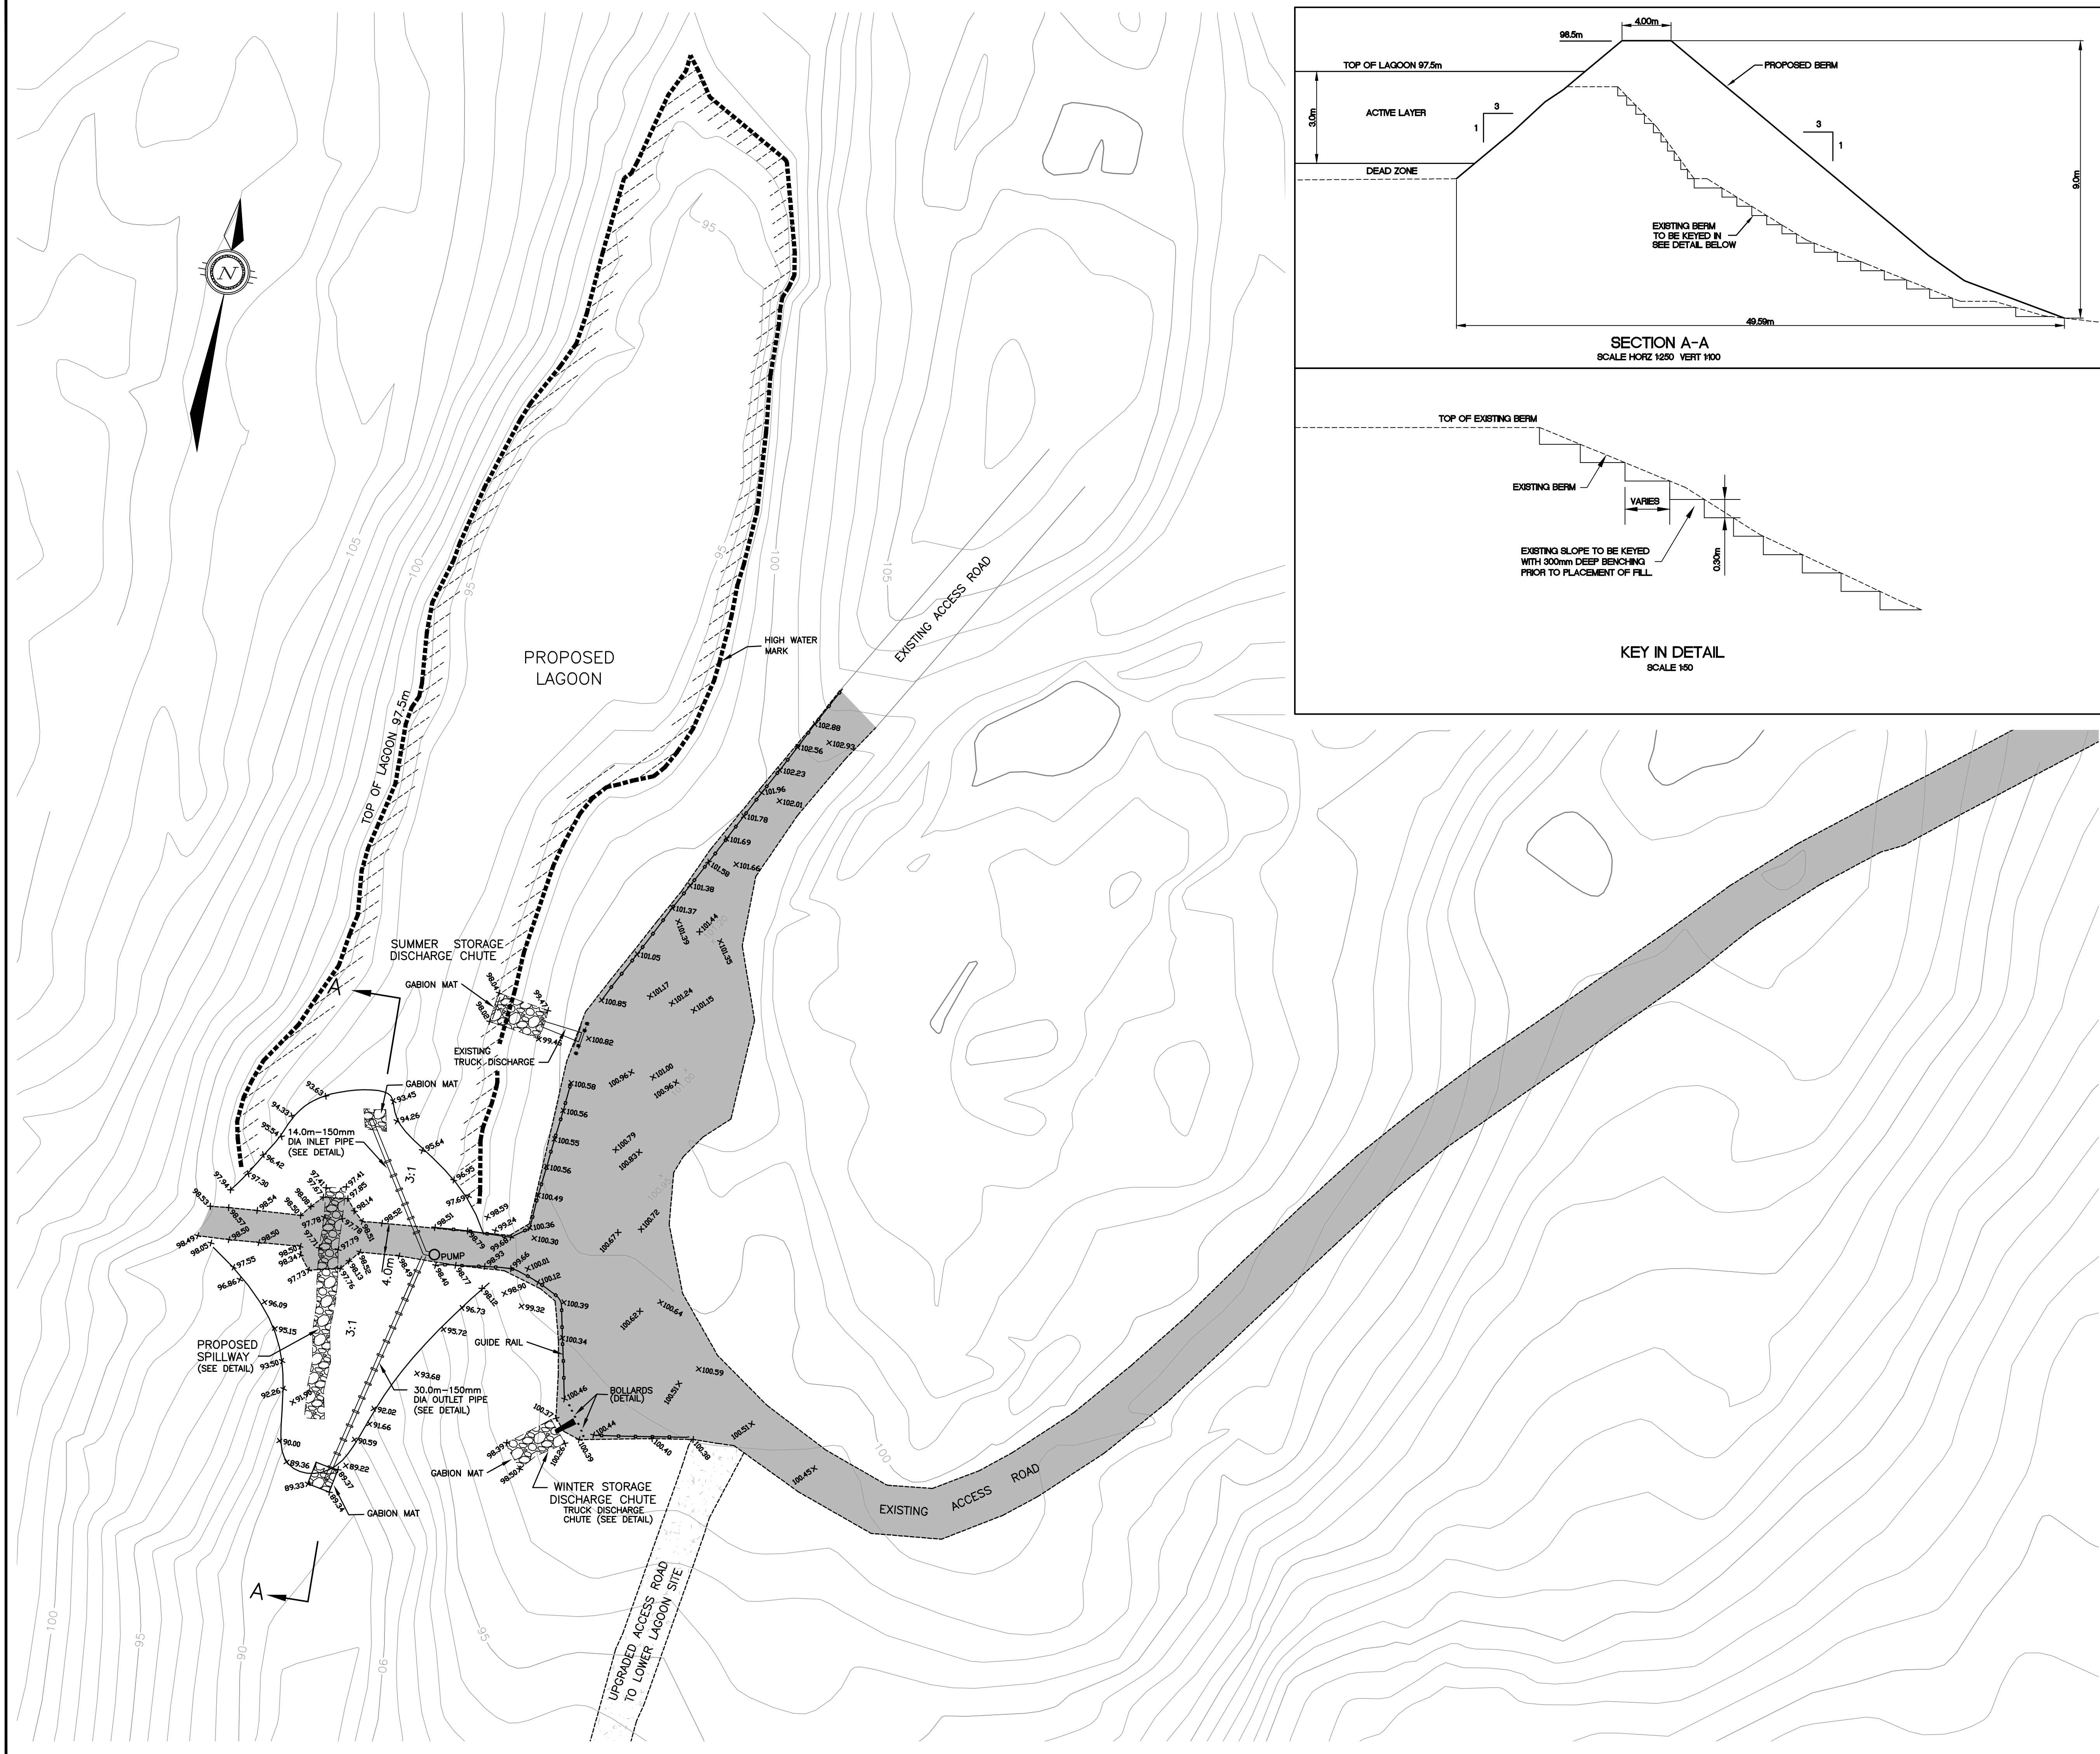

LEGEND

**AS-BUILT**  
DATE: SEPTEMBER 30, 2011

BENCH MARK  
BM 1 ELEV. = 102.72m  
RE-BAR PLANTED EAST OF THE ACCESS ROAD ACROSS FROM THE EXISTING TRUCK DISCHARGE POINT AND 2.9m FROM THE FACE OF THE CHAIN LINK FENCE.

| No. | DESCRIPTION         | DATE     | BY  | APP'D |
|-----|---------------------|----------|-----|-------|
| 4   | AS-BUILT            | 30/09/11 | SAB | SLB   |
| 3   | AS-CONSTRUCTED      | 18/11/11 | MEB | SLB   |
| 2   | ISSUED FOR TENDER   | 06/04/09 | MMR | SLB   |
| 1   | ISSUED FOR APPROVAL | 17/01/08 | MEB | SLB   |

DRAWINGS ORIGINALLY SEALED BY  
S.L.BURDEN, P.eng. OF  
exp. SERVICES Inc.  
APRIL 6TH, 2009

**Trow Associates Inc.**  
154 Colonnade Road South  
Ottawa, Ont. K2E 7J5  
Tel:(613)225-9940  
Fax:(613)225-7337

CLIENT  
GOVERNMENT OF NUNAVUT

|                                       |                              |
|---------------------------------------|------------------------------|
| PROJECT<br>KIMMIRUT WASTEWATER LAGOON |                              |
| TITLE<br>UPPER LAGOON<br>SITE PLAN    |                              |
| design by<br>SAD                      | project no.<br>OTCD000188814 |
| drawn by<br>MEB                       | drawing no.                  |
| checked by<br>SLB                     |                              |
| date<br>4/01/2008                     |                              |
| scale<br>HORIZ 1:400                  |                              |