


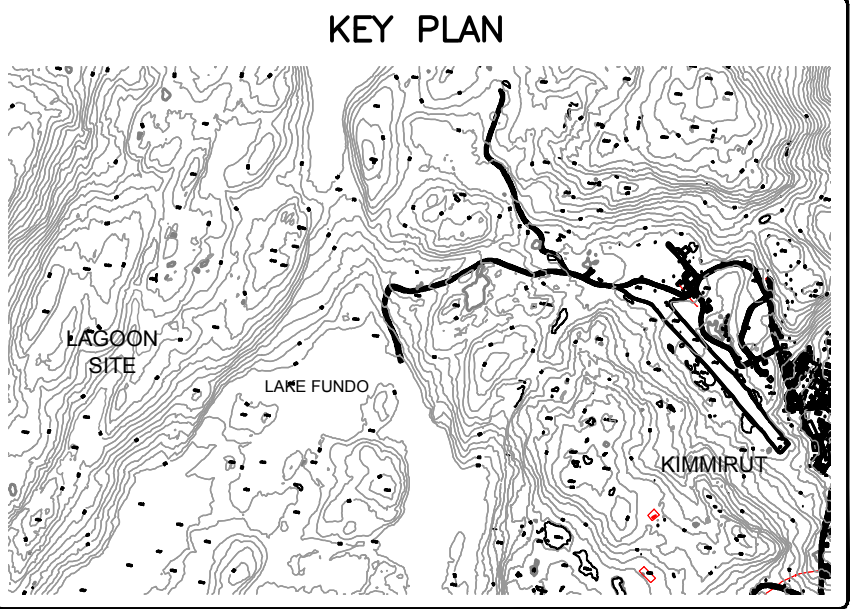

LEGEND

AS-BUILT

DATE: SEPTEMBER 30, 2011

BENCH MARK
BM 1 ELEV. = 102.72m
RE-BAR PLANTED EAST OF THE ACCESS ROAD ACROSS FROM THE EXISTING TRUCK DISCHARGE POINT AND 2.9m FROM THE FACE OF THE CHAIN LINK FENCE.

No.	DESCRIPTION	DATE	BY	APP'D
4	AS-BUILT	30/09/11	SAB	SLB
3	AS-CONSTRUCTED	18/11/11	MEB	SLB
2	ISSUED FOR TENDER	06/04/09	MMR	SLB
1	ISSUED FOR APPROVAL	17/01/08	MEB	SLB

DRAWINGS ORIGINALLY SEALED BY
S.L.BURDEN, P.eng. OF
exp. SERVICES Inc.
APRIL 6TH, 2009

Trow Associates Inc.
154 Colonnade Road South
Ottawa, Ont. K2E 7J5
Tel:(613)225-9940
Fax:(613)225-7337

CLIENT
GOVERNMENT OF NUNAVUT

PROJECT	KIMMIRUT WASTEWATER LAGOON		
TITLE	LOWER LAGOON SITE PLAN		
design by	SAD	project no.	OTCD000188814
drawn by	MEB	drawing no.	SP-3
checked by	SLB		
date	4/01/2008		
scale	HORIZ 1:400		