

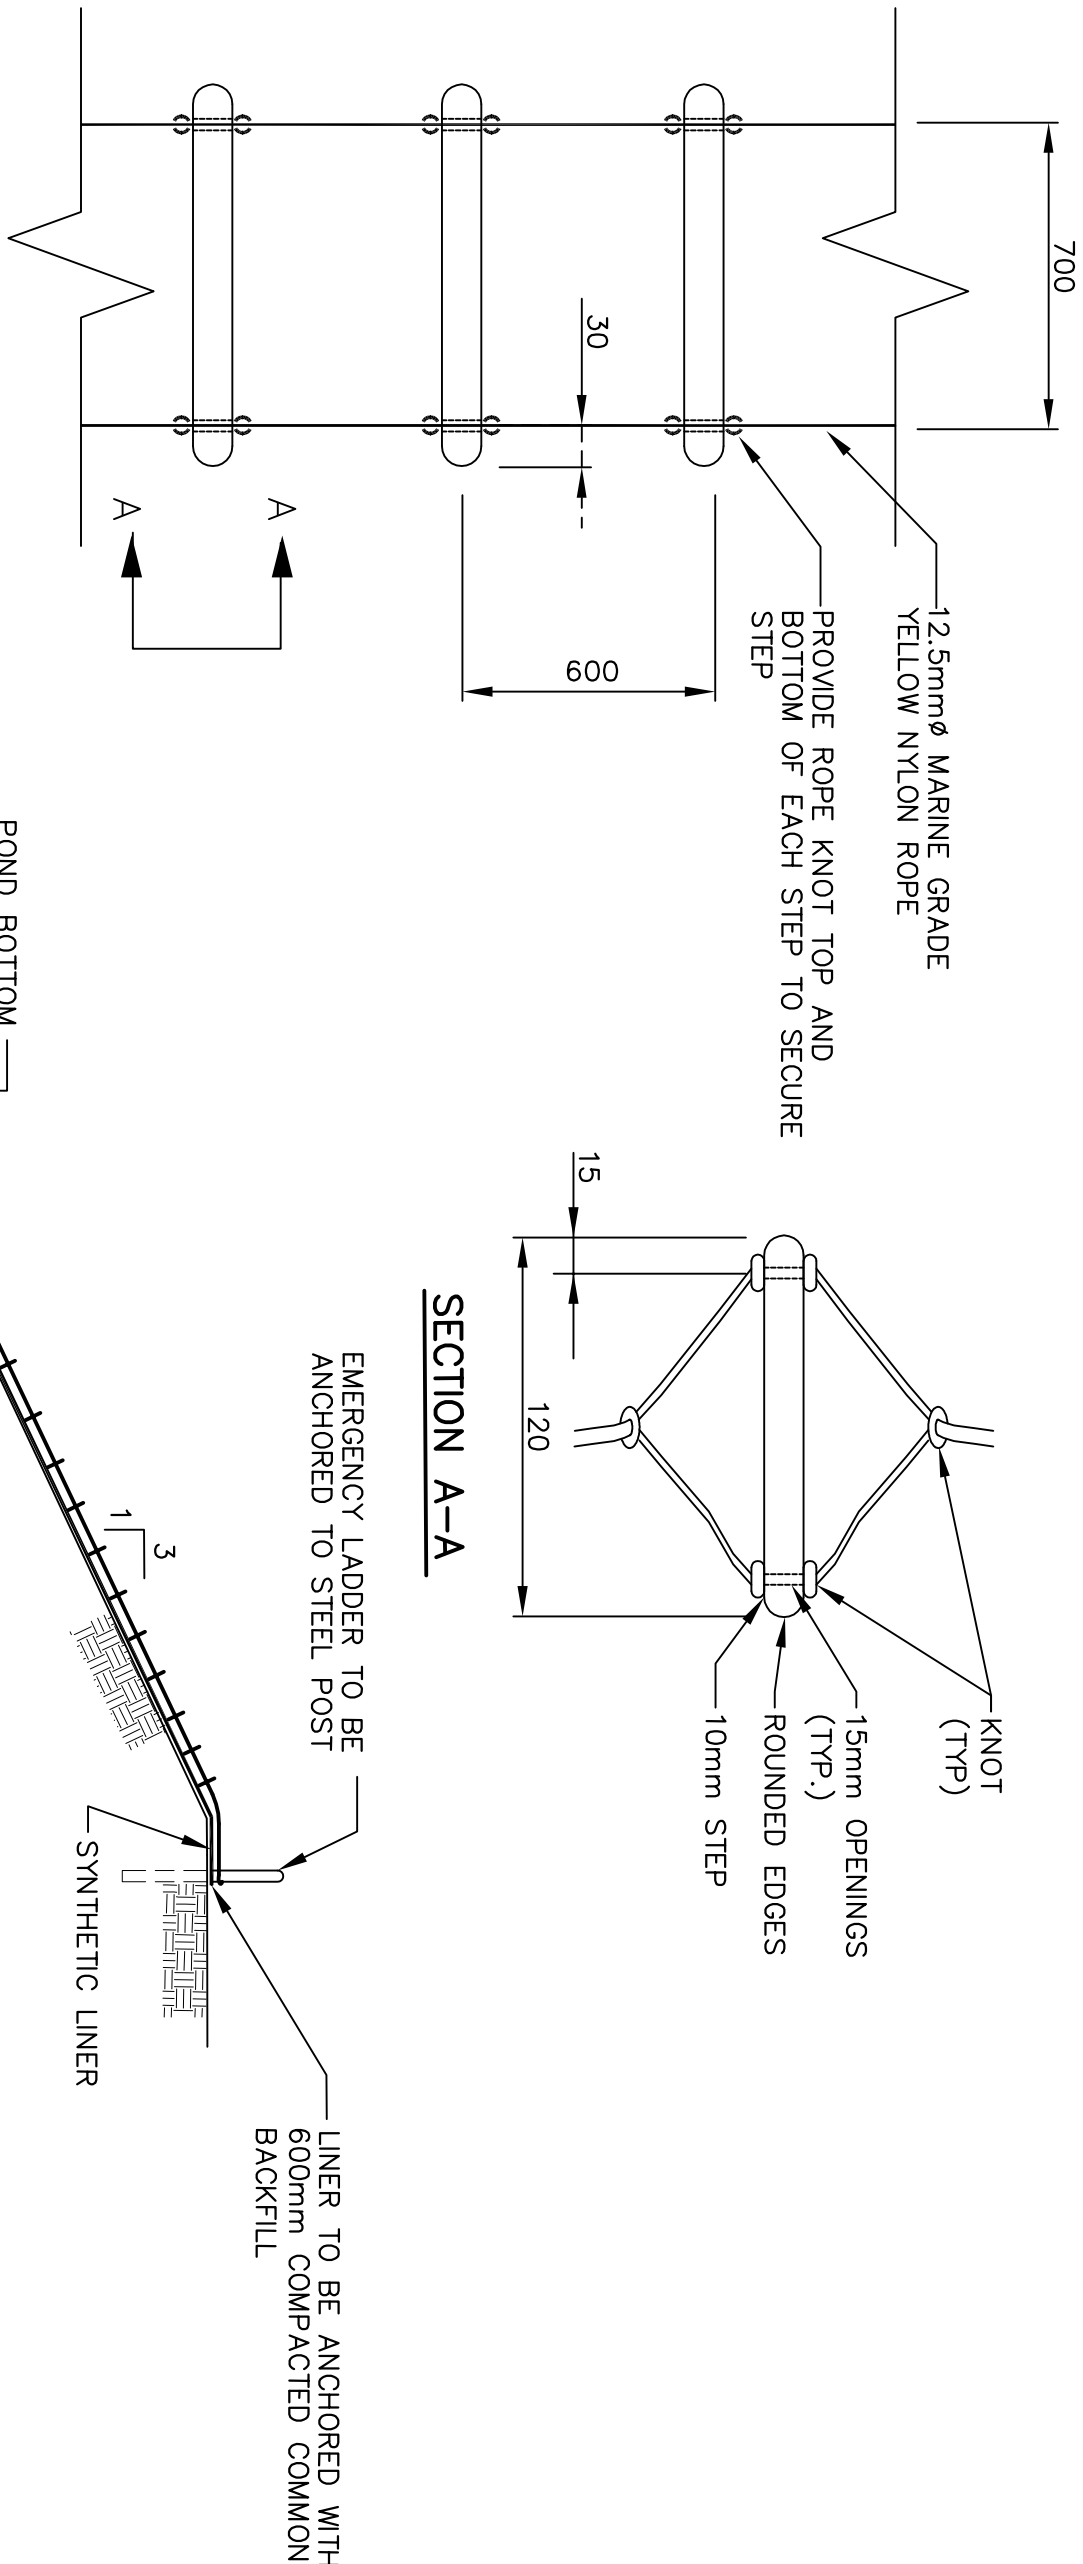
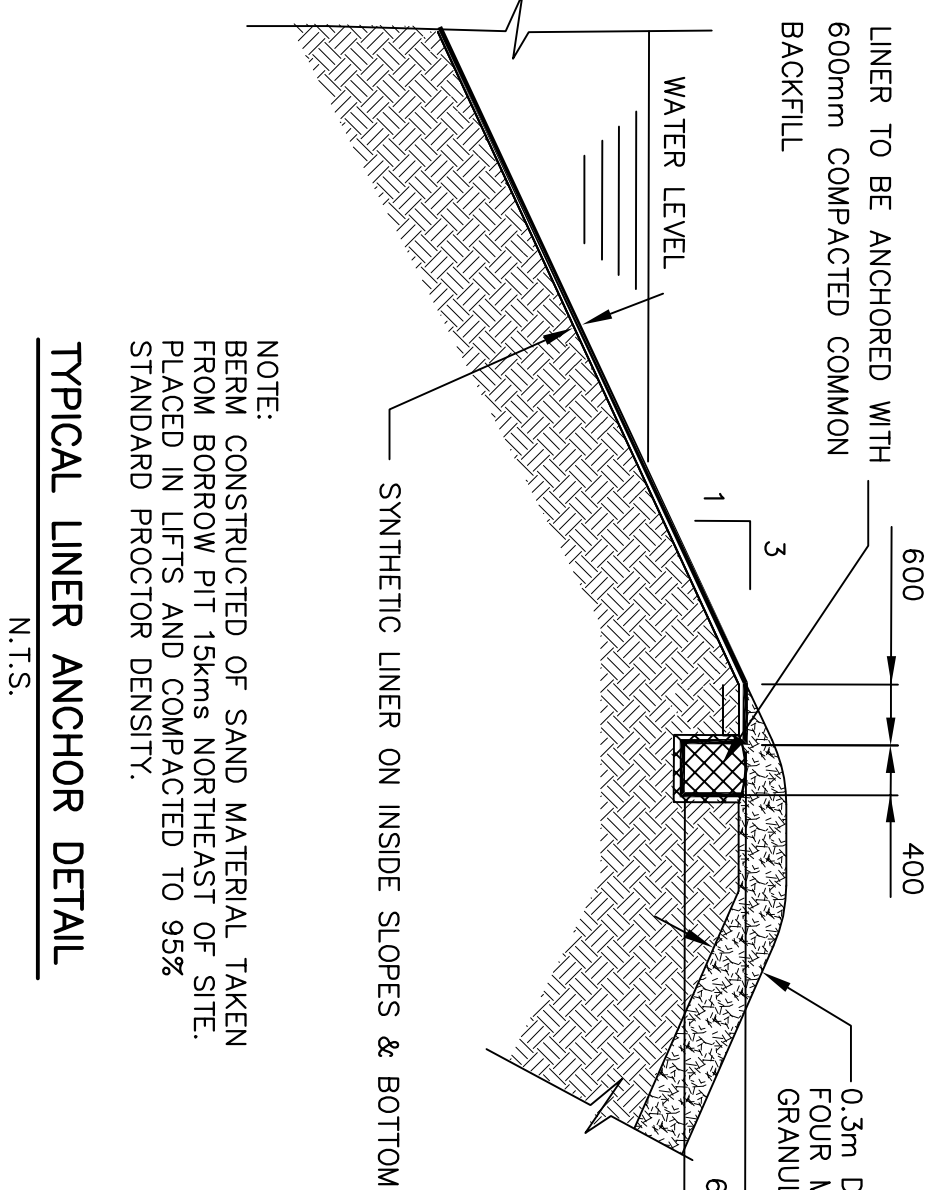



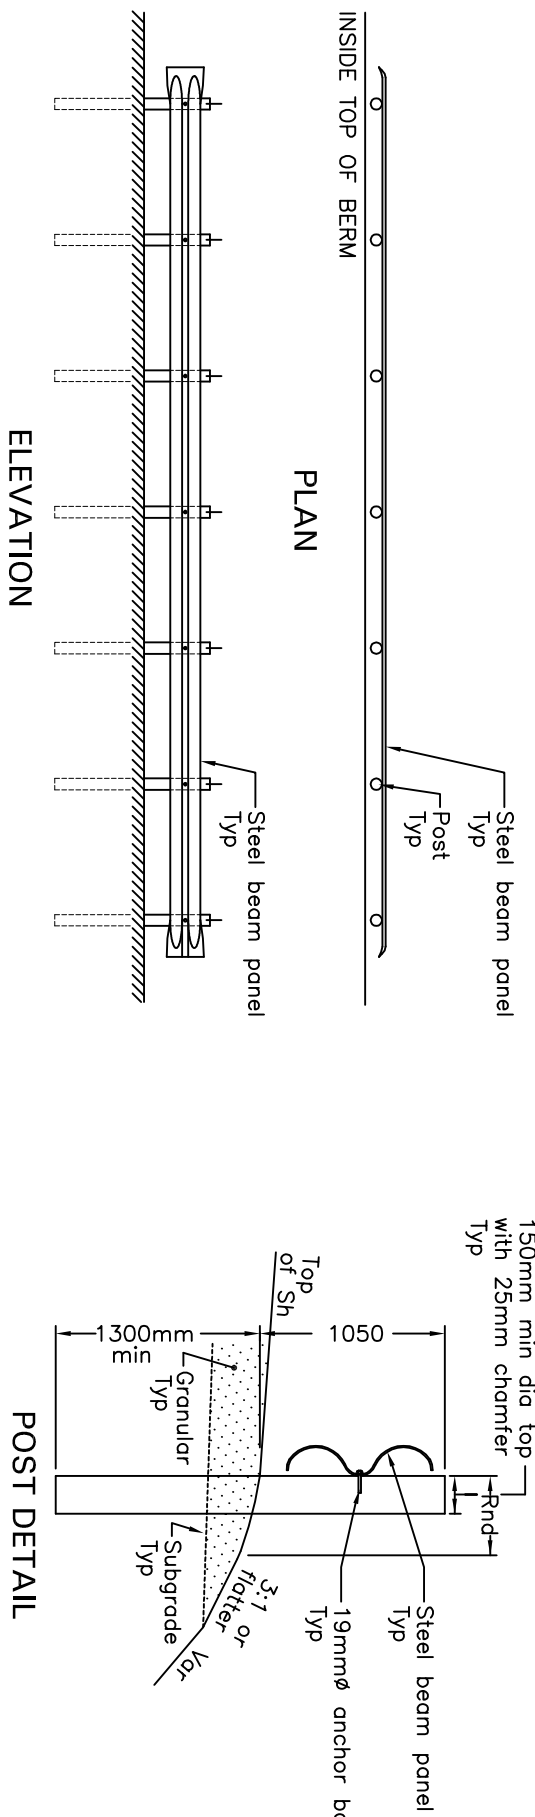


EMERGENCY LADDER DETAILS

N.T.S.

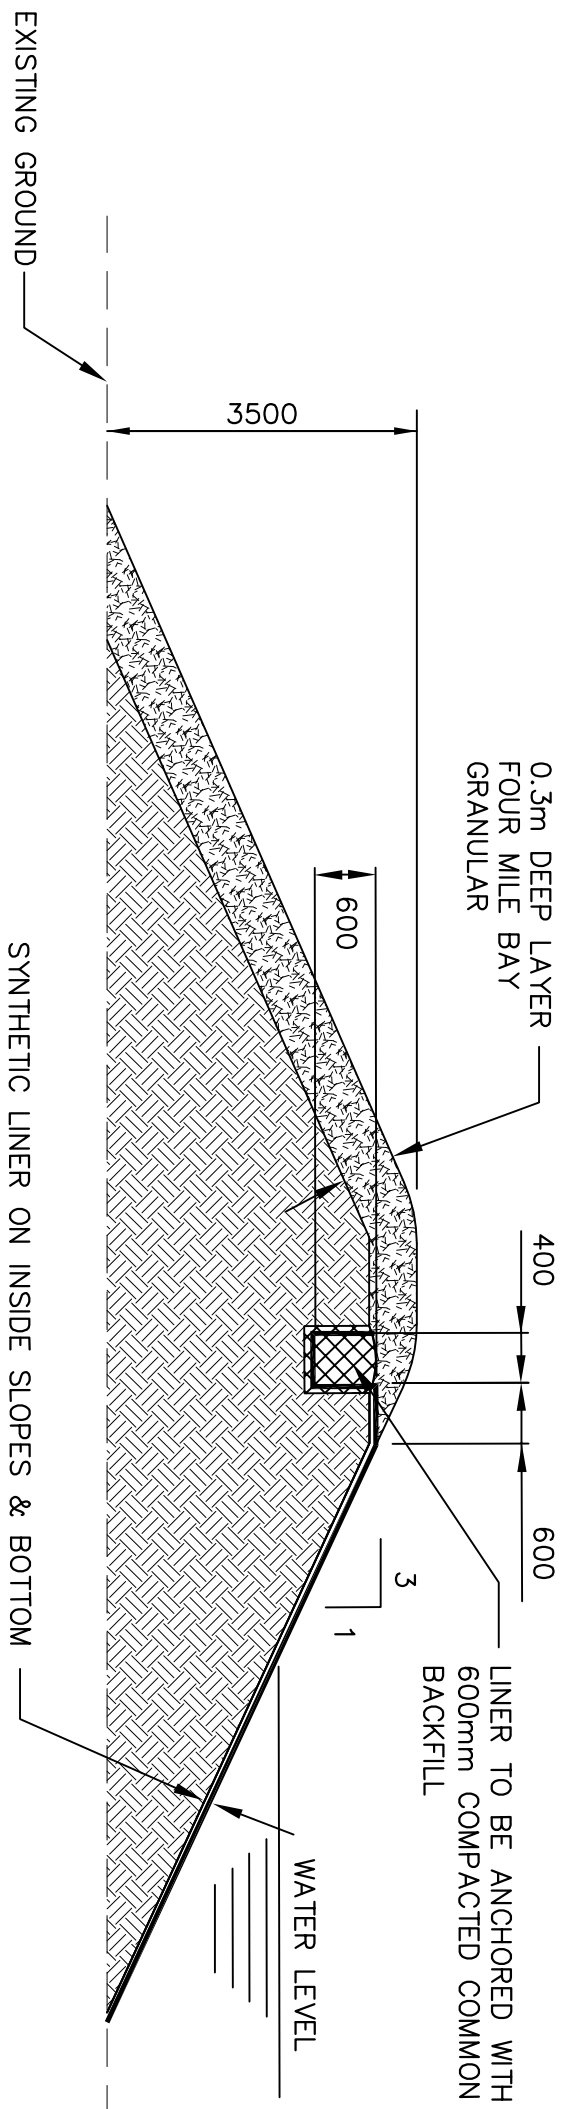

NOTE:
BERM CONSTRUCTED OF SAND MATERIAL TAKEN FROM BORROW PIT 15kms NORTHEAST OF SITE. PLACED IN LIFTS AND COMPACTED TO 95% STANDARD PROCTOR DENSITY.

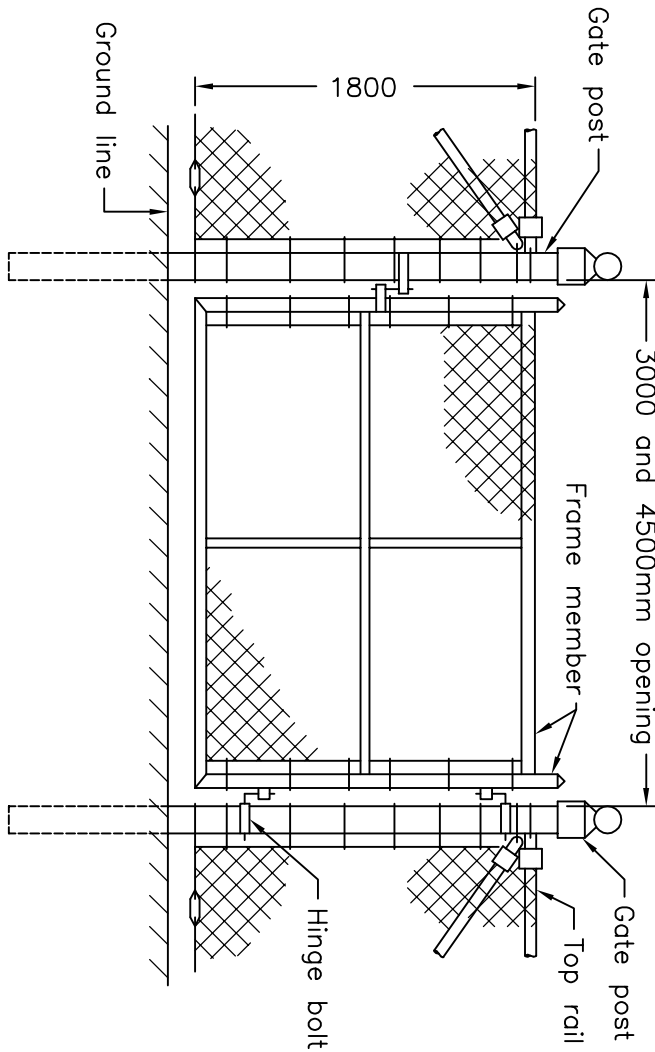
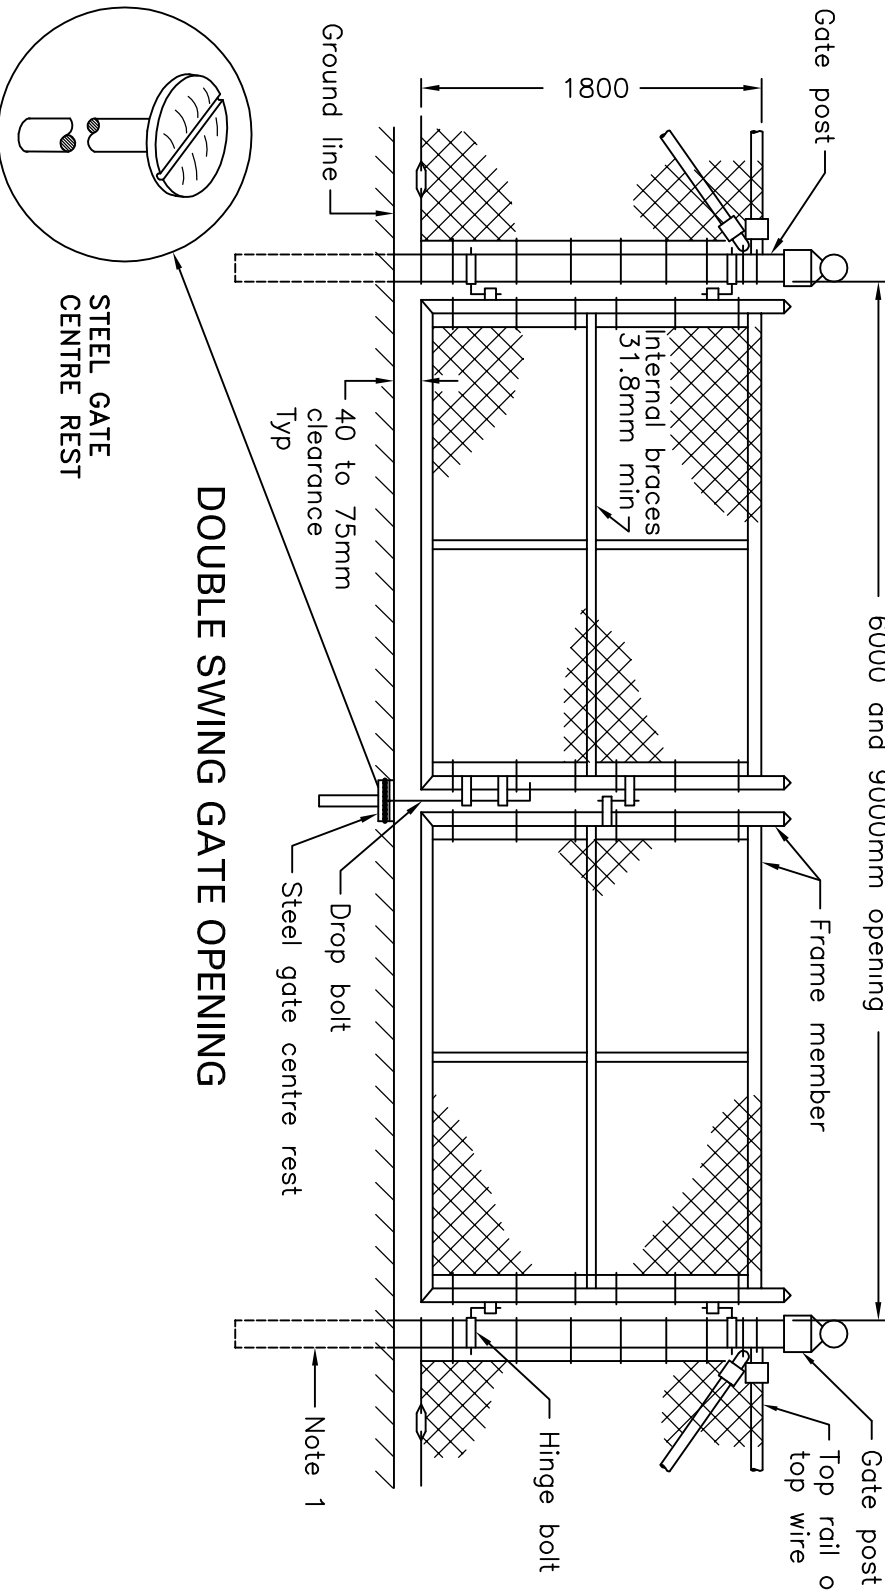


GATE AND GATE POST DETAILS				
Gate type and max opening m	Frame member min OD mm/min OD mm	Post dia mm	Post length standard m	
Single swing 3.0	42.9	88.9	2.6	
Double swing 6.0				
Single swing 4.5	48.3	114.3	2.9	
Double swing 9.0				



NOTES:
A Gate frames greater than 3.6m in width are supplied with diagonal braces.
B All dimensions are in millimetres unless otherwise shown.

FENCE, CHAIN LINK COMPONENT – GATE

NTS

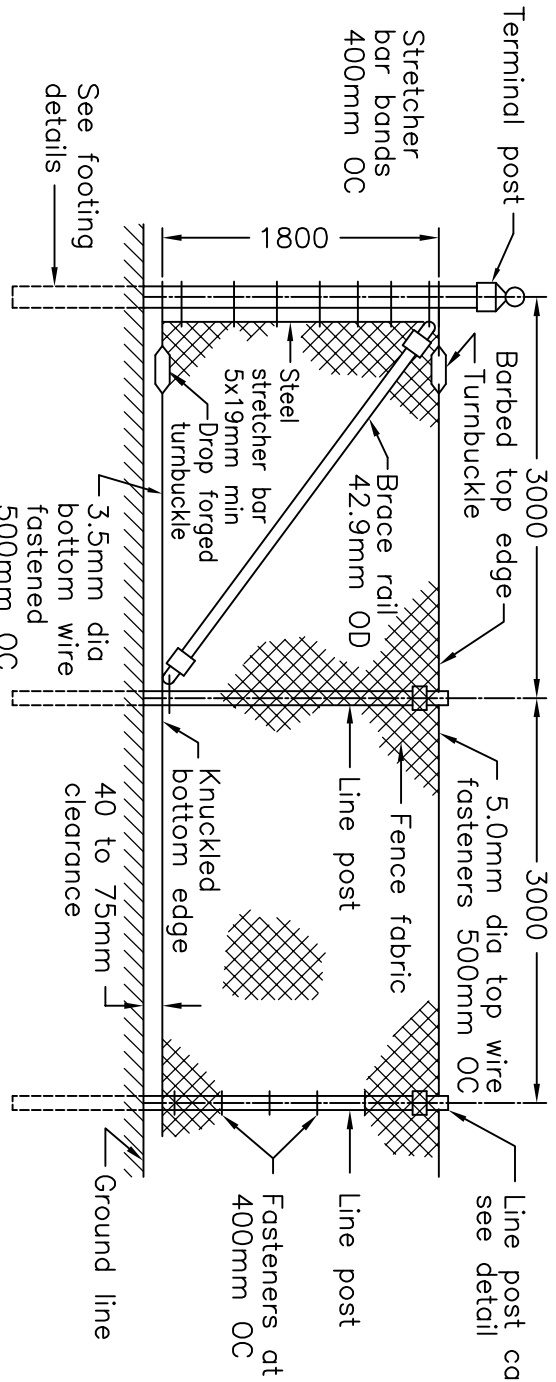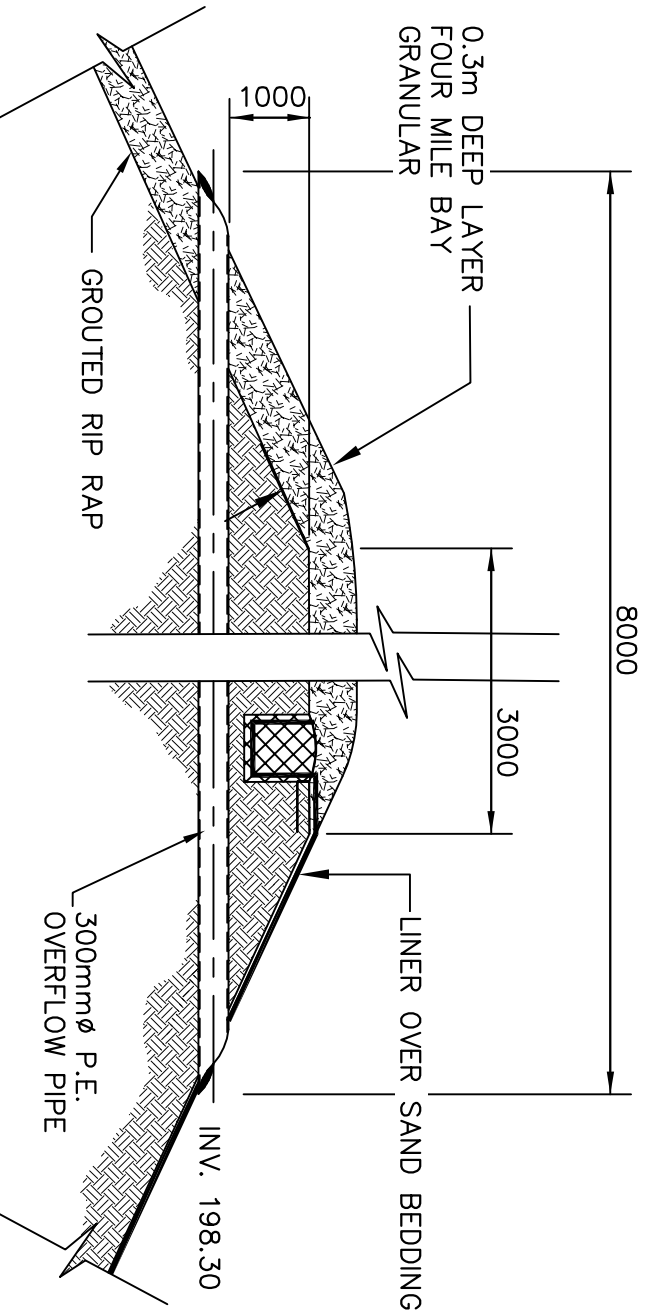

TERMINAL AND LINE POST DETAIL (TYPICAL)

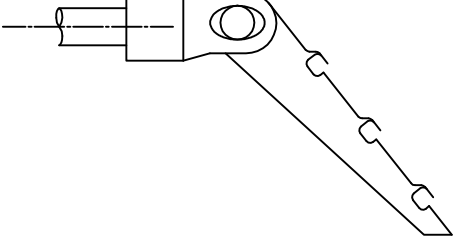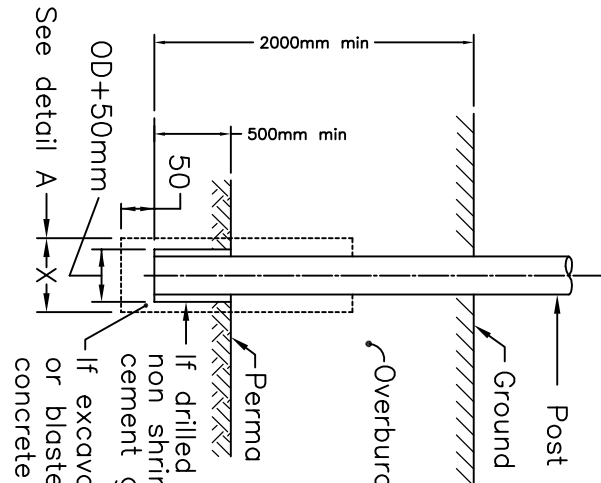

CHAIN LINK FENCE DETAILS

N.T.S.

No.	Issue / Revision	Date
1	Client Review and Approval	April 10, 2006
2	Client Review and Approval	June 26, 2006
3	Issued for tender	July 17, 2006
4	General Revisions – Client Review and Approval	March 21, 2007
5	Issued for Construction	May 2, 2007
6	Record Drawing	November 18, 2008

RECORD DRAWING

ORIGINAL SIGNED BY G.L. FERGUSON, P. Eng.

NOTES:
1. ALL AREAS DISTURBED BY CONTRACTOR DURING CONSTRUCTION ACTIVITIES SHALL BE REINSTATED TO ORIGINAL CONDITION OR BETTER, BY THE CONTRACTOR.

NUNAVUT BURNSIDE

Nuna Burnside Engineering and Environmental Ltd.
13 Towne, Cambridge, Ontario
telephone (867) 975-2052 fax (867) 975-2053
email info@nunaburnside.com
web www.nunaburnside.com



Client
**GOVERNMENT OF NUNAVUT
PROJECT MANAGEMENT DIVISION
DEPARTMENT OF COMMUNITY AND
GOVERNMENT SERVICES (CGS)
KITIKMEOT REGION
P.O. BAG 200
CAMBRIDGE BAY, NUNAVUT
X0B 0C0**

Drawing Title
**THE HAMLET OF KUGLUKTUK
SEWAGE LAGOON DETAILS**

Drawn By
R.A.

Checked By
M.O'Hara / X. Farnsworth

Scale
N.T.S.

Nuna Burnside Project No.
N-08-0575210