

1. This drawing is the exclusive property of B. J. Burnside & Associates Limited and the reproduction of any part without prior written consent of this office is strictly prohibited.
2. The contractor shall verify all dimensions, levels, and to this office prior to any construction.
3. This drawing is to be read and understood in conjunction with all other plans and documents applicable to this project.
4. Do not scale the drawings.

| No. | Issue / Revision | Date |
|-----|----------------------------|-------------------|
| 1 | Client Review | Jan 01, 2000 |
| 2 | Client Review and Approval | June 26, 2006 |
| 3 | Issued for tender | July 17, 2006 |
| 4 | Client Review and Approval | March 21, 2007 |
| 5 | Issued for Construction | May 2, 2007 |
| 6 | Record Drawing | November 18, 2008 |

RECORD DRAWING

ORIGINAL SIGNED BY G.J. POPCOW, P. Eng.



BURNSIDE

Nuna Burnside Engineering and Environmental Ltd.
15 Townline, Orongonia, Ontario
Telephone (867) 975-2025 Fax (867) 975-2083
email info@nunaburnside.com
web www.nunaburnside.com


Client
GOVERNMENT OF NUNAVUT
PROJECT MANAGEMENT DIVISION
DEPARTMENT OF COMMUNITY AND
GOVERNMENT SERVICES (CGS)
KITIKUOT REGION
P.O. BOX 220
CAMBRIDGE BAY, NUNAVUT
X0B 0C0

| | |
|--|-------------|
| Drawing Title | |
| THE HAMLET OF KUSUKTUK SEWAGE LAGOON PLAN | |
| Drawing No. | 2 |
| Project No. | N-O-09755.0 |
| Scale | 1:750 |
| Drawn By | G. POPCOW |
| Checked By | W. KENNEDY |
| Scale | 1:750 |



| BENCHMARK COORDINATE TABLE | | |
|----------------------------|----------|---------|
| BENCHMARK | NORTHING | EASTING |
| B.M. 1 | 5039.54 | 5047.52 |
| B.M. 2 | 4889.69 | 4917.33 |
| B.M. 3 | 5124.14 | 4946.78 |

| LAGOON COORDINATE TABLE | | | | |
|-------------------------|------------|---------|------------|---------|
| CORNER | INSIDE TOE | | INSIDE TOP | |
| | NORTHING | EASTING | NORTHING | EASTING |
| NE | 5204.42 | 4859.06 | 5217.94 | 4863.70 |
| NW | 5159.65 | 4679.19 | 5168.40 | 4664.65 |
| SE | 5073.24 | 4962.16 | 5069.35 | 4980.49 |
| SW | 4951.31 | 4731.04 | 4933.56 | 4723.08 |

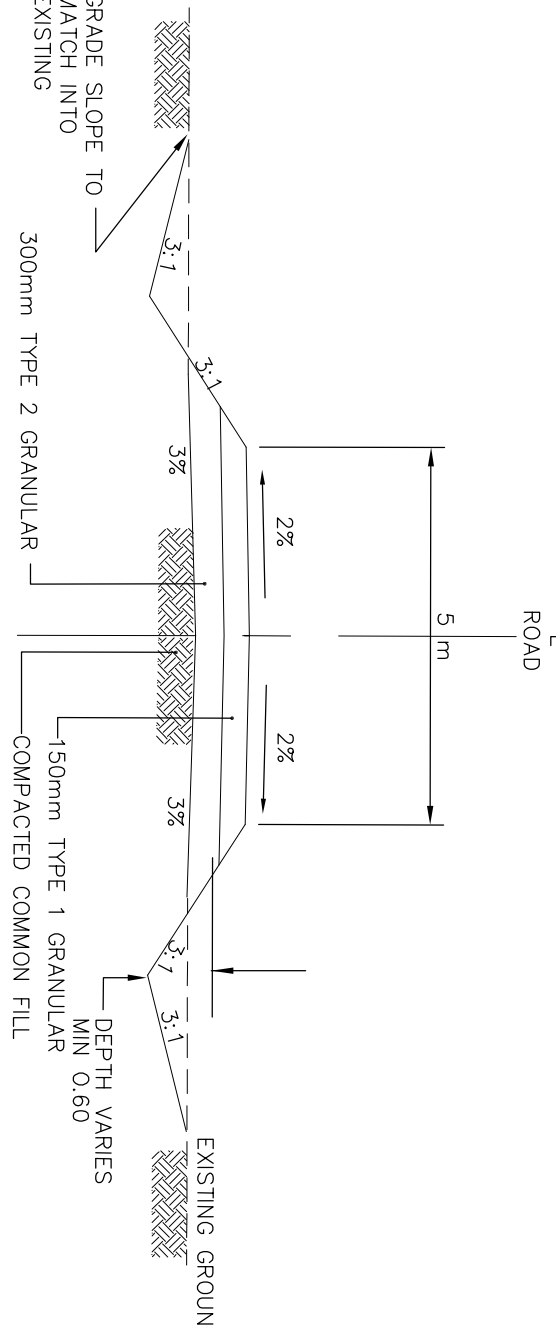

ACCESS ROAD CROSS SECTION C-C
N.T.S.

| LEGEND | |
|----------|----------------------|
| EXISTING | FEATURE |
| +89.00 | ELEVATION |
| ▲ | BENCHMARK |
| → | DITCH FLOW DIRECTION |
| → | FENCE |
| □ | CULVERT |
| ○ | TEST HOLE |
| --- | GROUND CONTOURS |