



LANDFILL PERIMETER BERM
CROSS SECTION A-A
SCALE NTS


NOTE: FOUR MILE BAY GRANULAR MATERIAL PLACED OVER INTERIOR & EXTERIOR SLOPE OF PERIMETER BERM

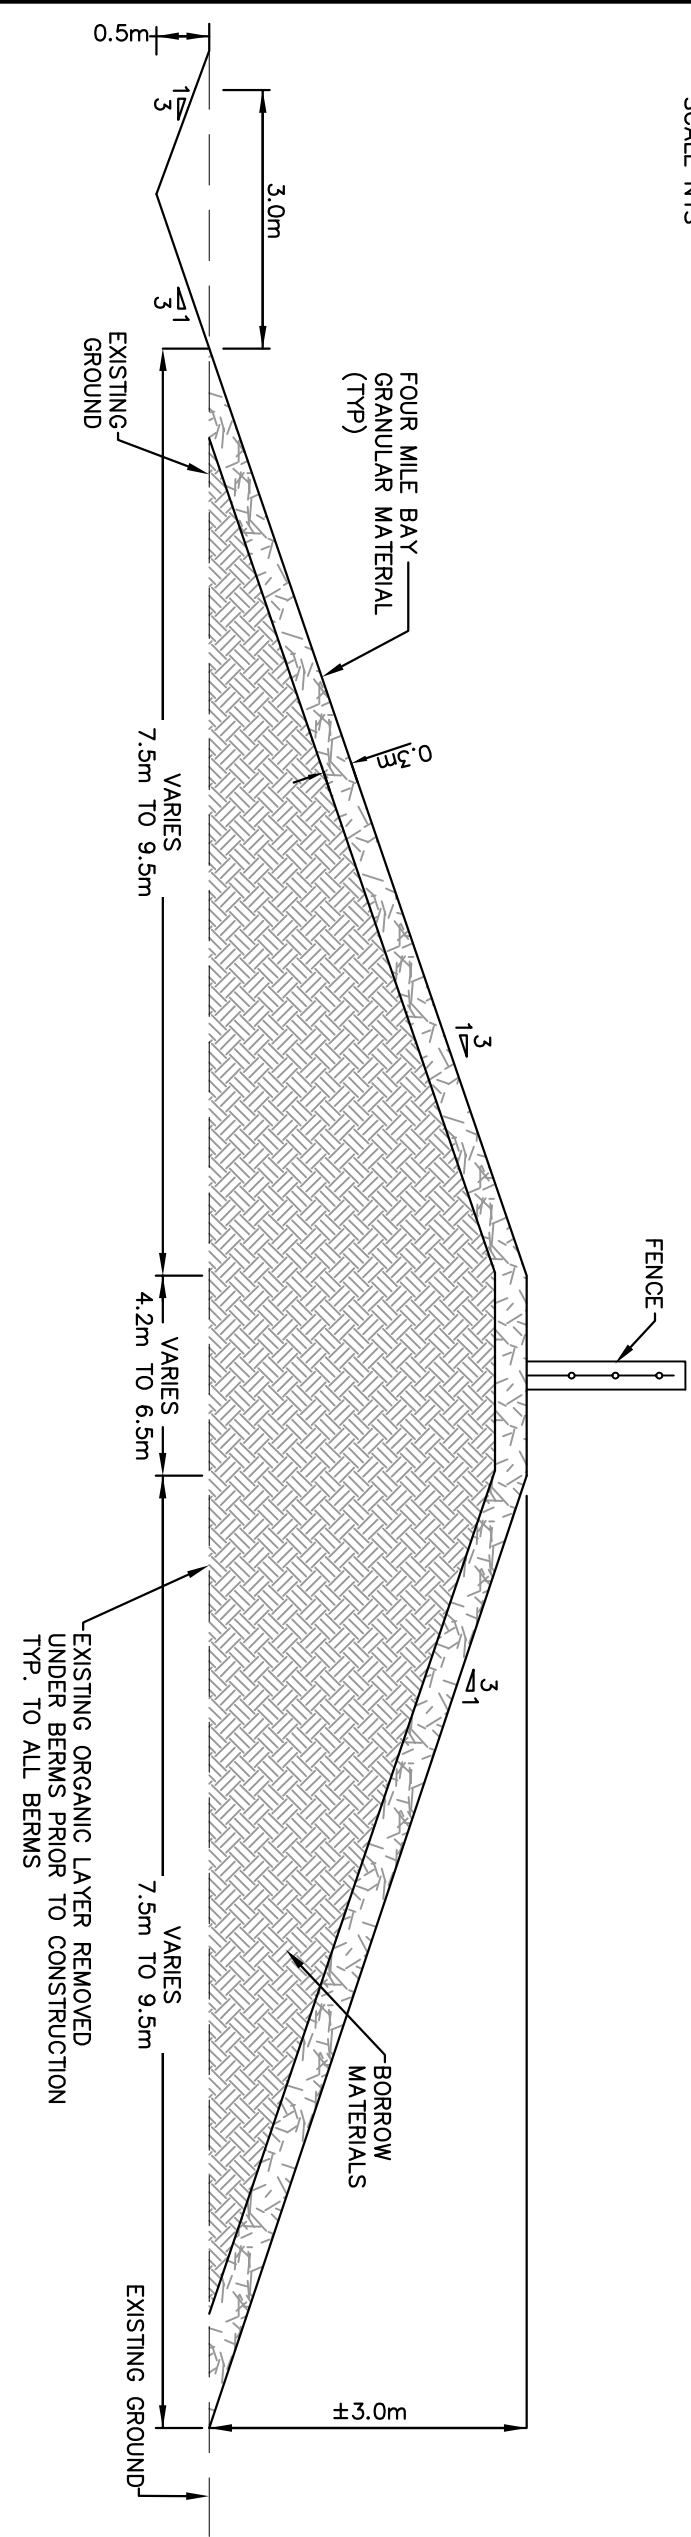


WATER RETENTION AREA
CROSS SECTION B-B
SCALE NTS

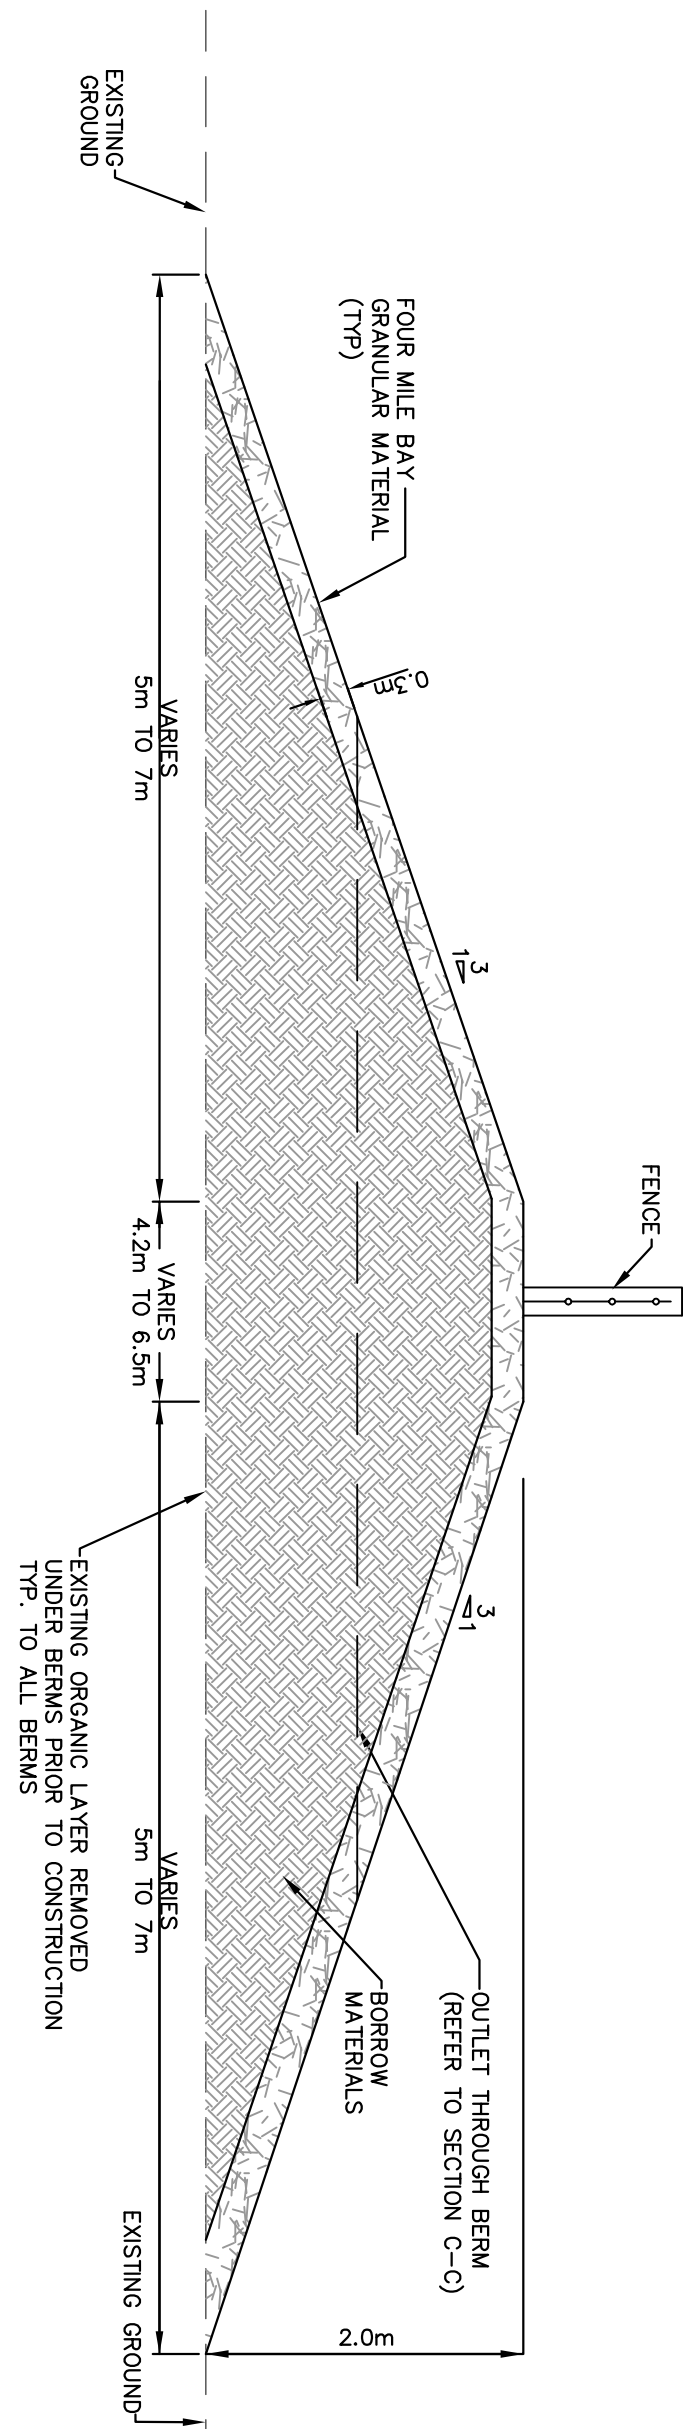


HAZARDOUS WASTE STORAGE
AREA CROSS SECTION D-D
SCALE NTS

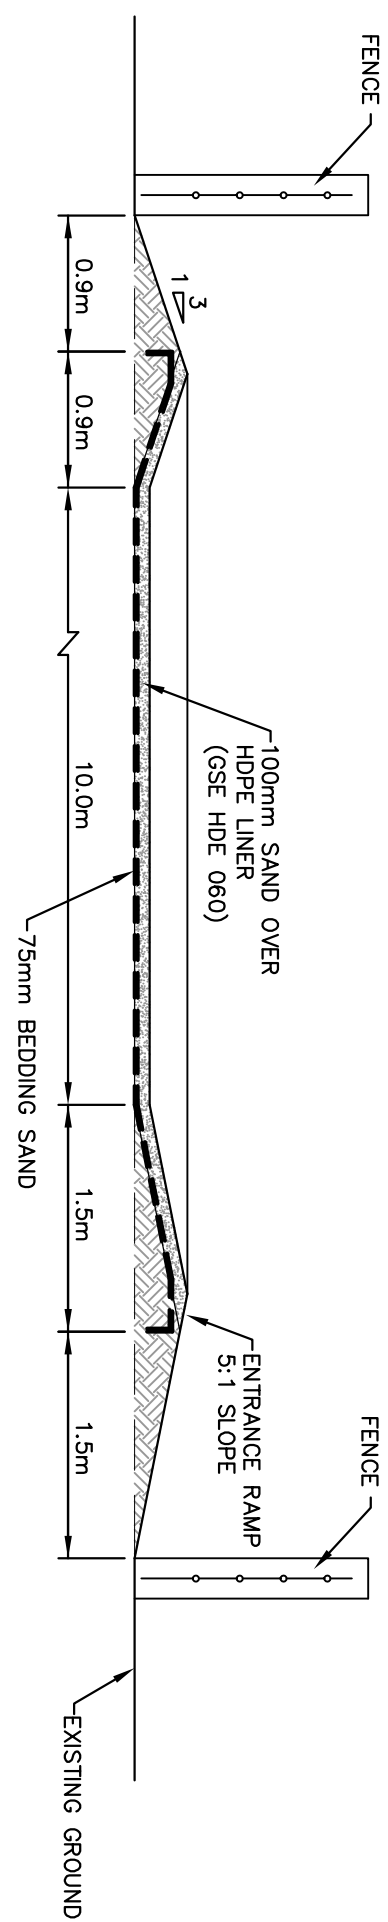


LANDFARMING AREA
CROSS SECTION E-E
SCALE NTS

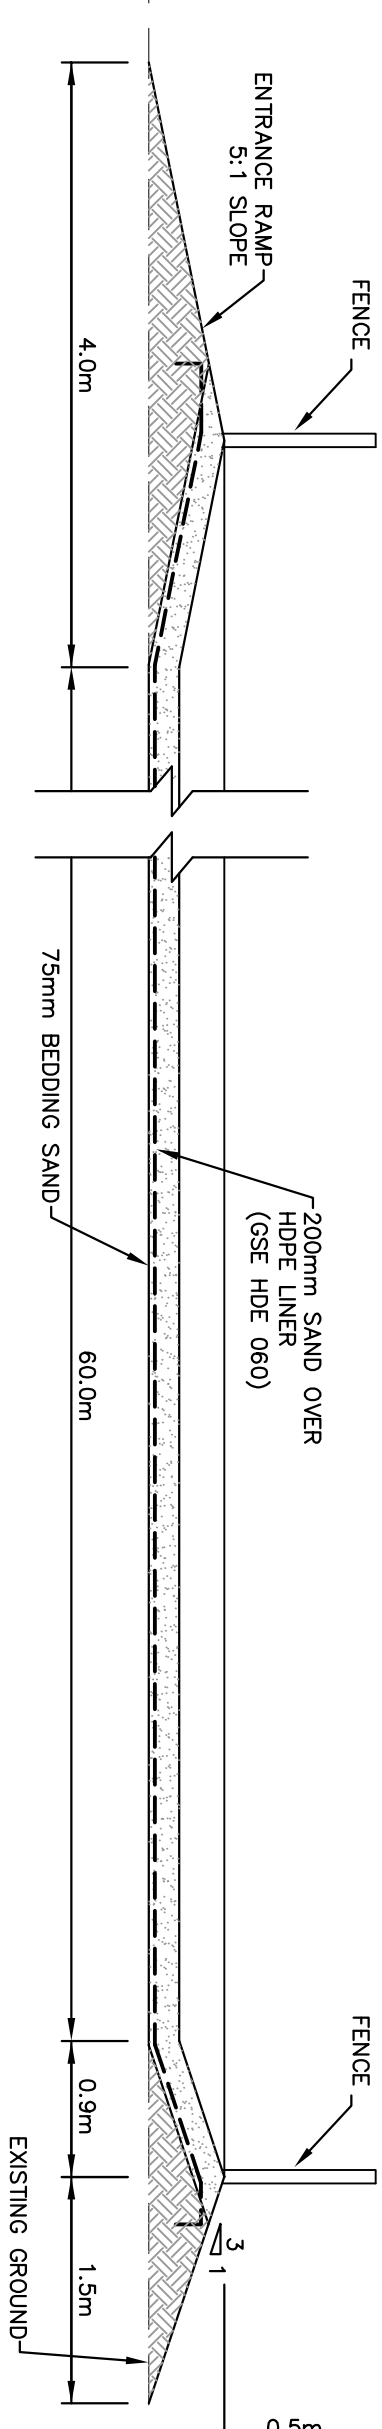

TYPICAL PERIMETER
DITCH DETAIL
SCALE NTS

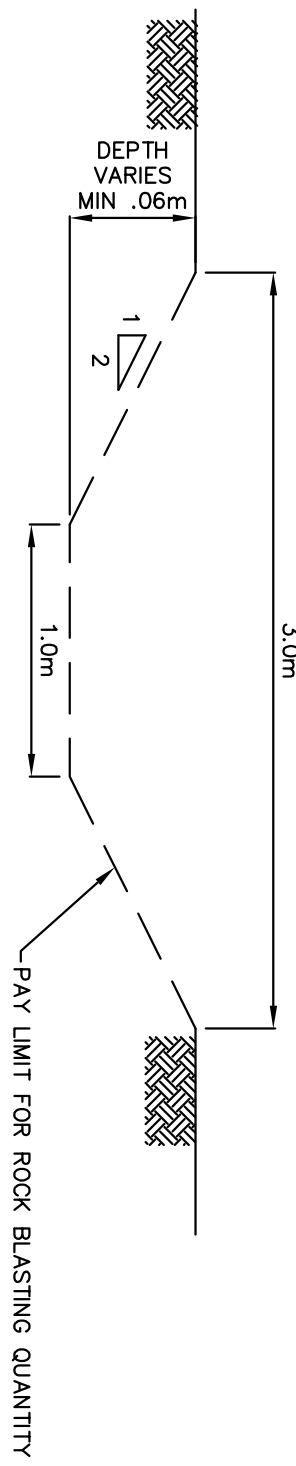


OUTLET CROSS
SECTION C-C

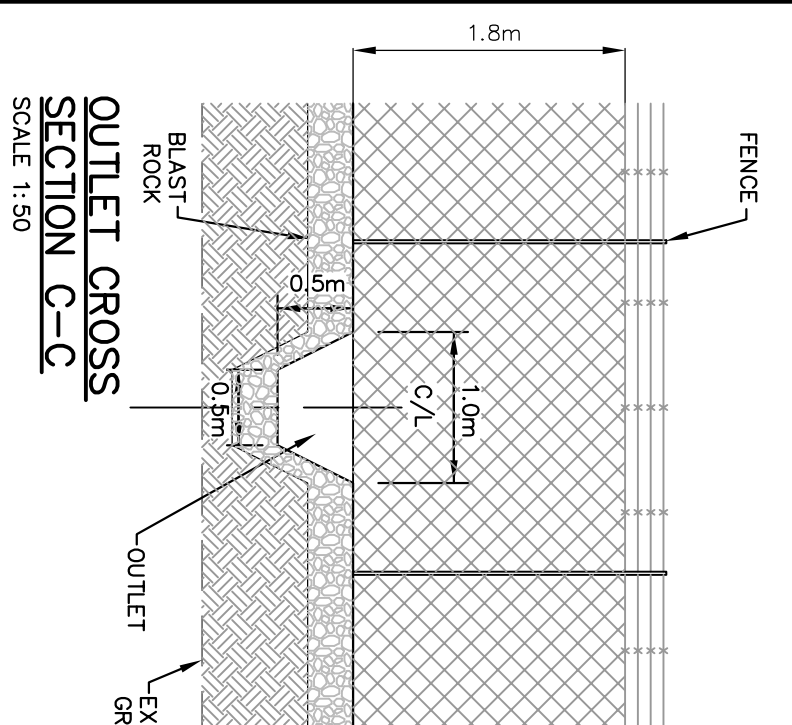


No.	Issue / Revision	Date
1	Client Review and Approval	April 10, 2006
2	Client Review and Approval	June 26, 2006
3	Issued for Tender	July 17, 2006
3	General Revisions – Client Review and Approval	March 21, 2007
5	Issued for Construction	May 2, 2007
6	Record Drawing	November 18, 2008

RECORD DRAWING

.....
ORIGINAL SIGNED BY G.J. POWOWICH, P. Eng.

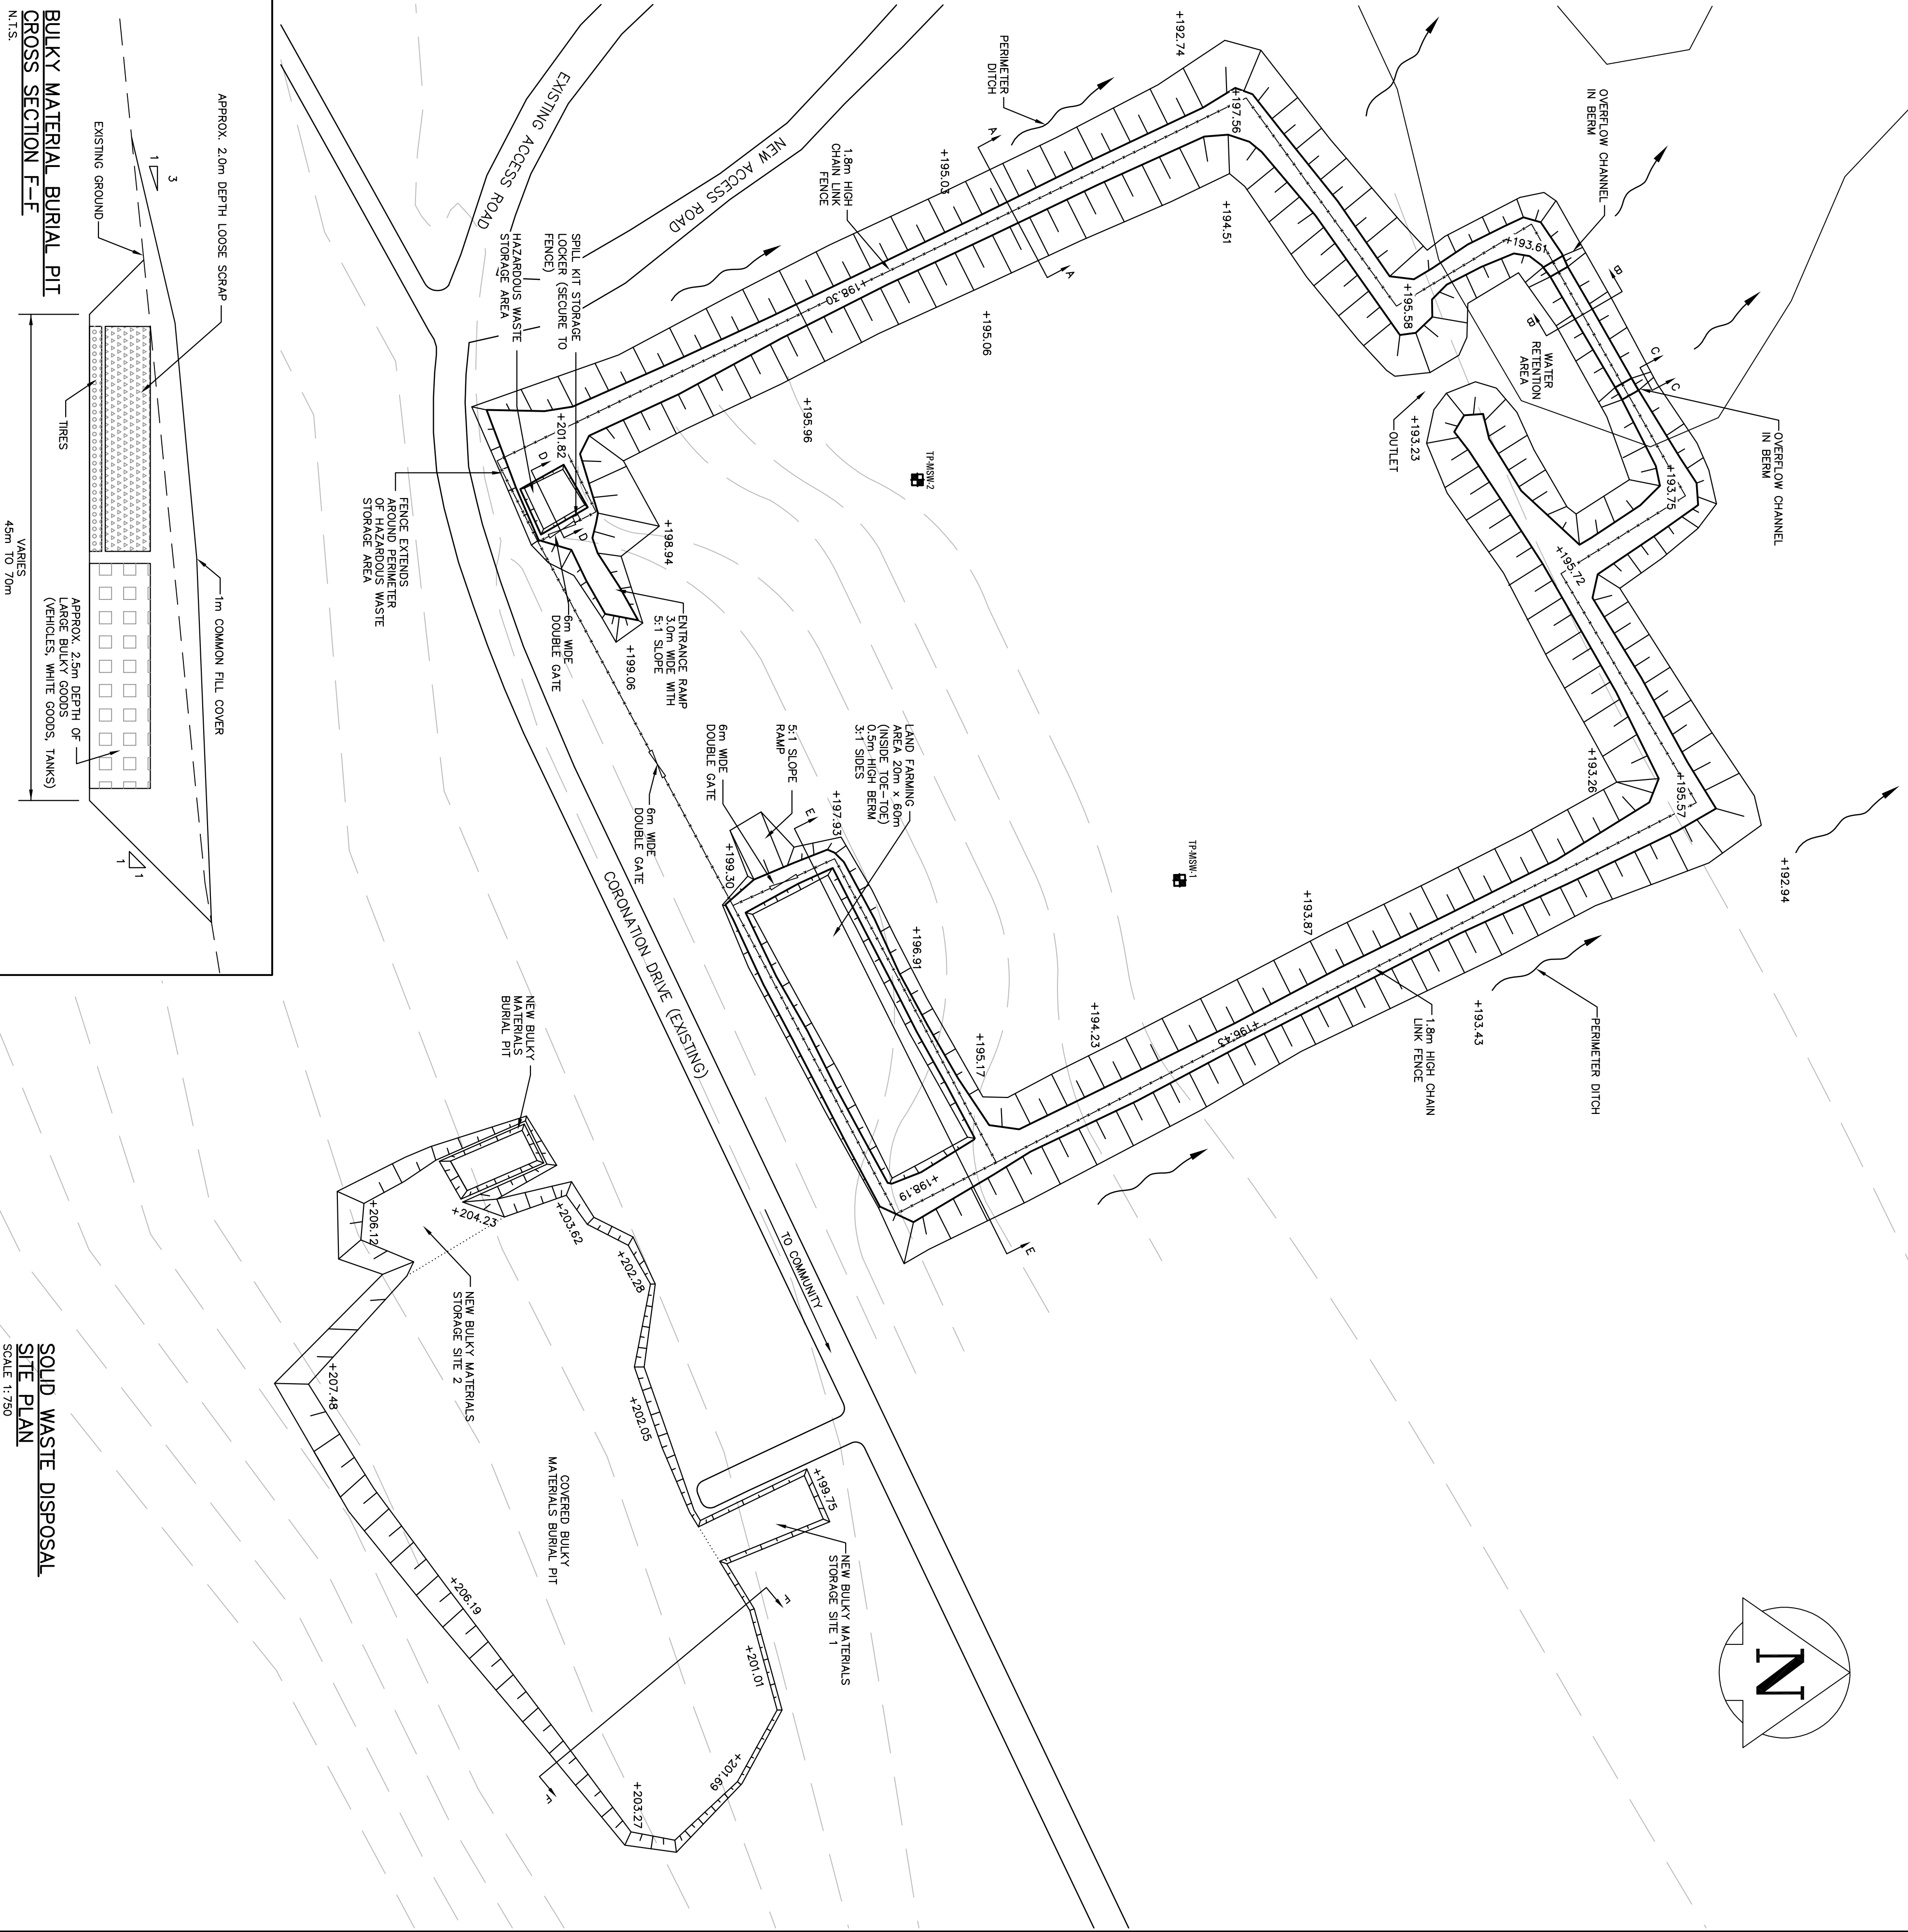

BULKY MATERIAL BURIAL PIT
CROSS SECTION F-F
NTS

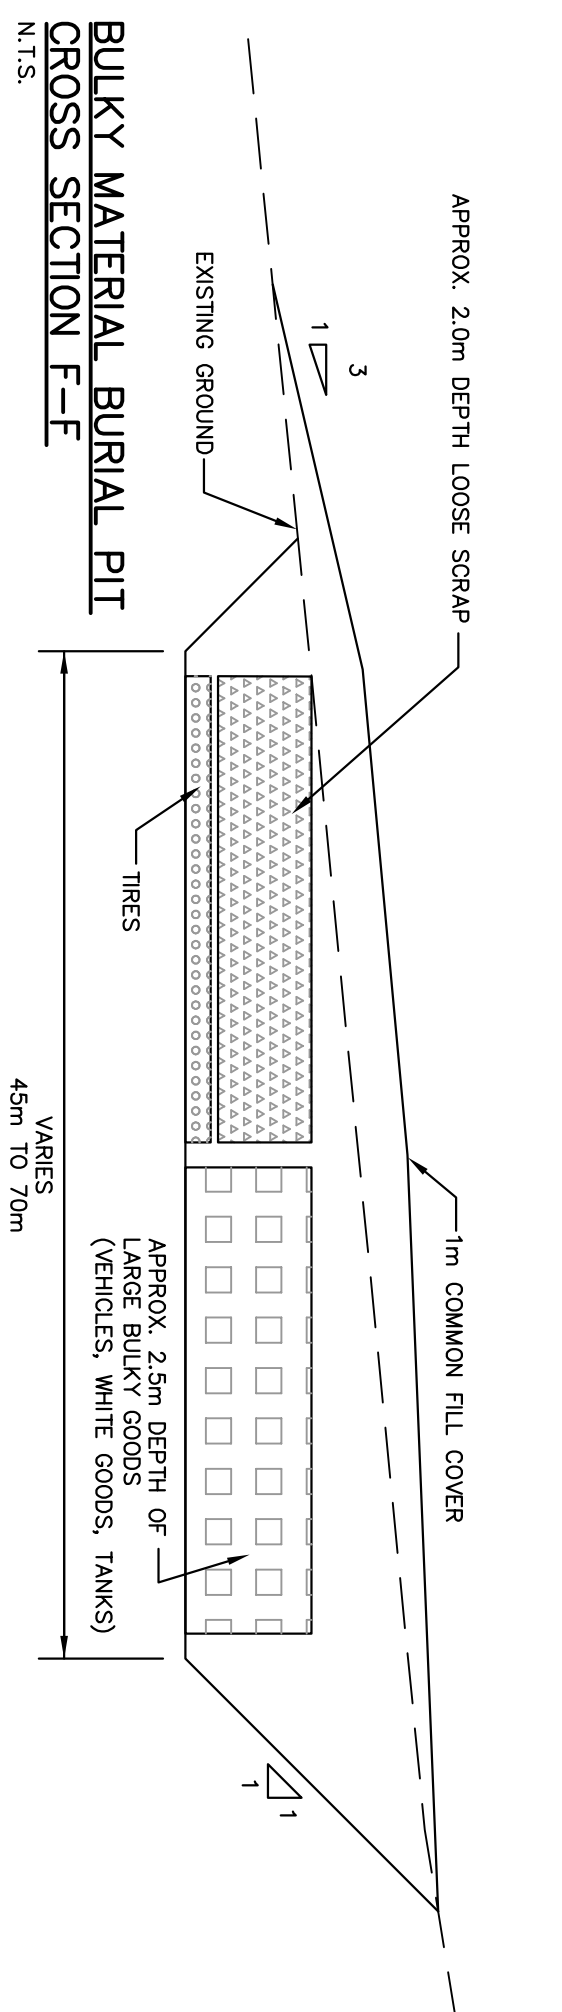

NOTES:

1. ALL AREAS DISTURBED BY CONTRACTOR DURING CONSTRUCTION ACTIVITIES SHALL BE REINSTATED TO ORIGINAL CONDITION OR BETTER, BY THE CONTRACTOR.
2. CONTRACTOR SHALL LOAD, HAIL, AND PLACE AS SHOWN EXISTING TIRES, BULKY GOODS AND LOOSE SCRAP FROM EXISTING STORAGE AREA TO BULKY MATERIALS BURIAL PIT.
3. TOPOGRAPHIC CONTOURS SHOWN ARE APPROXIMATE AND ARE DERIVED FROM REGIONAL TOPOGRAPHIC MAPS.



SOLID WASTE DISPOSAL
SITE PLAN
SCALE 1"=750'

GOVERNMENT OF NUNAVUT PROJECT MANAGEMENT DIVISION DEPARTMENT OF COMMUNITY AND GOVERNMENT SERVICES (CGS)	THE HAMLET OF KUGLUKTUK SOLID WASTE DISPOSAL FACILITY IMPROVEMENTS
--	--

P.O. BAG 200 CAMBRIDGE BAY, NUNAVUT X0B 0C0	On Project No 04-4466	Drawn By T.T.	Checked By K. Hunter
	Scale AS SHOWN	Nuno Burnside Project No. N-O 09755.0	