



# WATER SUPPLY IMPROVEMENTS PHASE 1 NEW INTAKE AND PUMPHOUSE KUGLUKTUK, NU

GN PROJECT#: 04-4417  
WEC PROJECT#: 13655.00

## RECORD DRAWING

DRAWINGS WERE BASED UPON INFORMATION SUBMITTED FROM OTHER PARTIES AND THE ENGINEER DOES NOT WARRANT OR CERTIFY THAT THE INFORMATION FROM THESE OTHER PARTIES IS ACCURATE.

DATE (YYYY MM DD): 2014.10.09

YELLOWKNIFE OFFICE  
P.O. Box 1529  
4903 47 Street  
Yellowknife, NT X1A 2P2


Bus: (867) 873-2395  
Toll Free: 1-800-263-2393  
Fax: (867) 873-2547

info@williamsengineering.com  
www.williamsengineering.com

**WILLIAMS  
ENGINEERING**  
CANADA









2010.08.06  
ISSUED FOR CONSTRUCTION

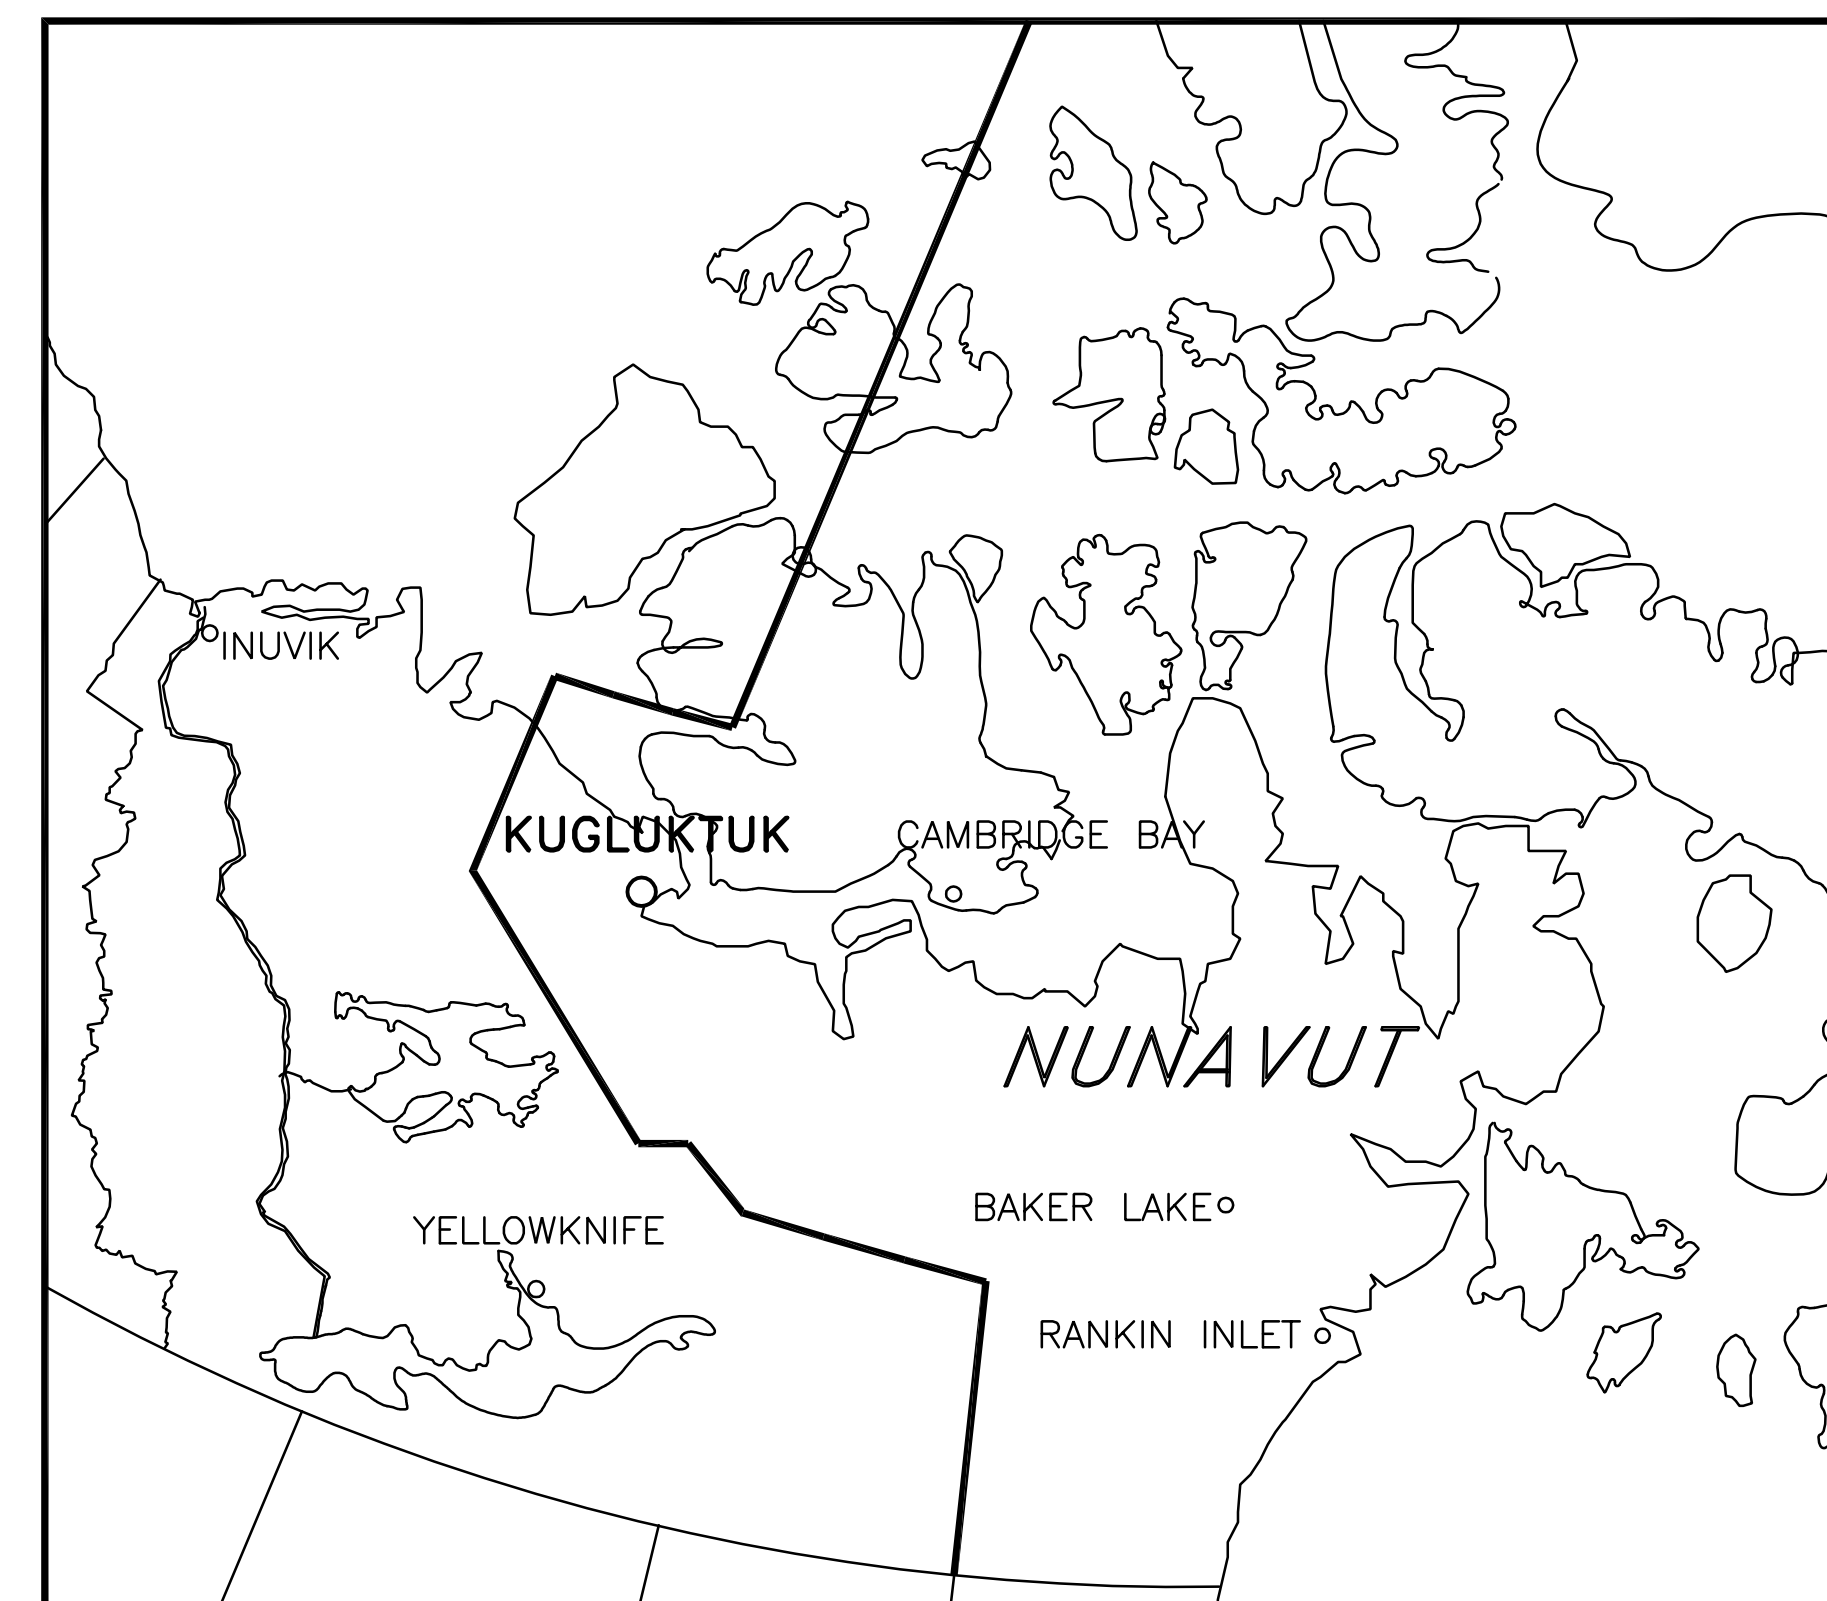

LOCATION PLAN

## LIST OF DRAWINGS:

G-00	TITLE PAGE
A-01	PUMPHOUSE PLAN AND ELEVATIONS
C-01	SITE PLAN
C-02	INTAKE PLAN AND PROFILE
C-03	TRENCH CROSS-SECTIONS AND VOLUME TABLE
C-04	INTAKE CONCEPTUAL SKETCH
C-05	INTAKE DETAILS
EP-1	PUMPHOUSE ELECTRICAL SITE PLAN AND SINGLE LINE DIAGRAM
EP-2	PUMPHOUSE ELECTRICAL SCHEMATICS & DETAILS
EP-3	PUMPHOUSE ELECTRICAL CONTROL AND INSTRUMENTATION
EP-4	PUMPHOUSE ELECTRICAL SCHEMATICS
EP-5	PUMPHOUSE ELECTRICAL SCHEDULES & HEAT TRACE SCHEMATICS
M-01	PUMPHOUSE AND ACCESS VAULTS PLANS AND SECTIONS
M-02	INTAKE PIPELINE DETAILS
P-01	PROCESS DRAWING
S-01	ACCESS VAULTS
S-02	PUMPHOUSE SKID
S-03	PIPE SUPPORTS

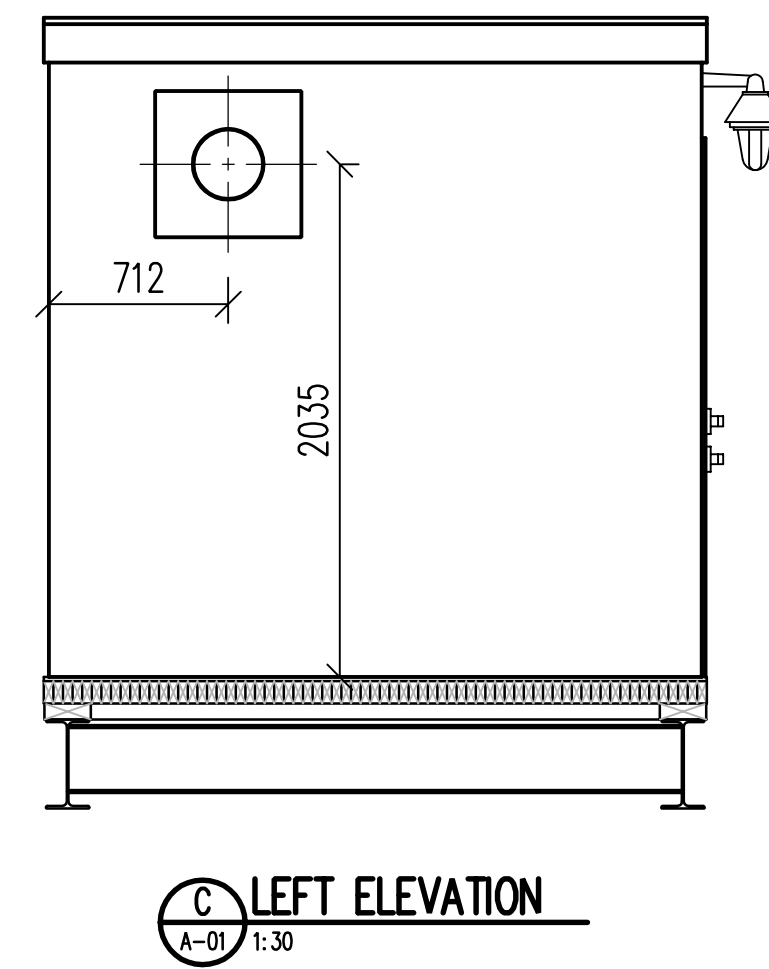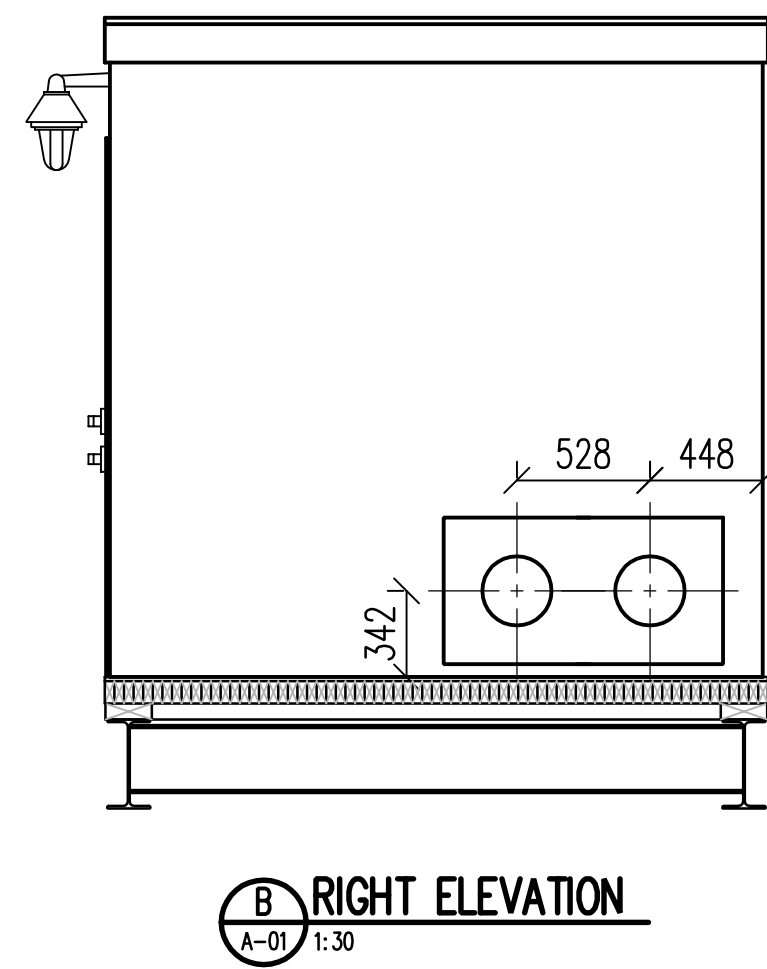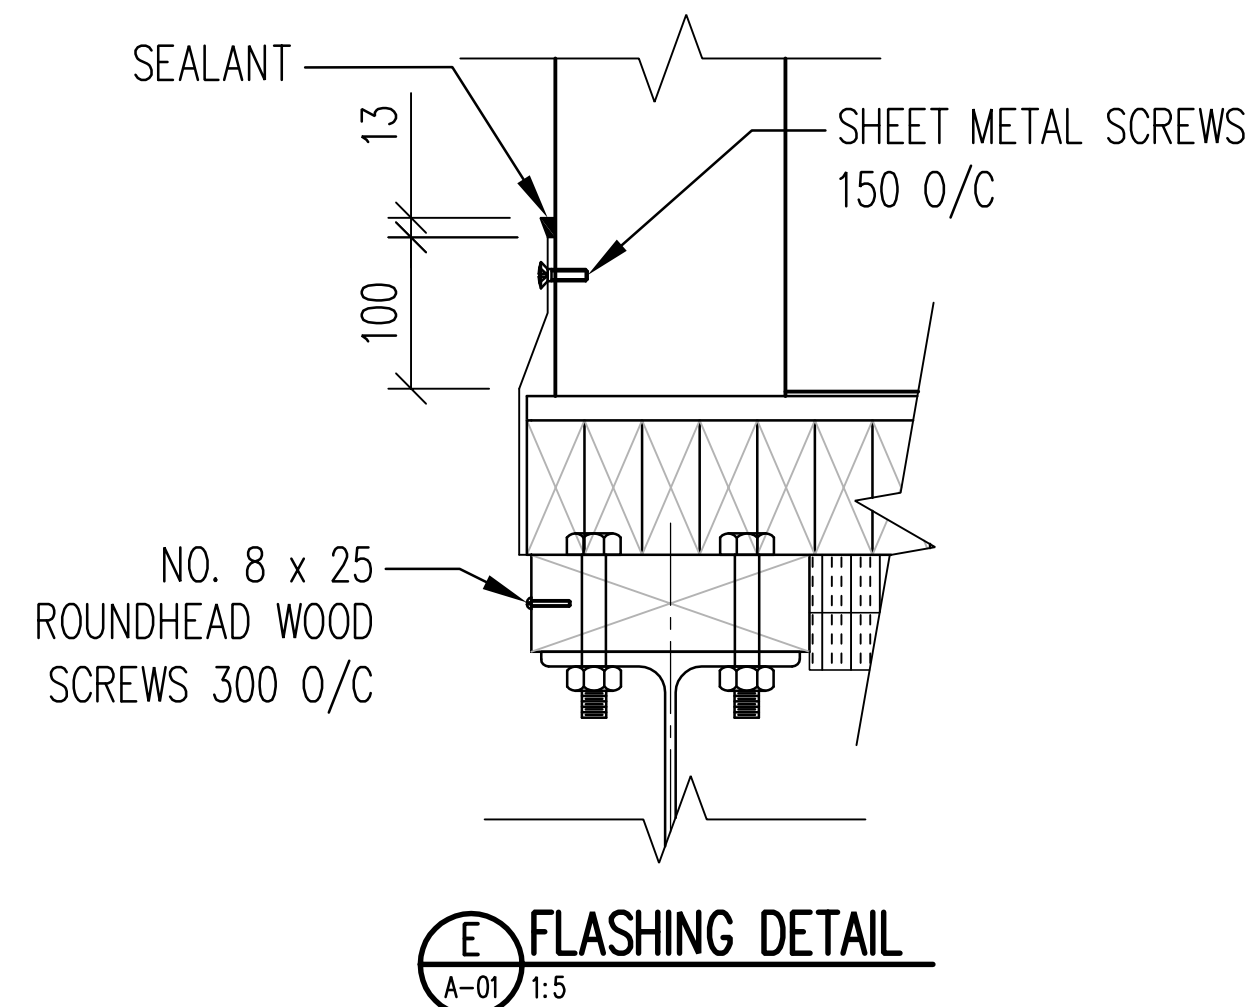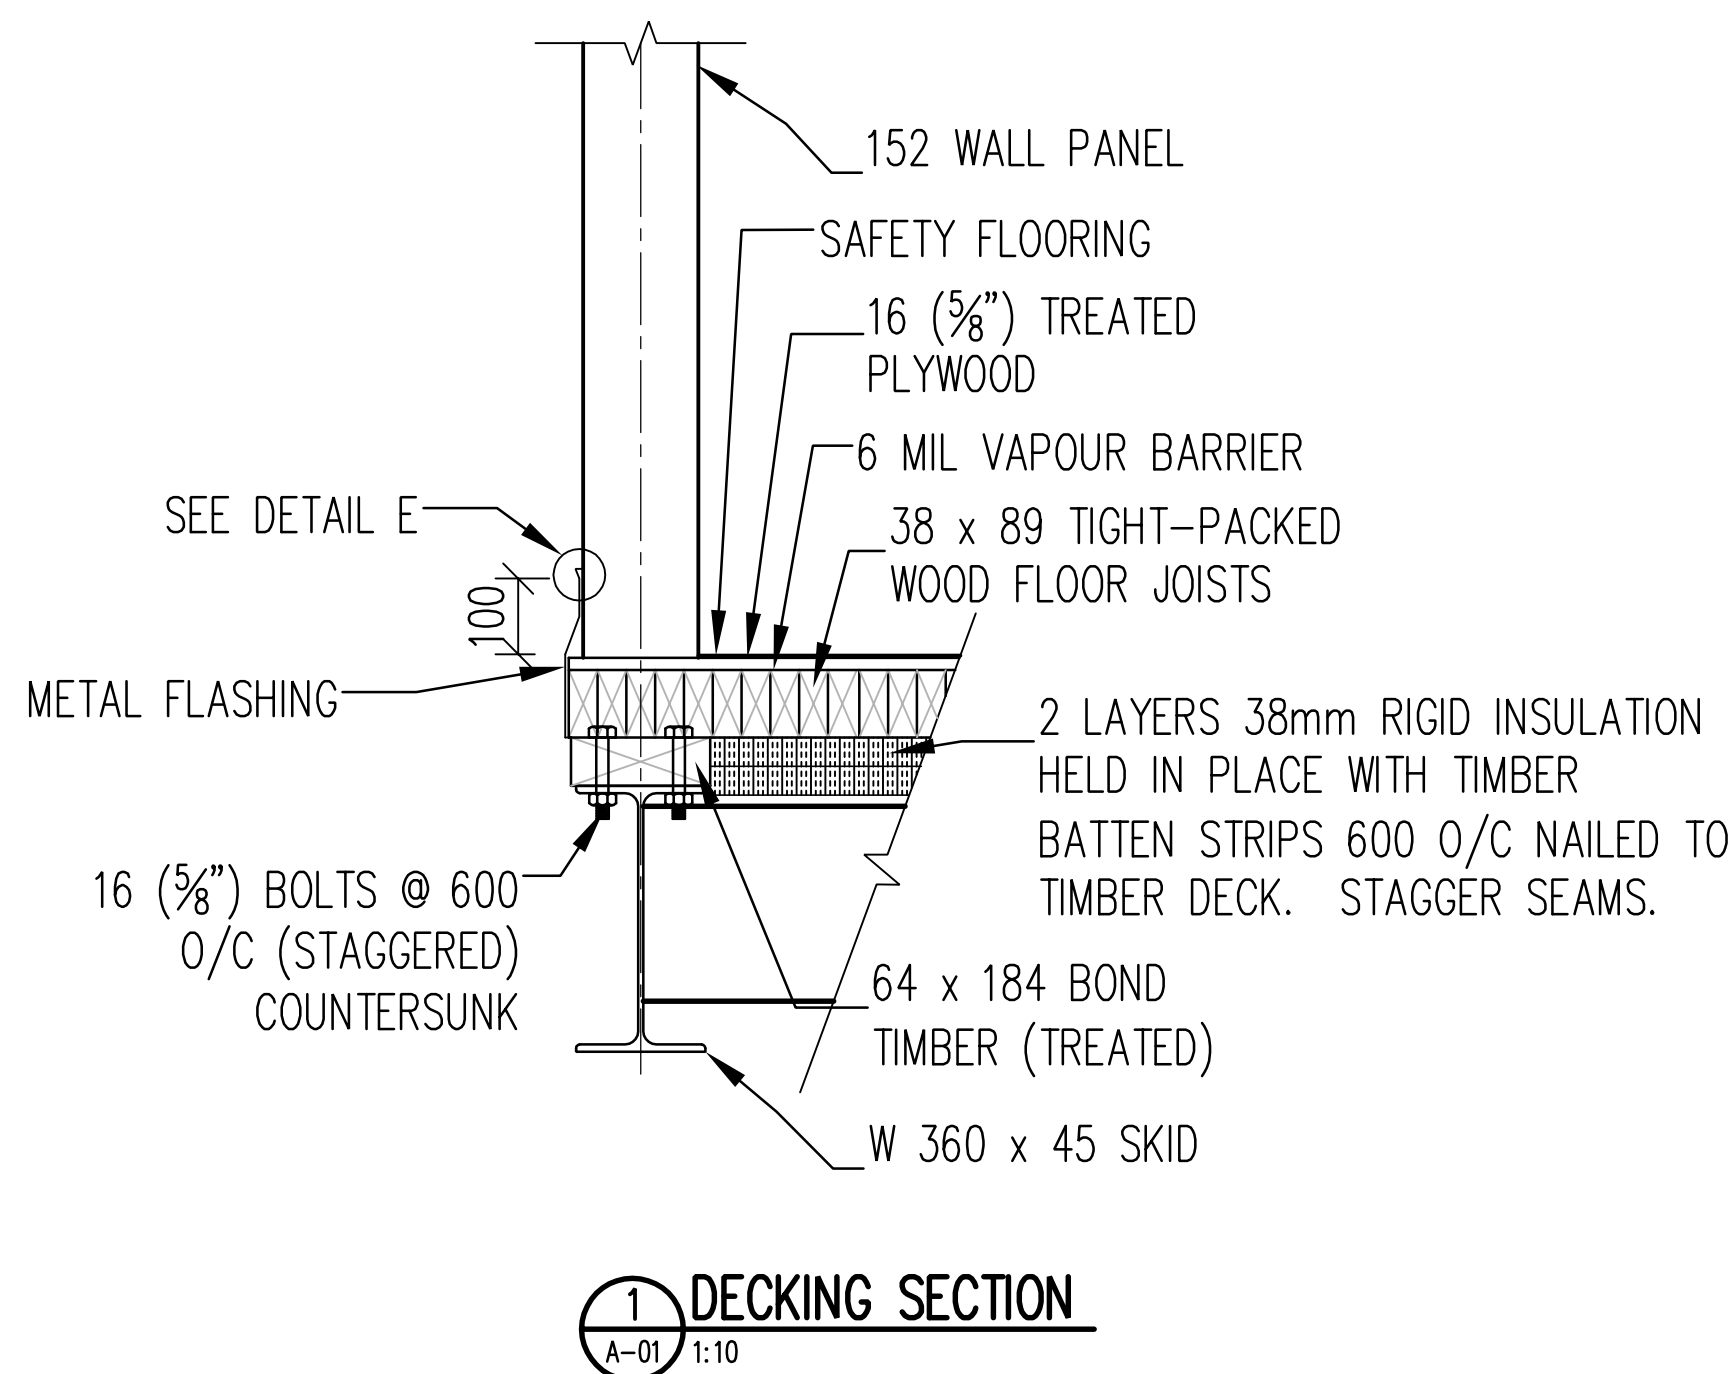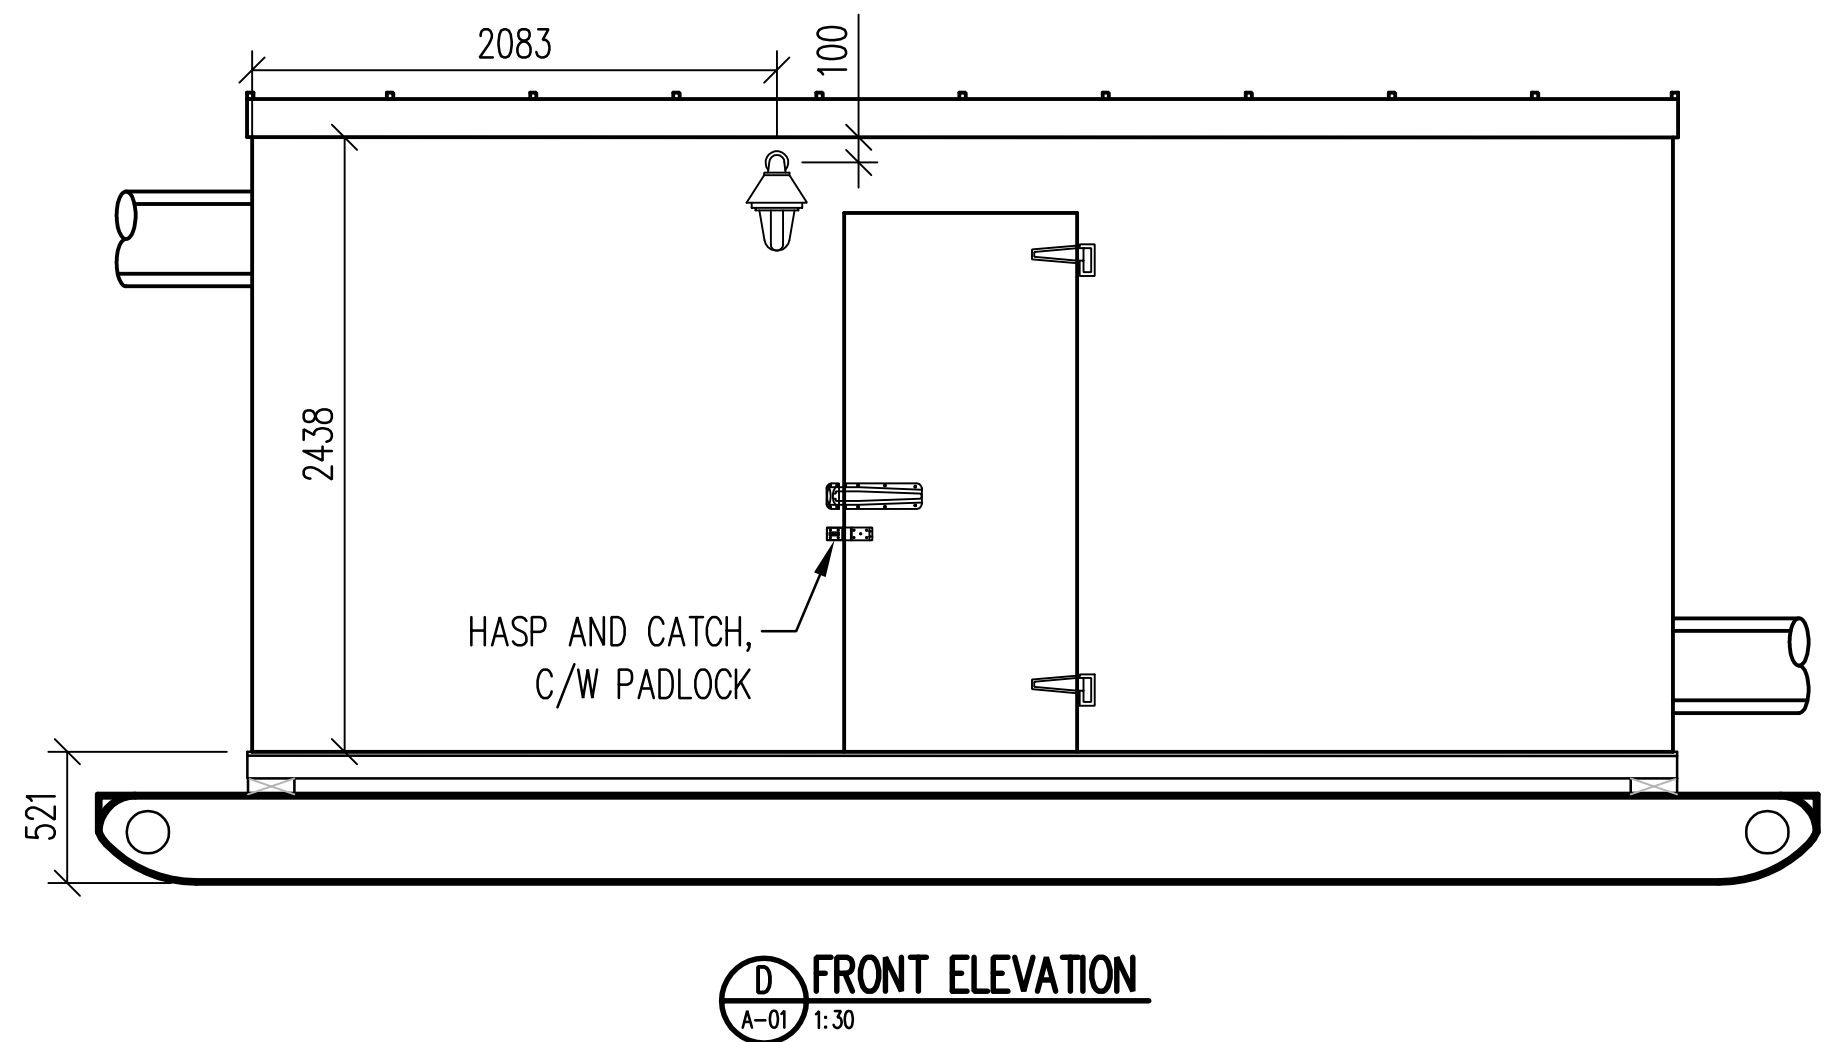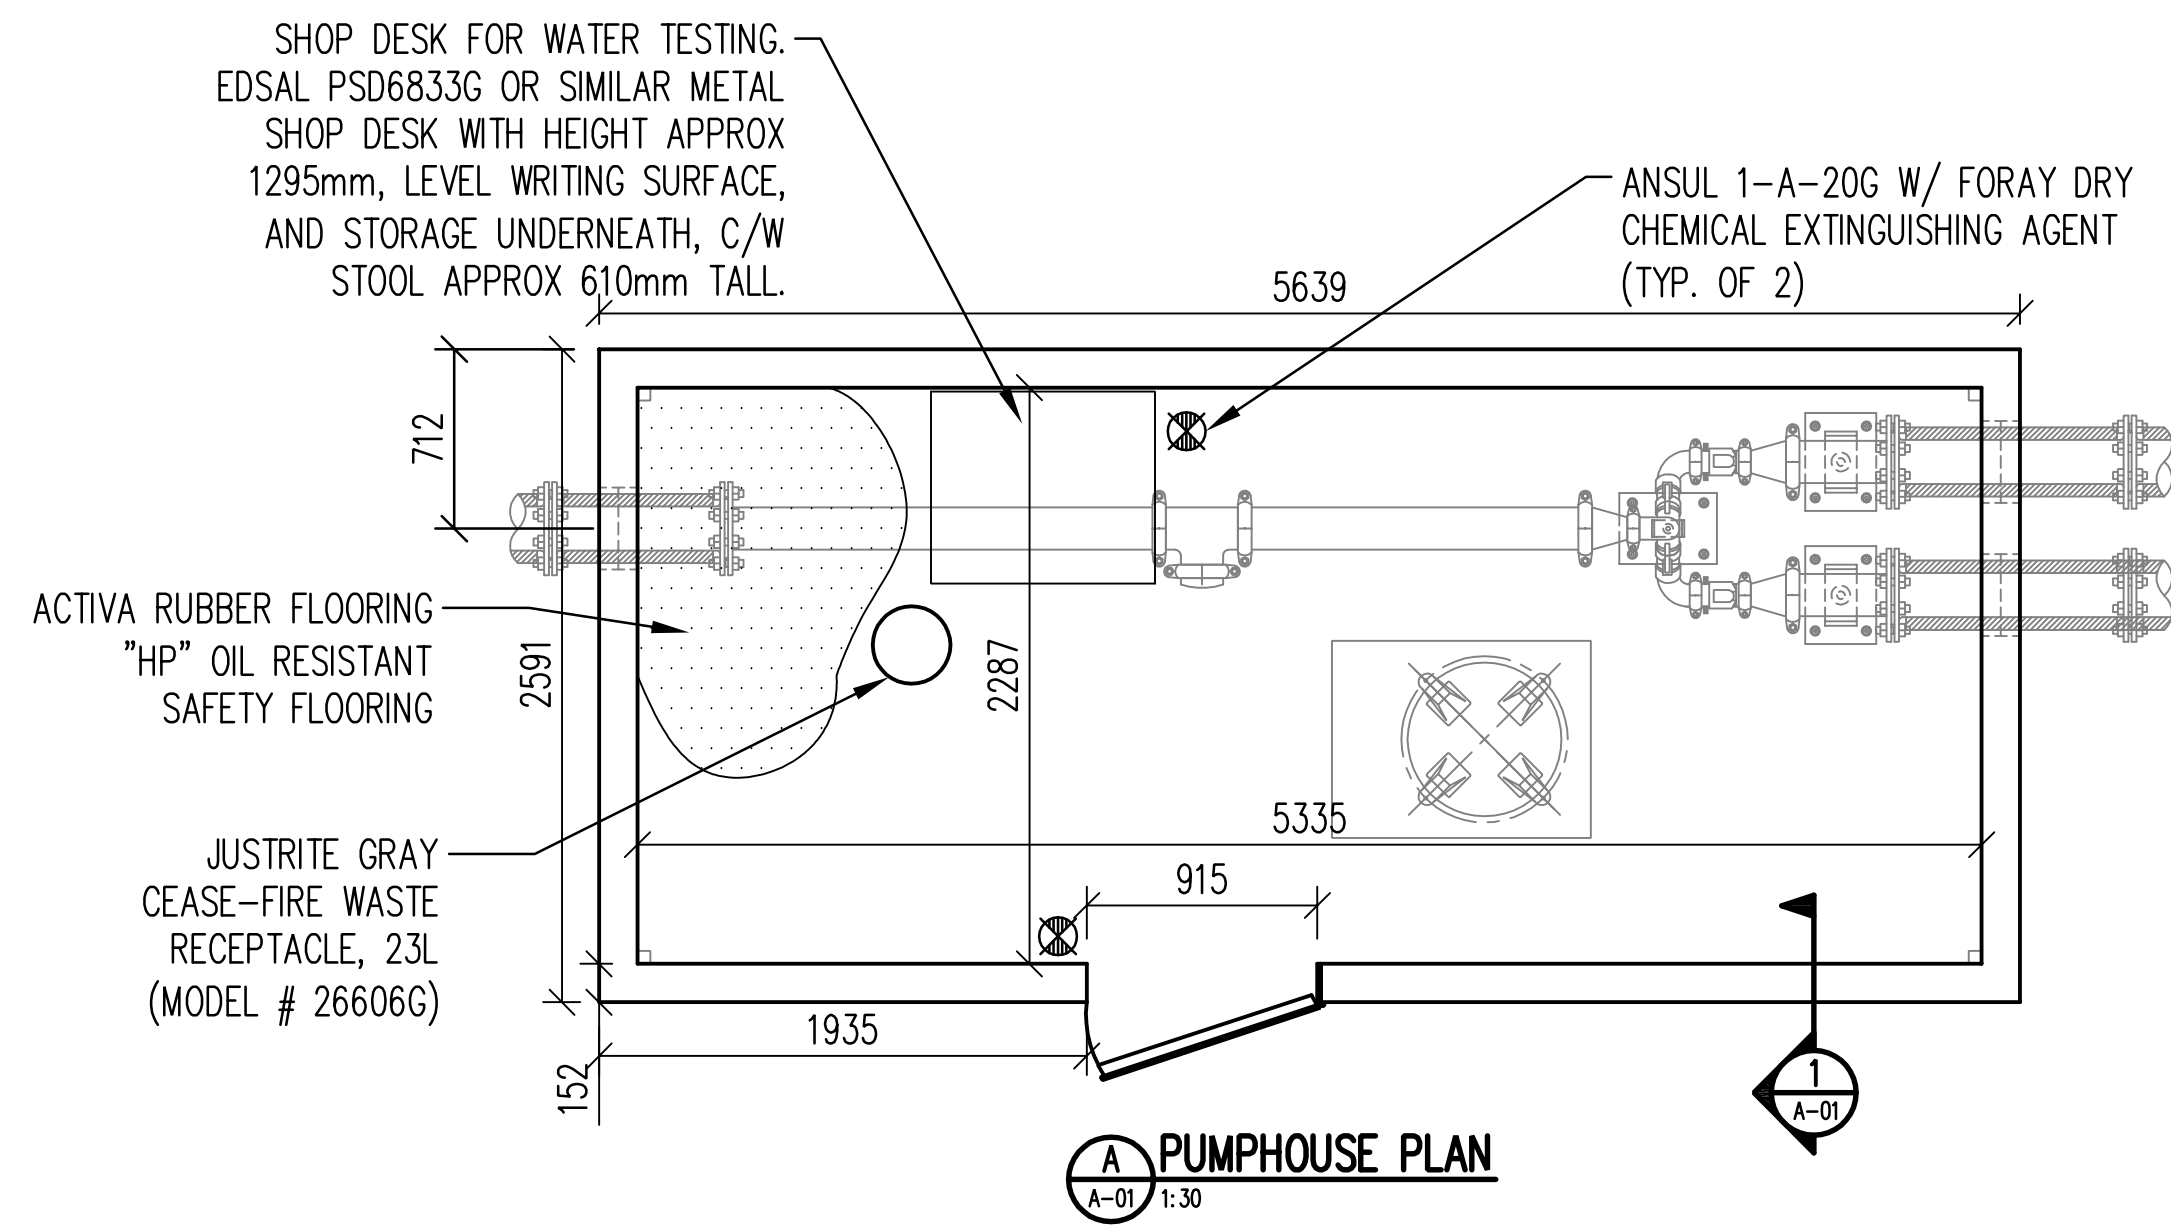

### BUILDING NOTES:

- BUILDING TO BE A BALLY MODULAR STRUCTURE WITH THE FOLLOWING SPECIFICATIONS:
- DESIGNED TO NATIONAL BUILDING CODE OF CANADA USING CLIMACTIC DATA FOR KUGLUKTUK, NU (FORMERLY KNOWN AS COPPERMINE)
- WALLS AND CEILING 152mm THICK
- BR-2 BULLET RESISTANCE
- STANDING SEAM ALUMINUM ROOF
- ONE (1) DOOR 101.6mm THICK, 914mm X 2134mm, C/W HASP, CATCH, AND PADLOCK.
- INTERIOR FINISH SMOOTH WHITE, EXTERIOR FINISH POLYESTER OVER GALVANIZED STEEL IN OWNER'S CHOICE OF COLOURS
- ALL SHOP DRAWINGS TO BE STAMPED BY A P.ENG REGISTERED WITH THE NORTHWEST TERRITORIES AND NUNAVUT ASSOCIATION OF PROFESSIONAL ENGINEERS AND GEOSCIENTISTS (NAPEG).
- FLOOR (DWG A-01, SECTION 1) AND SKID (SEE DWG S-02) NOT PROVIDED BY BALLY.

REVISIONS			
NO.	DESCRIPTION	DATE	BY
0	ISSUED FOR TENDER	2010.05.04	JG
1	ISSUED FOR CONSTRUCTION	2010.08.06	JG
2	RECORD DRAWING	2014.10.09	AC

### RECORD DRAWING

DRAWINGS WERE BASED UPON INFORMATION SUBMITTED FROM OTHER PARTIES AND THE ENGINEER DOES NOT WARRANT OR CERTIFY THAT THE INFORMATION FROM THESE OTHER PARTIES IS ACCURATE.  
DATE (YYYY MM DD): 2014.10.09

DRAWING NO.	DESCRIPTION
REFERENCE DRAWINGS	

FOR BEST PLOTTING RESULTS, BE SURE TO USE  
WILLIAMS ENGINEERING CANADA AUTOCAD PLOT CONFIGURATION  
FILES AVAILABLE FROM: [www.williamsengineering.com](http://www.williamsengineering.com)

### LEGEND

SECTION #	DETAIL #
1 A-01 SOURCE / REFERENCE DWG.	A E-01 SOURCE / REFERENCE DWG.


INFORMATION CONTAINED ON THIS DRAWING IS COPYRIGHTED AND HAS BEEN PREPARED FOR THE SOLE PURPOSE OF THIS PROJECT. UNAUTHORIZED USE OF THIS INFORMATION WILL BE CONSIDERED A BREACH OF COPYRIGHT AND MAY BE PURSUED AS SUCH. USE OF THIS INFORMATION FOR ANY OTHER PURPOSE OTHER THAN THIS PARTICULAR PROJECT IS AT THE RISK OF THE USER.

PERMIT STAMP:
PERMIT TO PRACTICE WILLIAMS ENGINEERING CANADA INC. PERMIT NUMBER P 646 NWT/NU Association of Professional Engineers and Geoscientists

ENGINEER'S SEAL:

YELLOWKNIFE OFFICE  
P.O. Box 1029  
480 47 Street  
Yellowknife, NT X1A 2P2  
Bus: (867) 673-2985  
Tel/Fax: 1-800-293-2983  
Fax: (867) 673-2987  
[info@williamsengineering.com](mailto:info@williamsengineering.com)  
[www.williamsengineering.com](http://www.williamsengineering.com)

WILLIAMS  
ENGINEERING  
CANADA

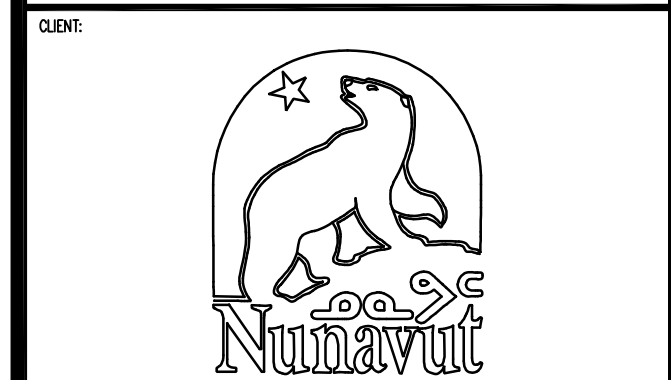

JOB TITLE:  
**WATER SUPPLY IMPROVEMENTS  
PHASE 1  
NEW INTAKE AND PUMPHOUSE  
KUGLUKTUK, NU**


DWG. TITLE:  
**PUMPHOUSE  
PLAN AND ELEVATIONS**

OWN. BY:	JG	DES. BY:	JG	PROJ. MGR.:	JH
PEER REVIEW:	JH	DATE: (YY-MM-DD)	2010.08.06	SCALE:	AS NOTED
CLIENT PROJ. #	GN PROJECT #04-4417	REC PROJ. #	13655.00		

DWG. NO. A-01 1 of 1



DATE & FILE NAME: C:\Projects\2009\13655\13655-03-01.dwg PLOTTED DATE: 10/27/10 2:51 PM  
PLOTTER: HP DesignJet 1000 Plotter PLOTTED BY: JH

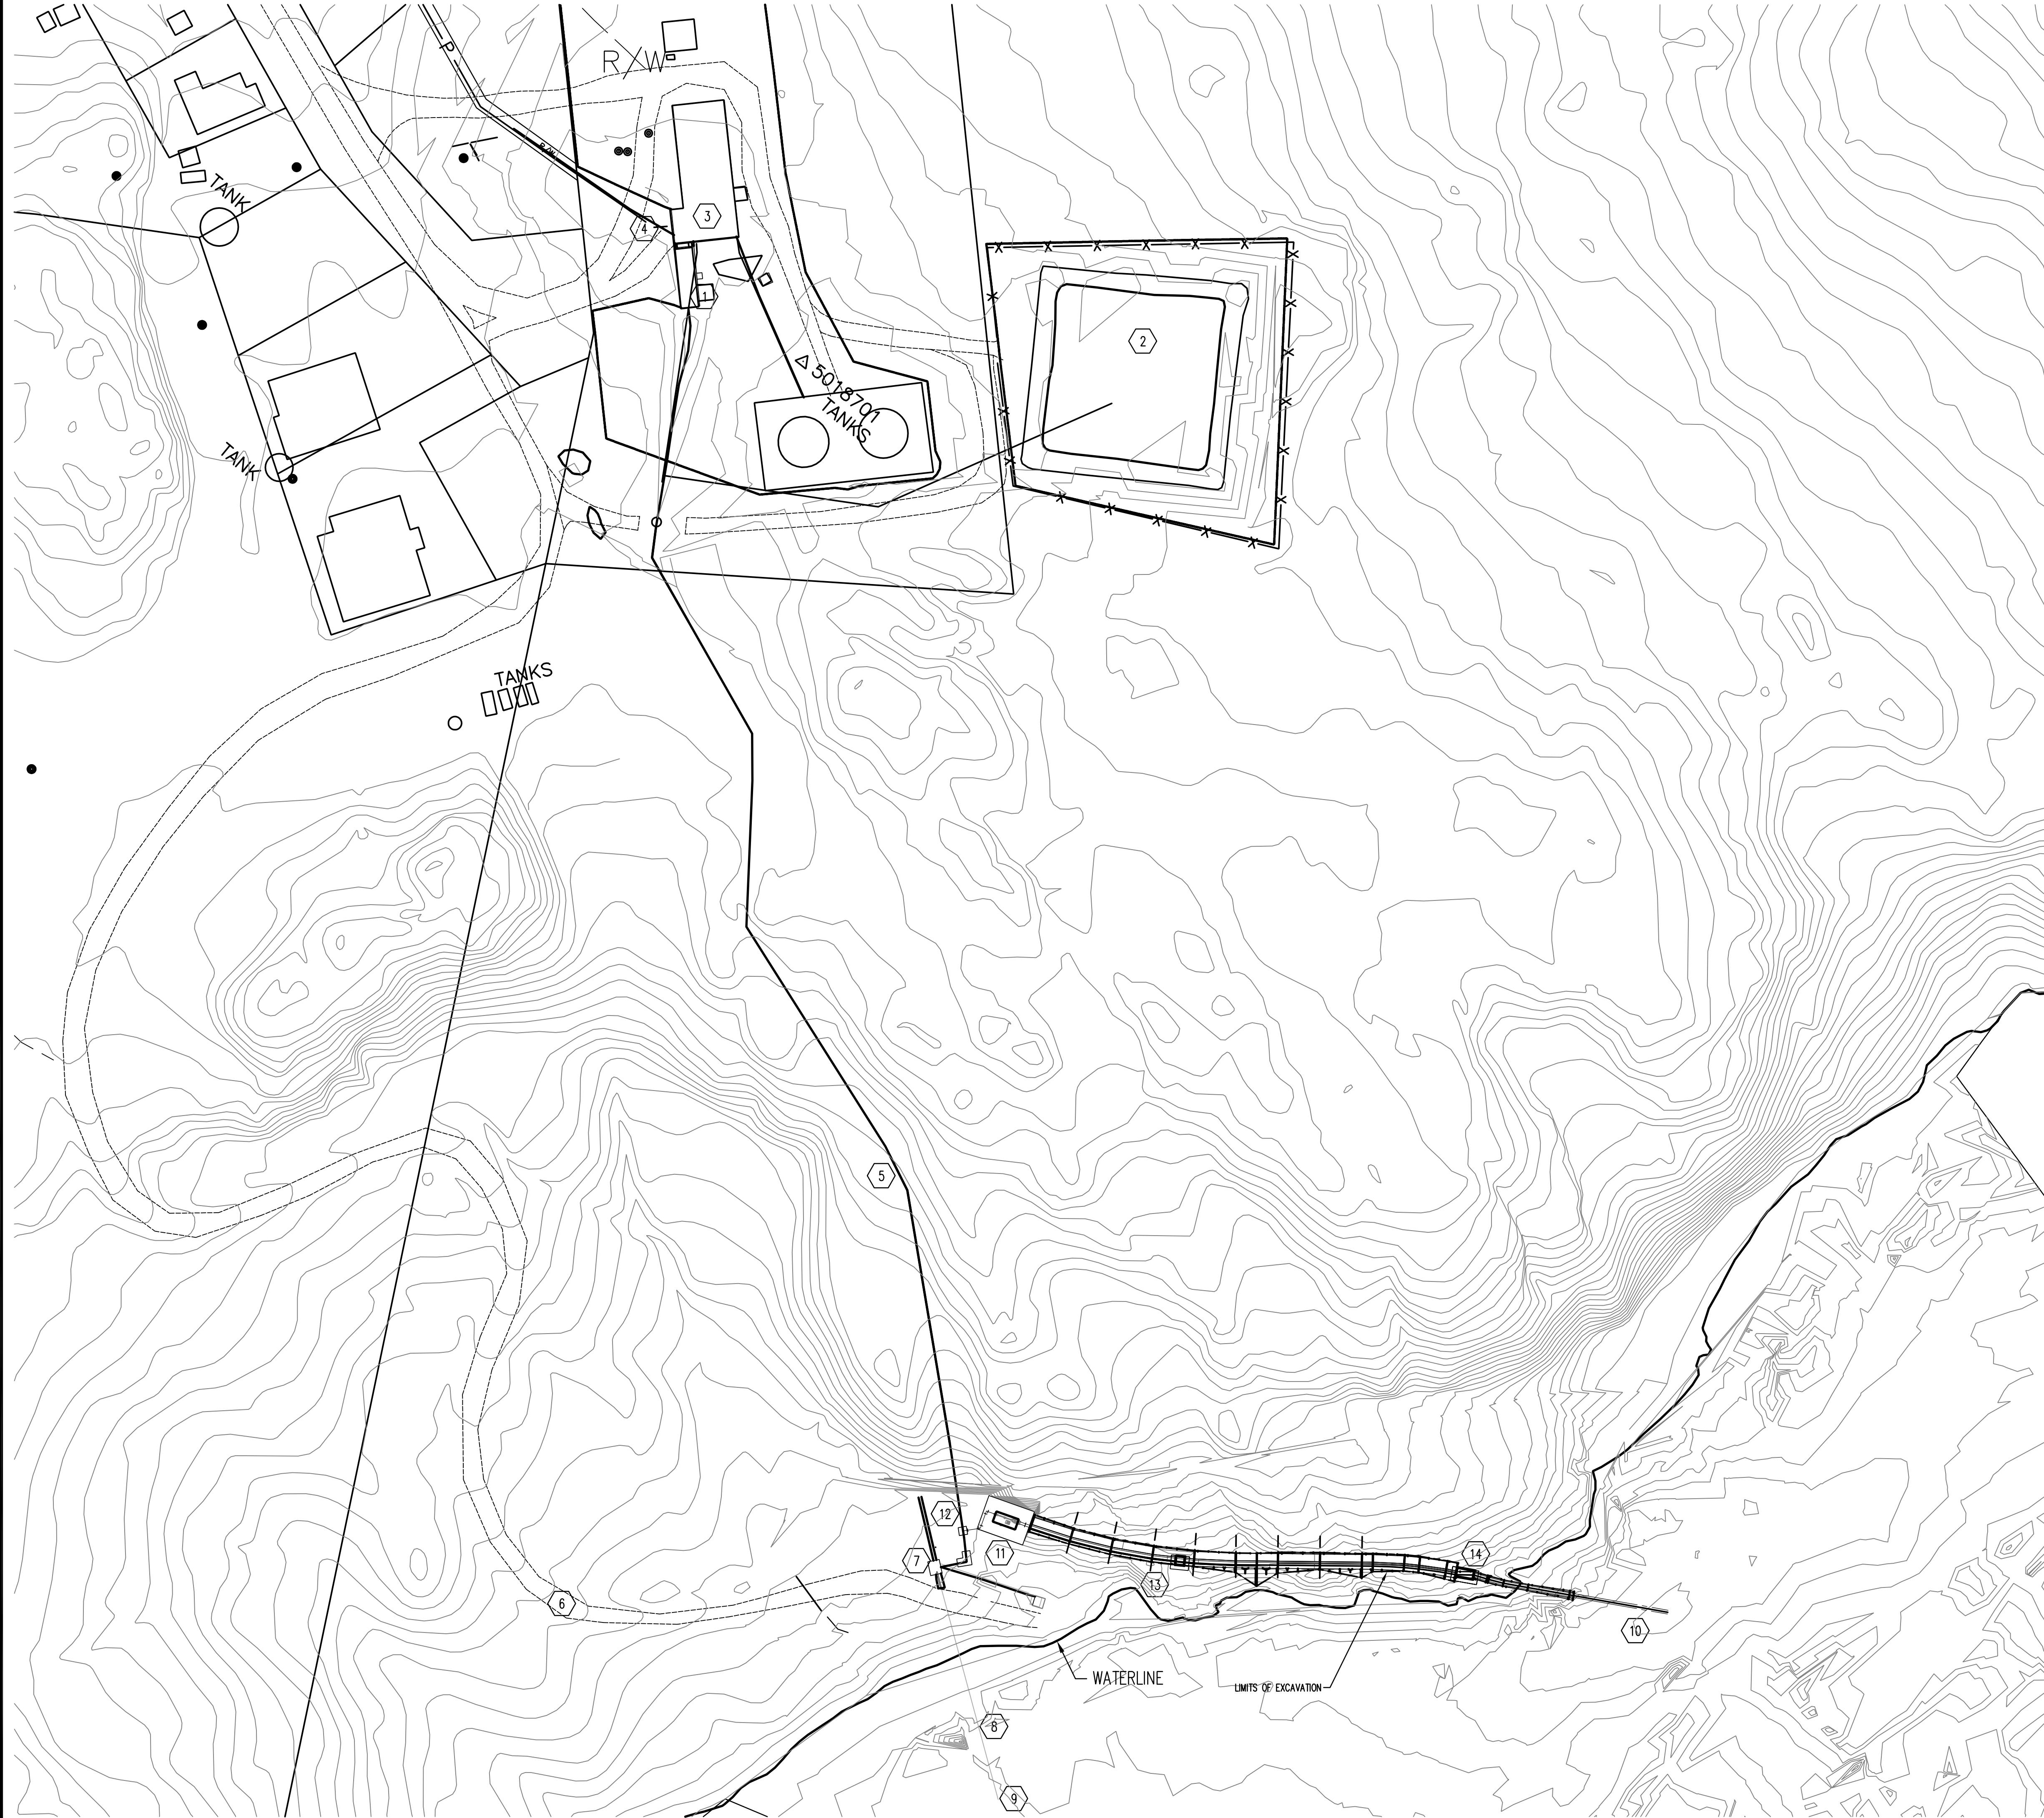

#### KEYNOTES:

- 1 EXISTING WATER TREATMENT PLANT
- 2 EXISTING RAW WATER STORAGE POND
- 3 EXISTING TREATED WATER STORAGE
- 4 EXISTING TRUCKFILL STATION
- 5 EXISTING RAW WATER PIPELINE
- 6 EXISTING PUMPHOUSE ACCESS ROAD
- 7 EXISTING PUMPHOUSE
- 8 EXISTING RAW WATER CASING
- 9 INTAKE SCREENS TO BE REPLACED WITH BLIND FLANGES AND PIPE ABANDONED IN PLACE
- 10 PROPOSED NEW RAW WATER INTAKE. SEE DWG C-02 FOR PLAN AND PROFILE.
- 11 PROPOSED NEW RAW WATER PUMPHOUSE.
- 12 PROPOSED CONNECTION TO EXISTING 150mm RAW WATER PIPELINE - SEE DWG M-03, DETAIL A.
- 13 ACCESS VAULT 1
- 14 ACCESS VAULT 2

#### REVISIONS

NO.	DESCRIPTION	DATE	BY	APP.
0	ISSUED FOR TENDER	2010.05.04	JH	JH
1	ISSUED FOR CONSTRUCTION	2010.08.06	JH	JH
2	RECORD DRAWING	2014.10.09	AC	

#### RECORD DRAWING

DRAWINGS WERE BASED UPON INFORMATION SUBMITTED FROM OTHER PARTIES AND THE ENGINEER DOES NOT WARRANT OR CERTIFY THAT THE INFORMATION FROM THESE OTHER PARTIES IS ACCURATE.  
DATE (YYYY MM DD): 2014.10.09

#### REFERENCE DRAWINGS

FOR BEST PLOTTING RESULTS, BE SURE TO USE WILLIAMS ENGINEERING CANADA AUTOCAD PLOT CONFIGURATION FILES AVAILABLE FROM: [www.williamsengineering.com](http://www.williamsengineering.com)

#### LEGEND

	SECTION # A-001		DETAIL # E-001
	SOURCE / REFERENCE DWG.		SOURCE / REFERENCE DWG.

INFORMATION CONTAINED ON THIS DRAWING IS COPYRIGHTED AND HAS BEEN PREPARED FOR THE SOLE PURPOSE OF THIS PROJECT. UNAUTHORIZED USE OF THIS INFORMATION WILL BE CONSIDERED A BREACH OF COPYRIGHT AND MAY BE PURSUED AS SUCH. USE OF THIS INFORMATION FOR ANY OTHER PURPOSE OTHER THAN THIS PARTICULAR PROJECT IS AT THE RISK OF THE USER.

#### PERMIT STAMP:

PERMIT TO PRACTICE  
WILLIAMS ENGINEERING CANADA INC.  
PERMIT NUMBER  
P 646  
NWT/NJ Association of Professional  
Engineers and Geoscientists

#### ENGINEER'S SEAL:

YELLOWKNIFE OFFICE  
P.O. Box 1529  
480 47 Street  
Yellowknife, NT X1A 2P2  
Bus: (867) 873-2386  
Tel Fax: 1-800-263-2383  
Fax: (867) 873-2547  
info@williamsengineering.com  
www.williamsengineering.com

WILLIAMS  
ENGINEERING  
CANADA

**WE**

#### CLIENT:





JOB TITLE:  
**WATER SUPPLY IMPROVEMENTS  
PHASE 1  
NEW INTAKE AND PUMPHOUSE  
KUGLUKTUK, NU**

#### SITE PLAN

OWN: JH	DES BY: JH/JC	PROJ. MGR: JH
PEER REVIEW: JH	DATE: (YY-MM-DD) 2010.08.06	SCALE: 1:750
CLIENT PROJ. #	GN PROJECT #04-4417	REC PROJ. # 13655.03

C-01 5 1

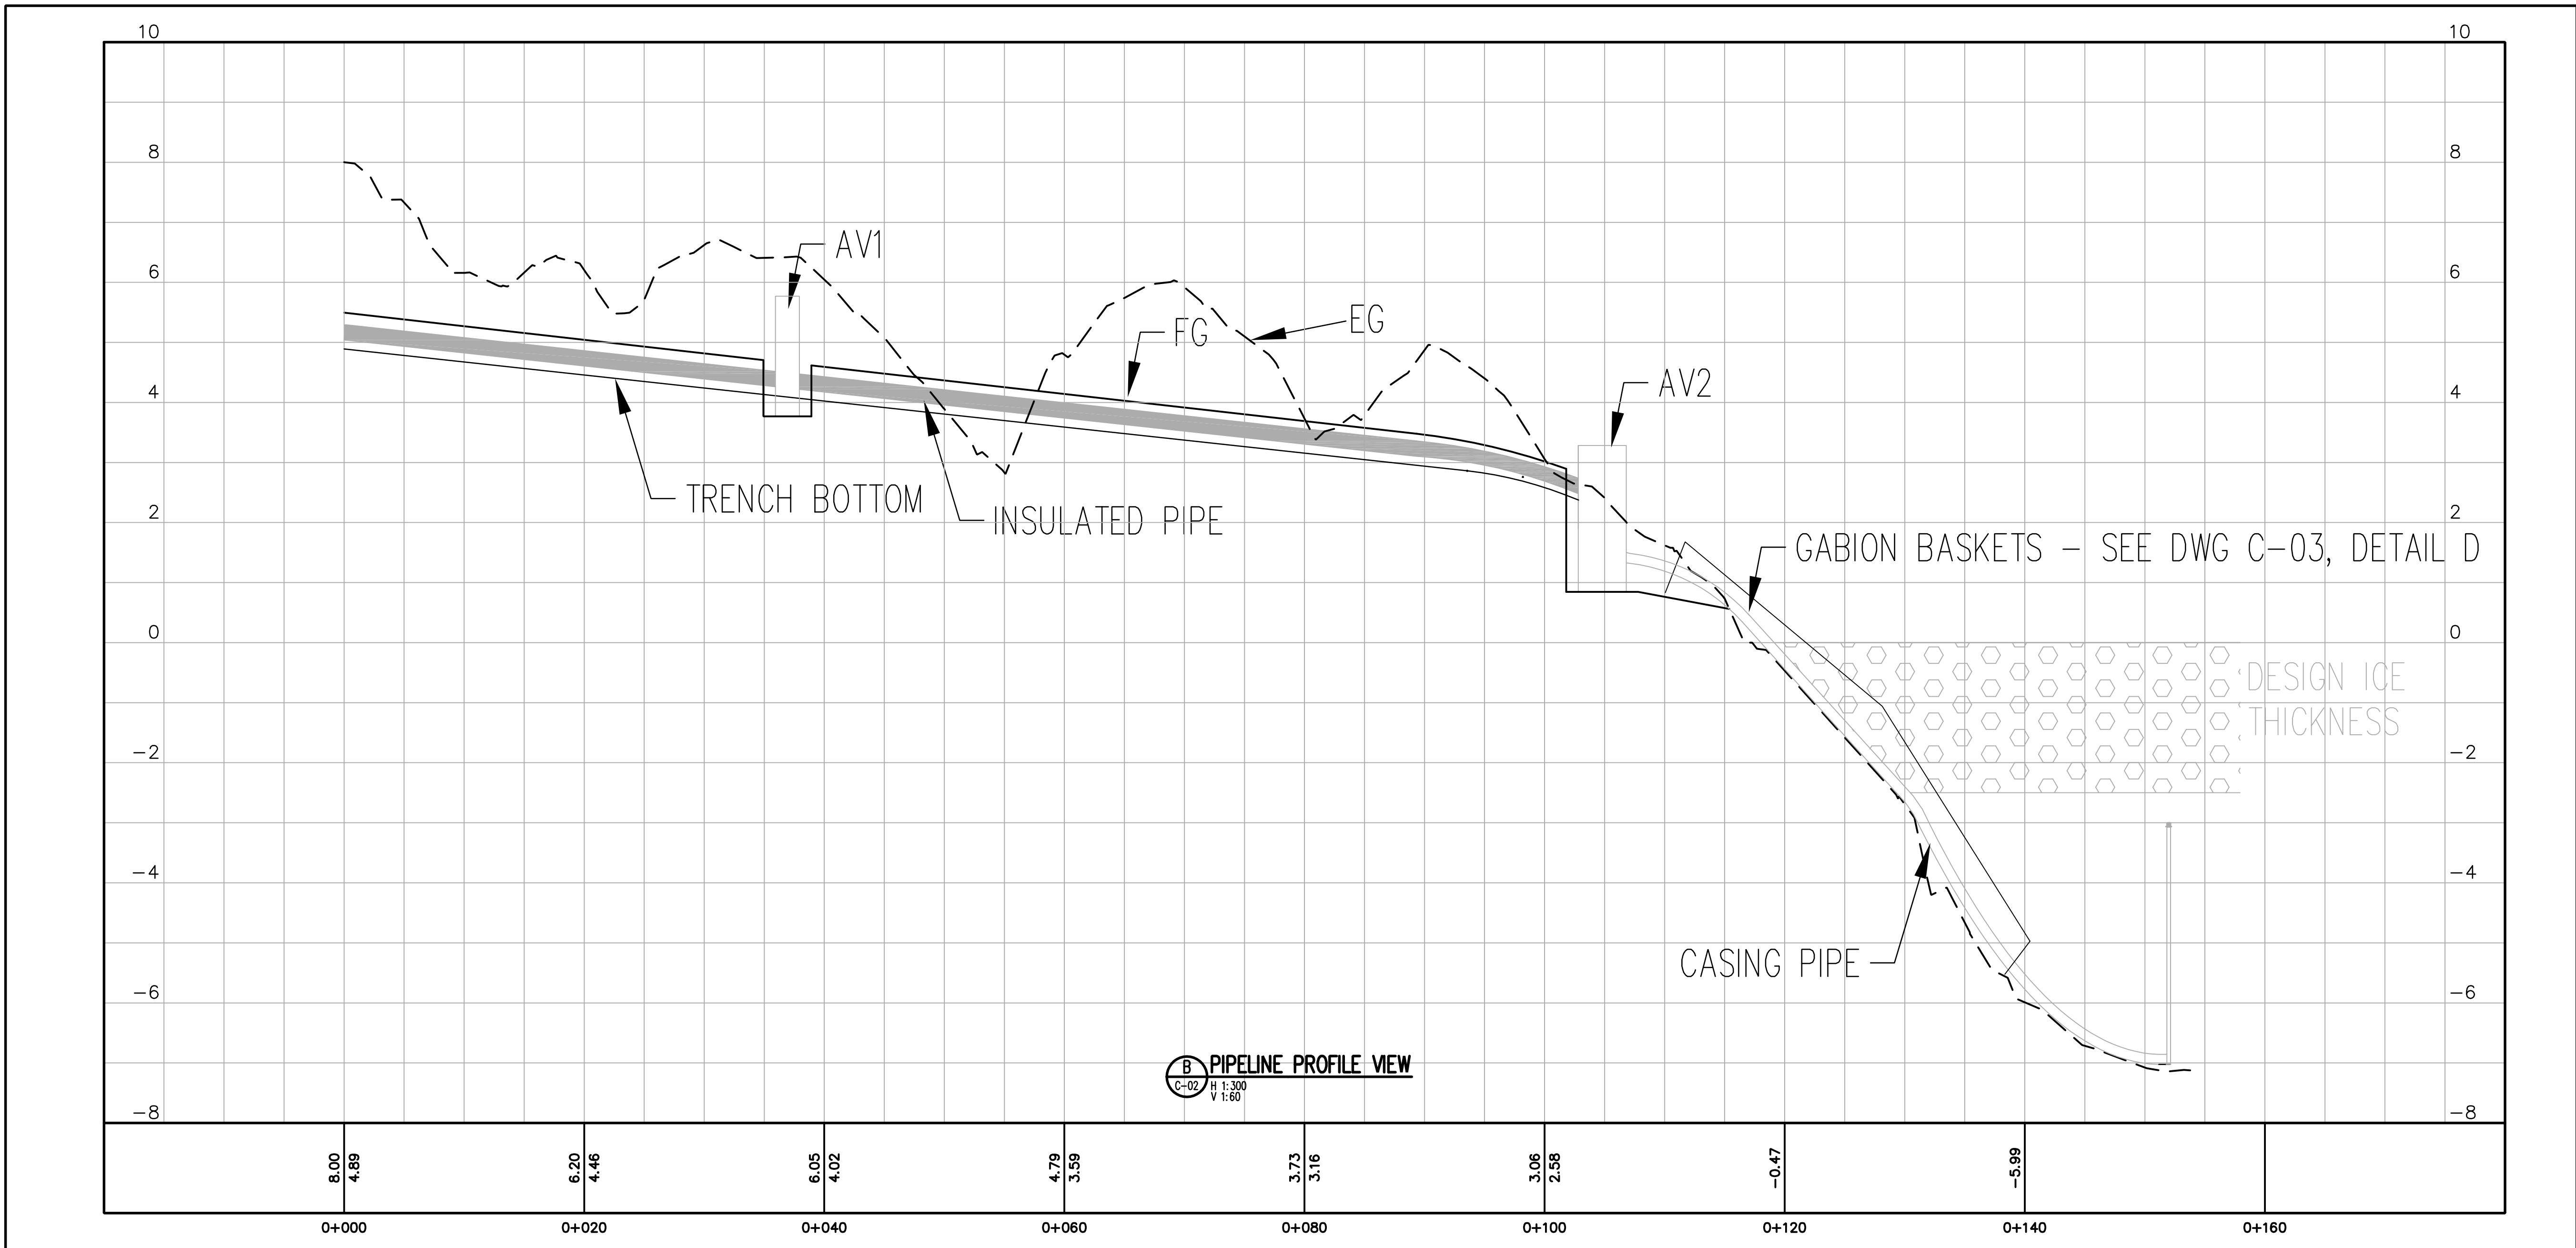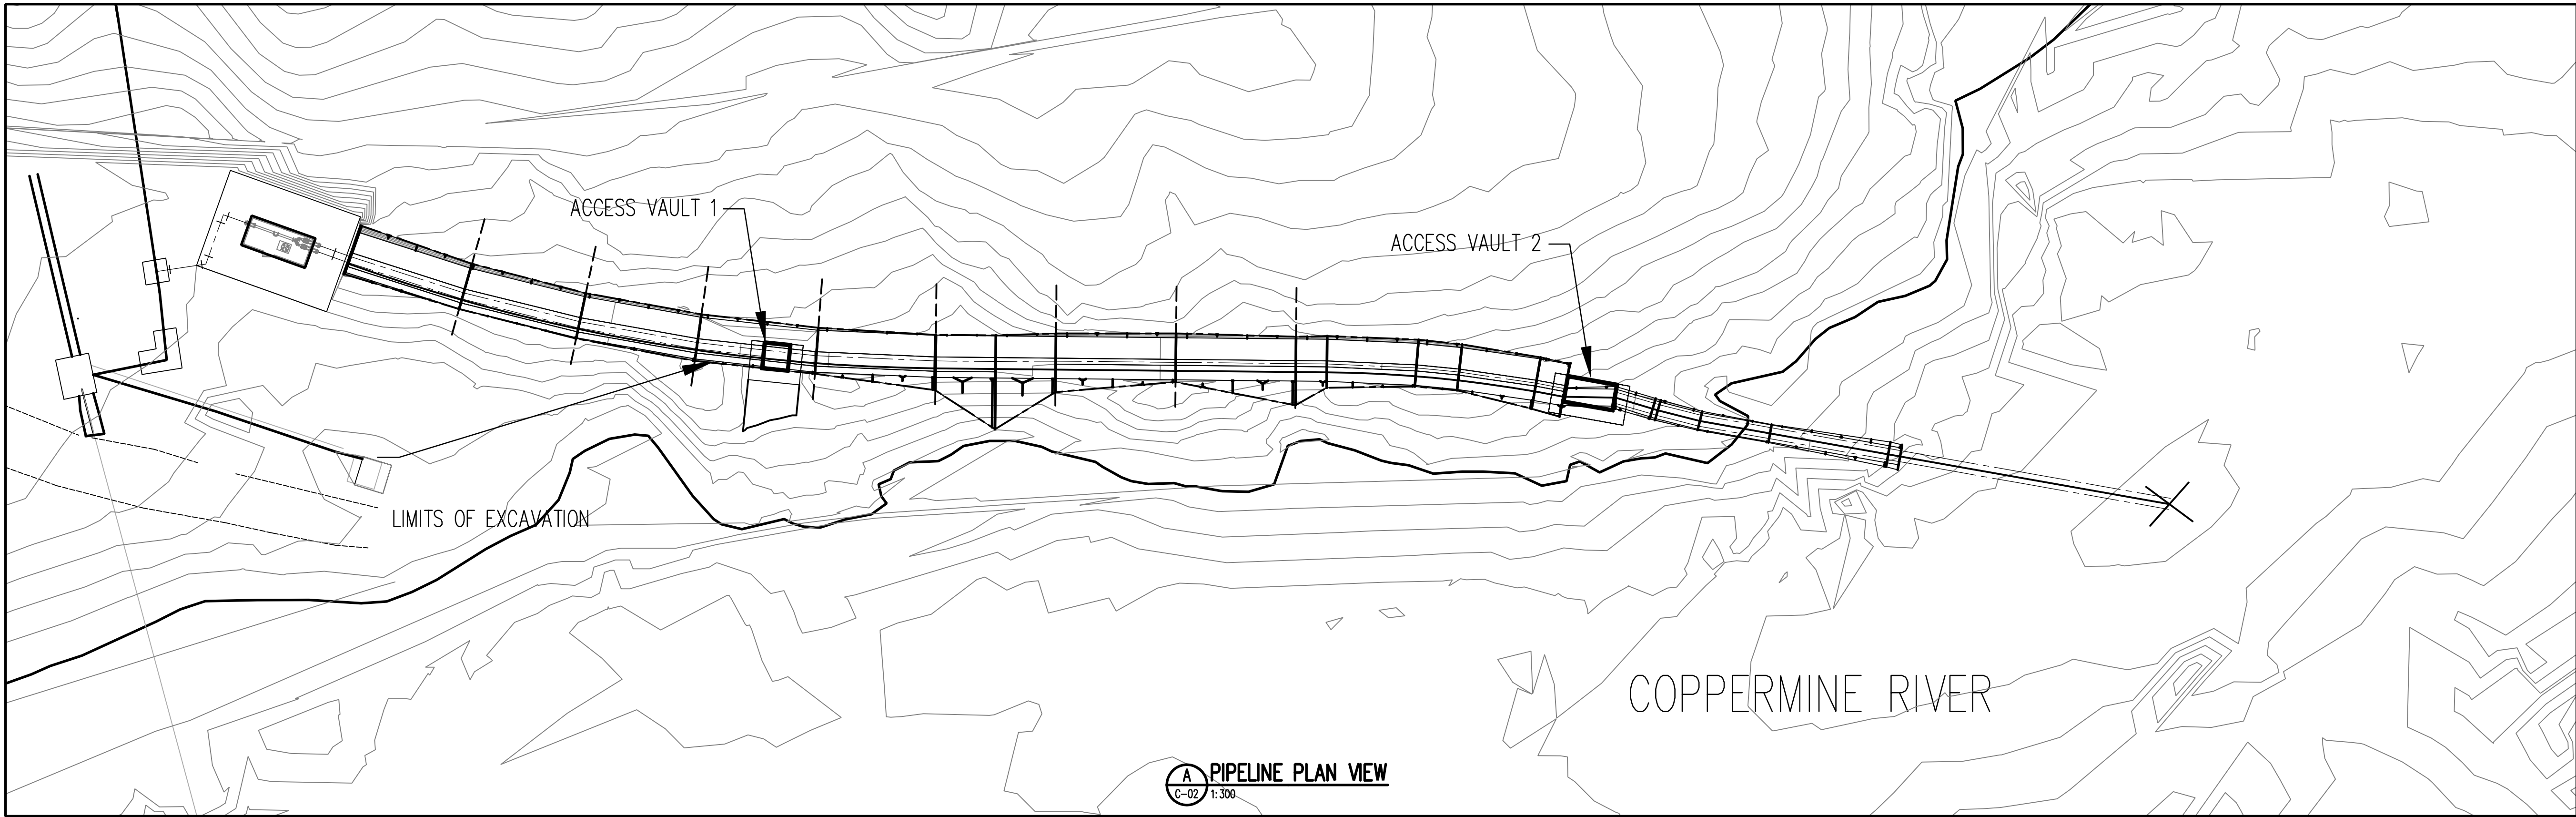

REVISIONS			
NO.	DESCRIPTION	DATE	BY
0	ISSUED FOR TENDER	2010.05.04	JG
1	ISSUED FOR CONSTRUCTION	2010.08.06	JG
2	RECORD DRAWING	2014.10.09	AC

**RECORD DRAWING**  
DRAWINGS WERE BASED UPON INFORMATION SUBMITTED FROM OTHER PARTIES AND THE ENGINEER DOES NOT WARRANT OR CERTIFY THAT THE INFORMATION FROM THESE OTHER PARTIES IS ACCURATE.  
DATE (YYYY MM DD): 2014.10.09

**REFERENCE DRAWINGS**

FOR BEST PLOTTING RESULTS, BE SURE TO USE WILLIAMS ENGINEERING CANADA AUTOCAD PLOT CONFIGURATION FILES AVAILABLE FROM: [www.williamsengineering.com](http://www.williamsengineering.com)

**LEGEND**

SECTION # 1 A-001  
SOURCE / REFERENCE DWG.

DETAIL # A-001  
SOURCE / REFERENCE DWG.

INFORMATION CONTAINED ON THIS DRAWING IS COPYRIGHTED AND HAS BEEN PREPARED FOR THE SOLE PURPOSE OF THIS PROJECT. UNAUTHORIZED USE OF THIS INFORMATION WILL BE CONSIDERED A BREACH OF COPYRIGHT AND MAY BE PURSUED AS SUCH. USE OF THIS INFORMATION FOR ANY OTHER PURPOSE OTHER THAN THIS PARTICULAR PROJECT IS AT THE RISK OF THE USER.

PERMIT STAMP:

PERMIT TO PRACTICE  
WILLIAMS ENGINEERING CANADA INC.  
PERMIT NUMBER  
P 646  
NWT/NJ Association of Professional Engineers and Geoscientists

ENGINEER'S SEAL:

YELLOWKNIFE OFFICE  
P.O. Box 1059  
480 47 Street  
Yellowknife, NT X1A 2P2  
Bus: (867) 873-2386  
Tel Fax: 1-800-263-2383  
Fax: (867) 873-2407  
info@williamsengineering.com  
www.williamsengineering.com

**WILLIAMS ENGINEERING CANADA**

**WE**

CLIENT:

**Nunavut**





**WATER SUPPLY IMPROVEMENTS PHASE 1  
NEW INTAKE AND PUMPHOUSE  
KUGLUKTUK, NU**

**INTAKE  
PLAN AND PROFILE**

OWN: BY: JG DES: BY: JH/JG/AC PROJ: MGR: JH  
PEER REVIEW: JH DATE: (YY-MM-DD) 2010.08.06 SCALE: AS NOTED  
CLIENT PROJ: # GN PROJECT #04-4417 REC PROJ: # 13655.00









**C-02** of 5



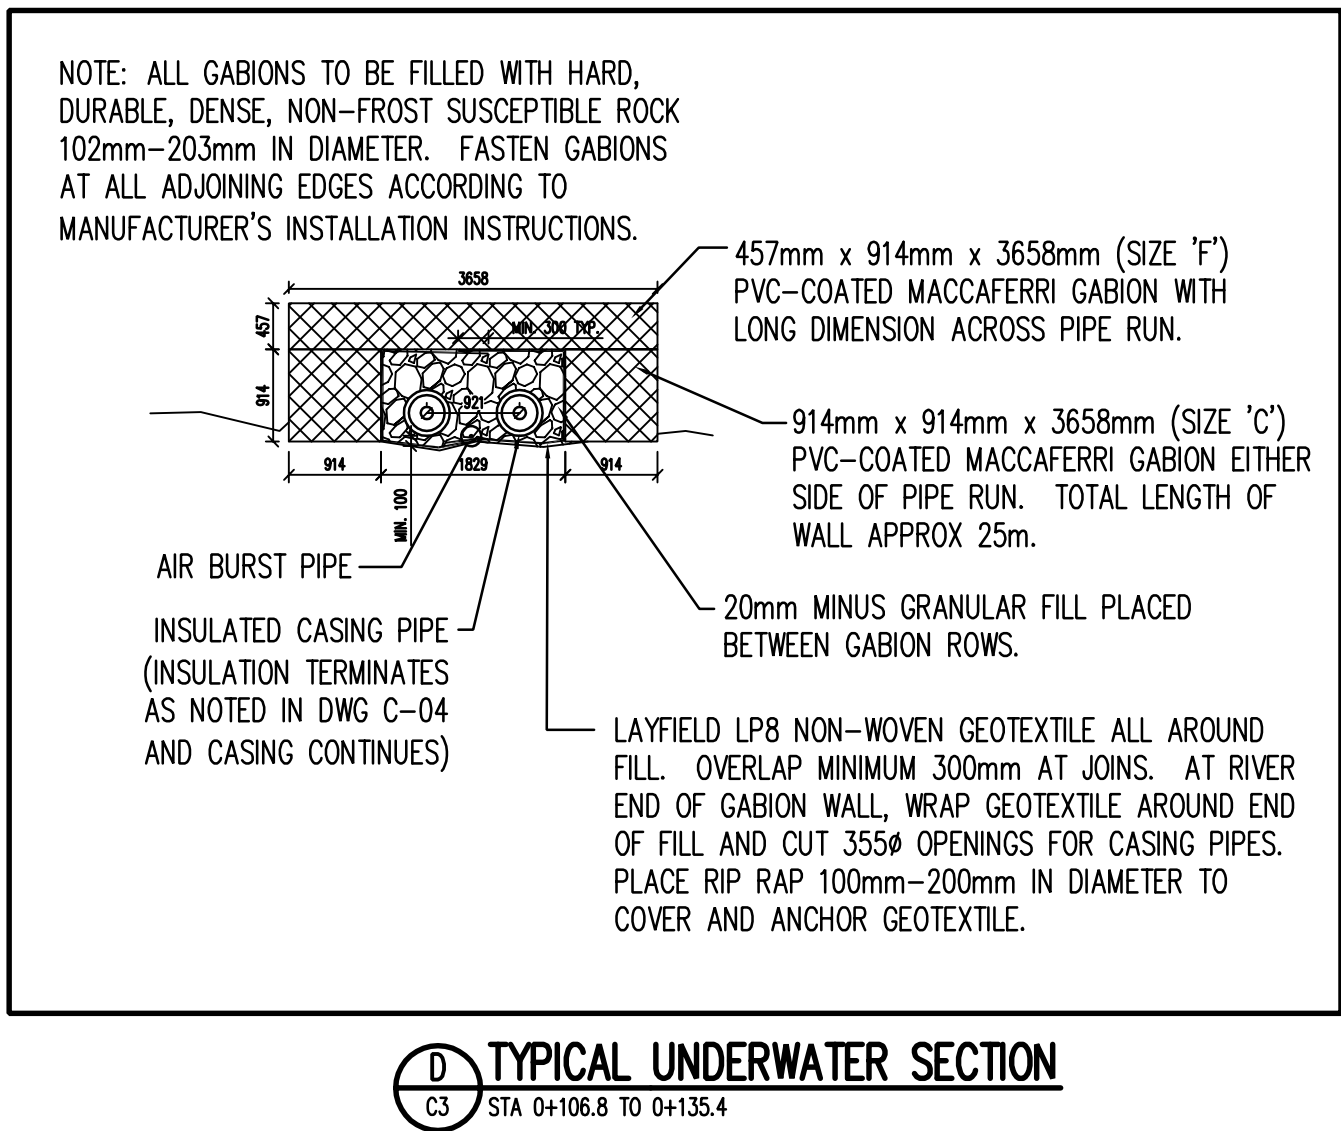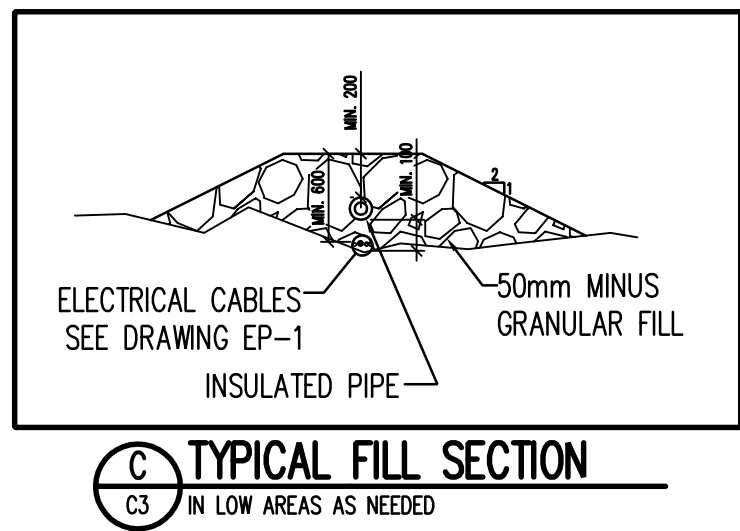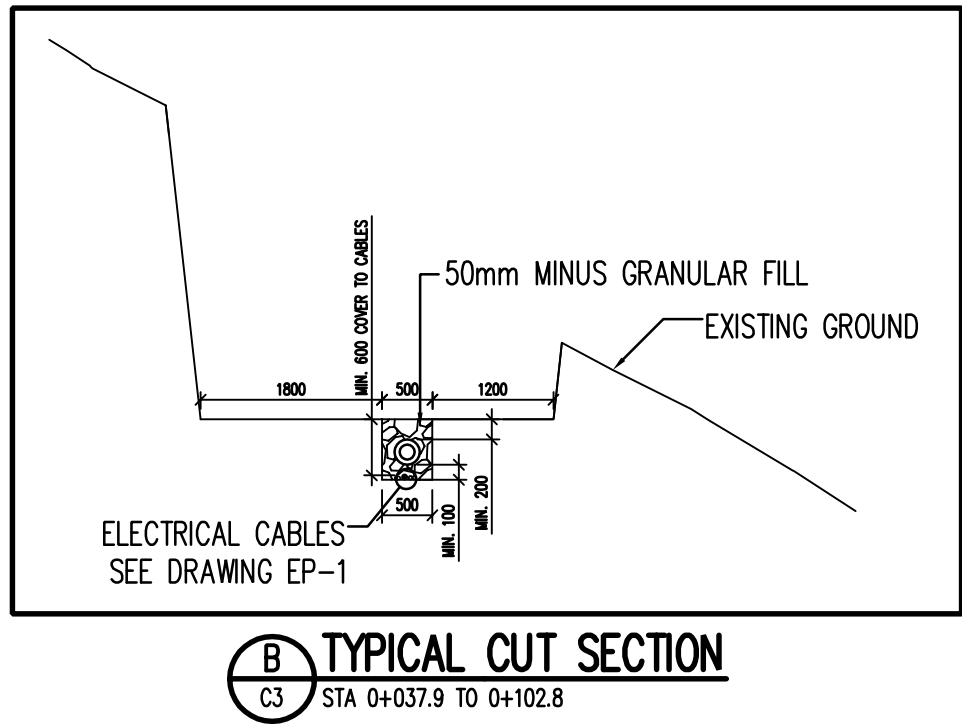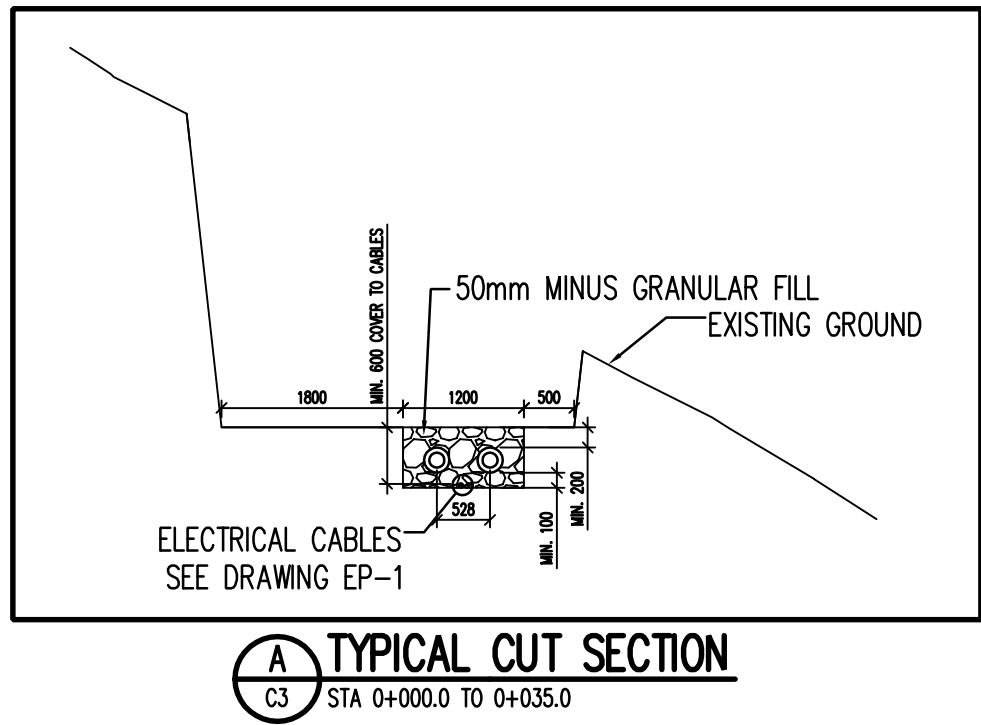

Total Volume Table						
Station	Fill Area	Cut Area	Fill Volume	Cut Volume	Cumulative Fill Vol	Cumulative Cut Vol
0+010.00	0.04	7.72	0.00	0.00	0.00	0.00
0+020.00	0.00	6.85	0.18	72.14	0.18	72.14
0+030.00	0.00	7.92	0.00	73.23	0.18	145.37
0+040.00	0.01	6.47	0.06	71.44	0.24	216.82
0+050.00	0.85	0.34	4.34	33.84	4.58	250.65
0+060.00	0.36	4.40	6.05	23.72	10.63	274.37
0+070.00	0.00	9.10	1.78	67.54	12.40	341.91
0+080.00	0.57	2.51	2.83	58.07	15.24	399.98

F VOLUMES FOR TRENCH SECTIONS SHOWN IN DETAIL E

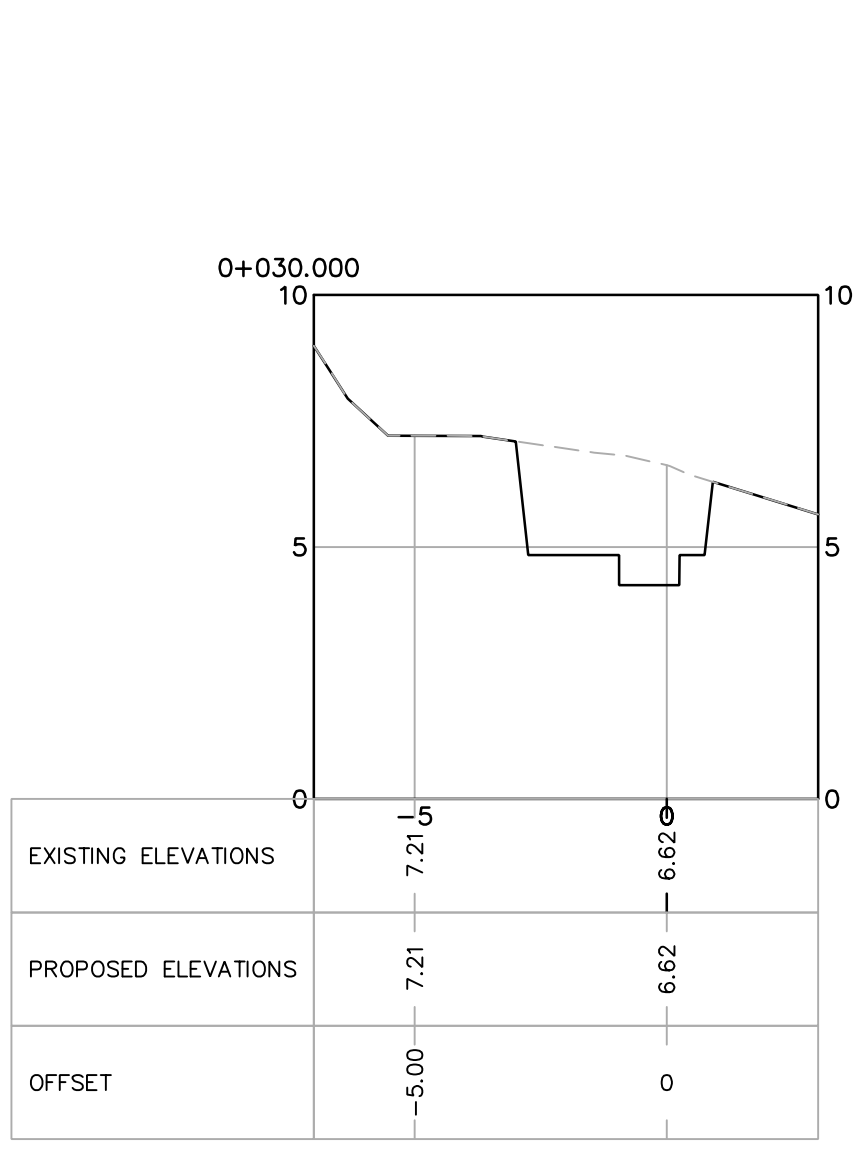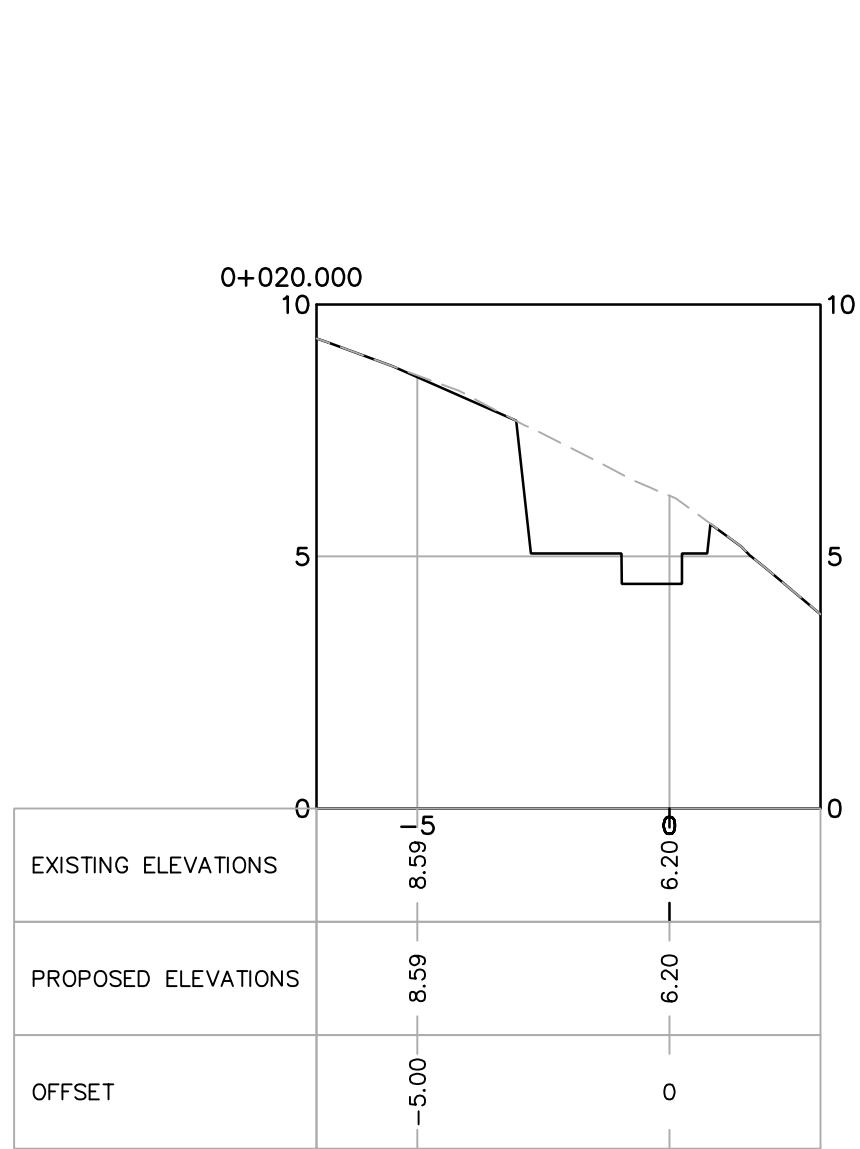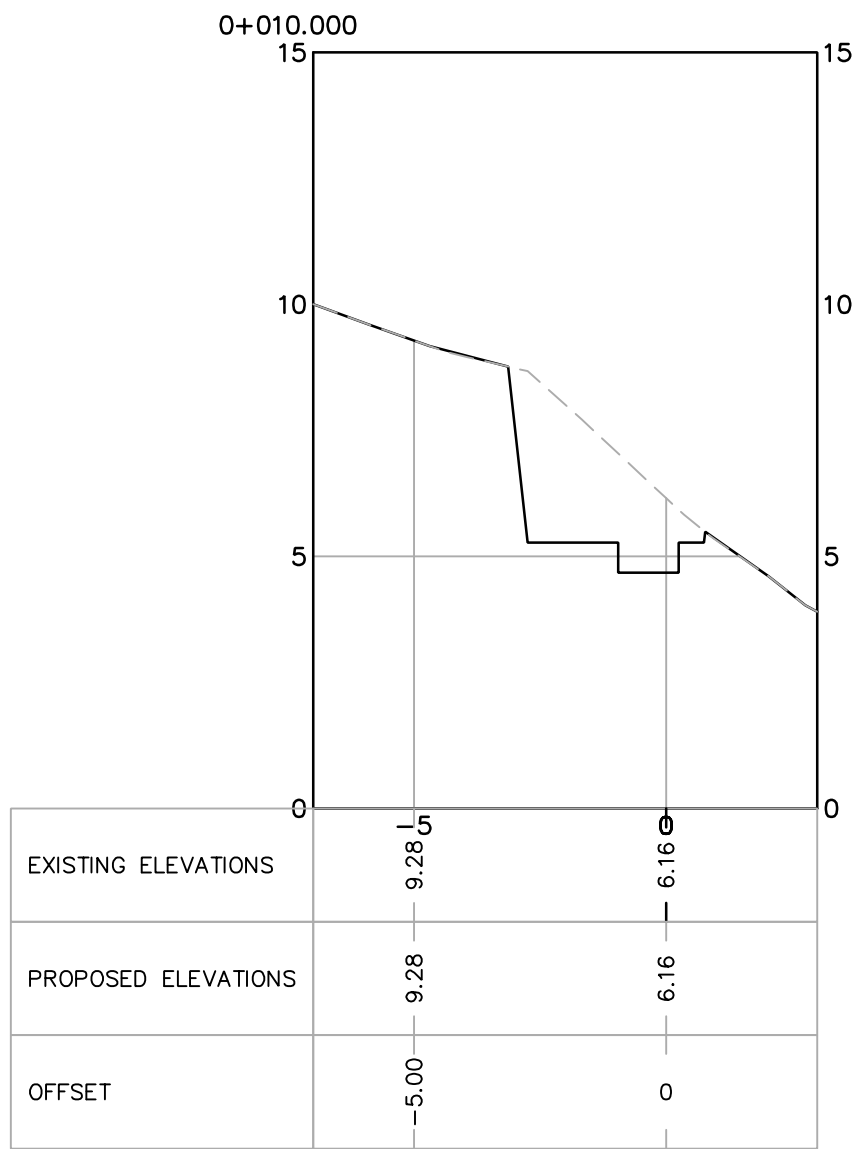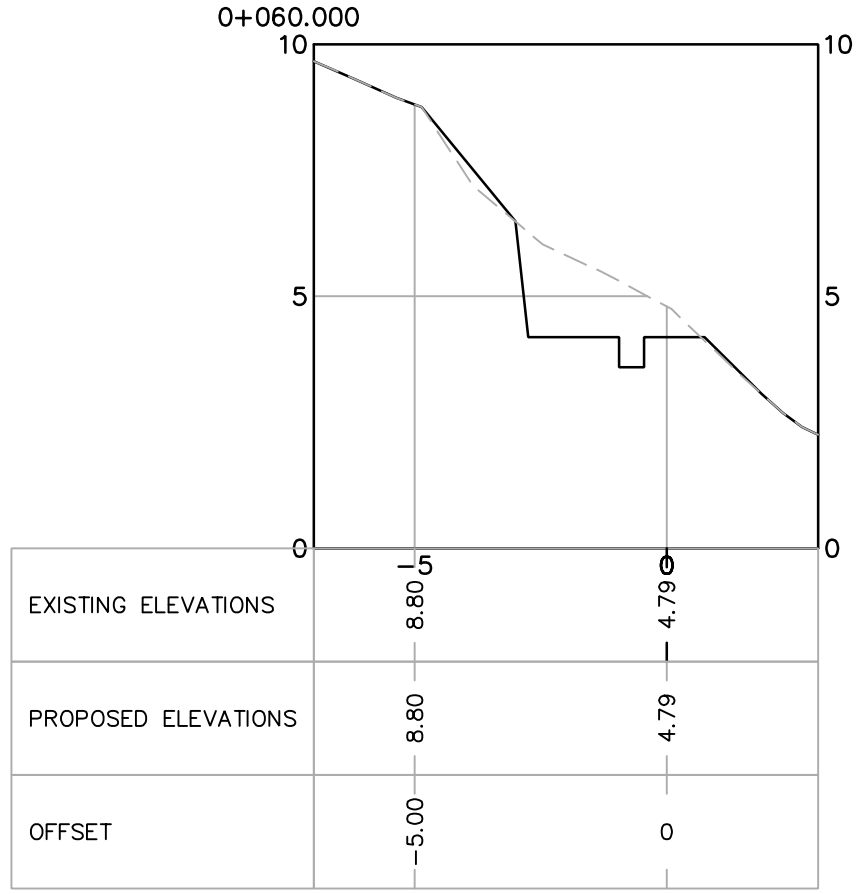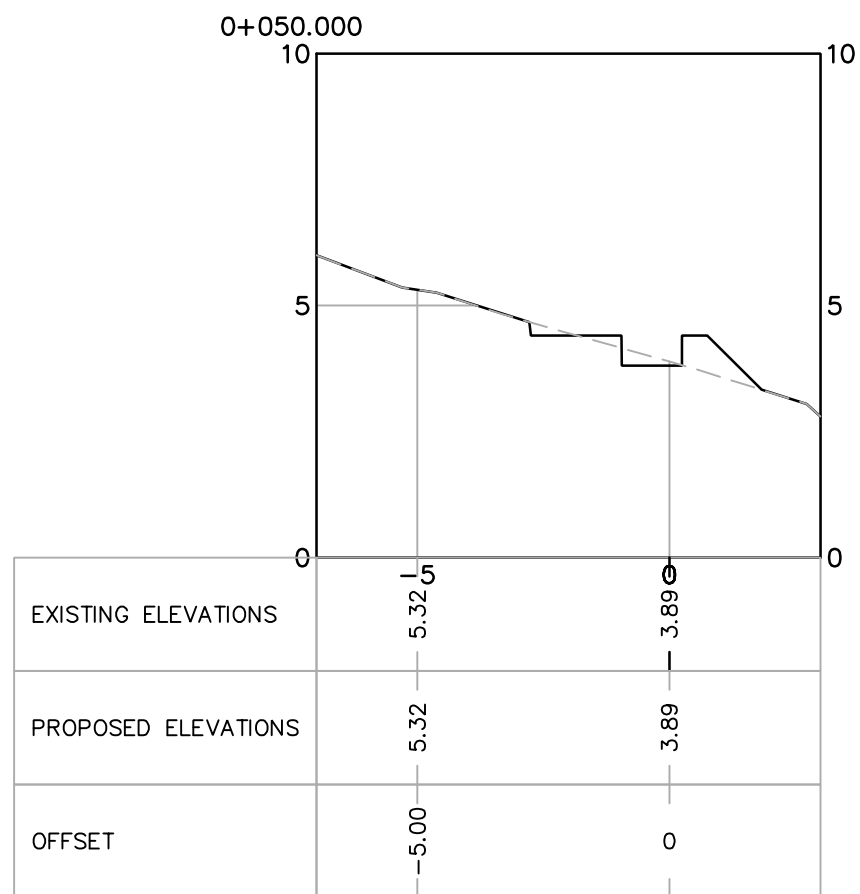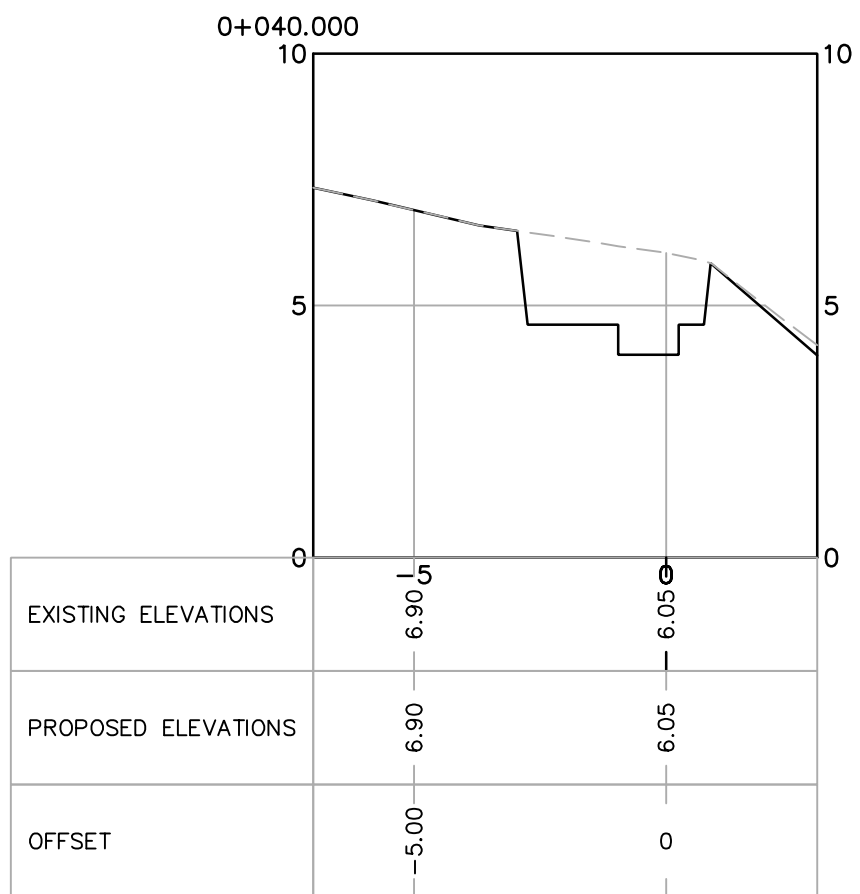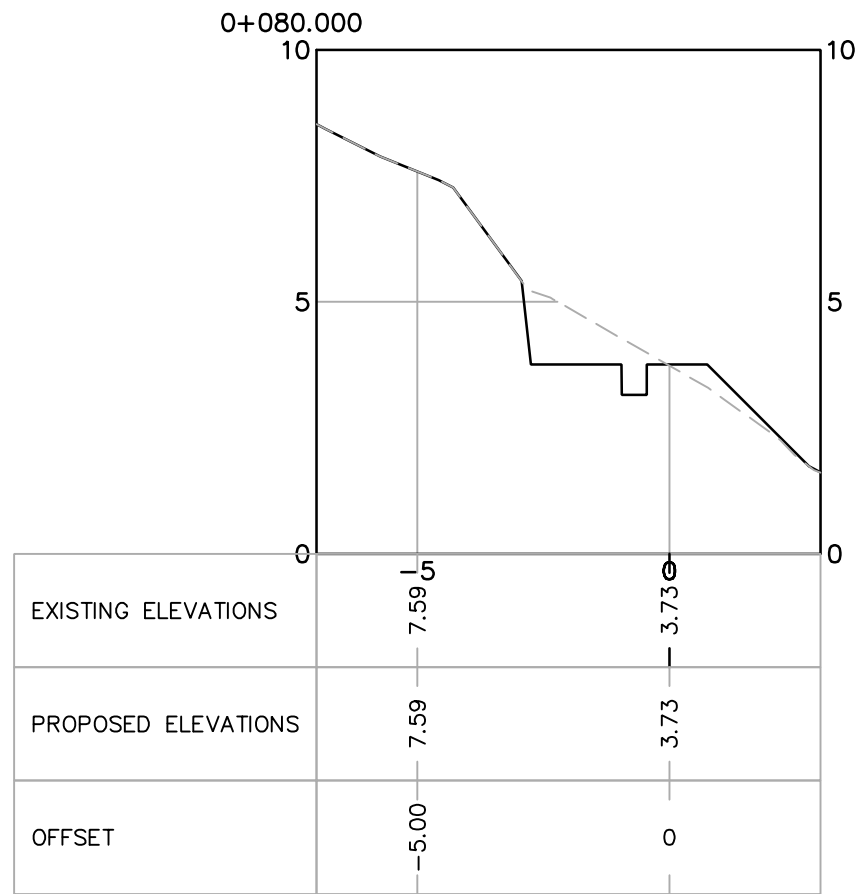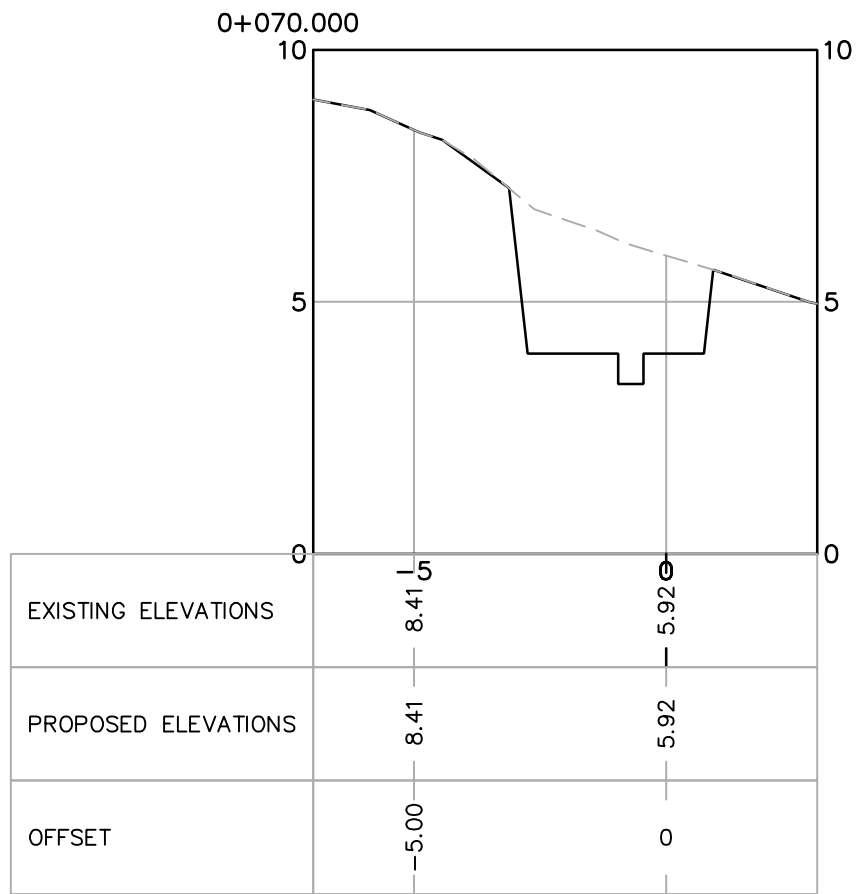

E EXCAVATION SECTIONS

REVISIONS

NO.	DESCRIPTION	DATE	BY	APP.
0	ISSUED FOR TENDER	2010.05.04	JG	JH
1	ISSUED FOR CONSTRUCTION	2010.08.06	JG	JH
2	RECORD DRAWING	2014.10.09	AC	

RECORD DRAWING

DRAWINGS WERE BASED UPON INFORMATION SUBMITTED FROM OTHER PARTIES AND THE ENGINEER DOES NOT WARRANT OR CERTIFY THAT THE INFORMATION FROM THESE OTHER PARTIES IS ACCURATE.

DATE (YYYY MM DD): 2014.10.09

REFERENCE DRAWINGS

FOR BEST PLOTTING RESULTS, BE SURE TO USE WILLIAMS ENGINEERING CANADA AUTOCAD PLOT CONFIGURATION FILES AVAILABLE FROM: [www.williamsengineering.com](http://www.williamsengineering.com)

LEGEND

SECTION # 1 A-001  
SOURCE / REFERENCE DWG. E-001

PERMIT TO PRACTICE

WILLIAMS ENGINEERING CANADA INC.  
PERMIT NUMBER P 646  
NWT/NJ Association of Professional Engineers and Geoscientists

ENGINEER'S SEAL

CLIENT:

YELLOWKNIFE OFFICE

P.O. Box 1059  
480 87 Street  
Yellowknife, NT X1A 2P2  
Bus: (867) 873-2286  
Tel Fax: 1-800-293-2283  
Fax: (867) 873-2547  
info@williamsengineering.com  
www.williamsengineering.com

WILLIAMS ENGINEERING CANADA

WE

CLIENT

NUMAVUT

JOB TITLE

WATER SUPPLY IMPROVEMENTS  
PHASE 1  
NEW INTAKE AND PUMPHOUSE  
KUGLUKTUK, NU

DWG. TITLE

TRENCH CROSS SECTIONS AND VOLUME TABLE

OWN. BY:

JG

DES. BY:

JH/JG/JC

PROJ. MGR.:

JH

PEER REVIEW:

JH

DATE: (YY-MM-DD)

2010.08.06

SCALE:

AS NOTED

CLIENT PROJ. #

GN PROJECT #04-4417

REC. PROJ. #

13655.00

DATE

C-03

BY



5

REV


1





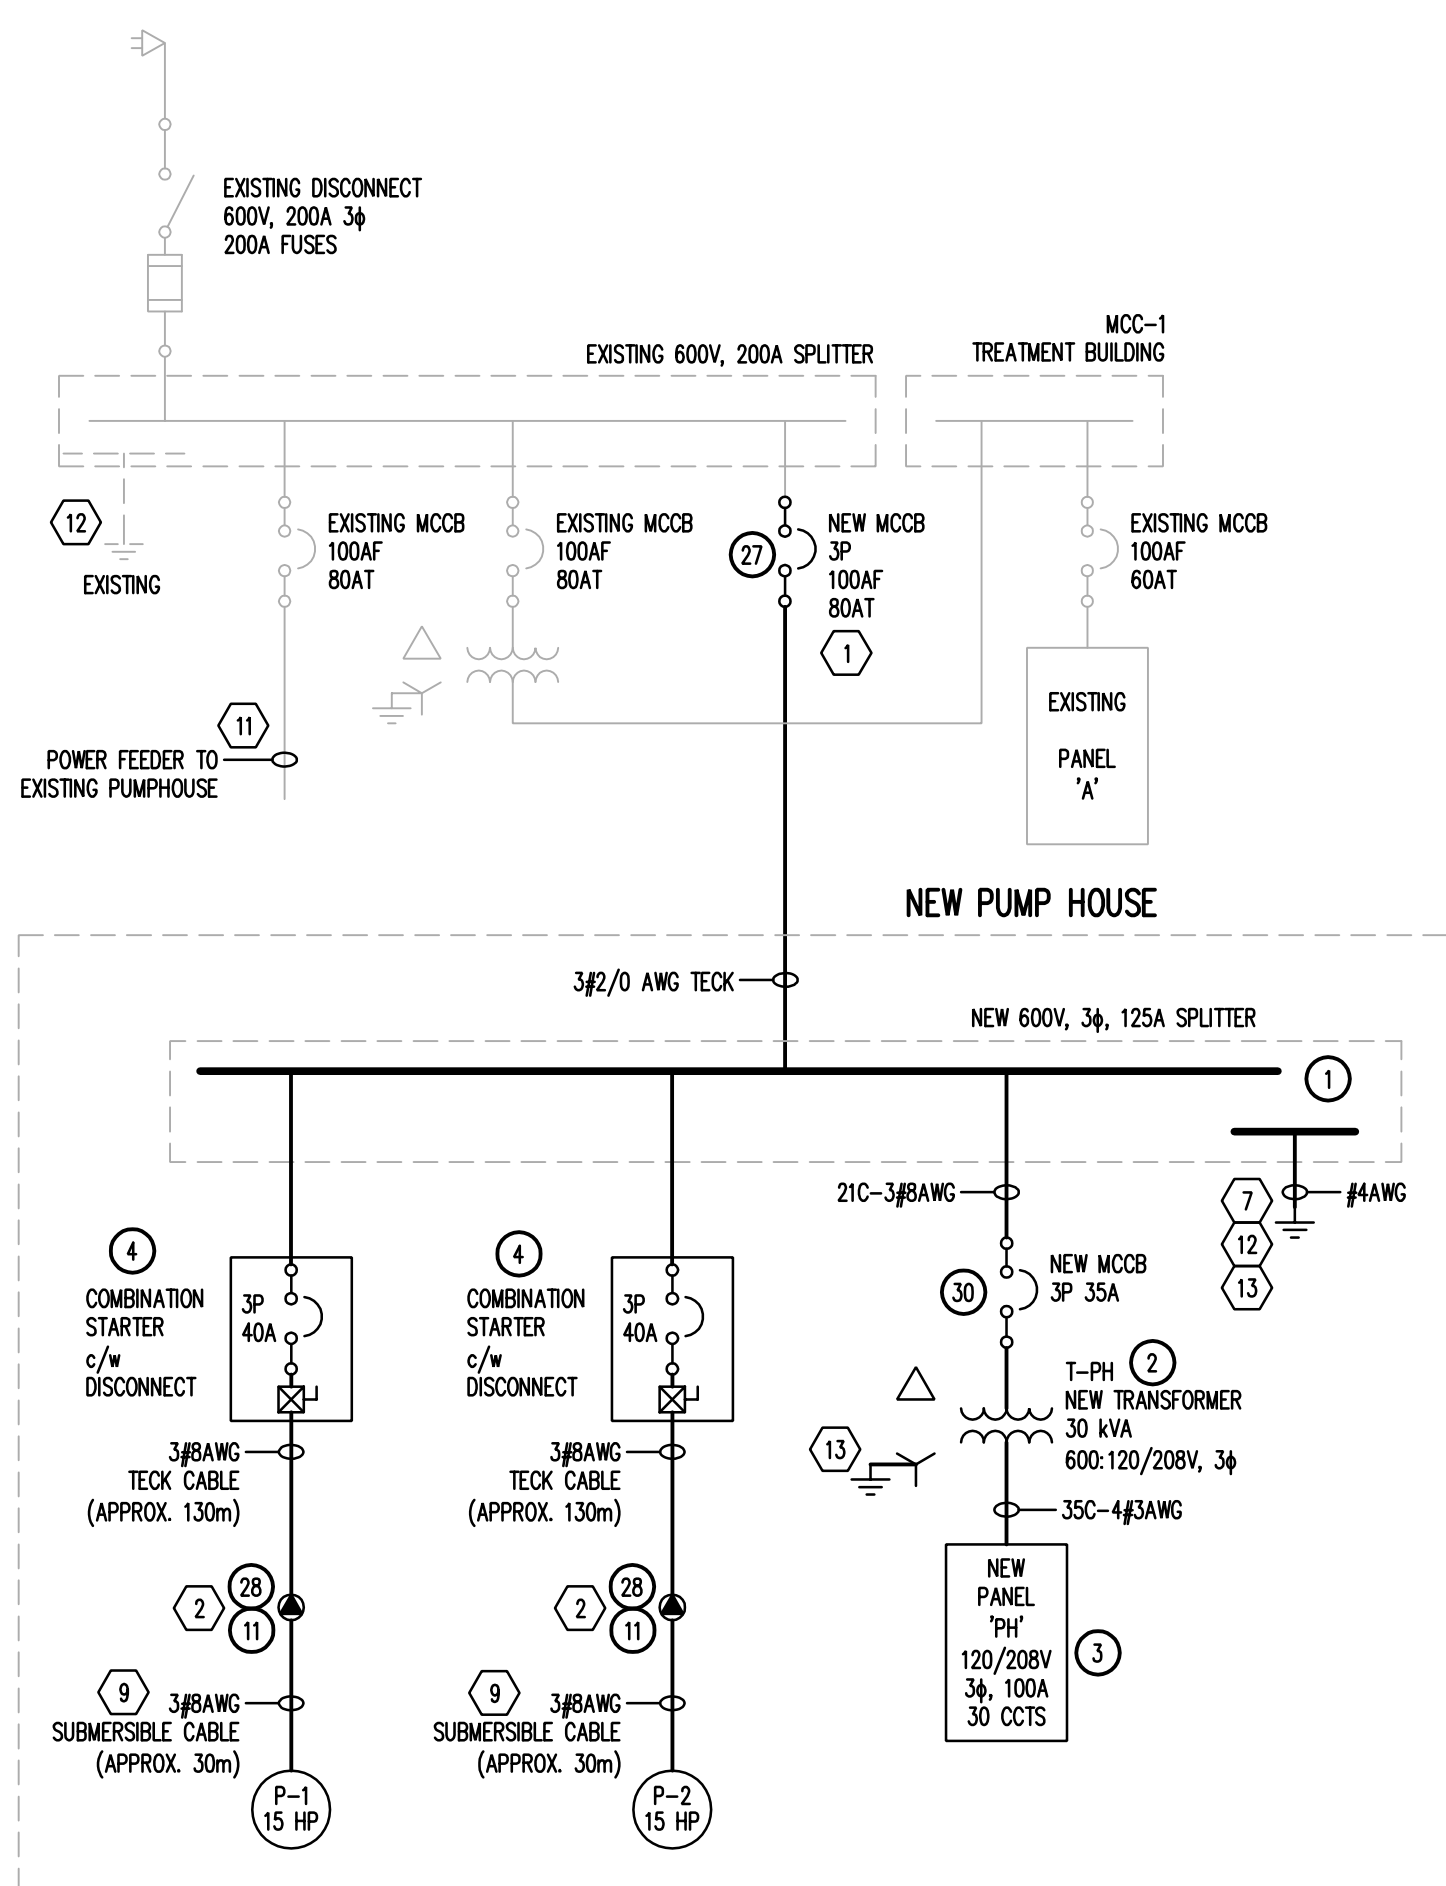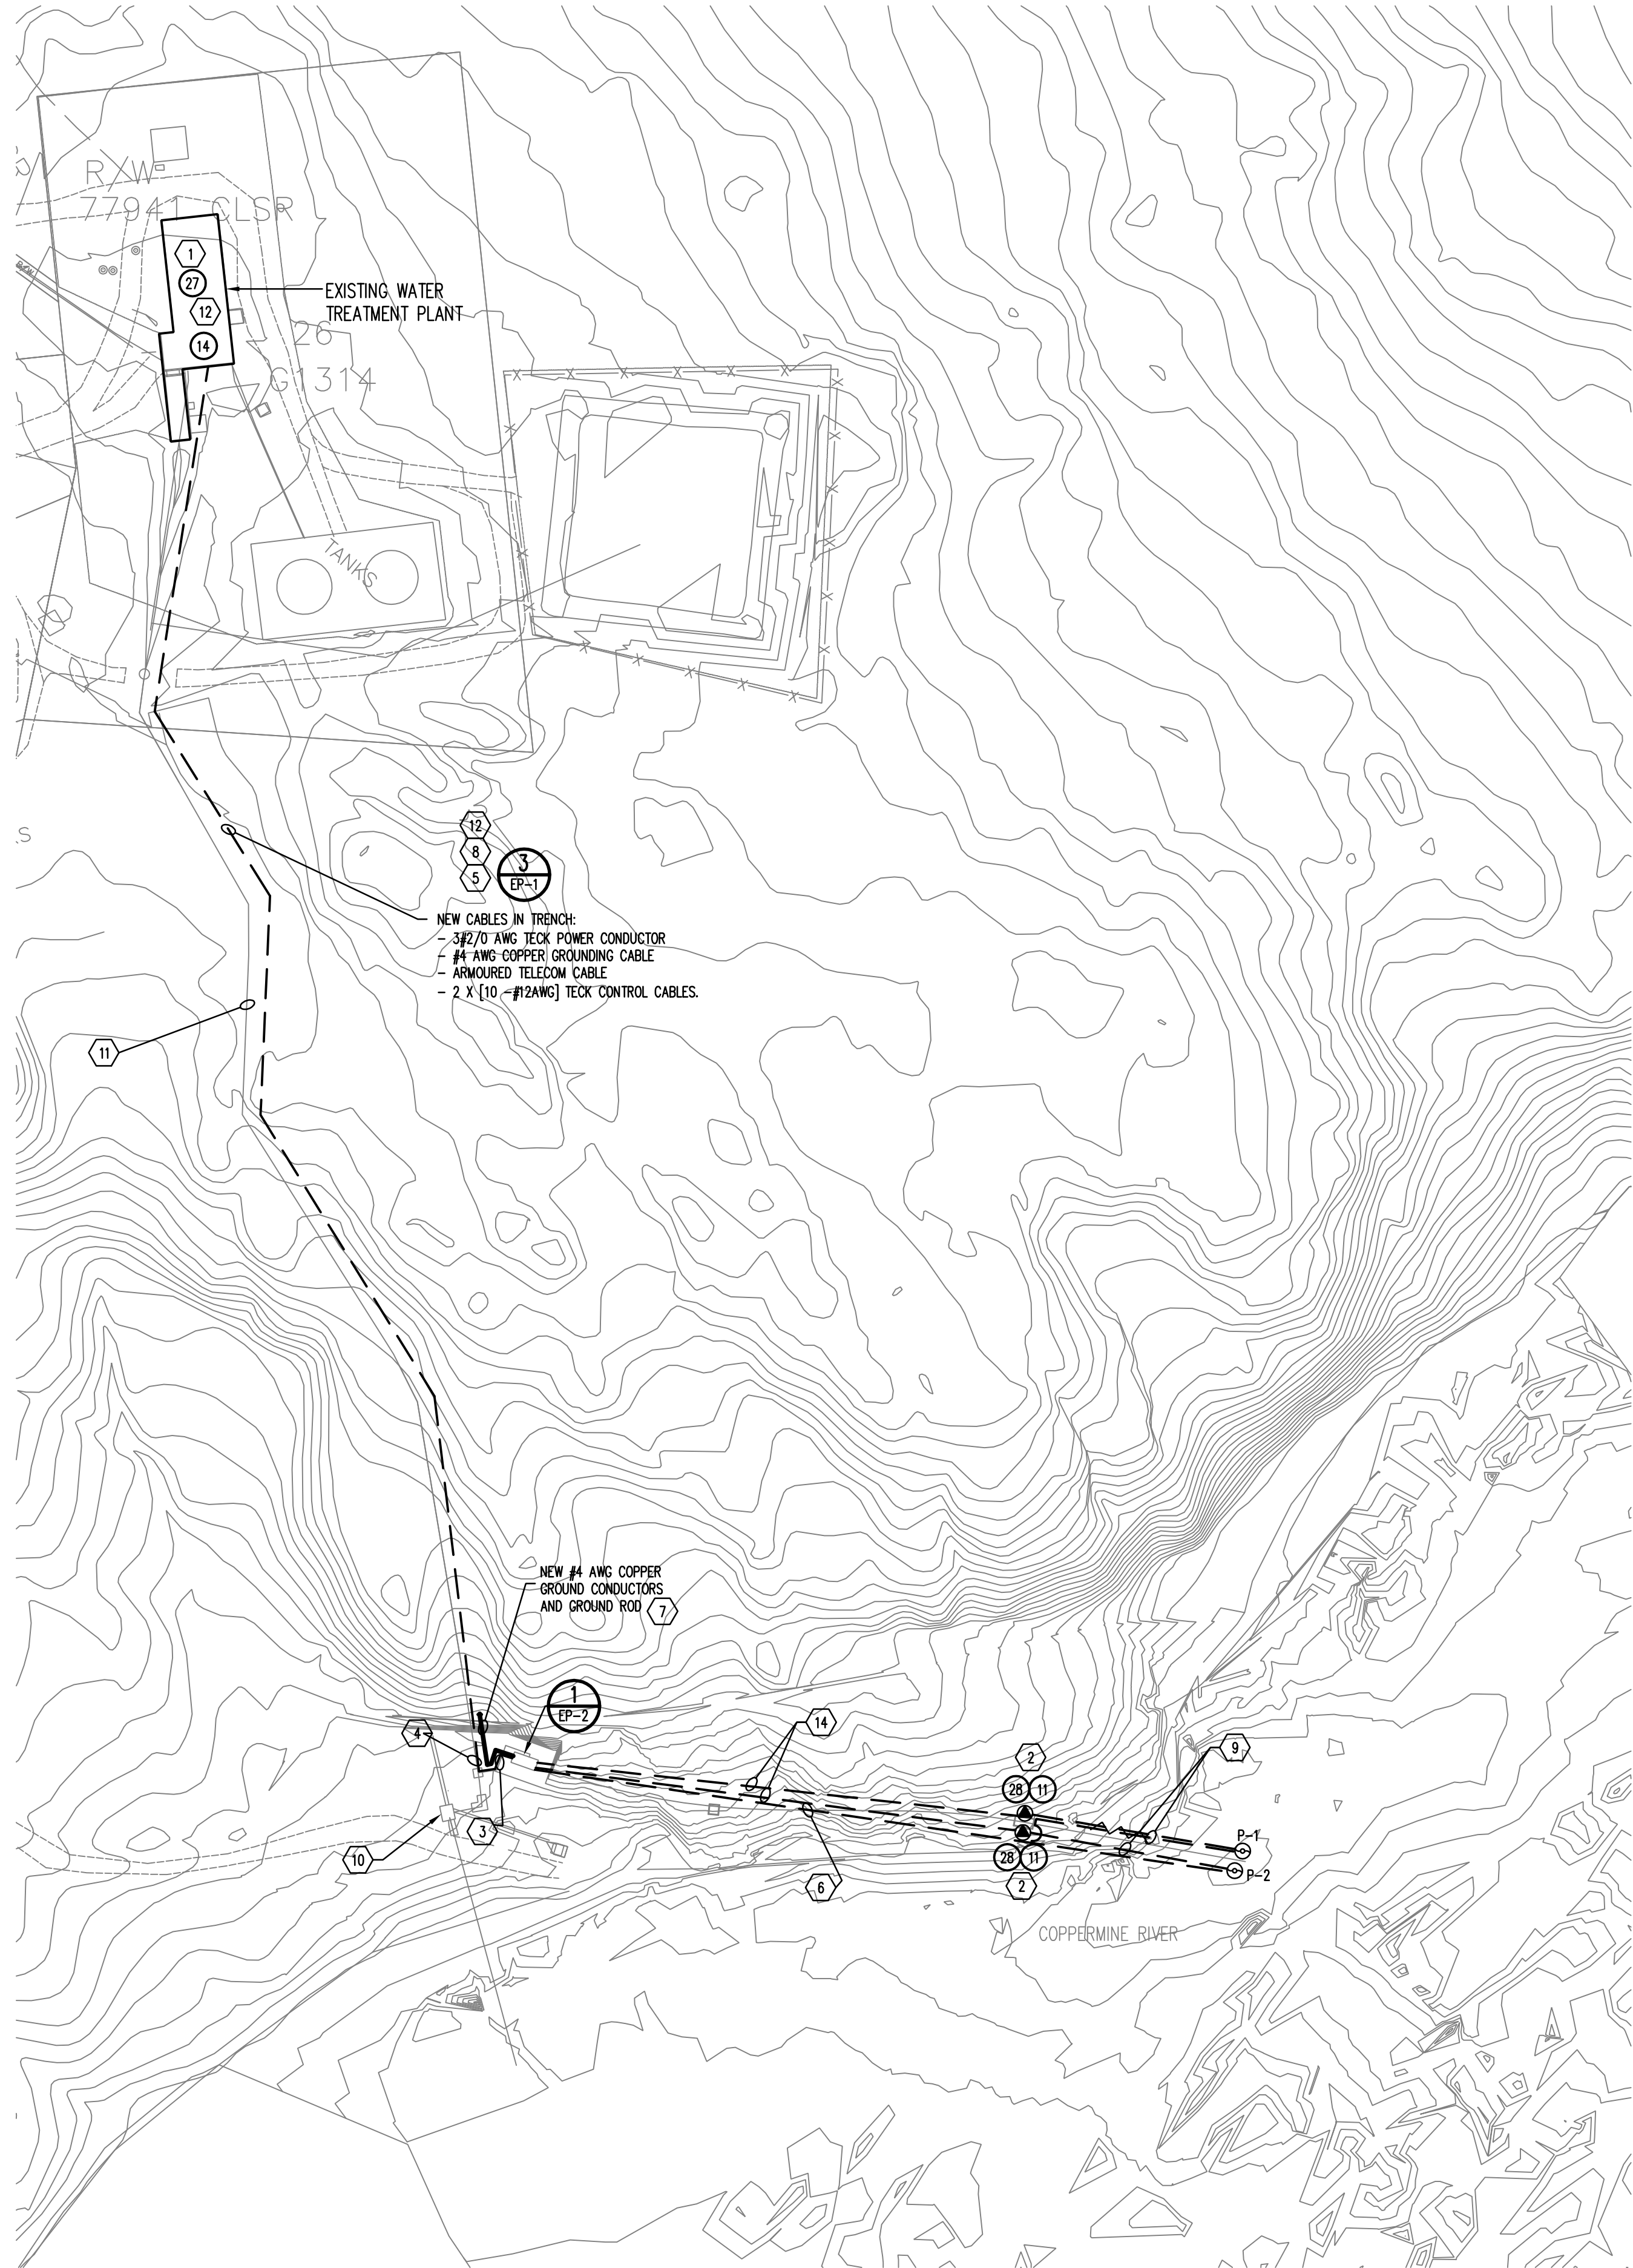


2 SINGLE LINE DIAGRAM  
EP-1 SCALE: NTS

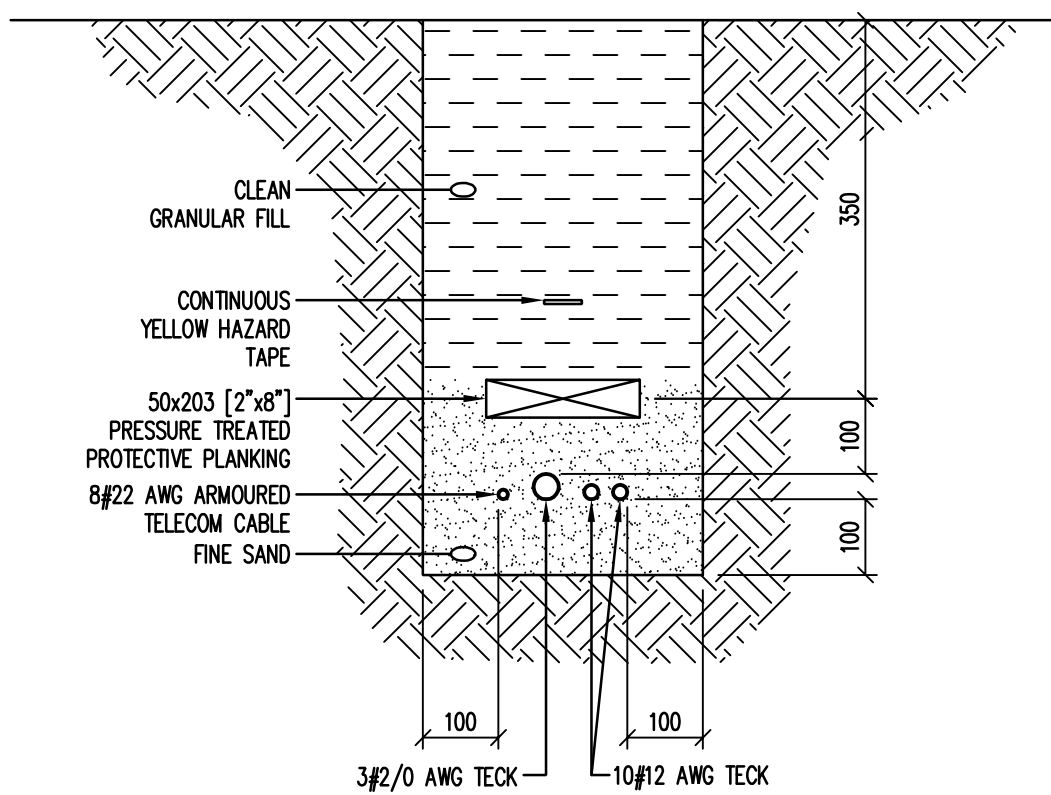

NOTE 1. REFER TO KEYNOTE 5.

3 TYPICAL TRENCH DETAIL  
EP-1 N.T.S.

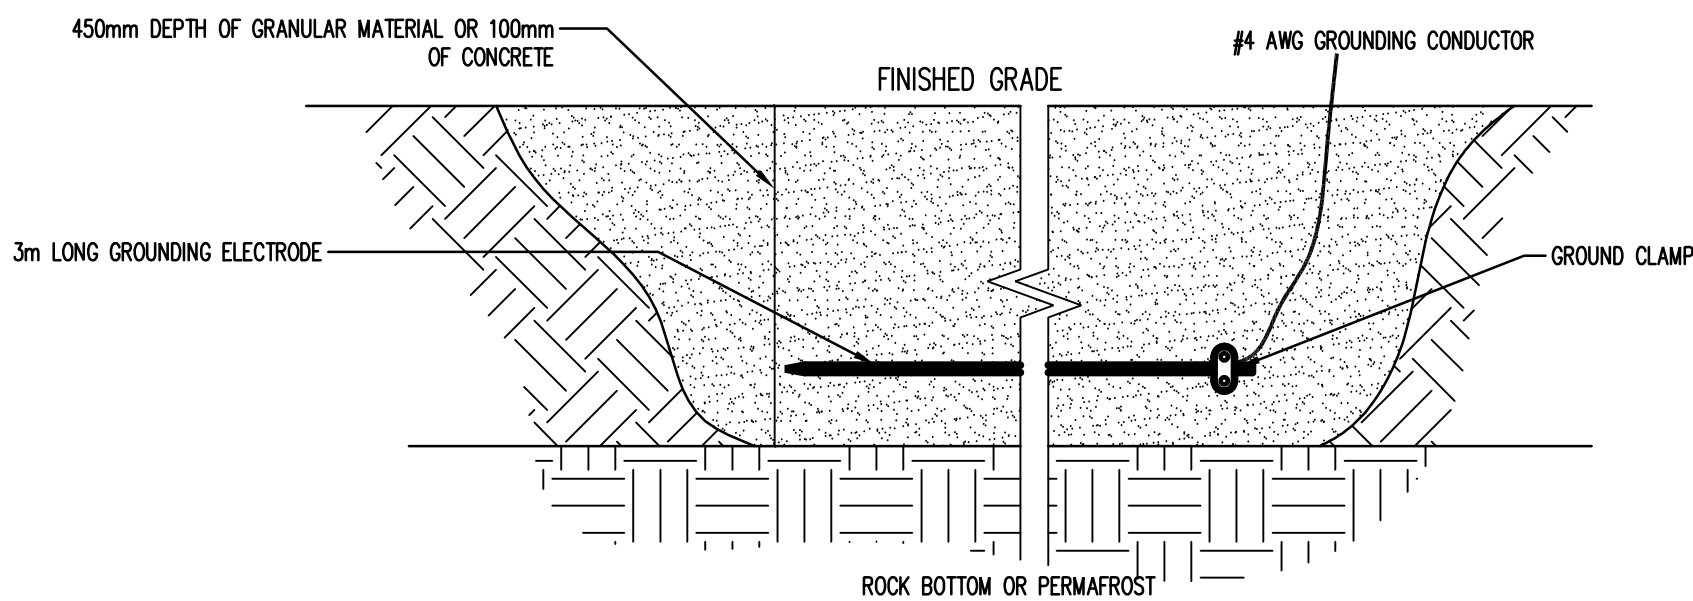

4 GROUNDING DETAIL  
EP-1 N.T.S.

## LOAD CALCULATION

### 120/208V LOADS

BASIC LOAD - 14.7 m<sup>2</sup> @ 25 W/m<sup>2</sup>  
HEAT TRACE  
RADIANT HEATERS  
COMPRESSOR - 5 HP ASSUMED  
TOTAL FACTORED LOADS - 120/208V

LOAD	LOAD FACTOR	CEC REFERENCE
368 W	100%	TABLE 14
6,430 W	100%	62-116 (3),(4)
7,200 W	100%	62-116 (3),(4)
5,000 W	100%	TABLE 14

### 600V LOADS

PUMPS - 2 @ 15 HP EACH  
TRANSFORMER (120/208V LOADS)  
TOTAL FACTORED LOADS - 600V

LOAD	LOAD FACTOR	CEC REFERENCE
30,000 W	100%	TABLE 14
18,998 W	100%	TABLE 14

## AMPACITY CALCULATION

48,998 W/(1.3\*600V) = 47.2 A

## KEYNOTES:

- PROVIDE NEW MCB IN MAIN WATER TREATMENT PLANT FOR NEW PUMPHOUSE SERVICE. 3 P RATED @ 600 V, SIZE AS SHOWN.
- TWISTLOCK CONNECTIONS FOR PUMP FEEDERS CABLING.
- PROVIDE NEW CABLES ON THE NEW PIPE SUPPORT. REFER TO DRAWING DETAIL /5-02.
- PROVIDE NEW CABLE SUPPORTS ON THE OTHER SIDE OF EXISTING PIPE SUPPORTS THAT IS SIMILAR WITH EXISTING ONE AND RUN NEW CABLES IN CONDUITS ON NEW CABLE SUPPORTS. MAXIMUM SPACE BETWEEN SUPPORTS IS 3 m WITH MINIMUM CONDUIT SIZE OF 41C.
- PROVIDE NEW CABLES IN EXISTING TRENCH WITH HAND EXCAVATION DUE TO REMAIN EXISTING FEEDER.
- HEAT TRACE RUN. SEE DETAIL 7/EP-4 FOR CONTROL AND DETAILS 1, 2, 3, 4, & 5/EP-5 FOR INSTALLATION.
- PROVIDE NEW GROUNDING SYSTEM AT NEW PUMPHOUSE AS SHOWN ON DETAIL 4. CONNECT INCOMING GROUND CONDUCTOR SPLITTER BOX GROUNDING LUG. RUN #4 AWG BARE COPPER CONDUCTORS TRENCHED AND ALONG WITH NEW CABLES.
- PROVIDE TWO (2) INCOMING TELEPHONE LINES. ONE LINE TO BE DEDICATED FOR AUTO DIALLER. SECOND LINE FOR VOICE HANDSET CONNECTION. CONNECT NEW LINES TO EXISTING BACKBOARD AT WATER TREATMENT PLANT.
- DO NOT USE SPliced CABLE. 30 m of SUBMERSIBLE CABLE c/w PUMP. CABLE TO BE SUPPLIED BY OTHERS AND INSTALLED BY ELECTRICAL. PROVIDE WATERTIGHT PLUGS & RECEPTACLES AT THE VAULT #2. TYPE AS SHOWN ON DRAWING EP-2.
- EXISTING PUMPHOUSE TO BE DEMOLISHED. REMOVE ALL ELECTRICAL DEVICES INCLUDING CABLES. COORDINATE SCHEDULE WITH OWNER.
- EXISTING PUMPHOUSE FEEDERS TO REMAIN AS ARE UNTIL DECOMMISSIONING OF EXISTING PUMPHOUSE. NEW CABLES TO BE RUN WITH EXISTING FEEDERS IN EXISTING TRENCH. EXISTING FEEDERS TO BE REMOVED WITH EXISTING PUMPHOUSE. COORDINATE REMOVING FEEDERS WITH OWNER.
- BOND GROUNDING SYSTEM OF NEW PUMPHOUSE TO EXISTING GROUNDING SYSTEM OF EXISTING WATER TREATMENT PLANT WITH #4 AWG COPPER CABLE.
- PROVIDE GROUNDING CONNECTION TO TRANSFORMER WITH #4 AWG CABLE FROM NEW GROUNDING SYSTEM AT NEW PUMPHOUSE.
- TECK CABLE FOR PUMPS P-1 & P-2 BETWEEN PUMPHOUSE AND VAULT #2. RUN IN TRENCH AS PER CEC REQUIREMENT. RUN TECK CABLE IN 41C RIGID STEEL CONDUIT WHERE EXPOSED.

REVISIONS

NO.	DESCRIPTION	DATE	BY	APP.
0	ISSUED FOR TENDER	2010.05.04	JG	JH
1	ISSUED FOR CONSTRUCTION	2010.08.06	JG	JH
2	RECORD DRAWING	2014.10.09	AC	

RECORD DRAWING

DRAWINGS WERE BASED UPON INFORMATION SUBMITTED FROM OTHER PARTIES AND THE ENGINEER DOES NOT WARRANT OR CERTIFY THAT THE INFORMATION FROM THESE OTHER PARTIES IS ACCURATE.

DATE (YYYY MM DD): 2014.10.09

REFERENCE DRAWINGS

FOR BEST PLOTTING RESULTS, BE SURE TO USE WILLIAMS ENGINEERING CANADA AUTOCAD PLOT CONFIGURATION FILES AVAILABLE FROM: [www.williamsengineering.com](http://www.williamsengineering.com)

LEGEND

SECTION #	DETAIL #
1 A-001	A E-001

INFORMATION CONTAINED ON THIS DRAWING IS COPYRIGHTED AND HAS BEEN PREPARED FOR THE SOLE PURPOSE OF THIS PROJECT. UNAUTHORIZED USE OF THIS INFORMATION WILL BE CONSIDERED A BREACH OF COPYRIGHT AND MAY BE PURSUED AS SUCH. USE OF THIS INFORMATION FOR ANY OTHER PURPOSE OTHER THAN THIS PARTICULAR PROJECT IS AT THE RISK OF THE USER.

PERMIT STAMP

PERMIT TO PRACTICE  
WILLIAMS ENGINEERING CANADA INC.  
PERMIT NUMBER  
P 646  
NWT/NJ Association of Professional  
Engineers and Geoscientists

ENGINEER'S SEAL

YELLOWKNIFE OFFICE  
P.O. Box 1059  
4800 87 Street  
Yellowknife, NT X1A 2P2  
Bus: (867) 873-2266  
Tel/Fax: 1-800-263-2363  
Fax: (867) 873-2617  
info@williamsengineering.com  
www.williamsengineering.com

WILLIAMS ENGINEERING CANADA

WE

CLIENT

Nunavut

JOB TITLE

WATER SUPPLY IMPROVEMENTS  
PHASE 1  
NEW INTAKE AND PUMPHOUSE  
KUGLUKTUK, NU

DWG. TITLE

PUMPHOUSE ELECTRICAL  
SITE PLAN AND  
SINGLE LINE DIAGRAM

OWN. BY:	JL	DES. BY:	JL	PROJ. MGR.:	JH
PEER REVIEW:	JL	DATE: (YY-MM-DD)	2010.08.06	SCALE:	AS NOTED
CLIENT PROJ. #	GN PROJECT #04-4417	REC PROJ. #	113655.00		


DWG. NO.

EP-1


5

1


PLAN & EEE NAME: C:\Projects\13000\13005 - Kugluktuk Water and Pump House\13005-00-0-EP-2.dwg PLOTTED DATE: 18/07/2010 2:54 PM

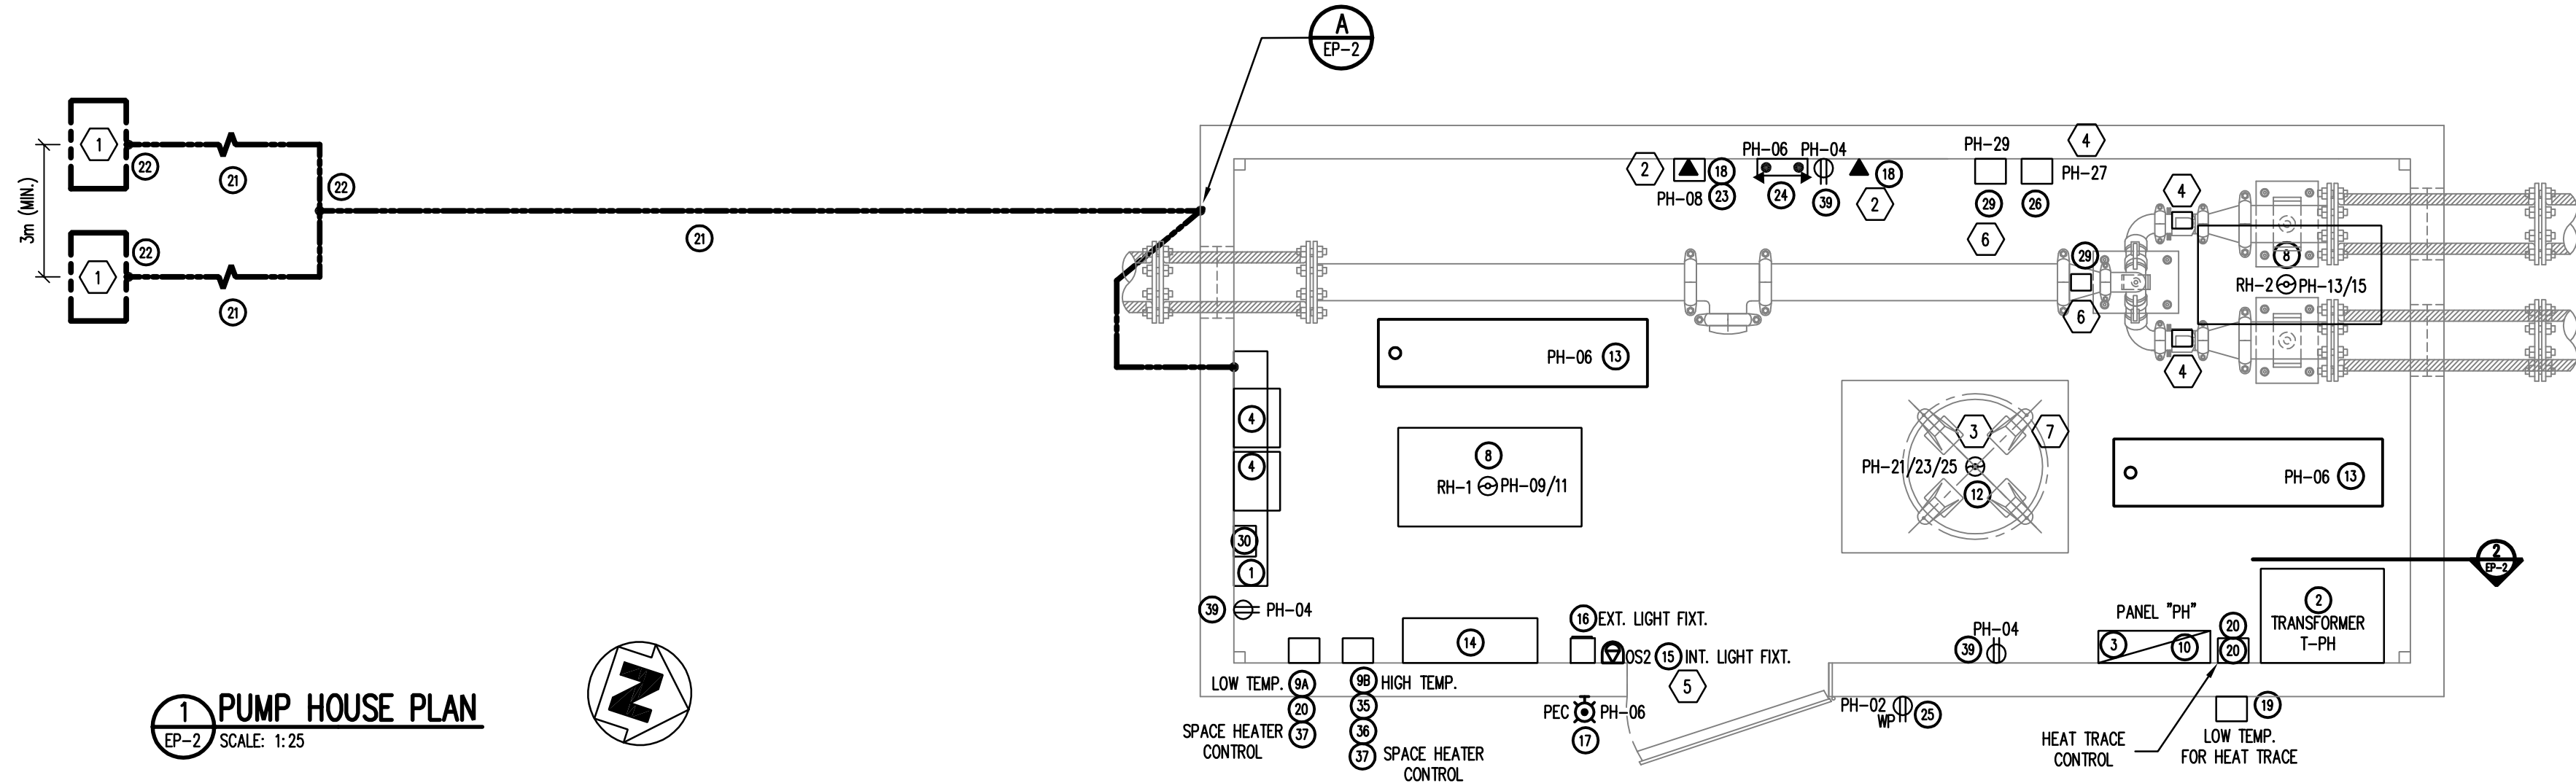

**1 PUMP HOUSE PLAN**  
EP-2 SCALE: 1:25

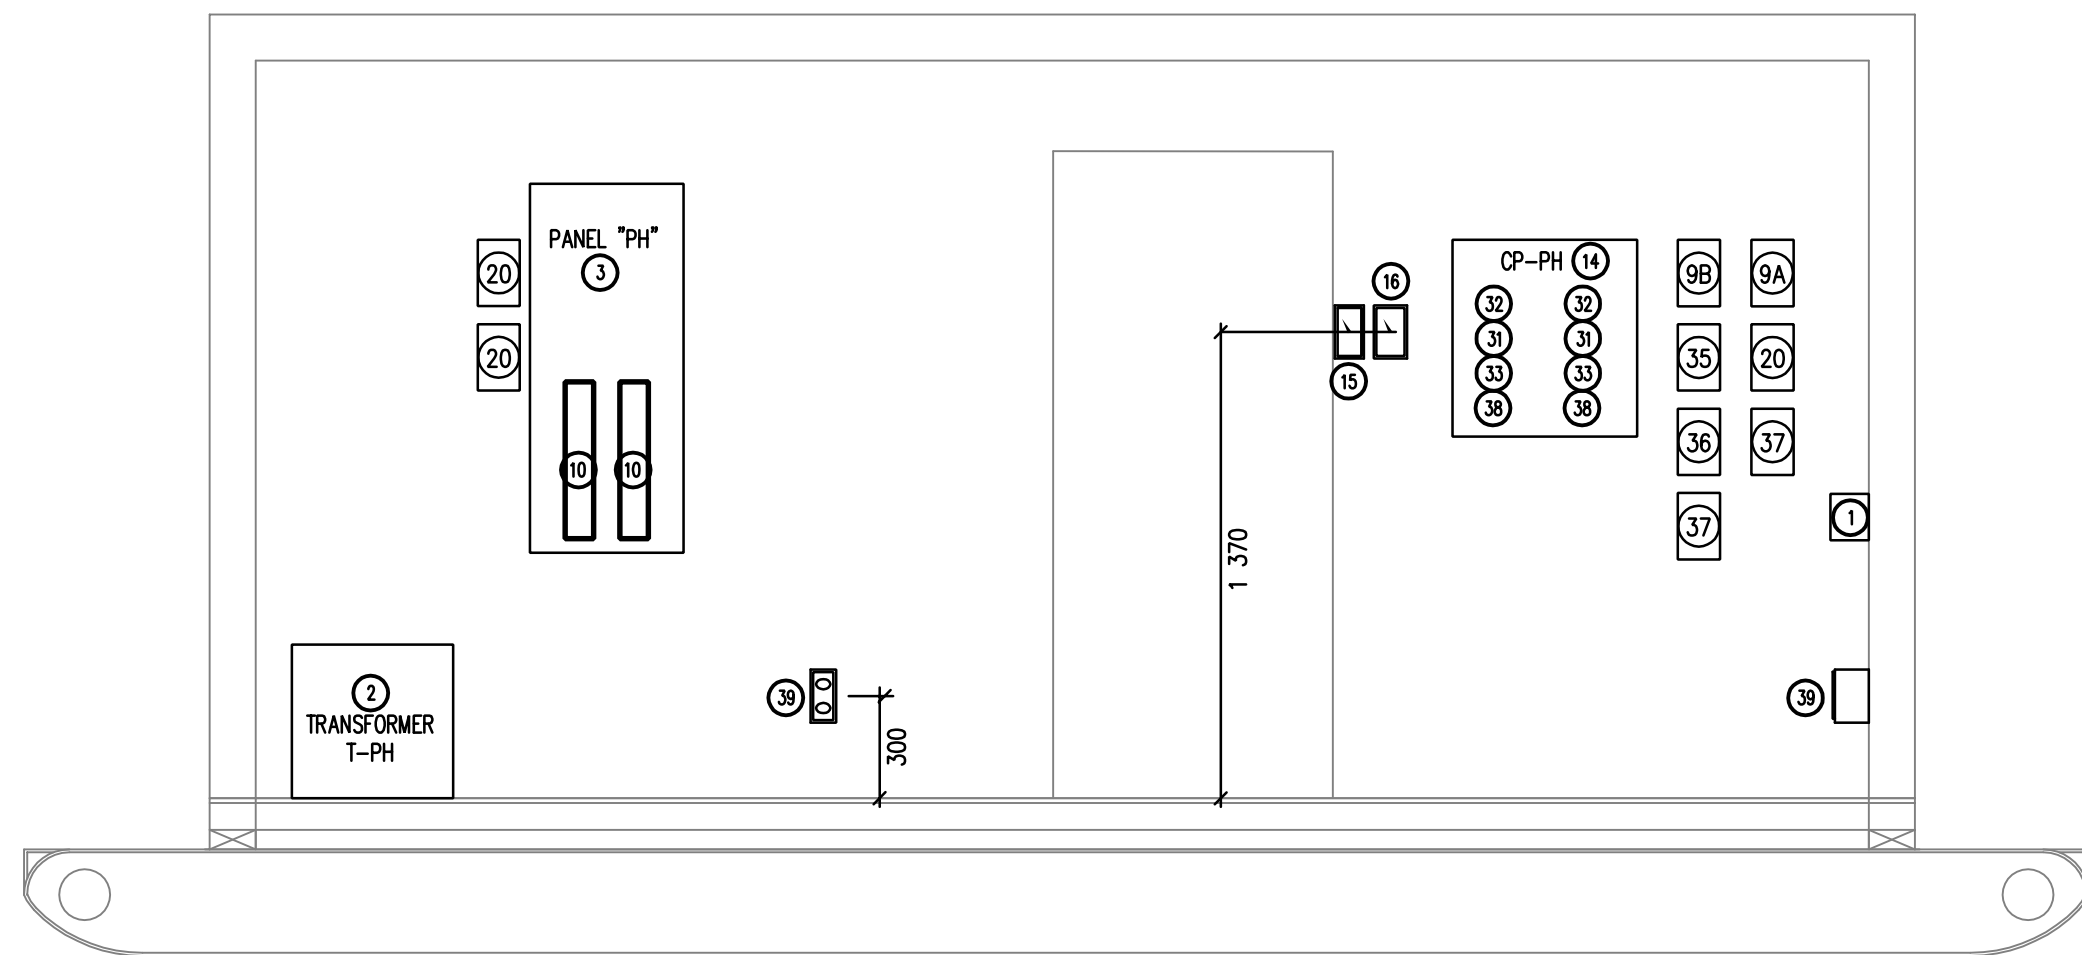


**2 WEST WALL ELECTRICAL EQUIPMENT**  
EP-2 SCALE: 1:25

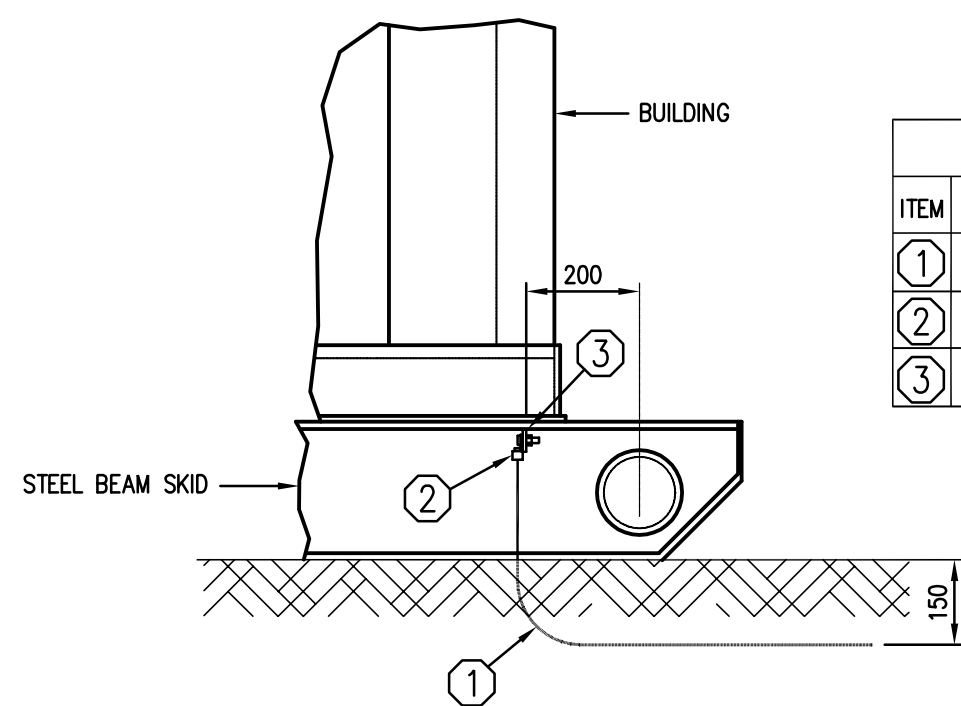

**A STATIC ELECTRICITY GROUNDING CONNECTIONS AT BUILDING**  
EP-2 SCALE: 1:25

**KEYNOTES:**

- GROUNDING RODS OF MINIMUM LENGTH 3 m. BURY AS SHOWN ON GROUNDING DETAIL 4/EP-1.
- PROVIDE TWO (2) INCOMING TELEPHONE LINES. ONE LINE TO BE DEDICATED FOR AUTODIALLER. SECOND LINE FOR VOICE HANDSET CONNECTION. CONNECT NEW LINES TO EXISTING BACKBOARD AT WATER TREATMENT PLANT.
- AIR COMPRESSOR FOR USE IN SCREEN CLEANING VIA AIR BURST SYSTEM. SUPPLIED BY OTHERS AND WIRING BY ELECTRICAL.
- PROVIDE POWER TO SWITCHING POWER SUPPLY FOR FLOW METERS. SUPPLIED BY OTHERS AND WIRING BY ELECTRICAL. RUN SENSOR CABLE IN SEPARATE CONDUIT BETWEEN FLOW METER AND FLOW SENSOR.
- OCCUPANCY SWITCH FOR INTERIOR LIGHTING. SET AT 20 MINUTES.
- SALINITY METER AND CPVC SENSOR. SUPPLIED BY OTHERS AND WIRING BY ELECTRICAL. PROVIDE CONTROL CIRCUIT AS SHOWN ON DETAIL 1/EP-4. RUN SENSOR CABLE IN SEPARATE CONDUIT BETWEEN METER AND SENSOR.
- PROVIDE BONDING WIRE TO COPPER PIPE OF COMPRESSOR WITH #4 AWG COPPER CABLE. COORDINATE WITH MECHANICAL.

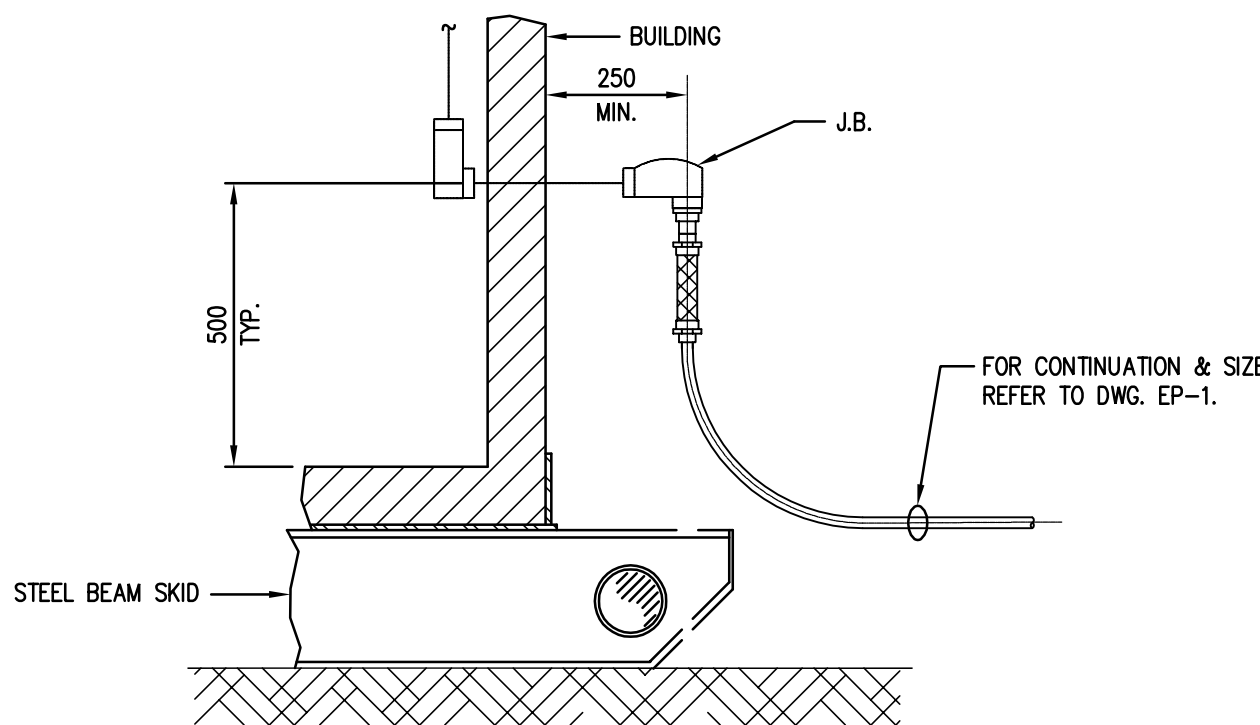

**B ELECTRICAL CONDUIT ARRANGEMENT AT ENTRY OF BUILDING**  
EP-2 SCALE: N.T.S.

**LIST OF PUMPHOUSE BLDG. ELECTRICAL & GROUNDING EQUIPMENT**

NO.	QTY.	DESCRIPTION
1	1	600V, 125A, 3 $\phi$ SPLITTER, BEL FT3103, SBT200 SPLITTER BLOCKS & TGR200 GROUNDING KIT.
2	1	30 kVA, 600V-120/208V THREE PHASE TRANSFORMER, REX POWER MAGNETICS TYPE BC30M/EP ENCAPSULATED, FLOOR MOUNT.
3	1	DISTRIBUTION PANELBOARD "PH", CUTLER-HAMMER TYPE POW-R-LINE, 120/208V, 100 AMP BUS, 3 $\phi$ c/w TVSS, EEMAC 4 ENCLOSURE, AND DOOR. SURFACE MOUNT. CAT. # P14L4C1-30.
4	2	DISCONNECT COMBO STARTER c/w GROUND FAULT SENSOR, NON-REVERSING, 3-POLE FOR 600 V LINE VOLTAGE AND 120V COIL. ALLEN BRADLEY TYPE 512-CDCO-EC2D.
5	-	NOT USED.
6	-	NOT USED.
7	AS REQ'D	HEAT TRACE TYPE TYCO THERMAL 88TV2-C7.
8	2	3.6 KW RADIANT HEATER. CHROMALOX TYPE RBC-33680, 208V, 1 $\phi$ , 17.3 A.
9	2	THERMOSTAT FOR BUILDING HEATING CONTROL, HONEYWELL TYPE T87 ROUND NON-PROGRAMMABLE THERMOSTAT.
10	AS REQ'D	DISTRIBUTION BREAKERS, 10,000 A.I.C., BOLT-ON TYPE, AMP. RATING AND No. OF POLES AS PER DISTRIBUTION PANEL SCHEDULE, CUTLER-HAMMER TYPE BAB FOR ITEM 3.
11	2	3 POLE, 4 WIRE, 600 VOLTS AC, 30 AMP WATERTIGHT LOCKING PLUG AND CONNECTOR. COOPER CAT. # L1730PW & L1730CW.
12	1	5 HP, 208 V, 3 $\phi$ , 60 HZ COMPRESSOR INCLUDING COMPRESSOR CONTROL PACKAGE. REFER TO CIVIL SPECIFICATION.
13	2	METALUX VAPORTITE FLUORESCENT FIXTURE V12-2320R-120V-EB81-WL-U, 2-T8 LAMPS, 120V.
14	2	CONTROLS ENCLOSURE, SINGLE DOOR NEMA 4, HAMMOND MANUFACTURING TYPE 141BN4JB.
15	1	PASSIVE INFRARED WALL SWITCH OCCUPANCY SENSOR LEVITON TYPE 0DS15-IDG.
16	1	AUTO/OFF TOGGLE SWITCH, DOUBLE POLE INDUSTRIAL GRADE. HUBBELL TYPE HBL1202.
17	1	HIGH PRESSURE SODIUM EXTERIOR LIGHTING FIXTURE GREY, WALL PACKETTE, 70 W, 120 V c/w BALLAST, PHOTOELECTRIC CONTROL, POLYCARBONATE COVER AND PROTECTION GRILLE, HOLOPHANE CAT. # W4070HP12SGB.
18	2	TELEPHONE OUTLET, WALL MOUNT.
19	1	AMBIENT SENSING THERMOSTAT FOR HEAT TRACING CABLE, DIGITRACE TYPE AMC-1A.
20	3	CONTROL RELAY FOR BUILDING HEATER, ELECTRICALLY HELD AC, c/w 4 CONTACTS N.O. TYPE, 35 A CONTACT RATING. ALLEN-BRADLEY CAT.# 700-PH401-A1. c/w EEMAC ENCLOSURE CAT.# 700-N31S.
21	1	#4 STRANDED BARE COPPER GROUND WIRE.
22	3	MECHANICAL GROUND CLAMP, BURNDY TYPE GP644C.
23	1	AUTODIALLER, NEMA 4 ENCLOSURE, LOW TEMPERATURE SENSOR, SENSAPHONE MODEL 1400.
24	1	EMERGENCY BATTERY PACK, LUMACELL RONX-36-M6W-CW1.
25	1	HEAVY DUTY WEATHER RESISTANT RECEPTACLE, HUBBELL TYPE HBL5262BKWR. RECEPTACLE COVER HUBBELL TYPE HBL5206NO.
26	1	SWITCHING POWER SUPPLY TO CONVERT 120VAC TO 12-24VDC.
27	1	600 V, 3 POLE, 100 A c/w ENCLOSURE. EATON CAT. # FDB3100.
28	2	3 POLE, 4 WIRE, 600 VOLTS AC, 30 AMP WATERTIGHT LOCKING RECEPTACLES. COOPER CAT. # L1730RW.
29	1	120V SALINITY METER WITH RELAY ACTUATION, WALCHEM TYPE CAT. #MEC-1MDN.
30	1	600V, 3 POLE, 35 A c/w ENCLOSURE. EATON CAT. # FDB303S.
31	AS REQ'D	MOMENTARY CONTACT PUSHBUTTONS, PANEL MOUNT, EATON CAT. # E22E2A, E22E2B, E22E3A, E22E3B.
32	2	TWO-POSITION SELECTOR SWITCH, PANEL MOUNT. EATON CAT. # E22V51A.
33	AS REQ'D	LED INDICATING LIGHT, PANEL MOUNT, EATON CAT. # EM22H2X43, EM22H2X44, EM22H9X96
34	10	GENERAL PURPOSE RELAY. 120 VAC COIL, 7 A CONTACT RATING, 4 POLE 4 FORM C. ALLEN BRADLEY CAT. #700-HC24A1.
35	1	AUTOMATIC RESET TIMER FOR BUILDING HEATER, INTERVAL USE TYPE 500 SERIES, 120 VAC. RANGE 0 TO 5 HRS., 5 MIN. PARAGON ELECTRIC CO. MODEL# 501-142-00 c/w MOISTURE AND DUST RESISTANT CASE MODEL 500 AND EDP.# 41150 ENCLOSURE TIMER SET AT 1 HR.
36	1	STANDARD DUTY STATION MOMENTARY CONTACT START/STOP PUSH BUTTON c/w PILOT LIGHT FOR BUILDING HEATER CONTROL. ALLEN BRADLEY CAT. # 800S-25AP.
37	2	CONTROL RELAY FOR REMOTE HEATER, ELECTRICALLY HELD AC, c/w 4 CONTACTS N.O. TYPE, 10 A CONTACT RATING. ALLEN-BRADLEY CAT.# 700-P401-A1 c/w EEMAC ENCLOSURE CAT.# 700-N31S.
38	2	PANEL MOUNT RESETTABLE AC HOUR METER. ENM COUNTING INSTRUMENTS CAT. # T34BN62D.
39	3	FS BOX WITH SPECIFICATION GRADE, 125 V., 15 A., DUPLEX RECEPTACLE, BROWN, SIDE WIRED, HUBBELL CAT. # 5262 AND FS TYPE COVER.
40	3	HEAT TRACE SINGLE ENTRY POWER CONNECTION BOX TYPE TYCO THERMAL JBS-100A.
41	4	HEAT TRACE END SEAL KIT TYPE TYCO THERMAL E-100-A.
42	4	HEAT TRACE SPLICE CONNECTION TYPE TYCO THERMAL T-100.
43	1	HEAT TRACE MULTIPLE ENTRY POWER CONNECTION BOX TYPE TYCO THERMAL JBM-100.

REVISIONS				
NO.	DESCRIPTION	DATE	BY	APP.
0	ISSUED FOR TENDER	2010.05.04	JG	JH
1	ISSUED FOR CONSTRUCTION	2010.08.06	JG	JH
2	RECORD DRAWING	2014.10.09	AC	

- ALL DIMENSIONS ARE SHOWN IN MILLIMETRES.
- CONDUITS SHALL BE RIGID, GALVANIZED STEEL.
- TO ALL NUMBER OF WIRES SHOWN IN CONDUITS, CONTRACTOR SHALL ADD ONE GROUND WIRE AS PER CEC REQUIREMENTS.
- MOUNT ALL ELECTRICAL EQUIPMENT SO THAT CONNECTIONS CAN BE EASILY EXPOSED FOR SERVICE.
- ALL SWITCHES, STARTERS, THERMOSTATS, RELAYS, CONTACTORS, TIMERS, ETC... SHALL BE IDENTIFIED WITH STAINLESS STEEL LABELS FASTENED TO BOXES.
- FOR WIRING DIAGRAMS SEE DWG. EP-4.
- AVAILABLE POWER SUPPLY TO THIS BUILDING SHALL BE 3 PHASE 600 V AND 208 V, 60 HZ.

**RECORD DRAWING**

DRAWINGS WERE BASED UPON INFORMATION SUBMITTED FROM OTHER PARTIES AND THE ENGINEER DOES NOT WARRANT OR CERTIFY THAT THE INFORMATION FROM THESE OTHER PARTIES IS ACCURATE.  
DATE (YYYY MM DD): 2014.10.09

**REFERENCE DRAWINGS**

FOR BEST PLOTTING RESULTS, BE SURE TO USE WILLIAMS ENGINEERING CANADA AUTOCAD PLOT CONFIGURATION FILES AVAILABLE FROM: [www.williamsengineering.com](http://www.williamsengineering.com)

**LEGEND**

SECTION #	DETAIL #
1 A-001	A E-001
SOURCE / REFERENCE DWG.	SOURCE / REFERENCE DWG.

INFORMATION CONTAINED ON THIS DRAWING IS COPYRIGHTED AND HAS BEEN PREPARED FOR THE SOLE PURPOSE OF THIS PROJECT. UNAUTHORIZED USE OF THIS INFORMATION WILL BE CONSIDERED A BREACH OF COPYRIGHT AND MAY BE PURSUED AS SUCH. USE OF THIS INFORMATION FOR ANY OTHER PURPOSE OTHER THAN THIS PARTICULAR PROJECT IS AT THE RISK OF THE USER.


PERMIT STAMP:
PERMIT TO PRACTICE WILLIAMS ENGINEERING CANADA INC. PERMIT NUMBER P 646 NWT/NJ Association of Professional Engineers and Geoscientists

ENGINEER'S SEAL:

YELLOWKNIFE OFFICE  
P.O. Box 1059  
480 47 Street  
Yellowknife, NT X1A 2P2  
Bus: (867) 873-2385  
Tel Fax: 1-800-293-2383  
Fax: (867) 873-2547  
info@williamsengineering.com  
www.williamsengineering.com

**WILLIAMS  
ENGINEERING  
CANADA**

**WE**

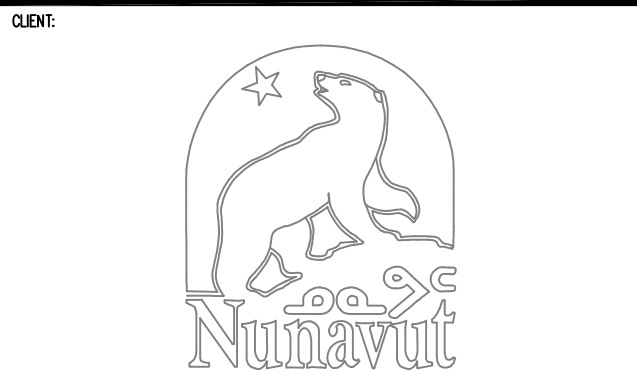

**WATER SUPPLY IMPROVEMENTS  
PHASE 1  
NEW INTAKE AND PUMPHOUSE  
KUGLUKTUK, NU**

**PUMPHOUSE  
ELECTRICAL  
SCHEMATICS  
& DETAILS**


DES. BY:	JL/JPC	DES. BY:	JL/JPC	PROJ. MGR.:	JH
DATE:	(YY-MM-DD)	DATE:	(YY-MM-DD)	SCALE:	AS NOTED
DATE:	2010.08.06	DATE:	2010.08.06	SCALE:	AS NOTED
CLIENT PROJ. #	GN PROJECT #04-4417	REC PROJ. #		REC PROJ. #	113655.00

**EP-2** 5 1




- 1) LOCAL PUMP CONTROL (MANUAL)
  - PUSH BUTTON CONTROL AT STARTER (START, STOP).
  - SELECTOR SWITCH FOR LOCAL OR REMOTE (PUMPHOUSE OR WTP CONTROL PANELS).
- 2) PUMPHOUSE CONTROL PANEL (CP-PH)
  - PUSH BUTTON CONTROL FOR P1 & P2 (START, STOP).
  - INDICATOR LIGHTS FOR P1 & P2 (RUNNING, STOPPED).
  - TIMING CONTROL FOR PUMPS:
    - MANUALLY SWITCHING BETWEEN PUMPS AFTER X HOURS OF OPERATION.
    - SAUITY METER OVERRIDE.
    - SAUITY METER STATUS INDICATOR LIGHTS (CUT-OUT, OVERRIDE).
    - AUTOXALLER FOR CALL-OUT (BLDG. LOW/HIGH TEM).
    - BUILDING SPACE HEAT-OUT CONTROL, RELAY.
- 3) WATER TREATMENT PLANT CONTROL PANEL (CP-WTP)
  - PUSH BUTTON CONTROL FOR P1 & P2 (START, STOP).
  - INDICATOR LIGHTS FOR P1 & P2 (RUNNING, STOPPED).
  - SAUITY METER STATUS INDICATOR LIGHTS (CUT-OUT, OVERRIDE).


- SALINITY METER OPERATION
  - CONTINUOUS "ONLINE" MONITORING OF SALINITY AT INTAKE PIPES IN PUMPHOUSE
  - SALINITY LEVEL EXCEEDING PRESET WILL STOP PUMPS.
- 5) BUILDING HEAT OPERATION
  - TWO HEATING "SETPOINTS" – LOW TEMP LIMIT & HIGH TEMP LIMIT.
  - LOW TEMPERATURE SETPOINT (°C) AUTOMATICALLY STARTS HEATER.
  - "START" PUSHBUTTON ALLOWS OPERATOR TO START HEATER UPON ENTERING PUMPHOUSE.
  - "STOP" PUSHBUTTON ALLOWS OPERATOR TO STOP HEATER WHEN LEAVING PUMPHOUSE. TIMER WILL STOP HEATER AFTER PRESET TIME (1 HOUR) IF STOP BUTTON IS NOT PRESSED.
  - HIGH TEMPERATURE SETPOINT WILL STOP HEATER WHEN BUILDING REACHES THE HIGH TEMPERATURE SETPOINT, REGARDLESS OF START METHOD.
- 6) HEAT TRACE OPERATION
  - HEAT TRACE REQUIRES MANUAL CONNECTION.
  - WHEN HEAT TRACE IS CONNECTED, LOW AMBIENT AIR TEMPERATURE ACTIVATES THE CIRCUIT.

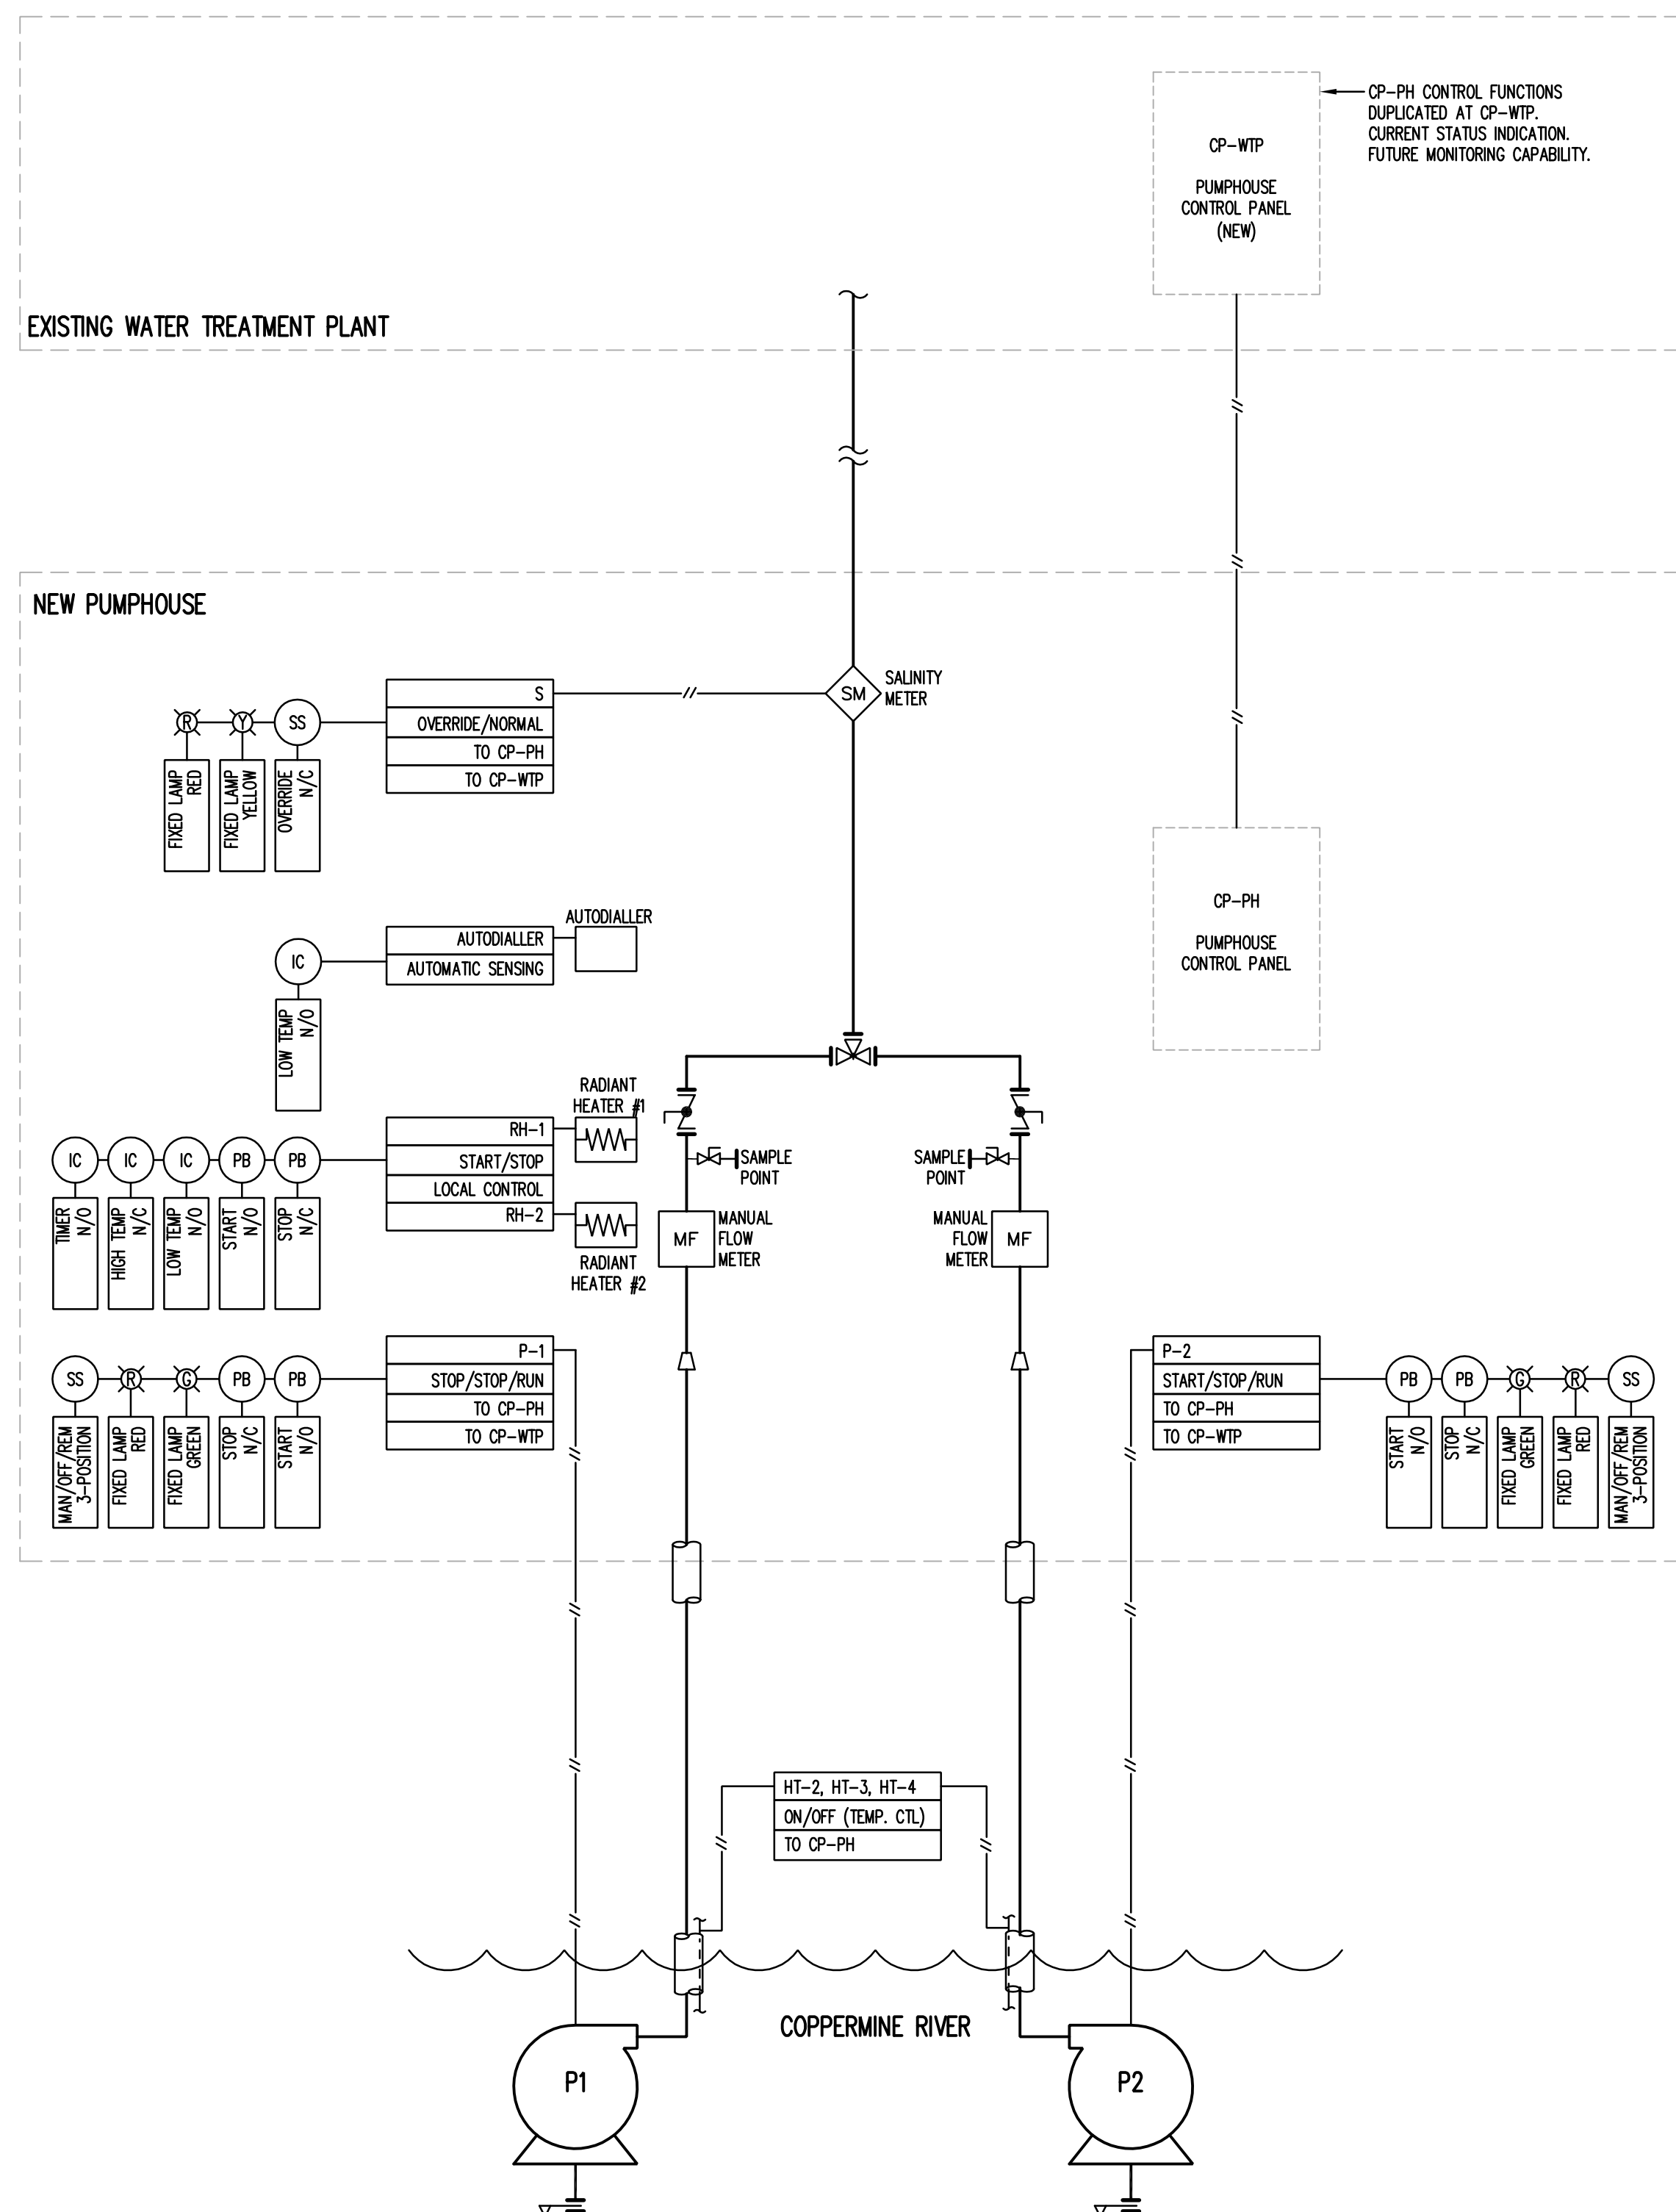

1 PUMPHOUSE PROCESS & INSTRUMENTATION  
EP-3 SCALE: N.T.S.

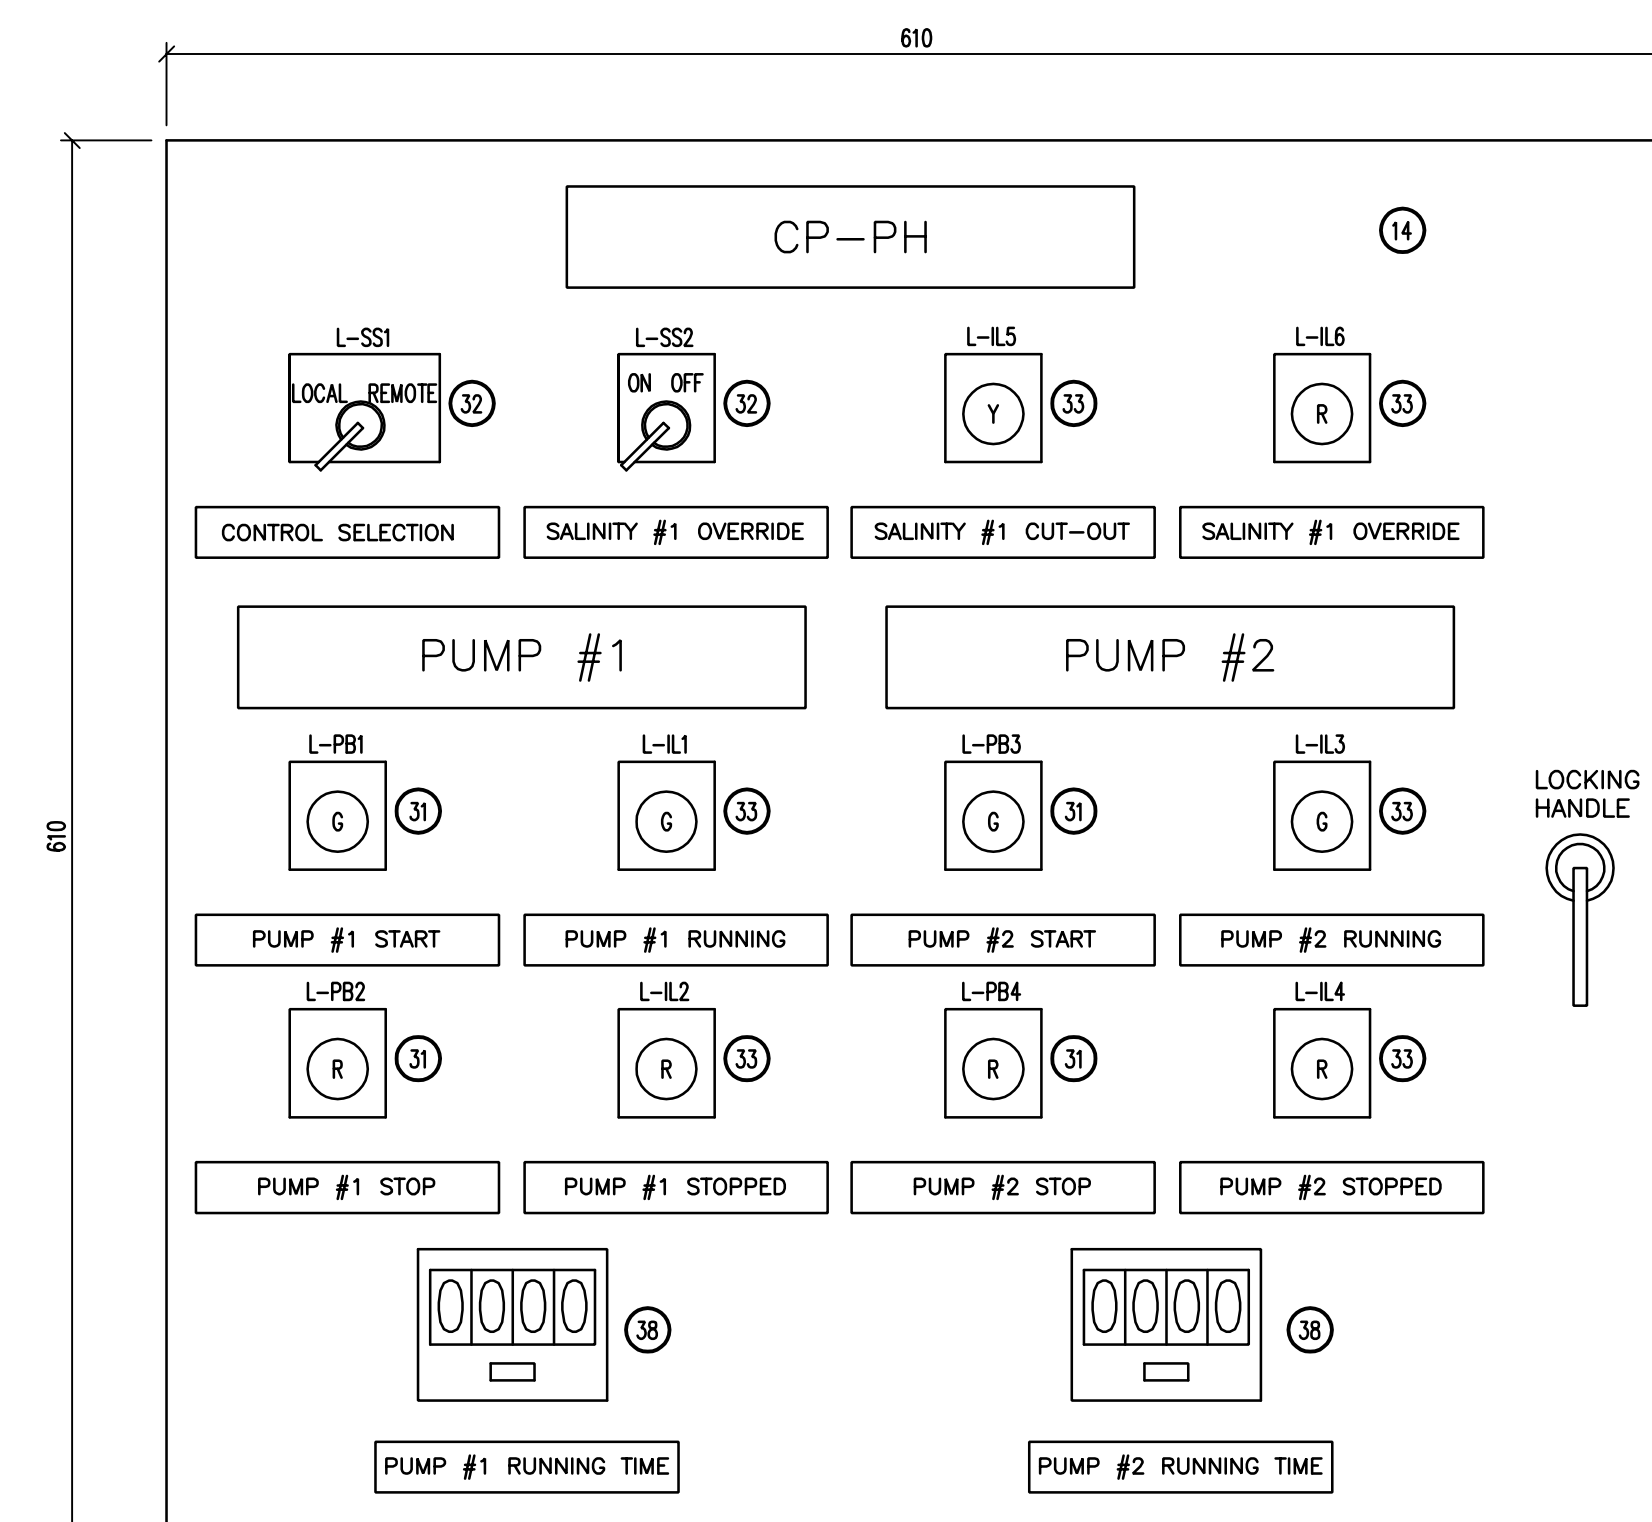

2 CONTROL PANEL FRONT LAYOUT AT PUMPHOUSE  
EP-3 SCALE: N.T.S.

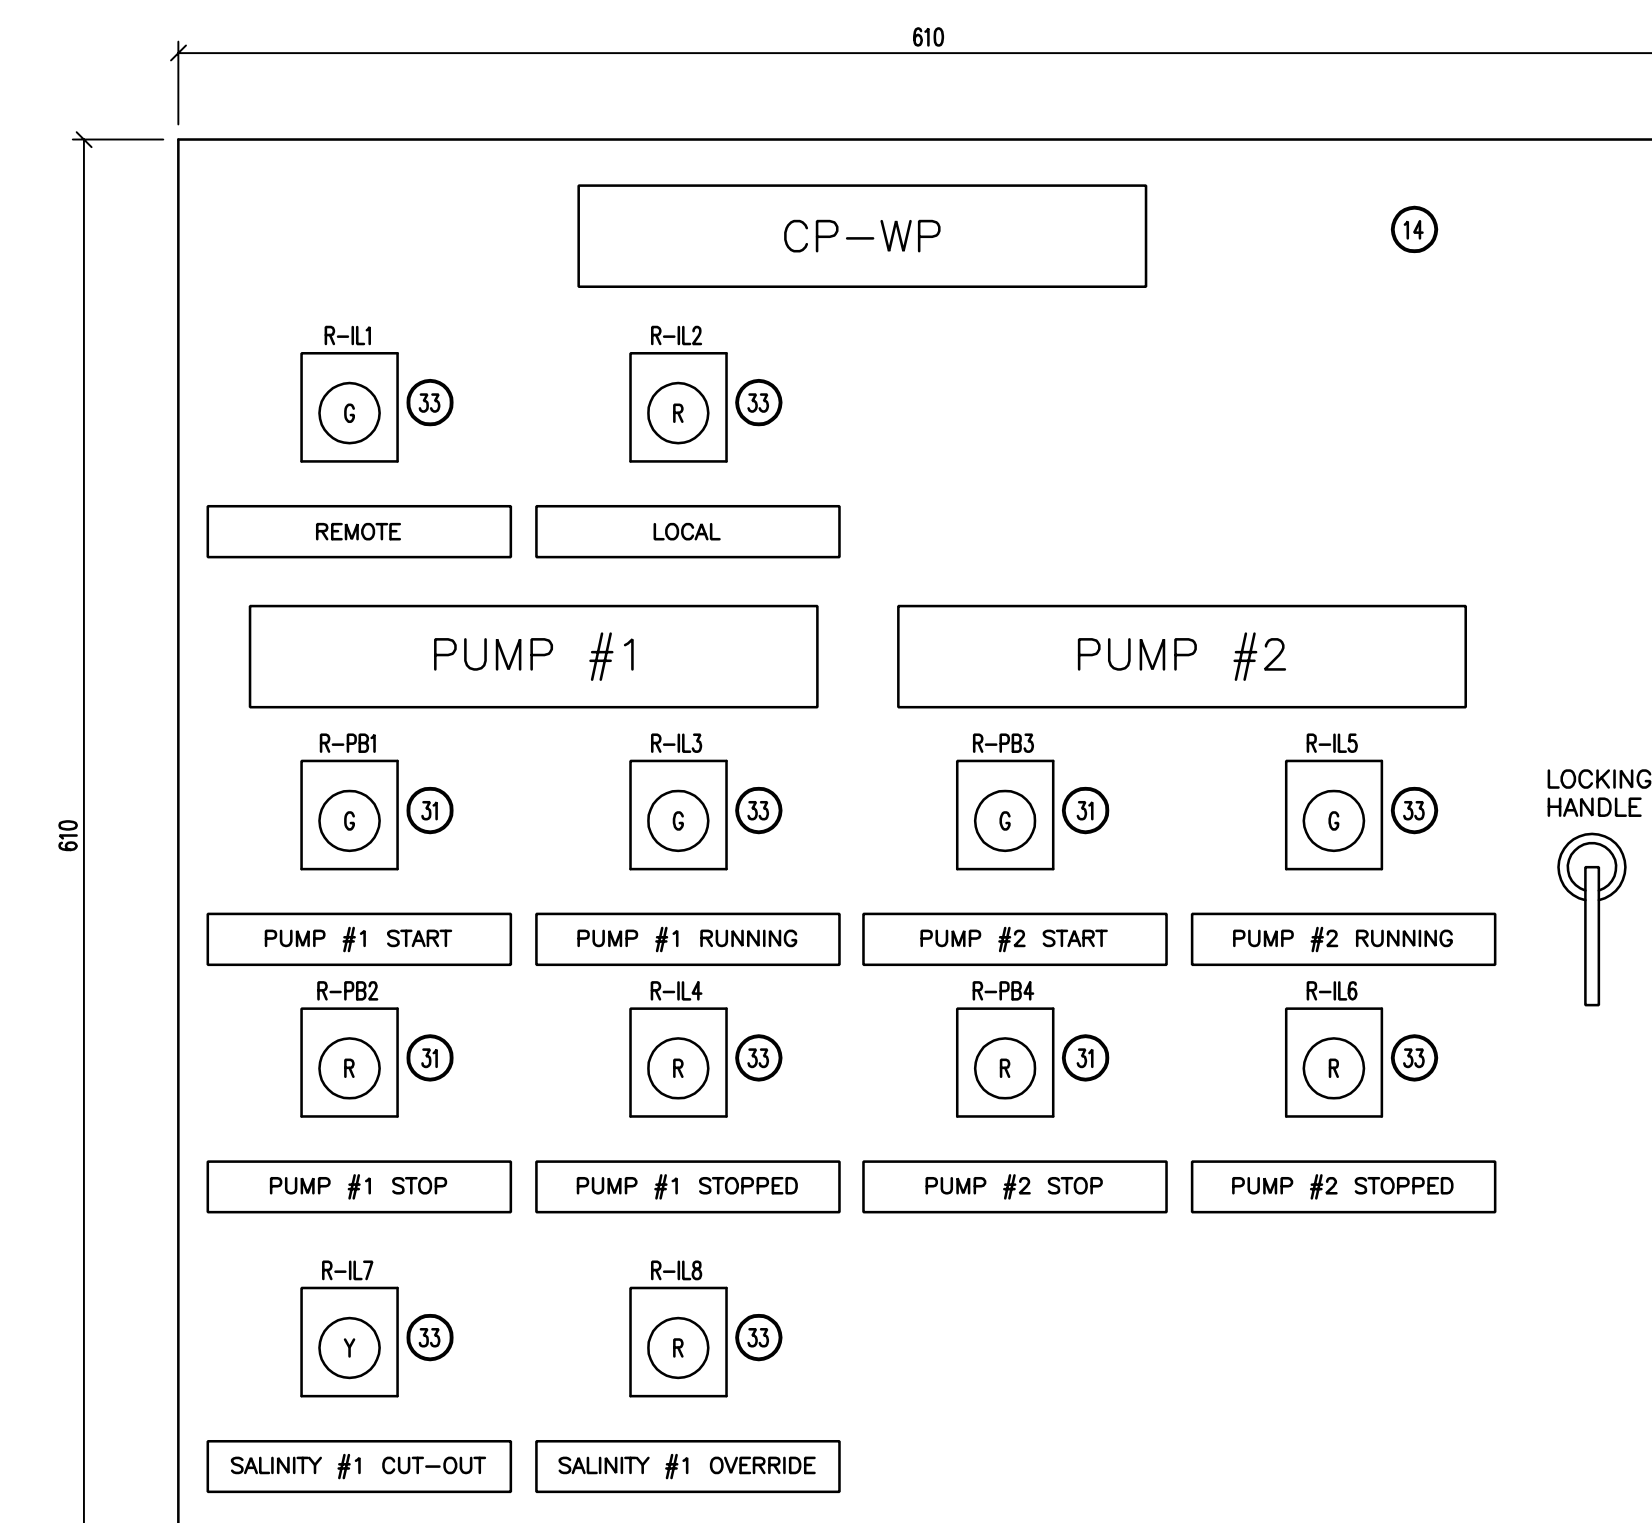

3 CONTROL PANEL FRONT LAYOUT AT WATER TREATMENT PLANT  
EP-3 SCALE: N.T.S.

REVISONS				
NO.	DESCRIPTION	YYYYMMDD	BY	APP.
0	ISSUED FOR TENDER	2010.05.04	JG	JH
1	ISSUED FOR CONSTRUCTION	2010.08.06	JG	JH
2	RECORD DRAWING	2014.10.09	AC	

LIST OF ABBREVIATIONS:  
IC = INPUT CONTACT  
OC = OUTPUT CONTACT  
PB = PUSHBUTTON  
N/O = NORMALLY OPEN  
N/C = NORMALLY CLOSE  
SS = SELECTOR SWITCH

1. ALL DIMENSIONS ARE SHOWN IN MILLIMETERS.
2. CONDUITS SHALL BE RIGID, GALVANIZED STEEL.
3. TO ALL NUMBER OF WIRES SHOWN IN CONDUITS, CONTRACTOR SHALL ADD ONE GROUND WIRE AS PER CEC REQUIREMENTS.
4. MOUNT ALL ELECTRICAL EQUIPMENT SO THAT CONNECTIONS CAN BE EASILY EXPOSED FOR SERVICE.
5. ALL SWITCHES, STARTERS, THERMOSTATS, RELAYS, CONTACTORS, TIMERS, ETC., SHALL BE IDENTIFIED WITH STAINLESS STEEL OR LAMACADOS LABELS FASTENED TO BOXES.
6. FOR WIRING DIAGRAMS SEE DWG. EP-4.
7. AVAILABLE POWER SUPPLY TO THIS BUILDING SHALL BE 3 PHASE 600 V AND 208 V, 60 Hz.
8. FOR DESCRIPTION OF ITEMS (A), (B), (C), (D), & (E) REFER TO DWG. EP-2.

DRAWINGS WERE BASED UPON INFORMATION SUBMITTED FROM OTHER PARTIES AND THE ENGINEER DOES NOT WARRANT OR CERTIFY THAT THE INFORMATION FROM THESE OTHER PARTIES IS ACCURATE.

DATE (YYYY MM DD): 2014.10.09

[illegible]

FOR BEST PLOTTING RESULTS, BE SURE TO USE  
WILLIAMS ENGINEERING CANADA AUTOCAD PLOT CONFIGURATION  
FILES AVAILABLE FROM: [www.williamsengineering.com](http://www.williamsengineering.com)

FOR BEST PLOTTING RESULTS, BE SURE TO USE  
WILLIAMS ENGINEERING CANADA AUTOCAD PLOT CONFIGURATION  
FILES AVAILABLE FROM: [www.williamsengineering.com](http://www.williamsengineering.com)

SECTION # 1 DETAIL # A  
SOURCE / REFERENCE DWG. A-001 SOURCE / REFERENCE DWG. E-001

INFORMATION CONTAINED ON THIS DRAWING IS COPYRIGHTED AND HAS BEEN PREPARED FOR THE SOLE PURPOSE OF THIS PROJECT. UNAUTHORIZED USE OF THIS INFORMATION WILL BE CONSIDERED A BREACH OF COPYRIGHT AND MAY BE PURSUED AS SUCH. USE OF THIS INFORMATION FOR ANY OTHER PURPOSE OTHER THAN THIS PARTICULAR PROJECT IS AT THE RISK OF THE USER.

PERMIT STAMP:

PERMIT TO PRACTICE  
WILLIAMS ENGINEERING CANADA INC.  
PERMIT NUMBER  
P 646  
NWT/NU Association of Professional  
Engineers and Geoscientists

ENGINEER'S SEAL

**YELLOWKNIFE OFFICE**  
P.O. Box 1529  
4903 47 Street  
Yellowknife, NT X1A 2P2

Bus: (867) 873-2395  
Toll Free: 1-800-263-2383  
Fax: (867) 873-2547

**info@williamsengineering.com**  
**www.williamsengineering.com**

**WILLIAMS  
ENGINEERING**



QUEST




JOB TITLE:  
WATER SUPPLY IMPROVEMENTS  
PHASE 1  
NEW INTAKE AND PUMPHOUSE  
KUGLUKTUK, NU

CWG2. TITLE: PUMPHOUSE ELECTRICAL CONTROL AND INSTRUMENTATION

OWN. BY:	JL	DES. BY:	JL	PROJ. MGR:	JH
PEER REVIEW:	JL	DATE: (YY-MM-DD)	2010.08.06		
CLIENT PROJ. #	GN PROJECT #04-4417			SEC PROJ. #	i13655.00

EP-3	5	REV	1
------	---	-----	---

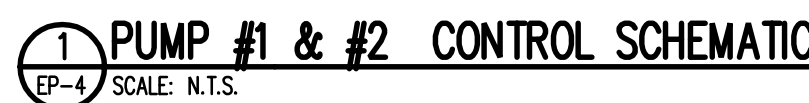

1 SEE DETAIL 1/EP-4.



---



MECHANICAL EQUIPMENT SCHEDULE																
EQUIP. No.	DESCRIPTION	LOCATION	HP/W	VOLT/ PHASE	STARTER AND ACCESSORIES						REMOTE CONTROL	MCC KEY OF CCT. No.	FUSE/ BREAKER SIZE	FEEDER	REMARKS	
					SIZE	MAN.	MAG.	ON/OFF	P.L.	H.O.A.						V.F.D.
P-1	INTAKE PUMP	INTAKE LOCATION	7.5 HP	600V / 3ø				X	X			X	SPLITTER	3P-40A	16C-3ø10	NOTE 2, 3, 4.
P-2	INTAKE PUMP	INTAKE LOCATION	7.5 HP	600V / 3ø				X	X			X	SPLITTER	3P-40A	16C-3ø10	NOTE 2, 3, 4.
C-1	COMPRESSOR	PUMP HOUSE	5.0 HP	208V / 3ø									PH-21/23/25	3P-40A	16C-3ø10	NOTE 1, 2, 5.
RH-1	RADIANT HEATER #1	PUMP HOUSE	3.6 kW	208V / 1ø				X				X	PH-09/11	2P-25A	16C-2ø10	NOTE 1, 2.
RH-2	RADIANT HEATER #2	PUMP HOUSE	3.6 kW	208V / 1ø				X				X	PH-13/15	2P-25A	16C-2ø10	NOTE 1, 2.
HT-1	HEAT TRACE #1	PIPE IN FIELD	0.27 KW (1.9 A)**	208V / 1ø								X	PH-01/03	2P-15A	16C-2ø10	NOTE 2, 6, 7.
HT-2	HEAT TRACE #2	PIPE IN FIELD	2.61 KW (11.4 A)**	208V / 1ø								X	PH-05/07	2P-25A	16C-2ø10	NOTE 2, 6, 7.
HT-3	HEAT TRACE #3	PIPE IN FIELD	0.94 KW (4.1 A)**	208V / 1ø								X	PH-10/12	2P-15A	16C-2ø10	NOTE 2, 6, 7.
HT-4	HEAT TRACE #4	PIPE IN FIELD	2.61 KW (11.4 A)**	208V / 1ø								X	PH-14/16	2P-25A	21C-2ø6	NOTE 2, 6, 7.

- NOTES:
1. PROVIDE DISCONNECT SWITCH AS REQUIRED BY CEC, CONTROLS BY DIV. 15.
  2. PROVIDE GROUNDING & BONDING AS CEC REQUIREMENT.
  3. PROVIDE TWIST-LOCK RECEPTACLES. COORDINATE RECEPTACLE TYPE WITH MECHANICAL.
  4. STARTER c/w GROUND FAULT SENSOR.
  5. COMPRESSOR c/w THERMAL RELAY MOTOR PROTECTION WITH RESET BUTTON IN A NEMA 1 ENCLOSURE.
  6. SYMBOL "\*\*" IS CIRCUIT OPERATING CURRENT.
  7. FEED POWER THROUGH GFI BREAKERS.

PANEL SCHEDULE														
PANEL	PH	LOCATION	VOLTAGE	PHASE	WIRE	BUS	MAIN BKR.	INT. CAP. (SYM RMS)	CIRCUITS	MOUNTING	FEEDER			
		PUMPHOUSE	120/208	3	4	100A	-	10KA		30	SURFACE	35C-4#3		
NOTES: * PROVIDE BREAKER LOCK ON GFI BREAKER														
LOADS			DESCRIPTION	POLE	AMP	CCT. NO.	ø	CCT. NO.	AMP	POLE	DESCRIPTION	LOADS		
L1	L2	L3										L1 L2 L3		
0.14			HEAT TRACE #1	[GFI BREAKER]	2	15	1	2	15	1	EXTERIOR RECEPTACLE	0.5		
						3		4	15	1	INTERIOR RECEPTACLES	0.6		
		1.3	HEAT TRACE #2	[GFI BREAKER]	2	25	5	6	15	1	INTERIOR & EXTERIOR LIGHTING / EMERGENCY LIGHTS	0.4		
1.3						7		8	15	1	AUTO-DIALLER	0.5		
	1.8		RADIANT HEATER RH-1		2	25	9	10	15	2	HEAT TRACE #3	[GFI BREAKER] 0.5		
		1.8				11		12				0.5		
1.8			RADIANT HEATER RH-2		2	25	13	14	25	2	HEAT TRACE #4	[GFI BREAKER] 1.1		
	1.8					15		16				1.1		
		0.1	SPACE HEATER & HEAT TRACE CONTROL		1	15	17	18	15	1	SPARE			
0.1			PUMP #1 & PUMP #2 CONTROL		1	15	19	20	15	1	SPARE			
	1.5		COMPRESSOR C-1		3	40	21	22	15	1	SPARE			
		1.5				23		24						
1.5						25		26						
	0.5		SWITCHING POWER SUPPLY FOR FLOW METER		1	15	27	28						
		0.5	SALINITY METER		1	15	29	30						
4.84	5.74	5.2	TOTAL PEAK LOAD (WATTS) W									2.1	2.2	0.9

TOTAL PEAK LOAD (WATTS) W AT (VOLTS) V, IMPLIES (AMPS) A  
CEC DEMAND FACTOR OF 0.9 APPLIED  
RESULTS IN A MIN. SERVICE AMPACITY OF (AMPS) A.


#### KEYNOTES:

1. HEAT TRACE RUNS DOWN FROM VAULT 2 TO TO PUMPS ALONG UNINSULATED 4" HDPE INNER PIPE AND THEN BACK UP AGAIN, TERMINATING ON THE INNER PIPE JUST INSIDE VAULT 2. SEE DETAIL 4, THIS DRAWING. HEATER MUST BE SANDWICHED WITH ALUMINUM TAPE FOR THE FULL RUN AND STRAPPED TO THE PIPE AT REGULAR INTERVALS. SEE DETAIL 2, THIS DRAWING.
2. 4" SCHEDULE 40 STEEL PIPING SECTION TO BE INSULATED WITH SPRAY FOAM INSULATION. MOUNT HEAT TRACE TO PIPING BEFORE INSULATING.
3. HEAT TRACE #2 ENTERS VAULT #2, WRAPS AROUND AND DOUBLES BACK ON EACH LEG OF THE TECH-TAYLOR VALVE, THEN TERMINATES WITH AN END SEAL (41) BACK AT ITS ENTRY POINT JUST INSIDE VAULT 2. SEE DETAILS 4,5 THIS DRAWING. DISTRIBUTE DOUBLE RUNS ON SINGLE PIPE EVENLY (180° APART), CONSULT MANUFACTURER AS TO RECOMMENDED VALVE WRAPPING PATTERN.
4. THE LENGTH SPECIFIED FOR HEAT TRACE #4 IS TOTAL FOR BOTH PIPES, DOUBLED BACK.
5. MULTIPLE ENTRY JUNCTION BOX (43) MOUNTS TO PIPE STAND SUPPORTING TECH-TAYLOR VALVE. MOUNT AT MAXIMUM HEIGHT POSSIBLE ON STAND. FREE AIR RUN OF HEAT TRACE FROM JUNCTION BOX TO PIPING ELBOW.
6. PROVIDE HEAT TRACE NUMBER AND ASSOCIATED FEED CIRCUIT NUMBER ON LAMICOID LABEL MOUNTED NEXT TO POWER ENTRY JUNCTION BOX FOR EACH HEAT TRACE CABLE.
7. REFER TO DETAILS 4,5, THIS DRAWING, FOR EXACT LOCATIONS OF HEAT TRACING COMPONENTS IN VAULT 2.
8. RUN HEAT TRACE TO POINT AS CLOSE AS POSSIBLE TO PIPE CONNECTION WITH PUMP.


1. ALL DIMENSIONS ARE SHOWN IN MILLIMETERS.
2. CONDUITS SHALL BE RIGID, GALVANIZED STEEL.
3. TO ALL NUMBER OF WIRES SHOWN IN CONDUITS, CONTRACTOR SHALL ADD ONE GROUND WIRE AS PER CEC REQUIREMENTS.
4. MOUNT ALL ELECTRICAL EQUIPMENT SO THAT CONNECTIONS CAN BE EASILY EXPOSED FOR SERVICE.
5. ALL SWITCHES, STARTERS, THERMOSTATS, RELAYS, CONTACTORS, TIMERS, ETC., SHALL BE IDENTIFIED WITH STAINLESS STEEL LABELS FASTENED TO BOXES.
6. FOR WIRING DIAGRAMS SEE DWG. EP-4.
7. AVAILABLE POWER SUPPLY TO THIS BUILDING SHALL BE 3 PHASE 600 V AND 208 V, 60 Hz.
8. FOR DESCRIPTION OF ITEMS ①, ②, ③, ④, ..... REFER TO DWG EP-2.
9. PROVIDE HEAT TRACE NUMBER AND ASSOCIATED FEED CIRCUIT NUMBER ON LAMICOID LABEL MOUNTED NEXT TO POWER ENTRY JUNCTION BOX FOR EACH HEAT TRACE CABLE.

#### RECORD DRAWING


DRAWINGS WERE BASED UPON INFORMATION SUBMITTED FROM OTHER PARTIES AND THE ENGINEER DOES NOT WARRANT OR CERTIFY THAT THE INFORMATION FROM THESE OTHER PARTIES IS ACCURATE.  
DATE (YYYY MM DD): 2014.10.09

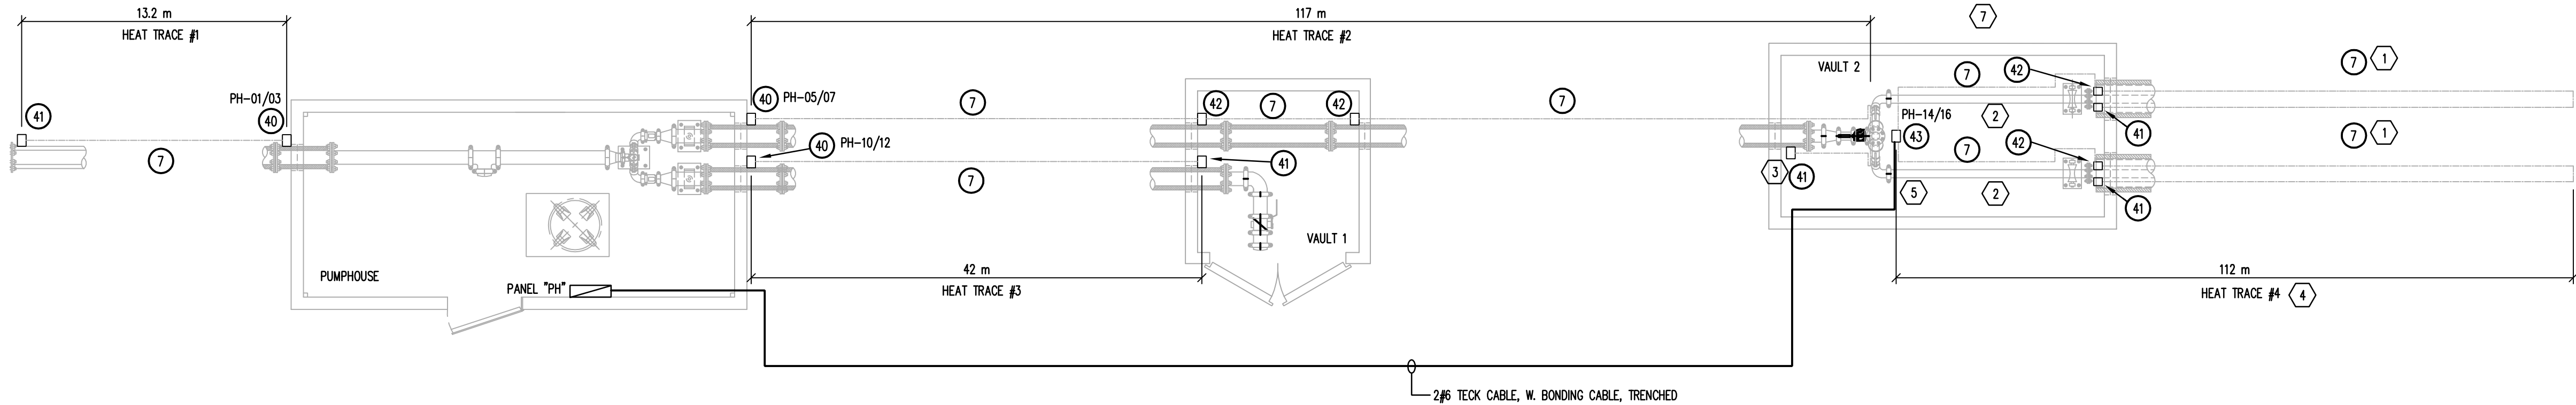


1 HEAT TRACING SYSTEM SCHEMATIC  
EP-5 SCALE: N.T.S.

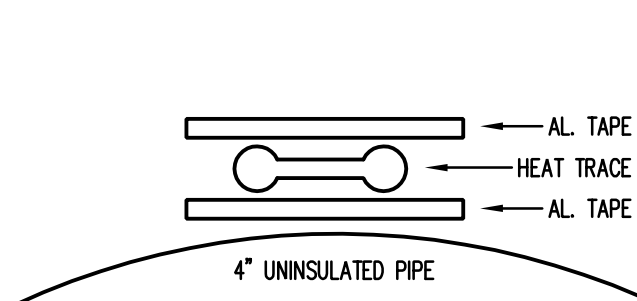


2 HEATER SANDWICHING  
EP-5 SCALE: N.T.S.

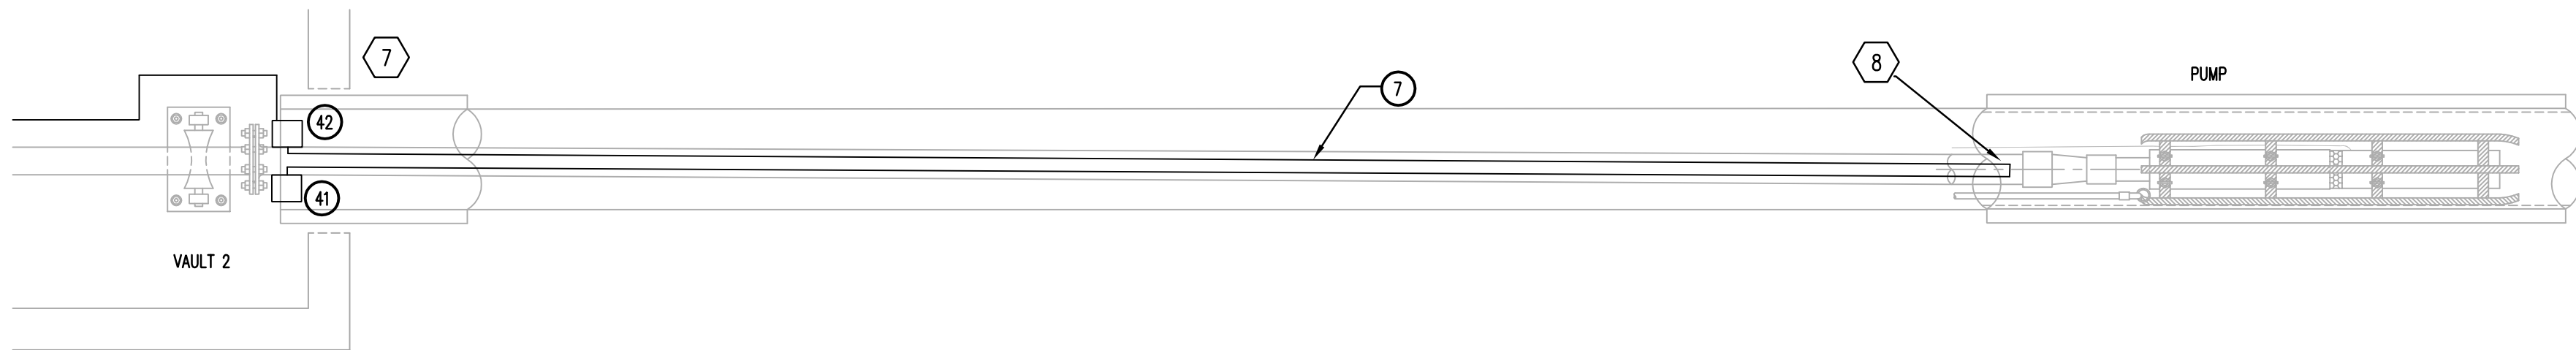

3 HEAT TRACE PUMP RUN  
EP-5 SCALE: N.T.S.

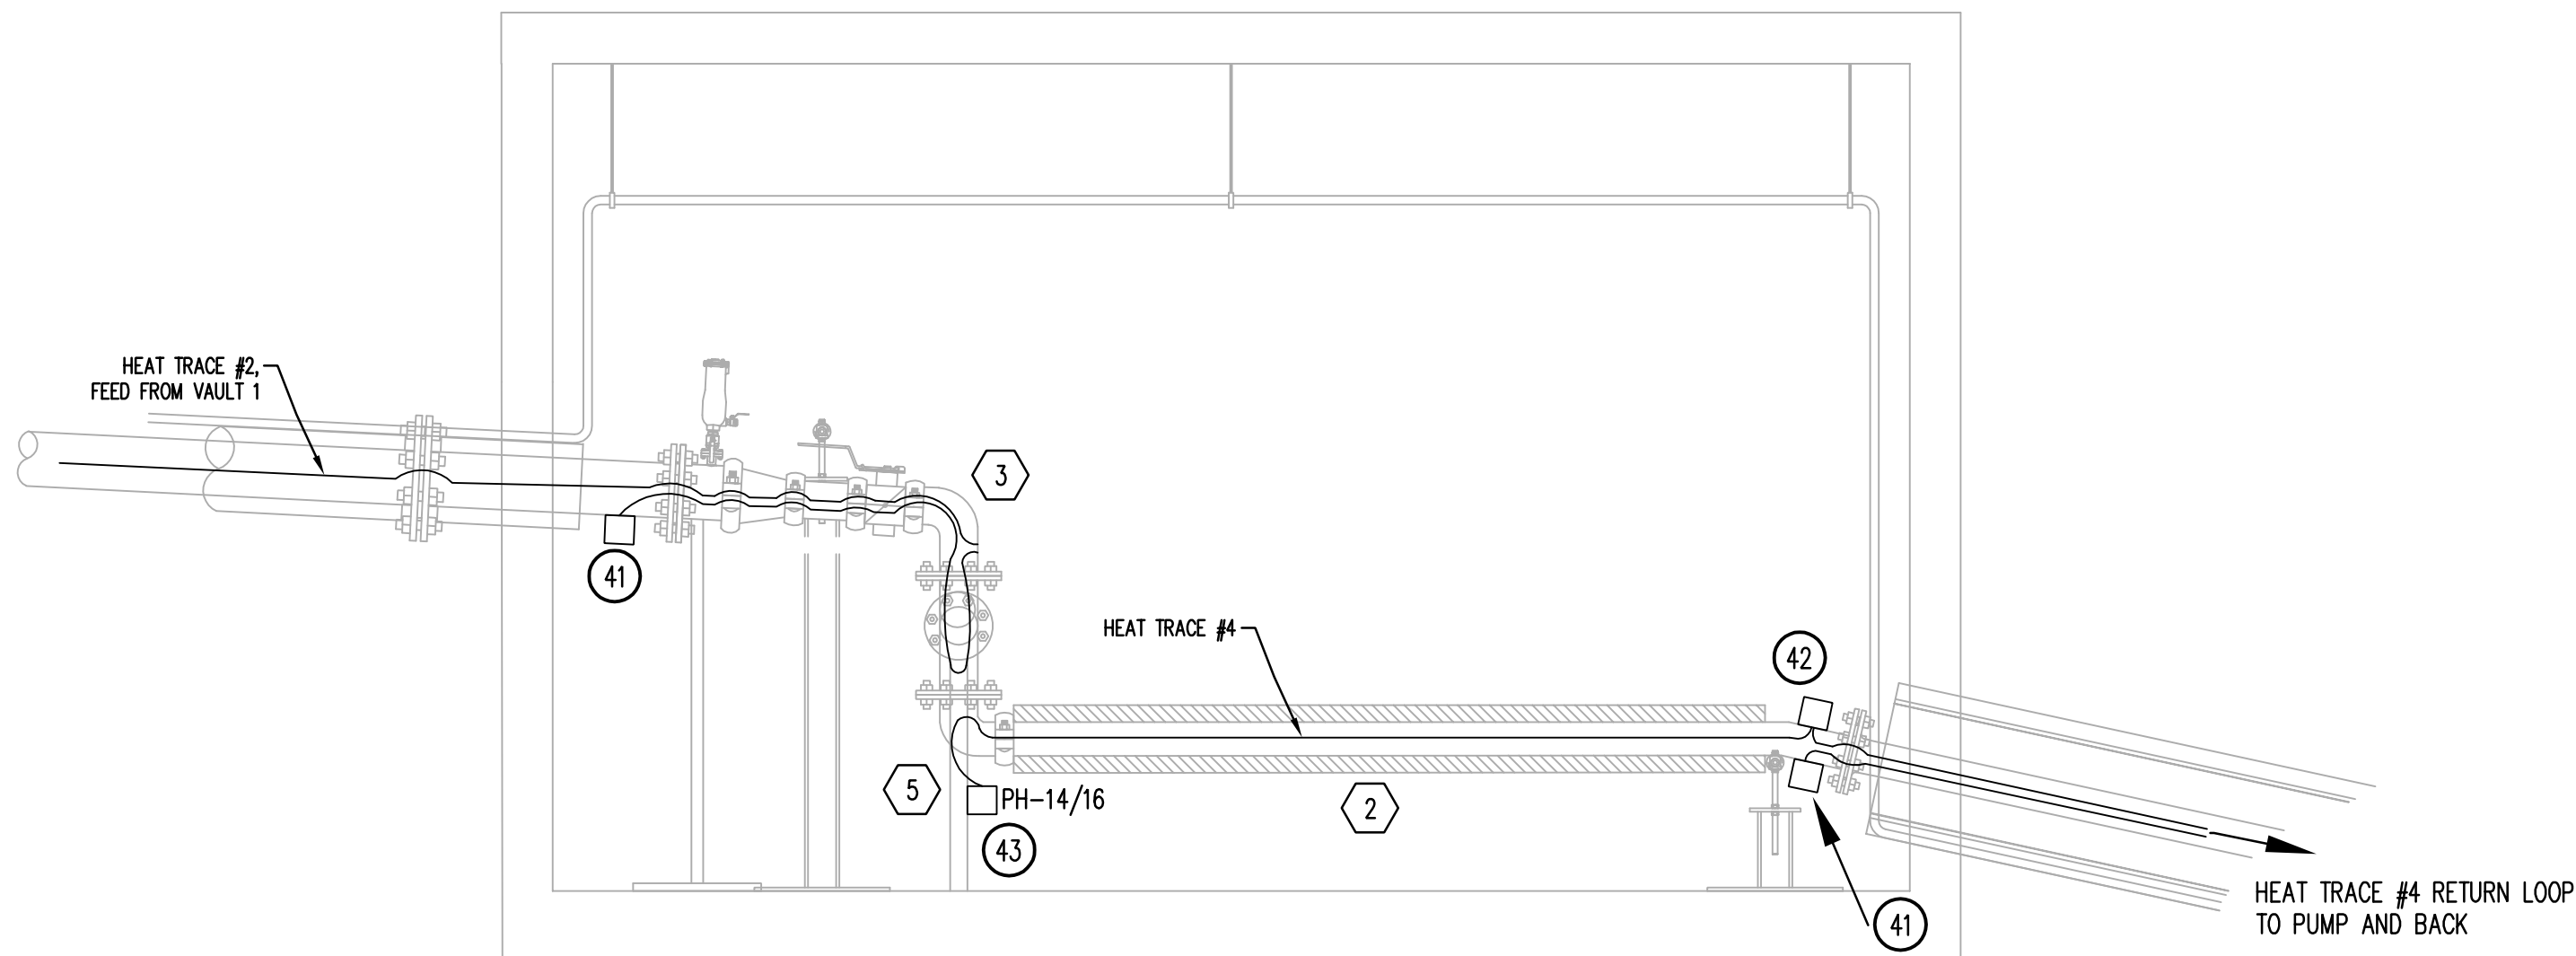

4 ACCESS VAULT 2 - HEAT TRACING, SIDE PROFILE  
EP-5 1:20

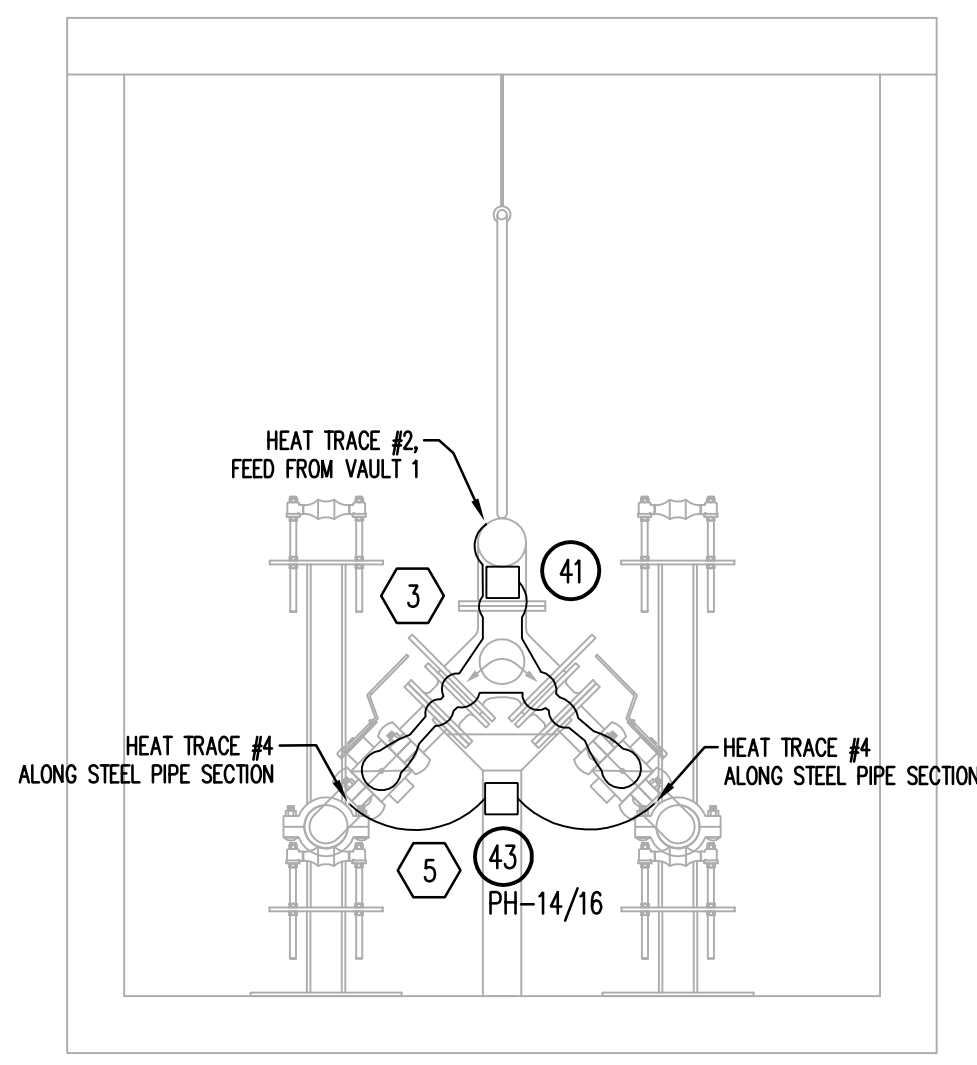

5 DETAIL - ACCESS VAULT 2 - VALVE HEAT TRACING, FRONT PROFILE  
EP-5 1:20

#### REFERENCE DRAWINGS

FOR BEST PLOTTING RESULTS, BE SURE TO USE  
WILLIAMS ENGINEERING CANADA AUTOCAD PLOT CONFIGURATION  
FILES AVAILABLE FROM: [www.williamsengineering.com](http://www.williamsengineering.com)

#### LEGEND

- SECTION # A-001  
SOURCE / REFERENCE DWG.
- DETAIL # E-001  
SOURCE / REFERENCE DWG.

INFORMATION CONTAINED ON THIS DRAWING IS COPYRIGHTED  
AND HAS BEEN PREPARED FOR THE SOLE PURPOSE OF THIS  
PROJECT. UNAUTHORIZED USE OF THIS INFORMATION WILL BE  
CONSIDERED A BREACH OF COPYRIGHT AND MAY BE PURSUED  
AS SUCH. USE OF THIS INFORMATION FOR ANY OTHER PURPOSE  
OTHER THAN THIS PARTICULAR PROJECT IS AT THE RISK OF THE  
USER.

PERMIT STAMP:  
PERMIT TO PRACTICE  
WILLIAMS ENGINEERING CANADA INC.  
PERMIT NUMBER  
P 646  
NWT/NJ Association of Professional  
Engineers and Geoscientists

ENGINEER'S SEAL:

YELLOWKNIFE OFFICE  
P.O. Box 1529  
4800 67 Street  
Yellowknife, NT X1A 2P2  
Bus: (867) 873-2385  
Tel Fax: 1-800-293-2385  
Fax: (867) 873-2607  
info@williamsengineering.com  
www.williamsengineering.com

WILLIAMS  
ENGINEERING  
CANADA

WE

CLIENT:



JOB TITLE  
WATER SUPPLY IMPROVEMENTS  
PHASE 1  
NEW INTAKE AND PUMPHOUSE  
KUGLUKTUK, NU









DWG. TITLE  
PUMPHOUSE ELECTRICAL  
SCHEDULES &  
HEAT TRACE SCHEMATICS

DWG. BY: JL/JPC DES. BY: JL/JPC PROJ. MGR.: JH

PEER REVIEW: JL DATE: (YY-MM-DD) 2010.08.06 SCALE: AS NOTED

CLIENT PROJ. # GN PROJECT #04-4417 REC PROJ. # 113655.00


DWG. EP-5 5 1

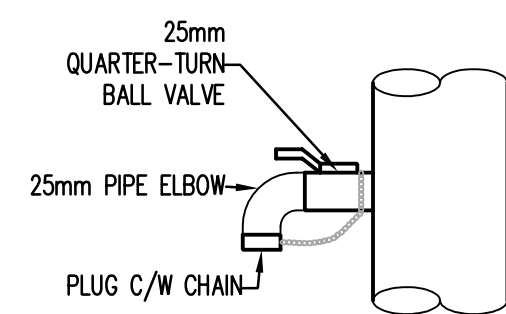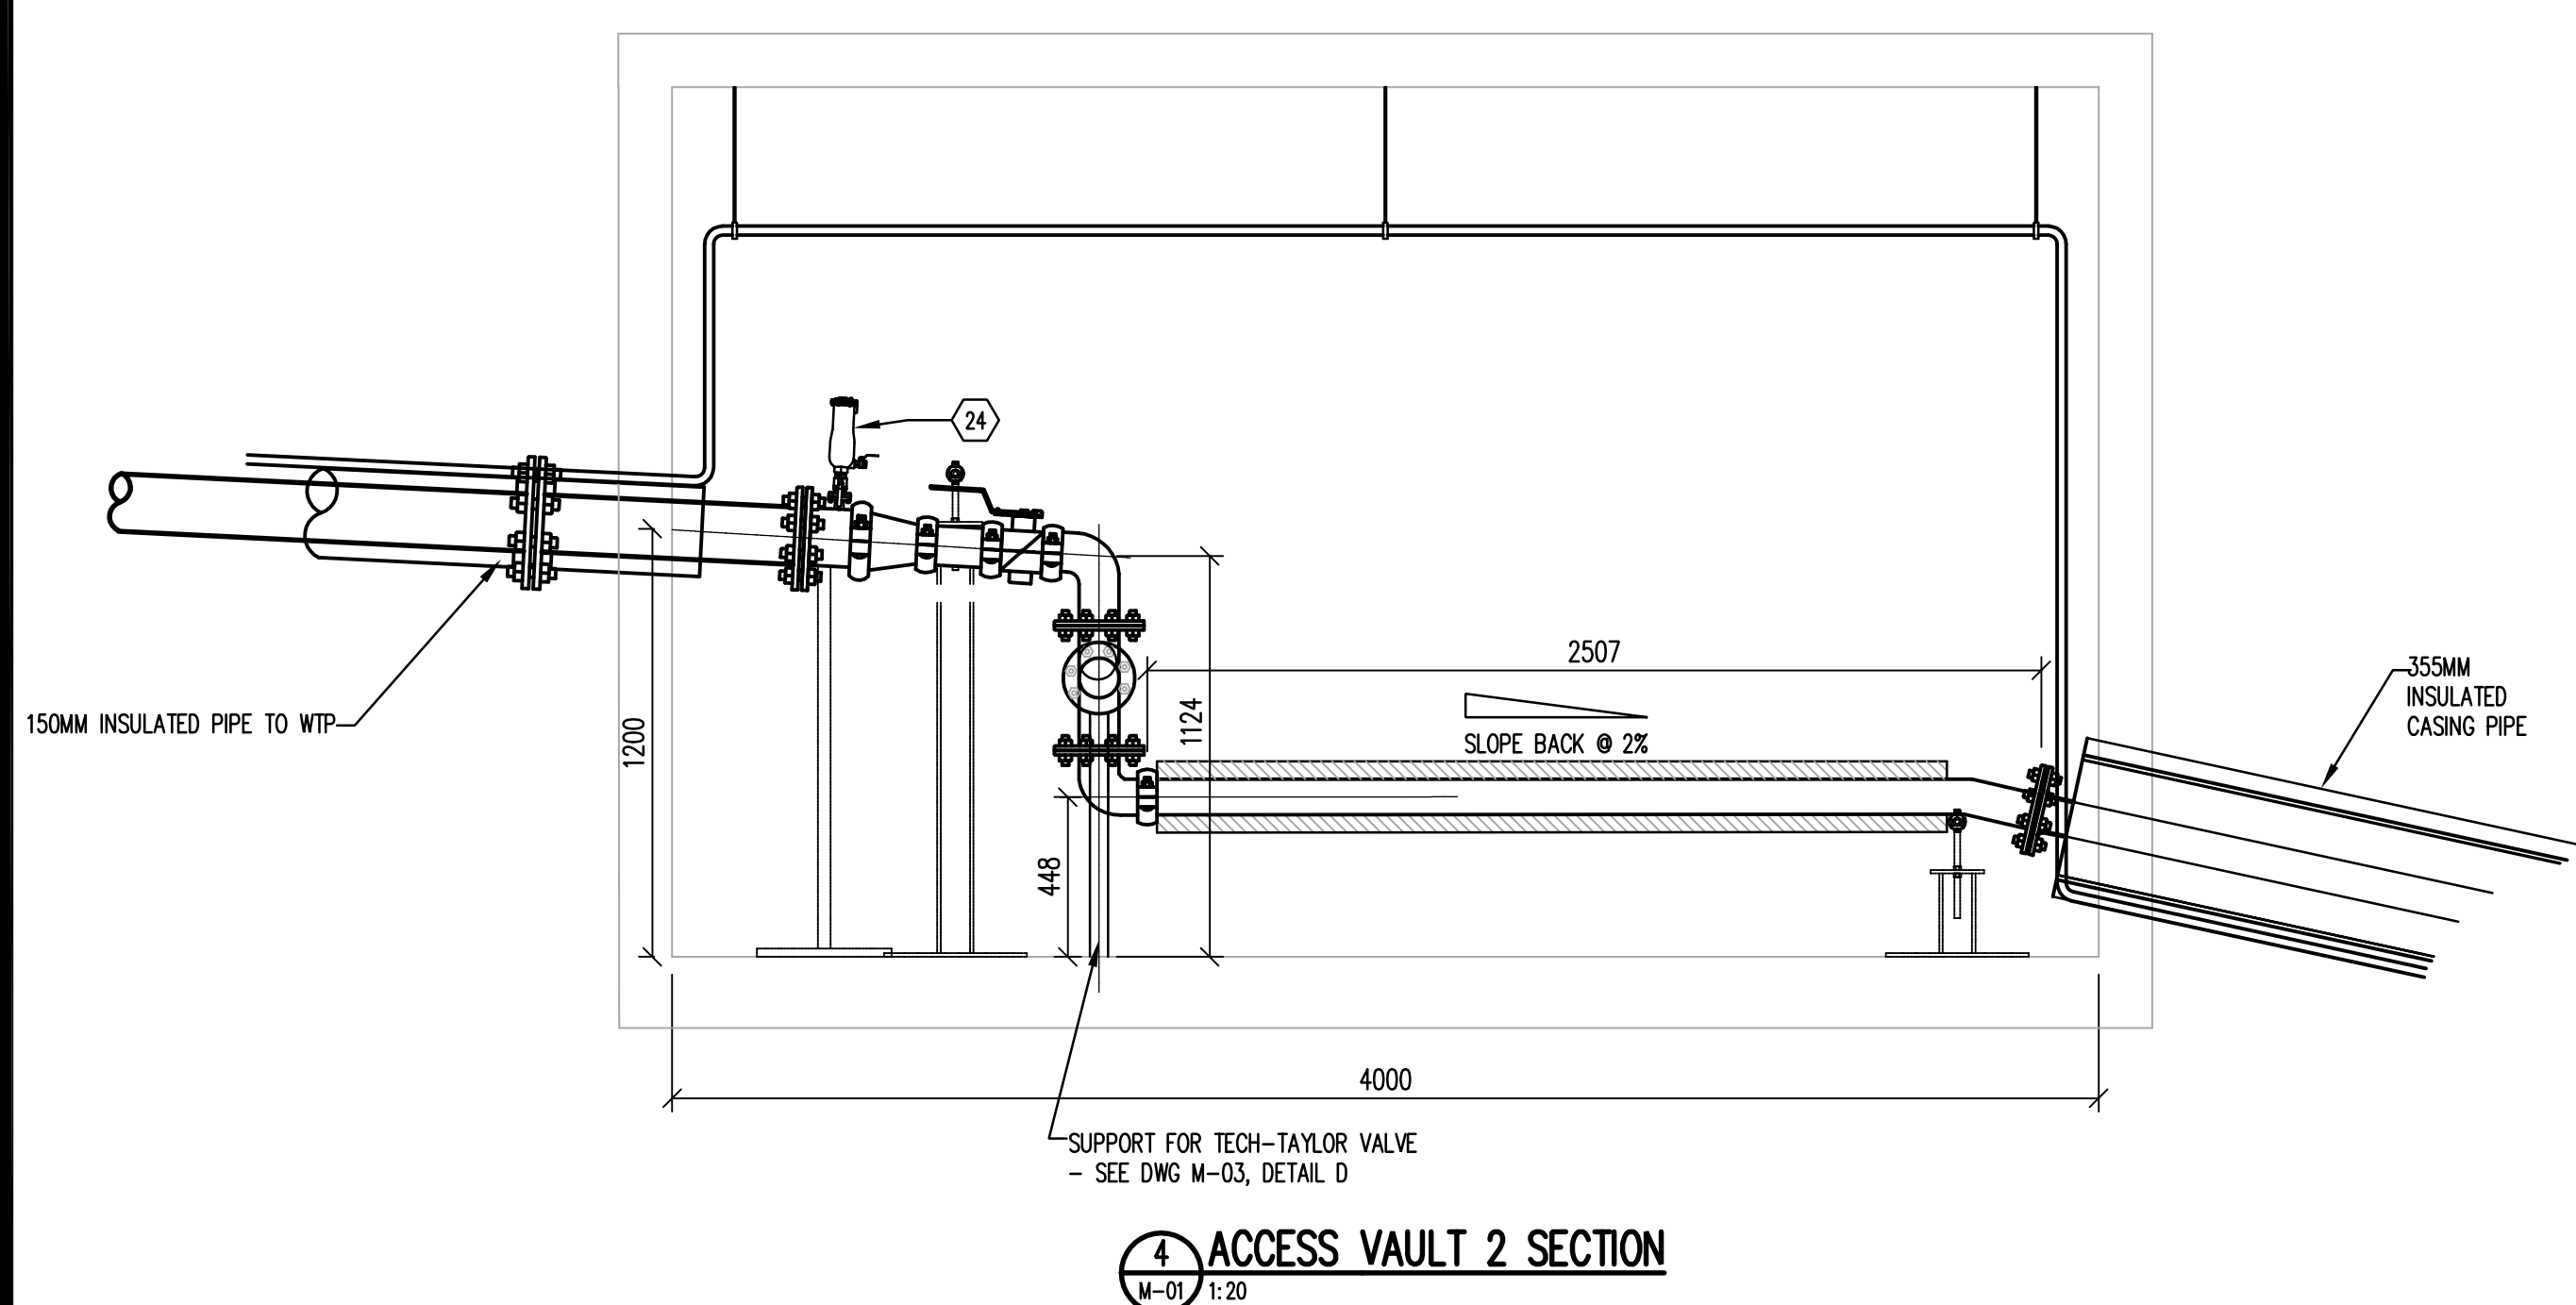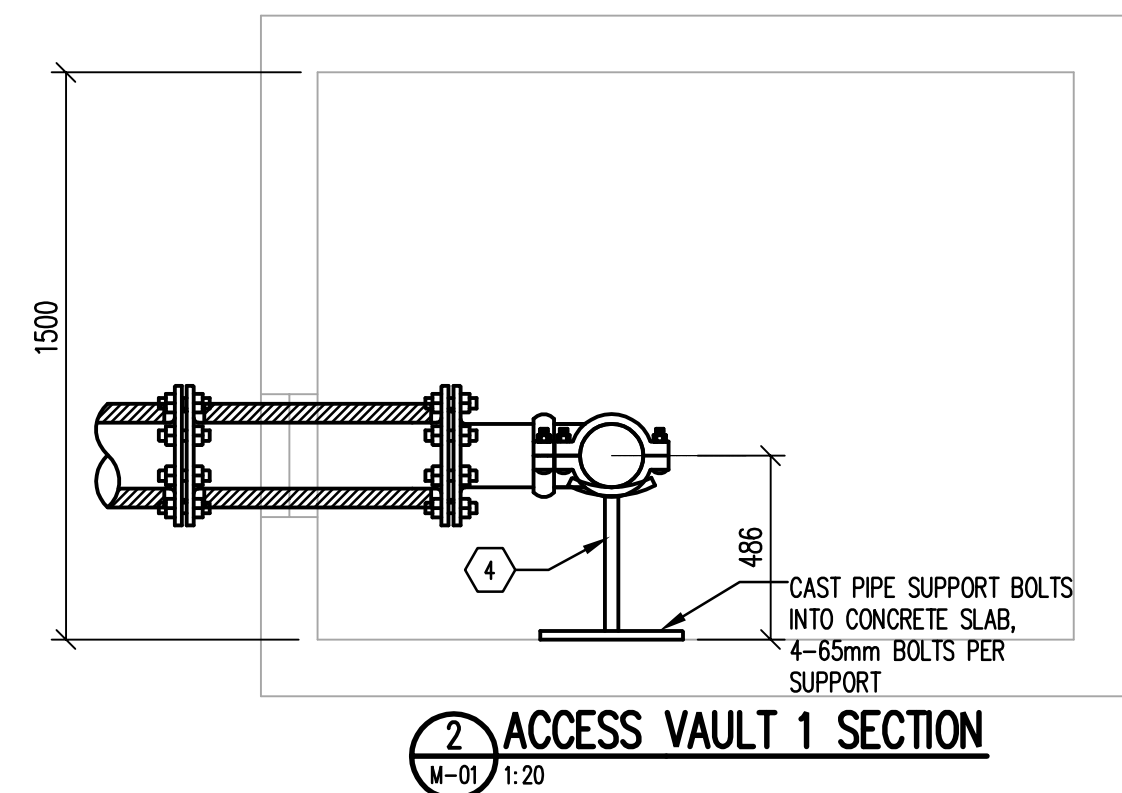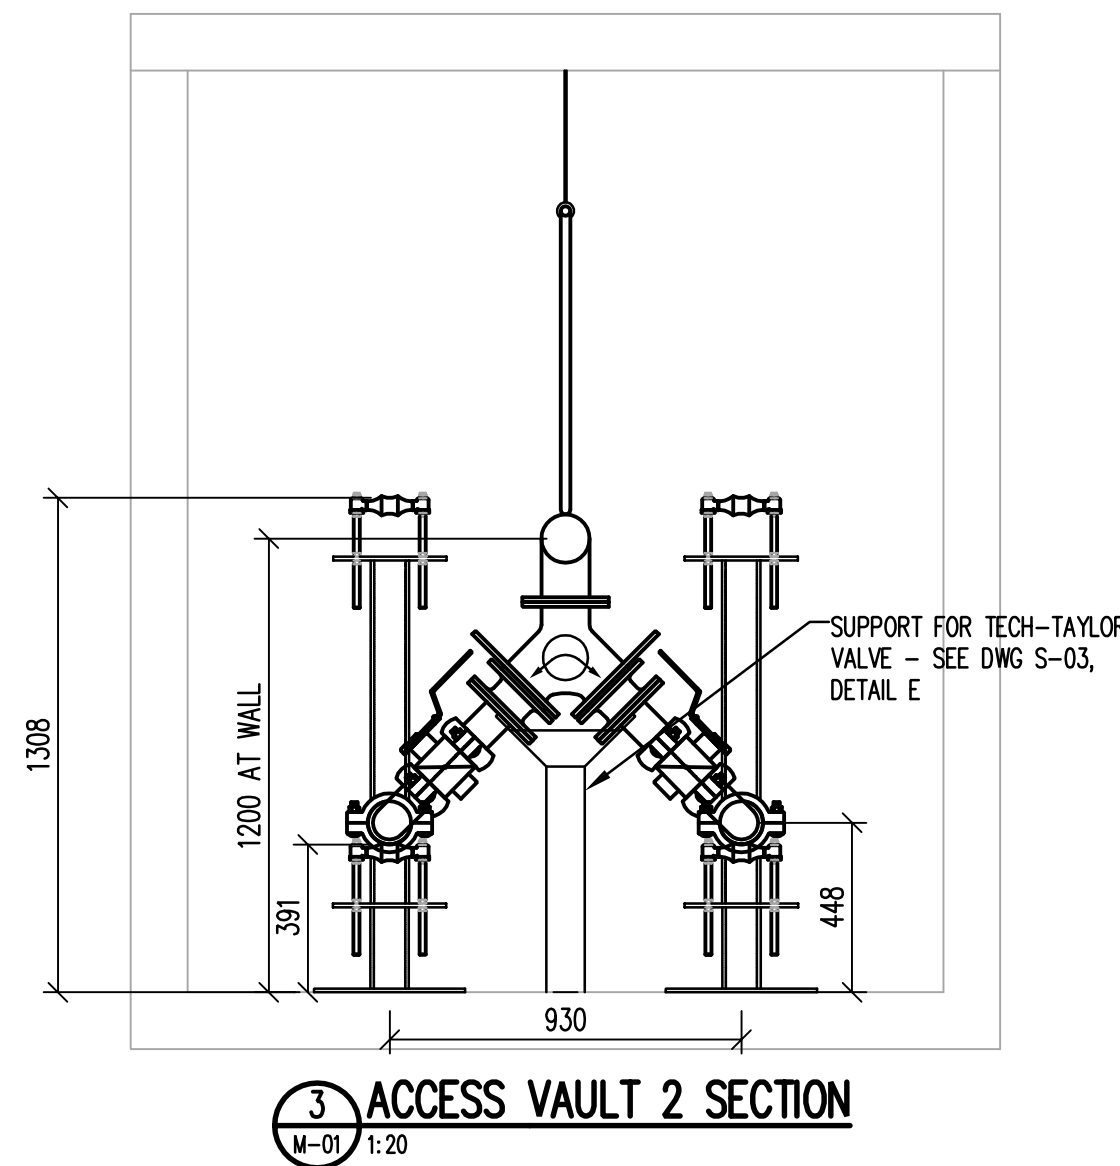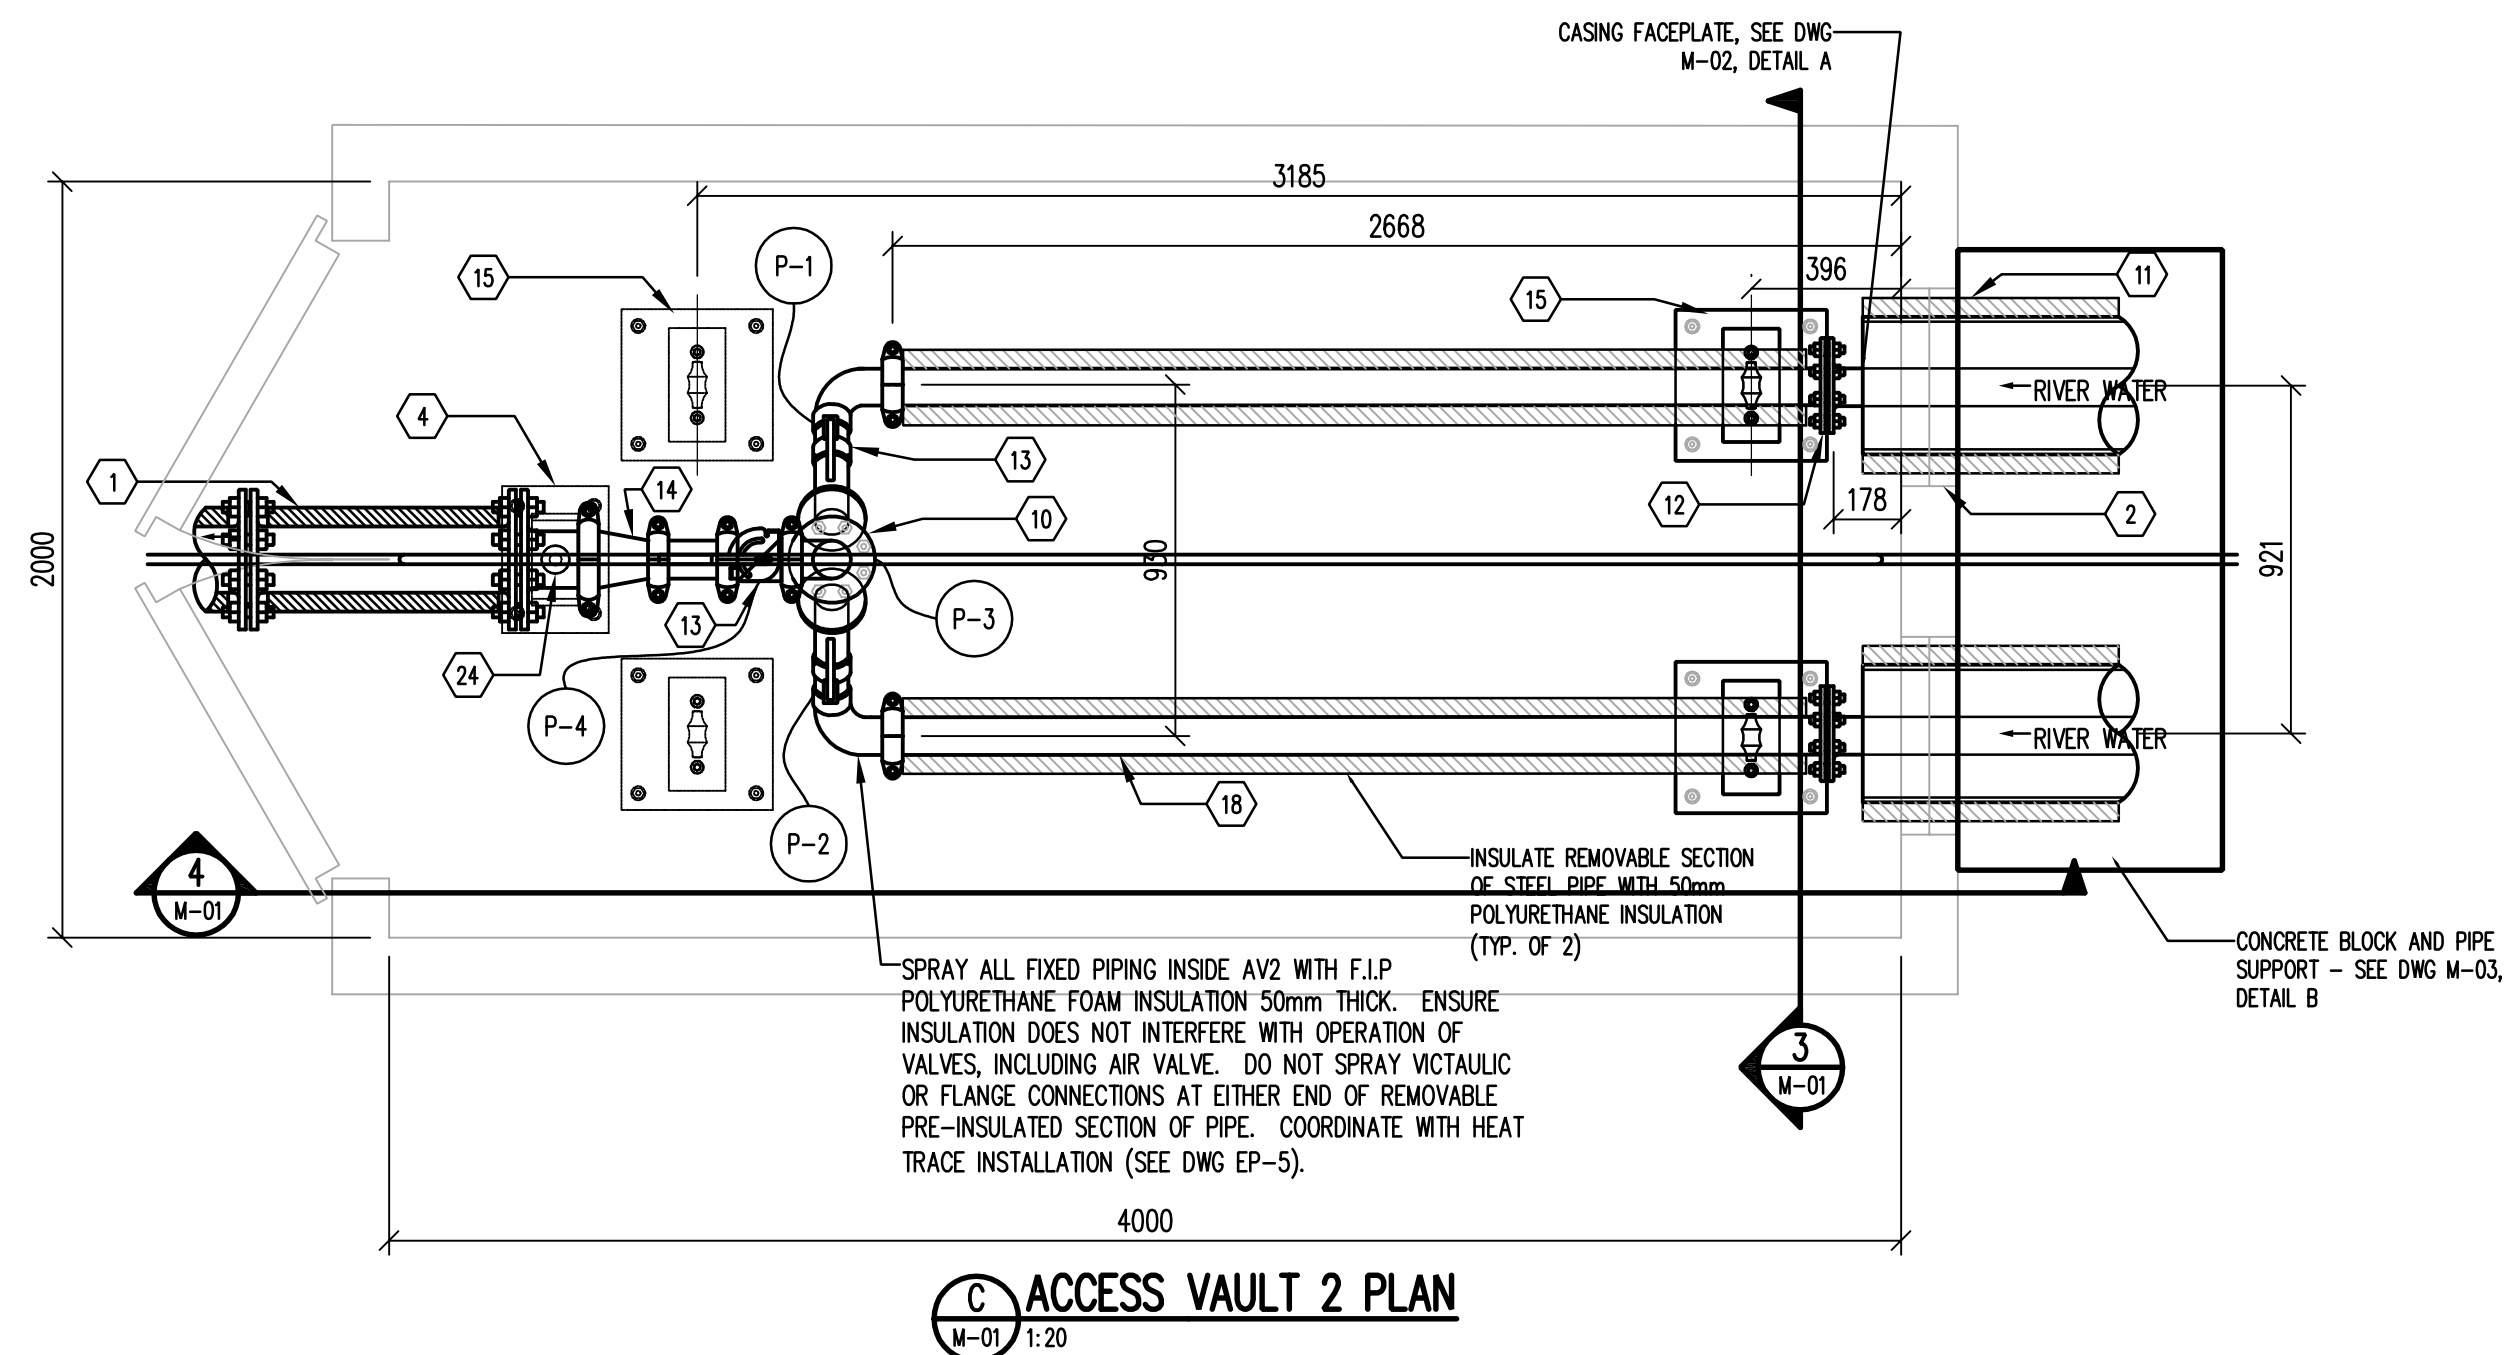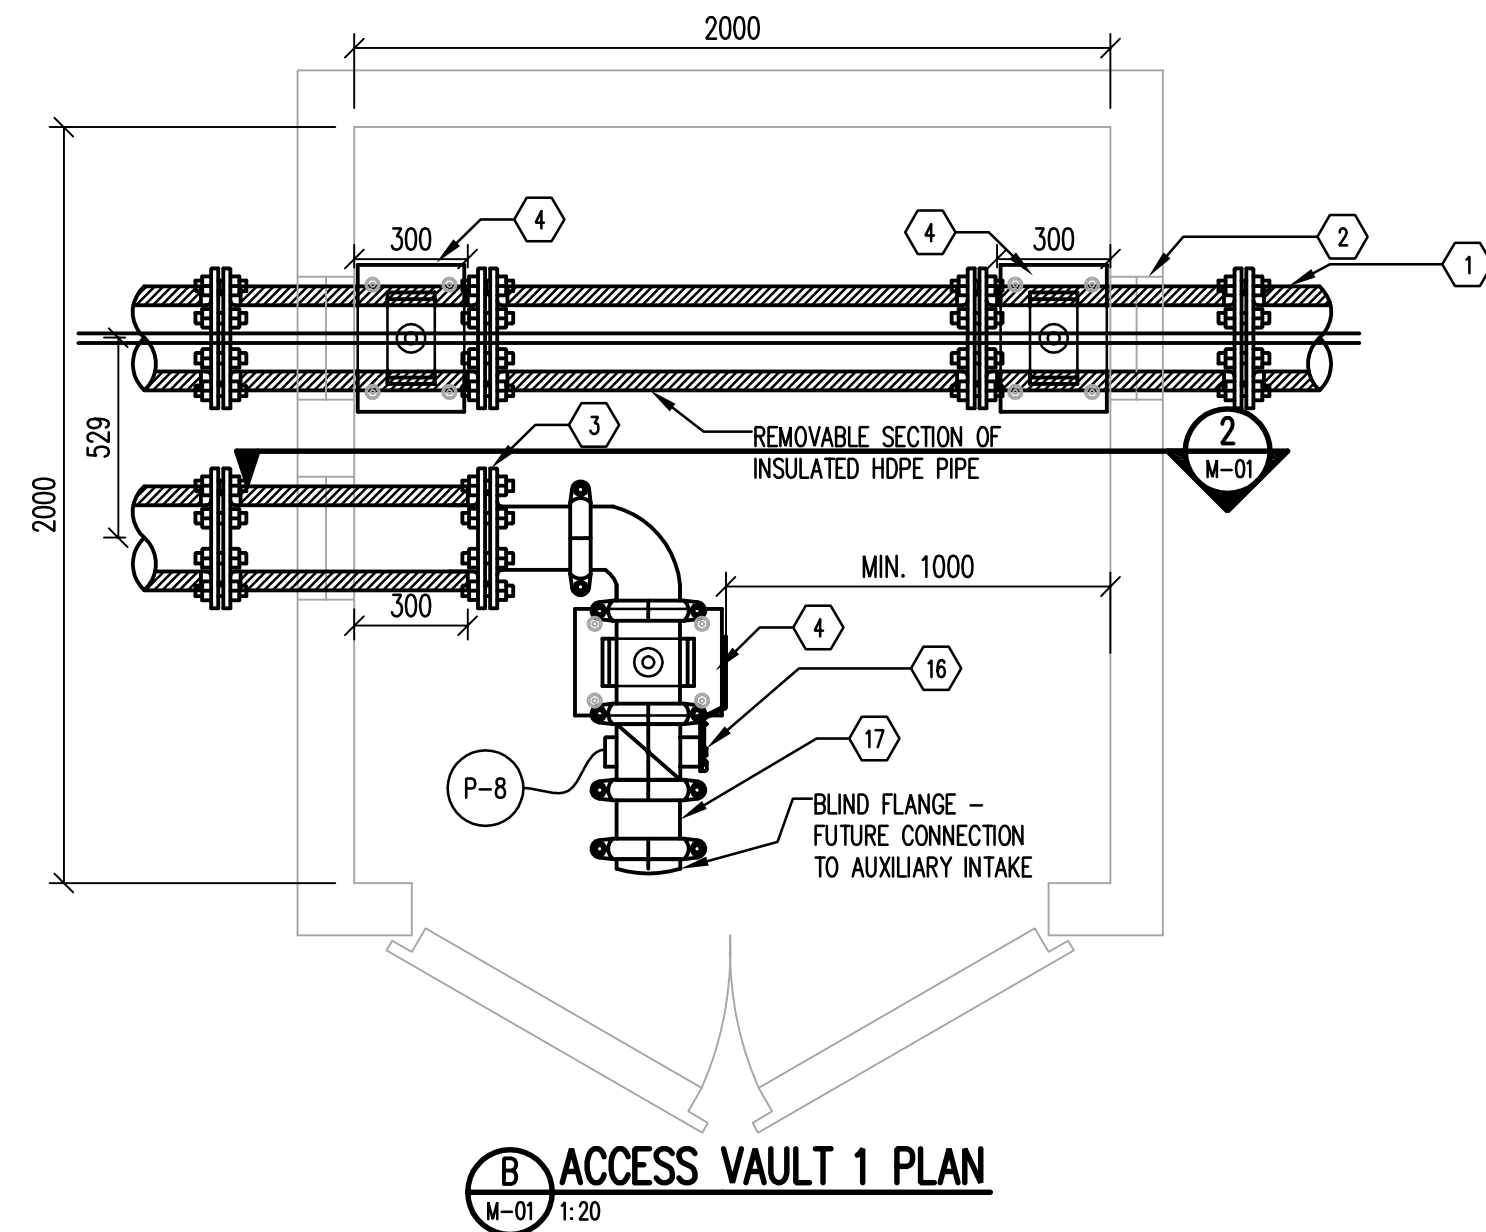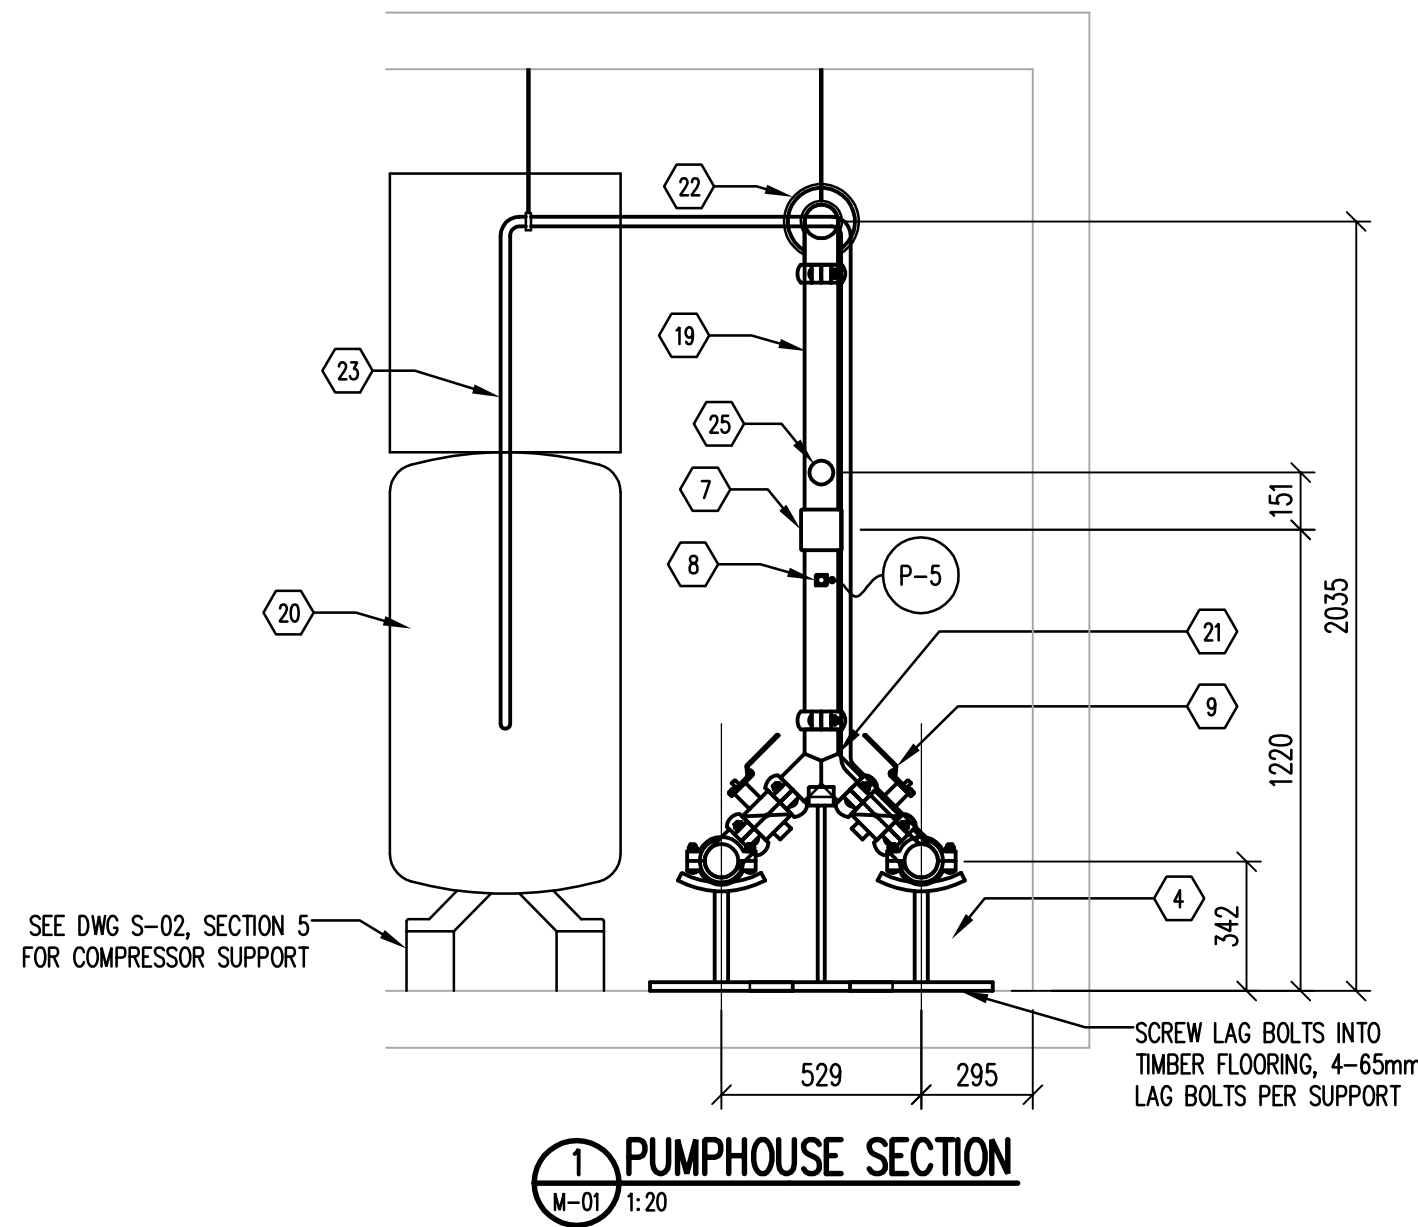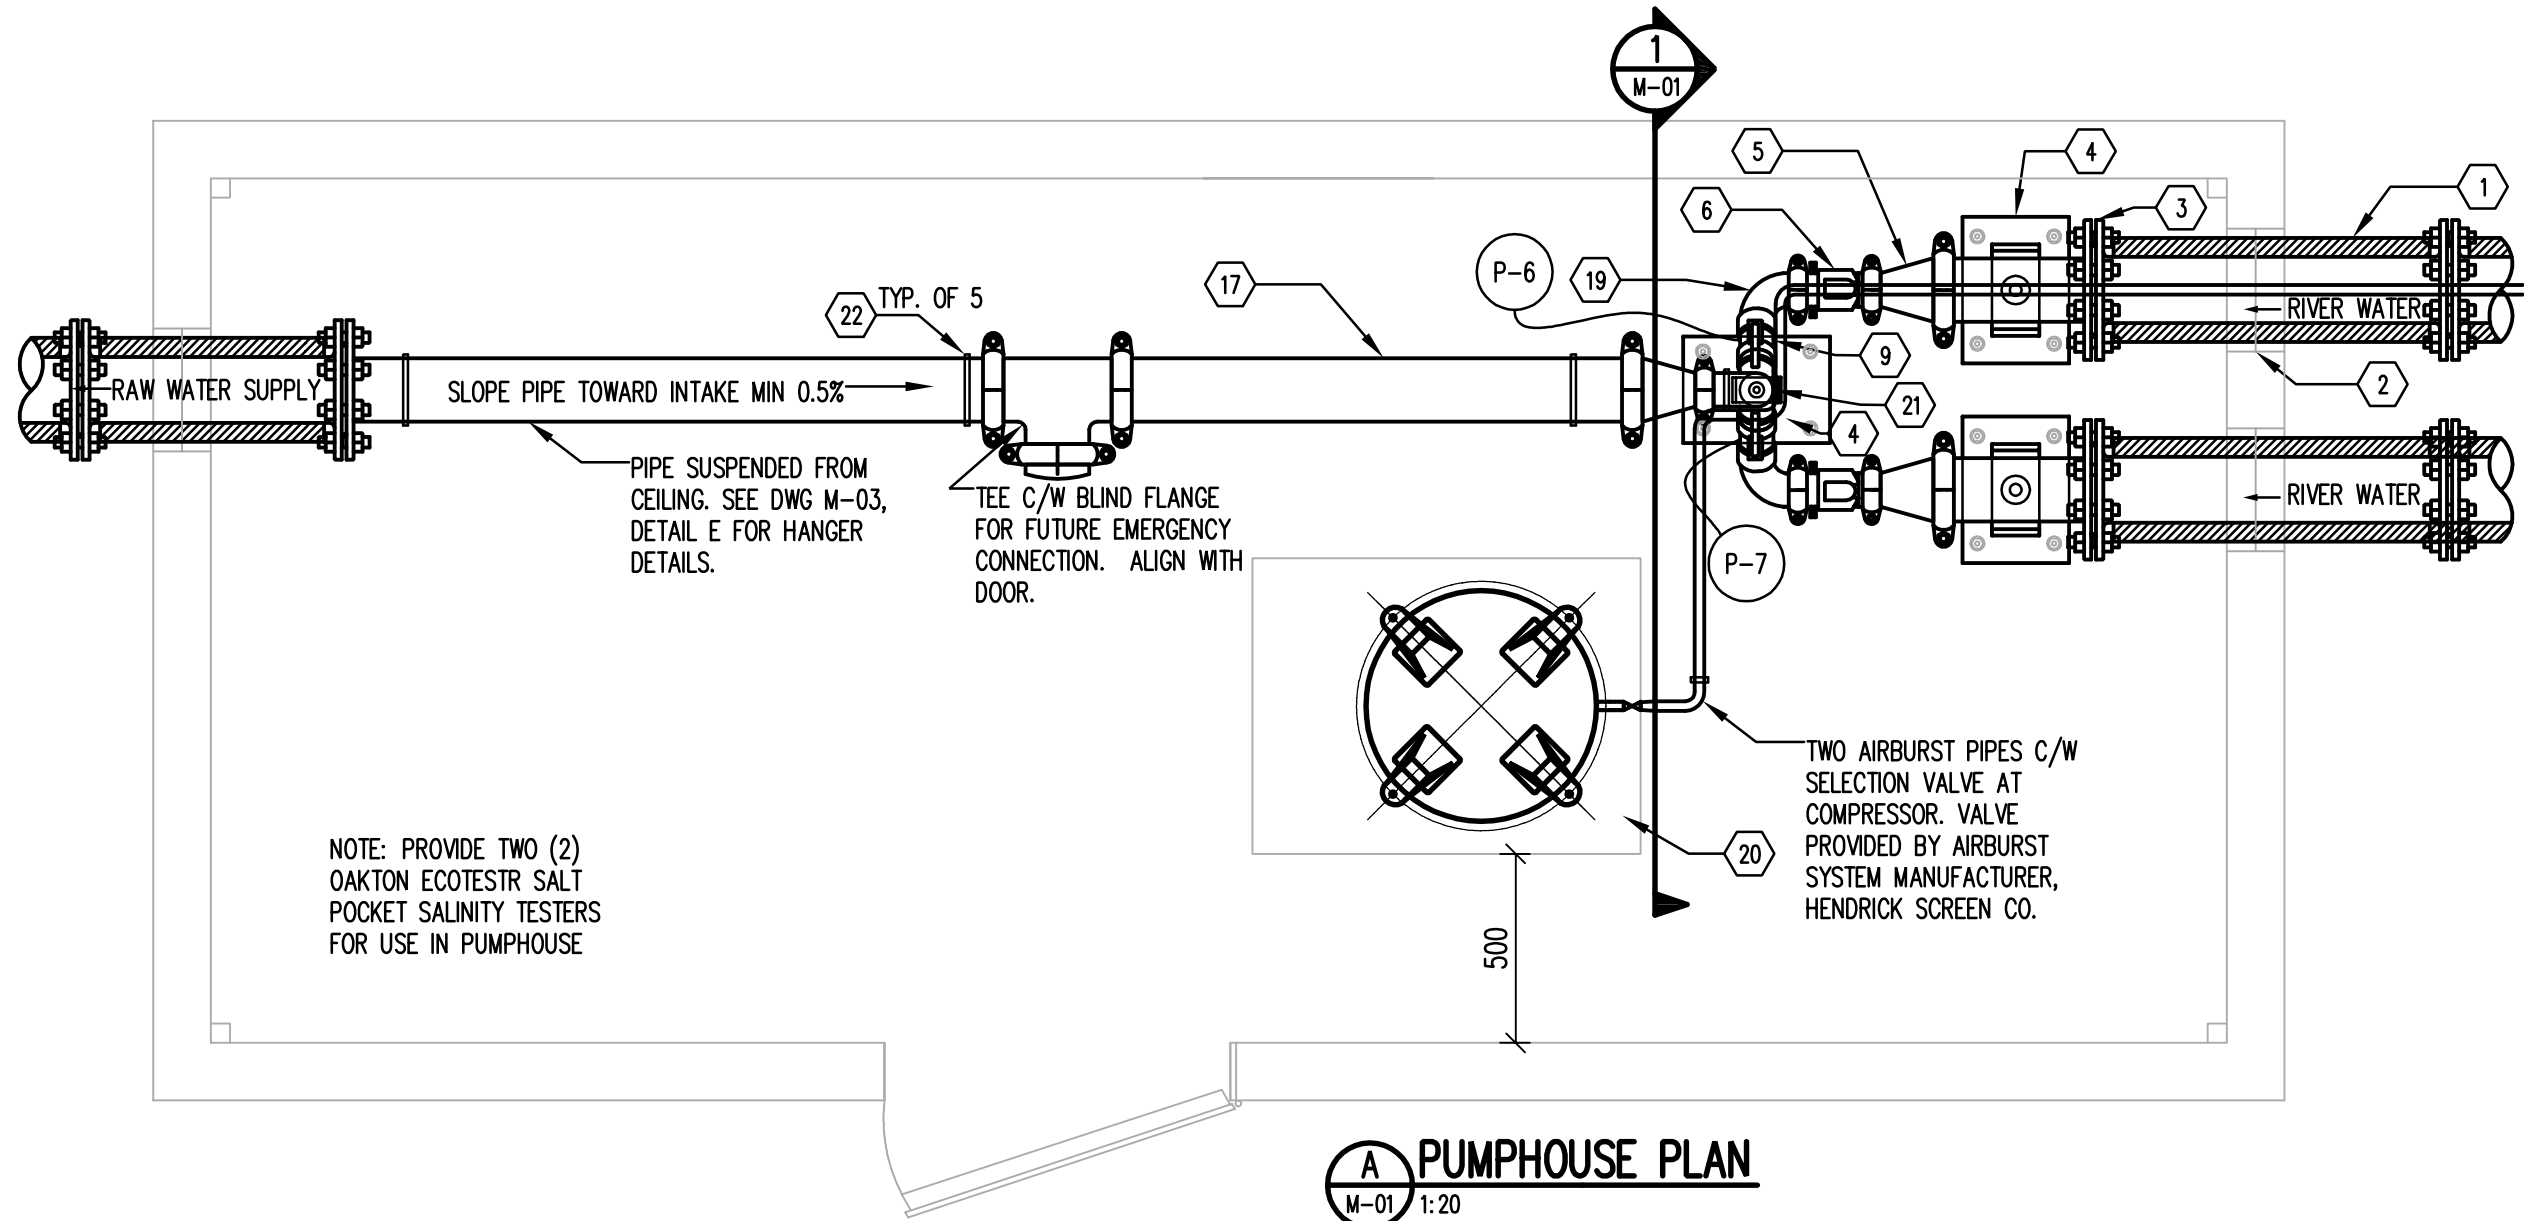

VALVE CHART			
TAG NUMBER	DESCRIPTION	PURPOSE	POSITION
P-1	BUTTERFLY VALVE	ISOLATE PIPELINE A	NO
P-2	BUTTERFLY VALVE	ISOLATE PIPELINE B	NO
P-3	TECH-TAYLOR VALVE	AUTOMATICALLY OPENS THE PIPELINE WHOSE PUMP IS OPERATING	-
P-4	BUTTERFLY VALVE	ISOLATE MAIN PIPELINE AT AV2	NO
P-5	1/4-TURN BALL VALVE	OBTAINING RAW WATER SAMPLES	NC
P-6	BUTTERFLY VALVE	ISOLATE MAIN PIPELINE	NO
P-7	BUTTERFLY VALVE	ISOLATE AUXILIARY PIPELINE	NO
P-8	BUTTERFLY VALVE	ISOLATE AUXILIARY PIPELINE AT AV1	NC

- KEYNOTES:**
- 150mm Ø HDPE DR9 PE3408 PIPE WITH 50mm RIGID POLYURETHANE INSULATION
  - WALL PENETRATION - SEE DWG M-02, DETAIL F
  - 150mm (6") Ø HDPE TO STEEL PIPE FLANGE ADAPTOR
  - PIPE SUPPORT
  - 150x75mm (6"x3") REDUCER
  - MANUAL FLOW METER: OF SIGNET 515 ROTOR-X PADDLEWHEEL FLOW SENSOR C/W OF SIGNET 8550 PROCESSPRO FLOW TRANSMITTER CONFIGURED TO SHOW FLOW RATE IN L/min AND TOTAL FLOW IN m³. PROVIDE MIN 10W SWITCHING POWER SUPPLY TO CONVERT 120VAC TO 12-24VDC TO SUPPLY BOTH FLOW METERS.
  - SALINITY METER: WALCHEM WEC410-1INDN, PUMP CUTOFF SETPOINT 1mS/cm (1000µS/cm)
  - SAMPLE POINT - 25mm QUARTER-TURN GLOBE VALVE, SEE DWG M-01, DETAIL D
  - 75mm (3") Ø BUTTERFLY VALVE SHUT OFF
  - TECH-TAYLOR VALVE
  - 100mm HDPE DR9 PE3408 CARRIER PIPE FROM RIVER ENCLOSED IN 355mm DR41 CASING PIPE WITH 50mm RIGID POLYURETHANE INSULATION
  - 100mm (4") Ø HDPE TO STEEL PIPE FLANGE ADAPTOR
  - 100mm (4") Ø BUTTERFLY VALVE
  - 6"x4" (150x100mm) REDUCER

- PIPE ROLLER SUPPORT STAND - SEE DWG S-03, DETAIL D
- 150mm (6") Ø BUTTERFLY VALVE
- 150mm (6") SCHEDULE 40 STEEL PIPE
- 100mm (4") SCHEDULE 40 STEEL PIPE
- 75mm (3") SCHEDULE 40 STEEL PIPE
- COMPRESSOR FOR AIRBURST SYSTEM: INGERSOLL RAND 2475NS FULLY PACKAGED AIR COMPRESSOR W/ MANUAL CONTROL AS SOLD BY HENDRICK SCREEN COMPANY. REQUIRES CUSTOM ORDER W/ FEET ROTATED 45° FROM STANDARD MODEL TO LINE UP WITH SKID SUPPORTS, AND 208/3/60, 5 HP COMPRESSOR WITH THERMAL RELAY MOTOR PROTECTION.
- 75mm (3") WYE FITTING
- PIPE HANGER - SEE DWG M-03, DETAIL E
- 25mm (1") PEX PIPE WITH MINIMUM MAINTAINED PRESSURE RATING 200 PSIG. SUPPORT AS SHOWN ON DRAWINGS.
- 25mm (1") VAL-MATIC #801A WASTEWATER SINGLE-BODY COMBINATION VALVE. PIPE OUTLET TO LOCATION AWAY FROM ELECTRICAL AND MECHANICAL EQUIPMENT.
- MECHANICAL PRESSURE GAUGE: ASHCROFT 3005 LIQUID-FILLED GAUGE, RANGE 0-1725kPa (0-250 PSI) WITH CONNECTION ON BACK. INDICATION TO BE PRIMARY METRIC (Pa PREFERRED); SECONDARY PSI OR FT OF H₂O. INCLUDE PLUG C/W CHAIN. HANG PLUG FROM GAUGE TO BE USED IN CASE OF GAUGE REMOVAL.

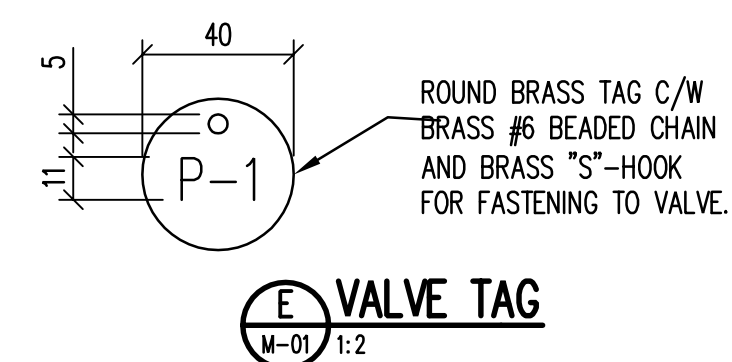

REVISIONS			
NO.	DESCRIPTION	DATE	BY
0	ISSUED FOR TENDER	2010.05.04	JG
1	ISSUED FOR CONSTRUCTION	2010.08.06	JG
2	RECORD DRAWING	2014.10.09	AC

**RECORD DRAWING**

DRAWINGS WERE BASED UPON INFORMATION SUBMITTED FROM OTHER PARTIES AND THE ENGINEER DOES NOT WARRANT OR CERTIFY THAT THE INFORMATION FROM THESE OTHER PARTIES IS ACCURATE.

DATE (YYYY MM DD): 2014.10.09

DRAWING NO. \_\_\_\_\_ DESCRIPTION \_\_\_\_\_

**REFERENCE DRAWINGS**

FOR BEST PLOTTING RESULTS, BE SURE TO USE WILLIAMS ENGINEERING CANADA AUTOCAD PLOT CONFIGURATION FILES AVAILABLE FROM: [www.williamsengineering.com](http://www.williamsengineering.com)

**LEGEND**

SECTION # \_\_\_\_\_ SOURCE / REFERENCE DWG. \_\_\_\_\_

DETAIL # \_\_\_\_\_ SOURCE / REFERENCE DWG. \_\_\_\_\_

INFORMATION CONTAINED ON THIS DRAWING IS COPYRIGHTED AND HAS BEEN PREPARED FOR THE SOLE PURPOSE OF THIS PROJECT. UNAUTHORIZED USE OF THIS INFORMATION WILL BE CONSIDERED A BREACH OF COPYRIGHT AND MAY BE PURSUED AS SUCH. USE OF THIS INFORMATION FOR ANY OTHER PURPOSE OTHER THAN THIS PARTICULAR PROJECT IS AT THE RISK OF THE USER.

PERMIT STAMP:

PERMIT TO PRACTICE  
WILLIAMS ENGINEERING CANADA INC.  
PERMIT NUMBER  
P 646  
NWT/NJ Association of Professional Engineers and Geoscientists

ENGINEER'S SEAL:

CLIENT:

YELLOWKNIFE OFFICE  
P.O. Box 1059  
4800 67 Street  
Yellowknife, NT X1A 2P2  
Bus: (867) 873-2365  
Tel Fax: 1-800-293-2363  
Fax: (867) 873-2667  
info@williamsengineering.com  
www.williamsengineering.com

**WILLIAMS ENGINEERING CANADA**

**Nunavut**

**WATER SUPPLY IMPROVEMENTS PHASE 1 NEW INTAKE AND PUMPHOUSE KUGLUKTUK, NU**

DWG. TITLE: **PUMPHOUSE AND ACCESS VAULTS PLANS AND SECTIONS**









OWN. BY:	DES. BY:	PROJ. MGR.:
CB/JG	JH/JG/JC	JH

PEER REVIEW:	DATE: (YY-MM-DD)	SCALE:
JH	2010.08.06	AS NOTED




CLIENT PROJ. #	WEC PROJ. #
GN PROJECT #04-4417	13655.00

**M-01** 2 of 1



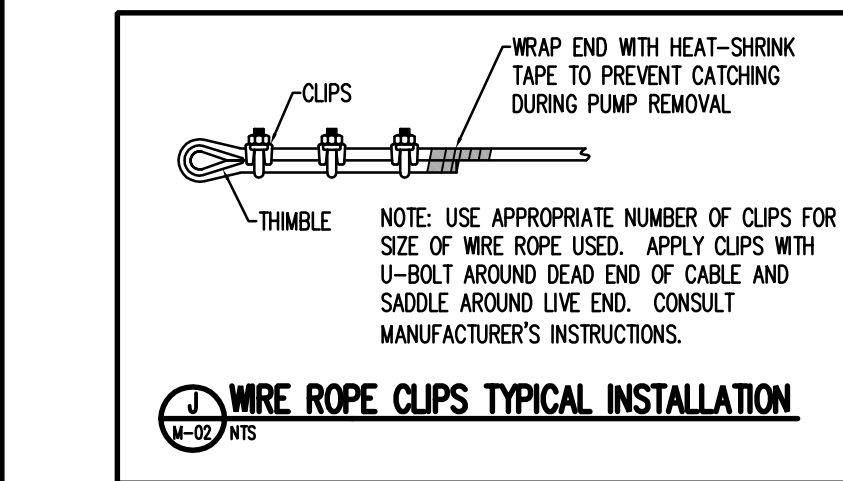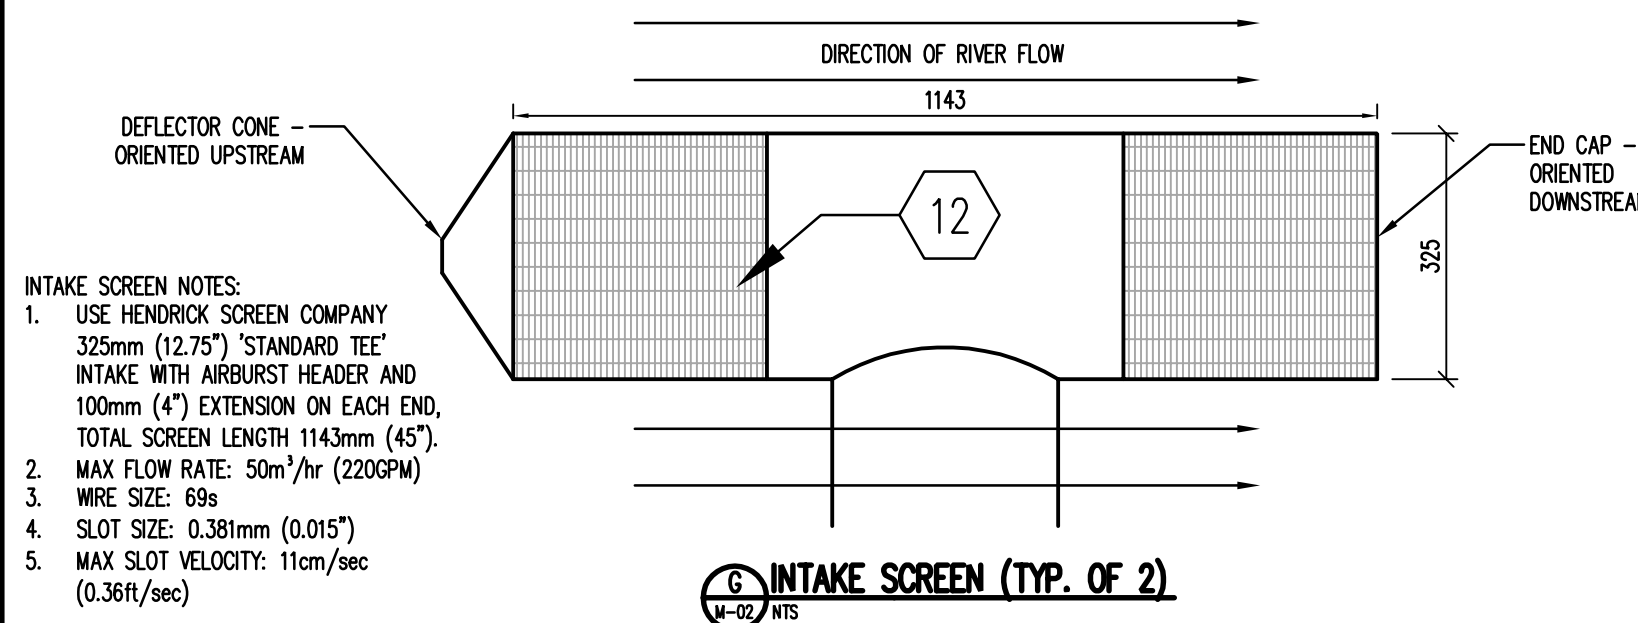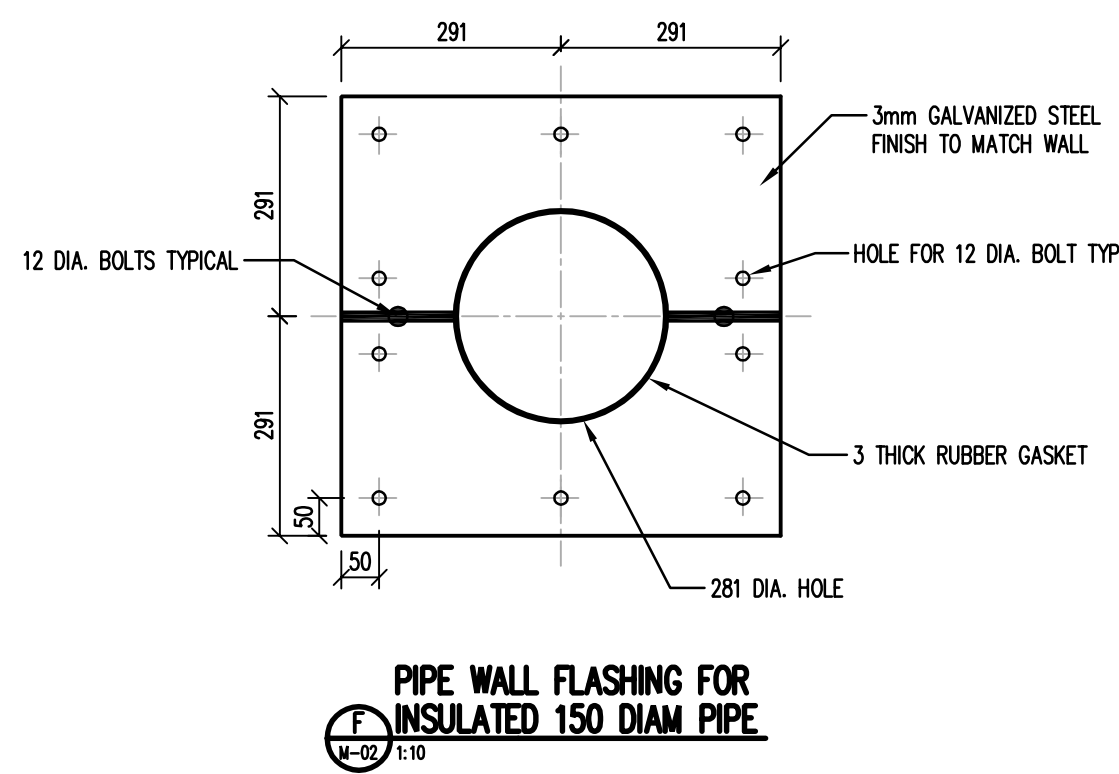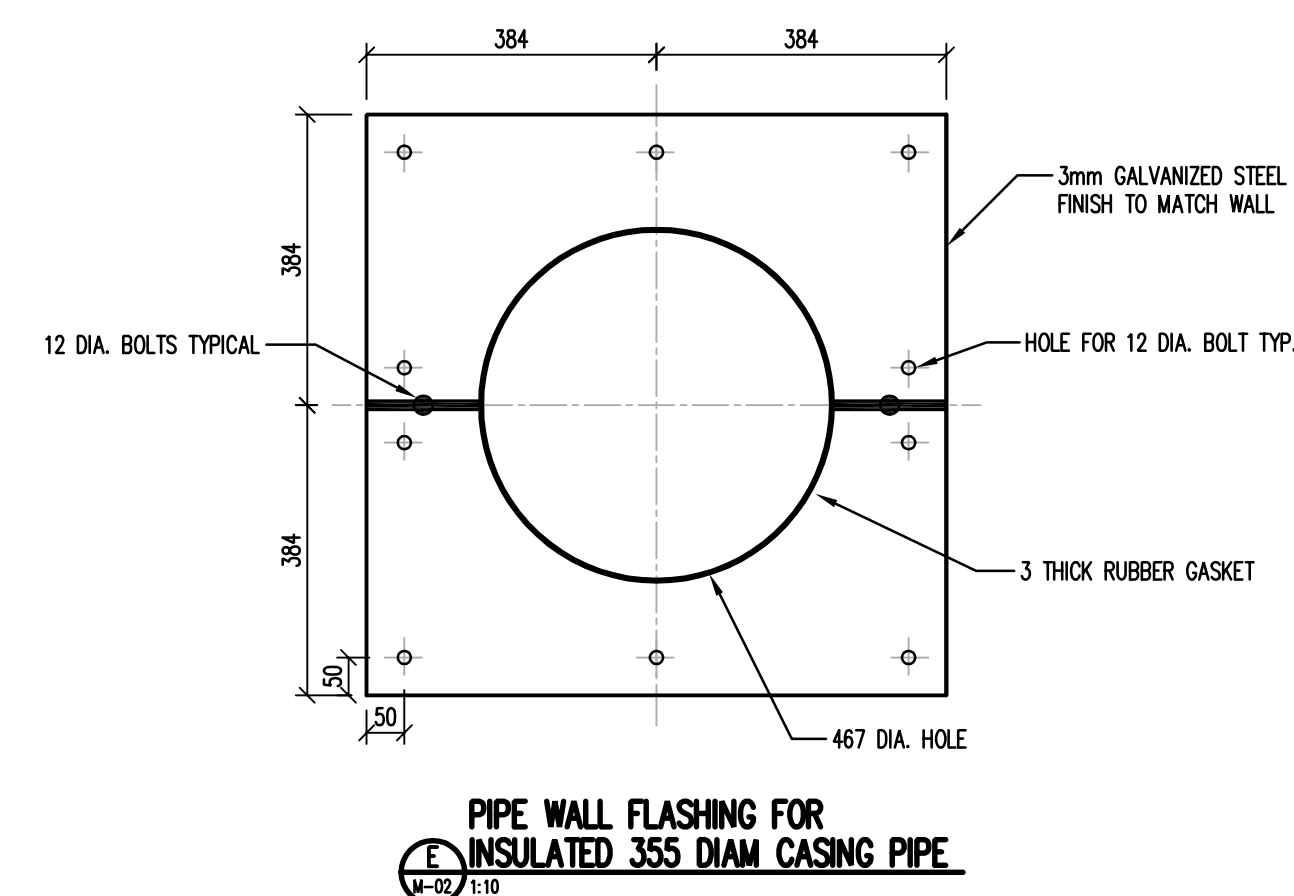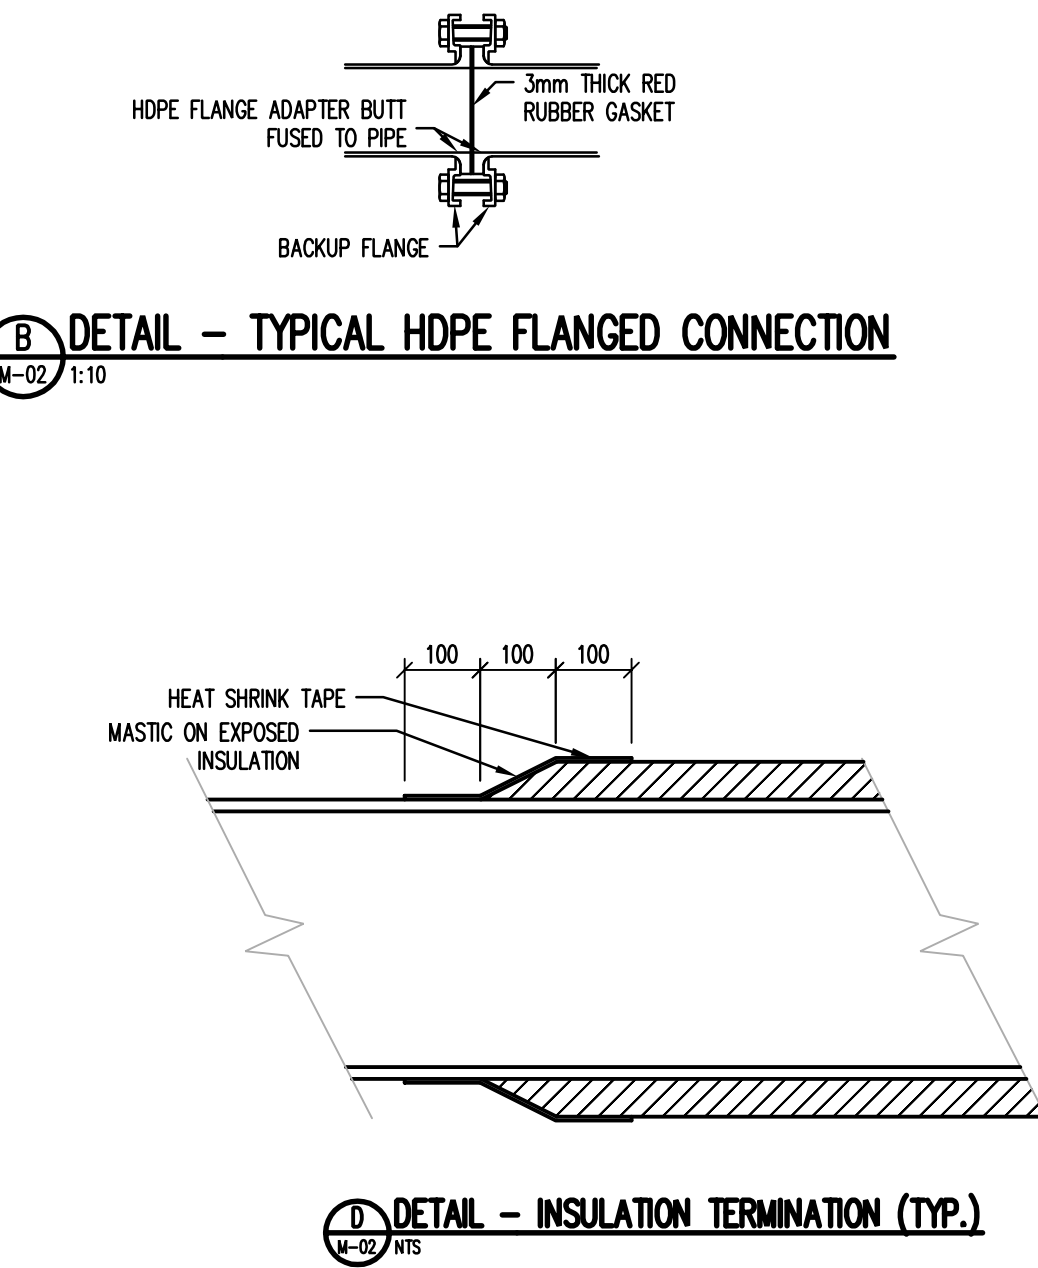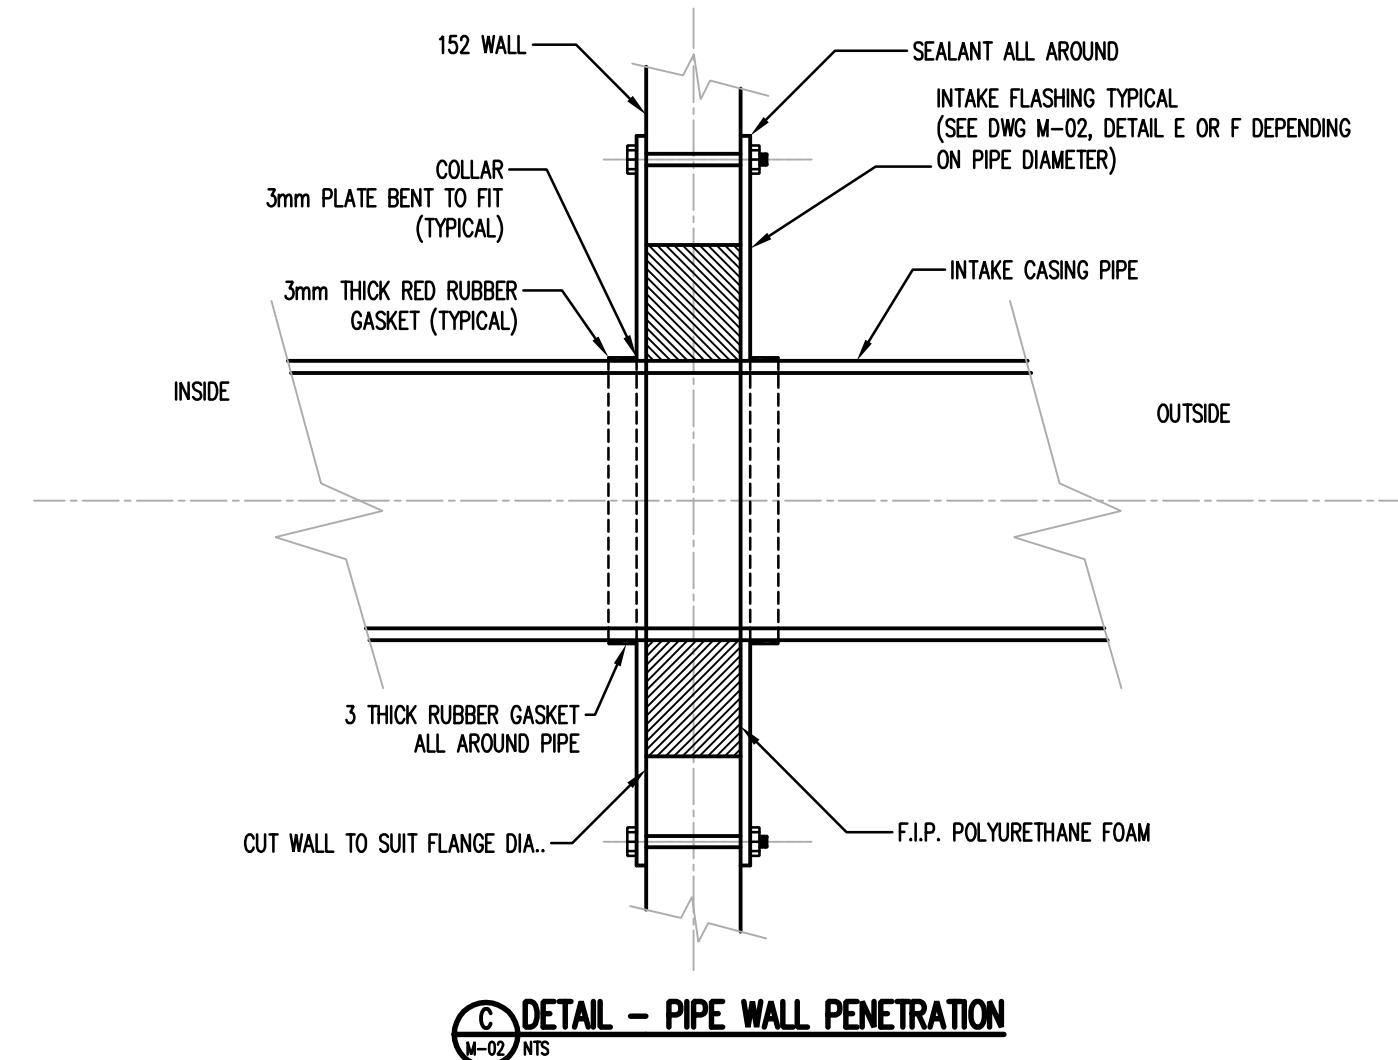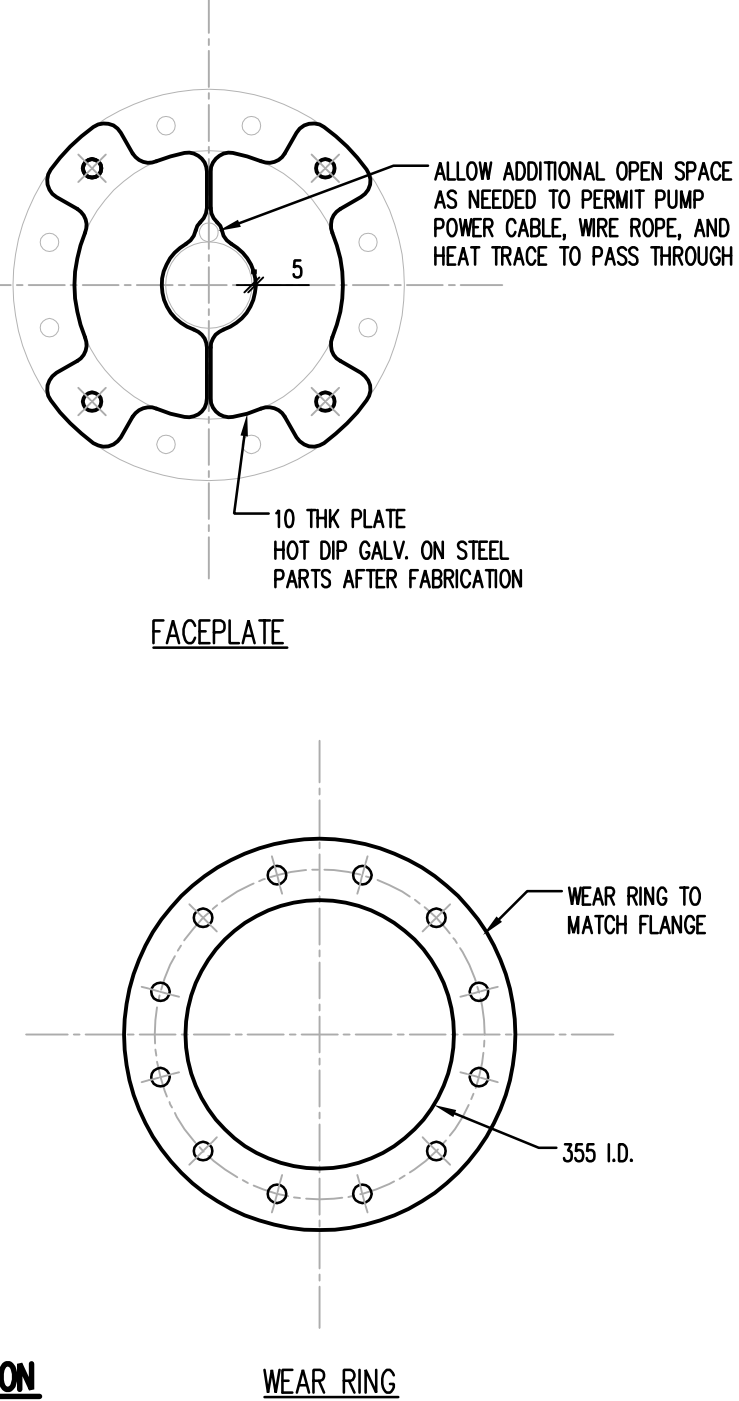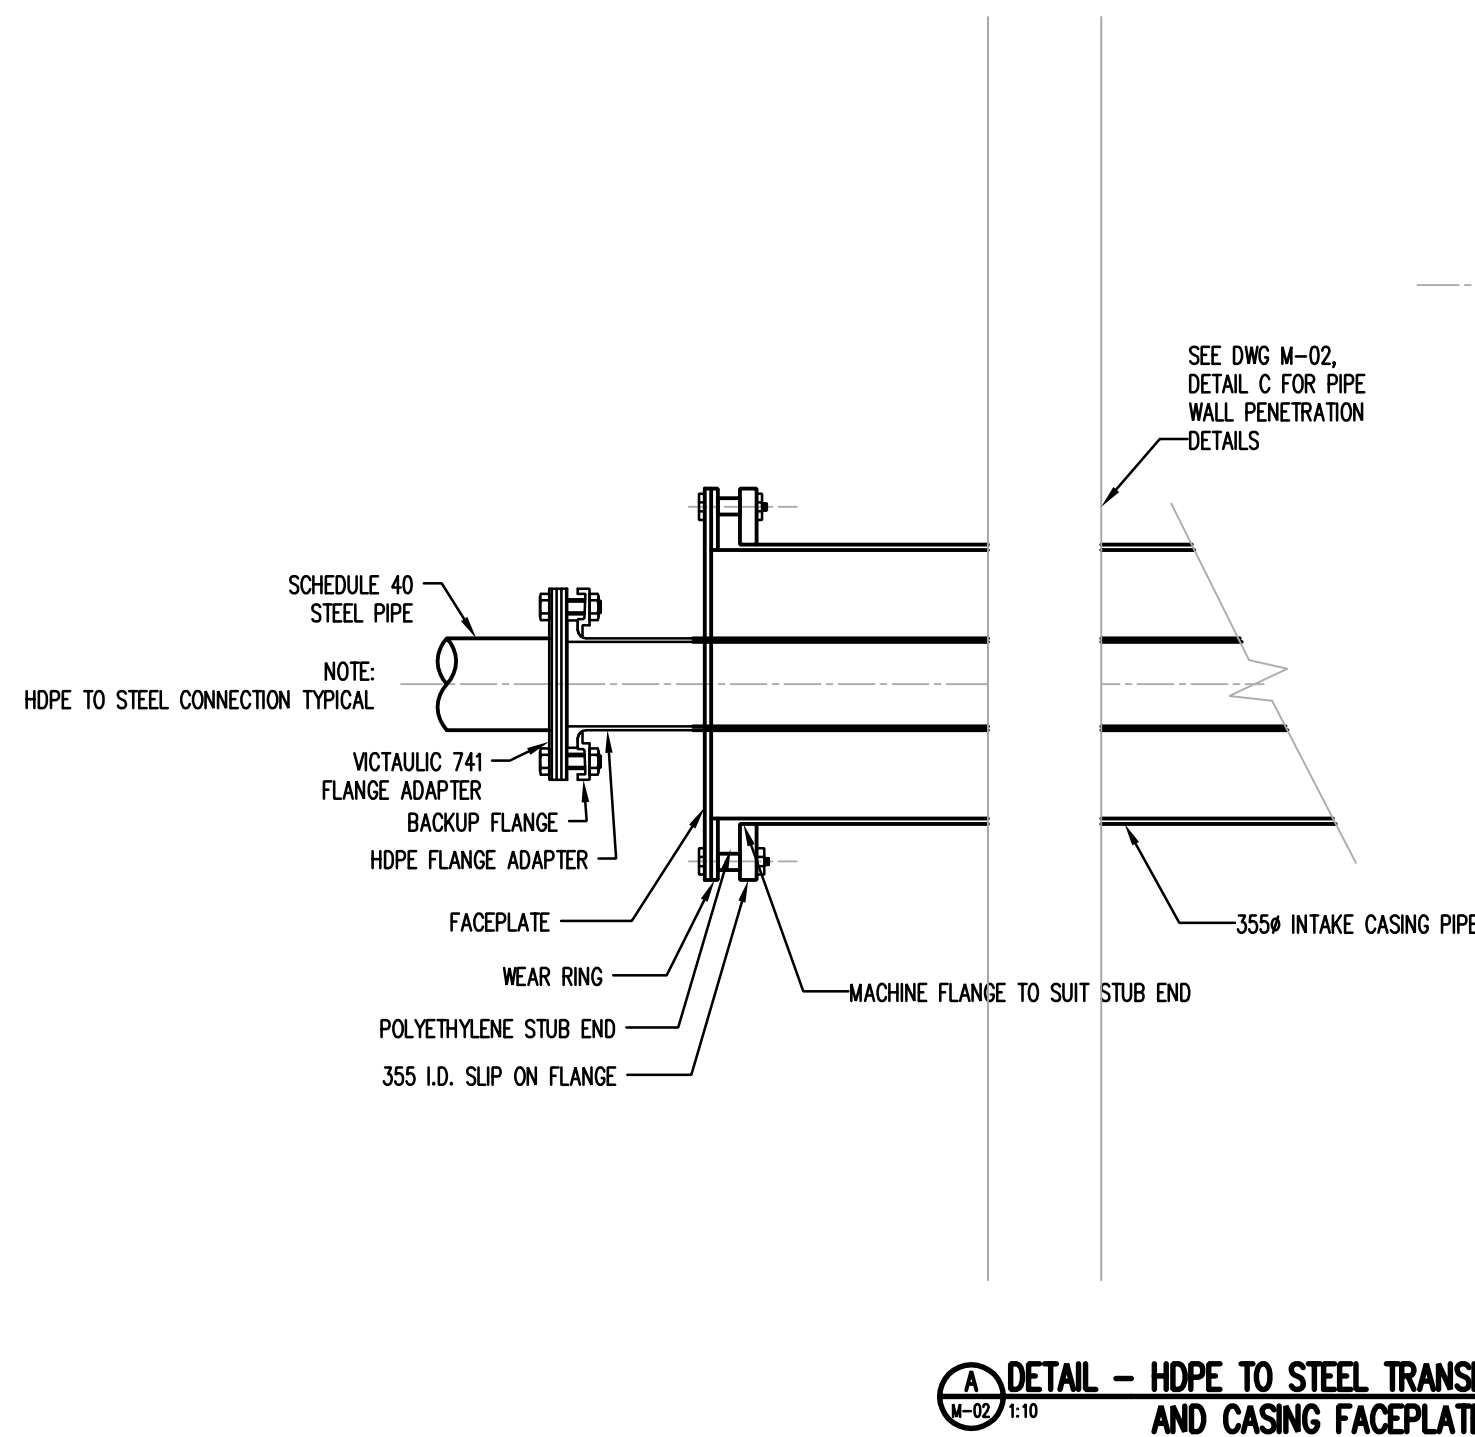

- KEYNOTES:**
- GRUNDFOS 150S150-6 15HP PUMP. REMOVE CHECK VALVE.
  - PUMP SLED BOTTOM ROD (4 x 25mm STAINLESS STEEL RODS TOTAL) WELDED TO 4 STAINLESS STEEL HOUSING RINGS. RODS TO BE COVERED WITH PEX PIPE.
  - PUMP SLED HOUSING RING, CUT FROM 8" STAINLESS STEEL PIPE.
  - DRILLED HOLE THROUGH HOUSING RING WITH WELDED NUT TO PROVIDE CLAMPING BOLT TO BEAR DOWN ON RUBBER GASKET MATERIAL STRIP WRAPPED AROUND PUMP (IN 4 LOCATIONS PER RING). ALL HARDWARE TO BE STAINLESS STEEL.
  - PUMP ELECTRICAL CABLE - 30m LONG FACTORY INSTALLED WATERTIGHT 3/4" BAWG C/W GROUNDING CABLE
  - 75mm STEEL PIPE PUMP OUTLET - FLANGED STEEL TO HDPE TRANSITION, SEE DWG M-02, DETAIL A.
  - 75mm x 100mm HDPE PIPE REDUCER
  - HDPE SOCKET FUSION WELD PIPE COUPLING
  - STAINLESS STEEL CONNECTION EYE WELDED TO END OF PUMP SLED
  - 8.3mm S3 WIRE ROPE FOR PULL CABLE - SEE CONNECTION DETAIL J.
  - 355mm (14") CASING PIPE WITH 50mm INSULATION
  - HENDRICK SCREEN CO 325mm (12.75") STANDARD TEE INTAKE SCREENS (ONE LOCATED AT 3m BELOW WATER LEVEL OTHER AT 3.5m) - SEE DWG M-02, DETAIL G.
  - 150 LB BLIND FLANGE (H.D. GALV)
  - 355x300 RED. TEE SCH 30 HOT GALV. SEAMLESS STEEL
  - 355 HDPE PIPE TO 355 SCH 30 HOT GALV. SEAMLESS STEEL ADAPTOR FLANGE
  - 10mm x 0.7mm STAINLESS STEEL BAND (TYP. OF 2), MIN TENSILE STRENGTH 44kN, BOLTED TO CONCRETE BLOCK ON BOTH SIDES OF THE PIPELINE.

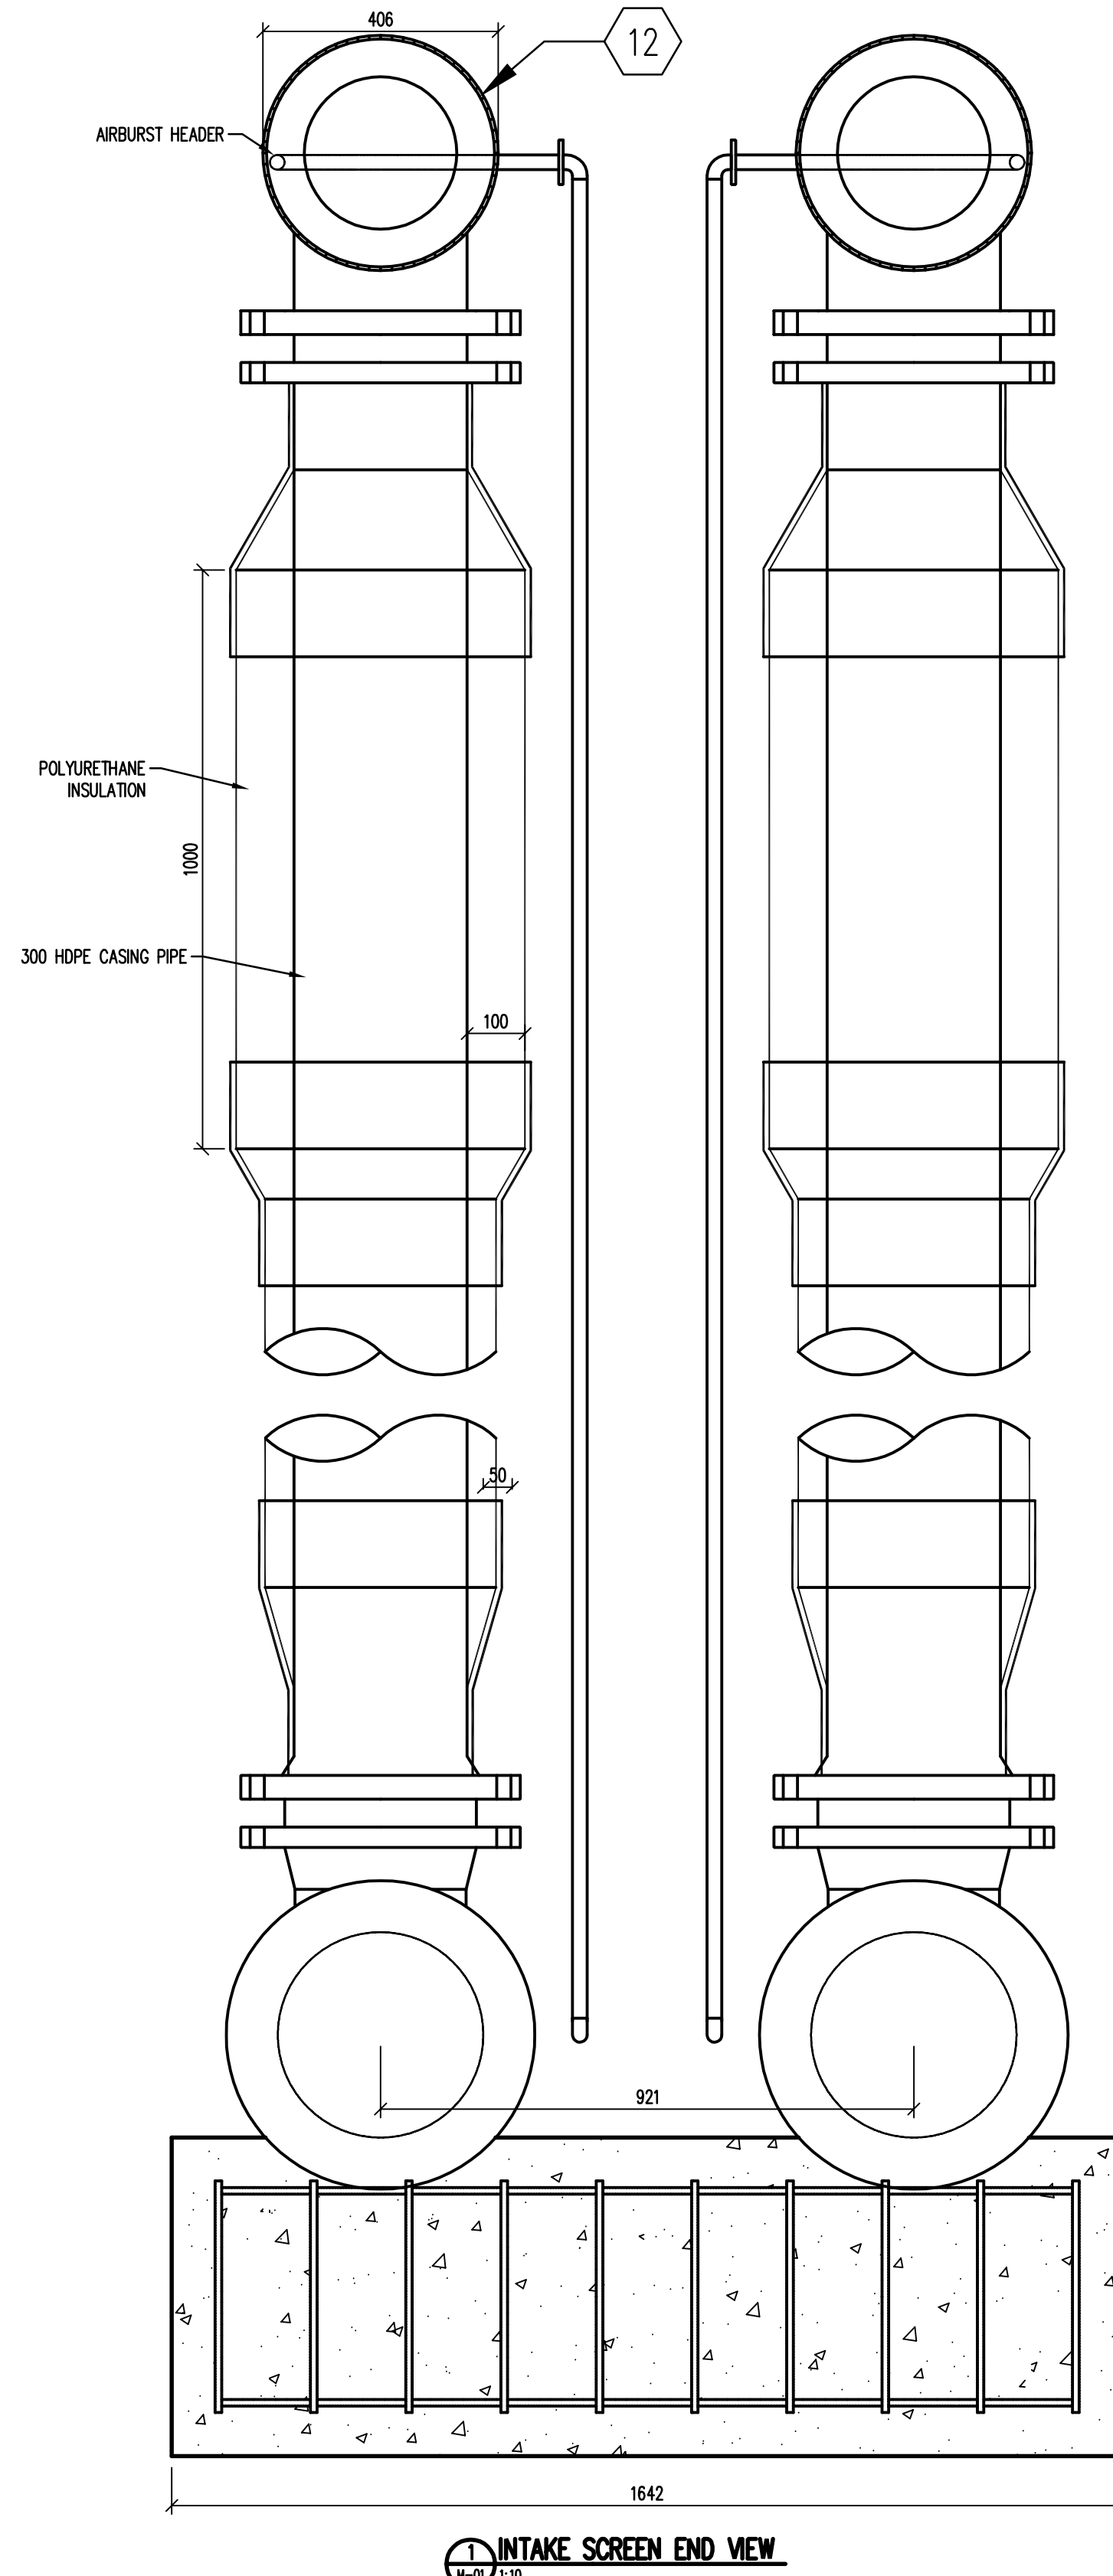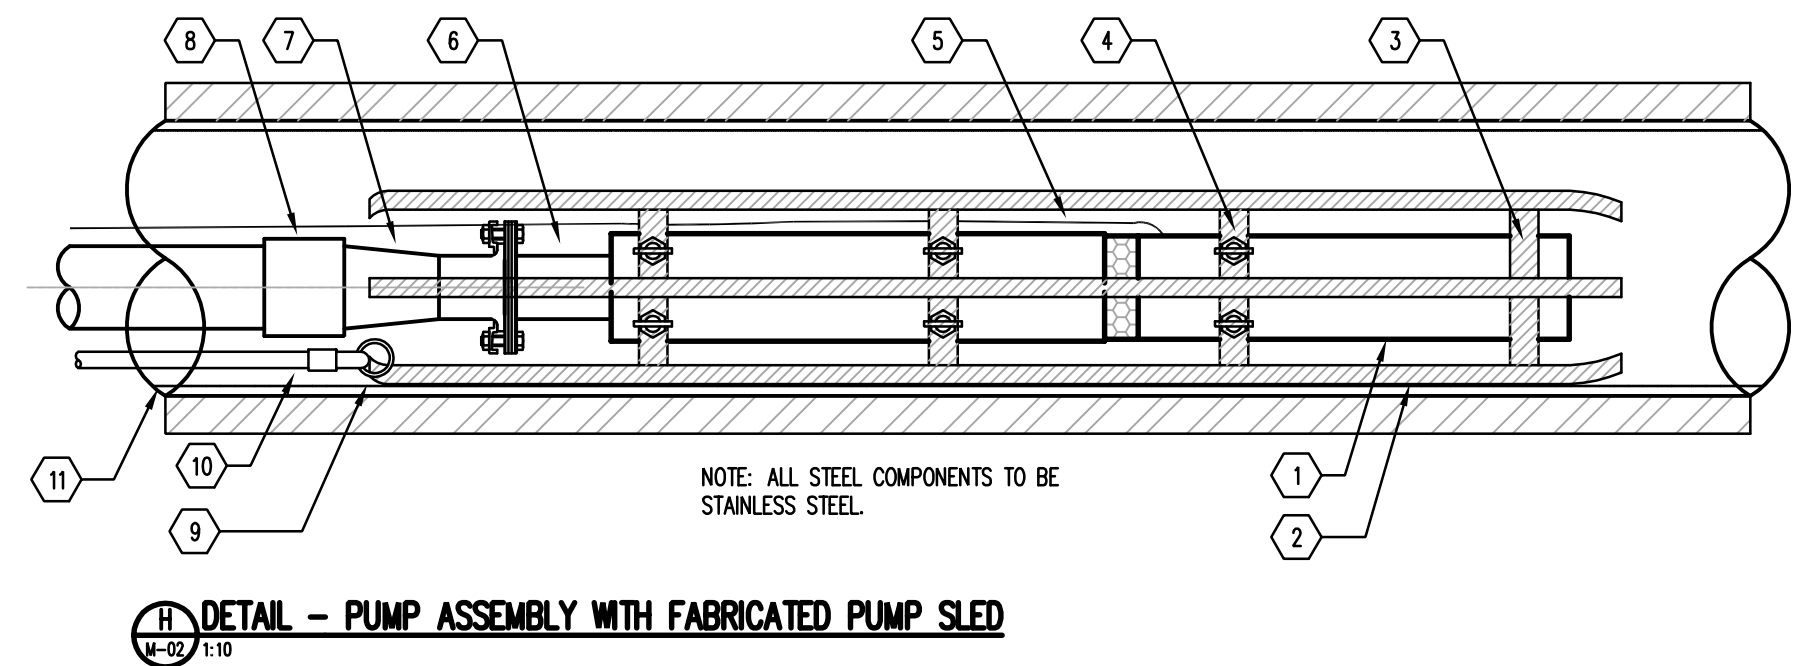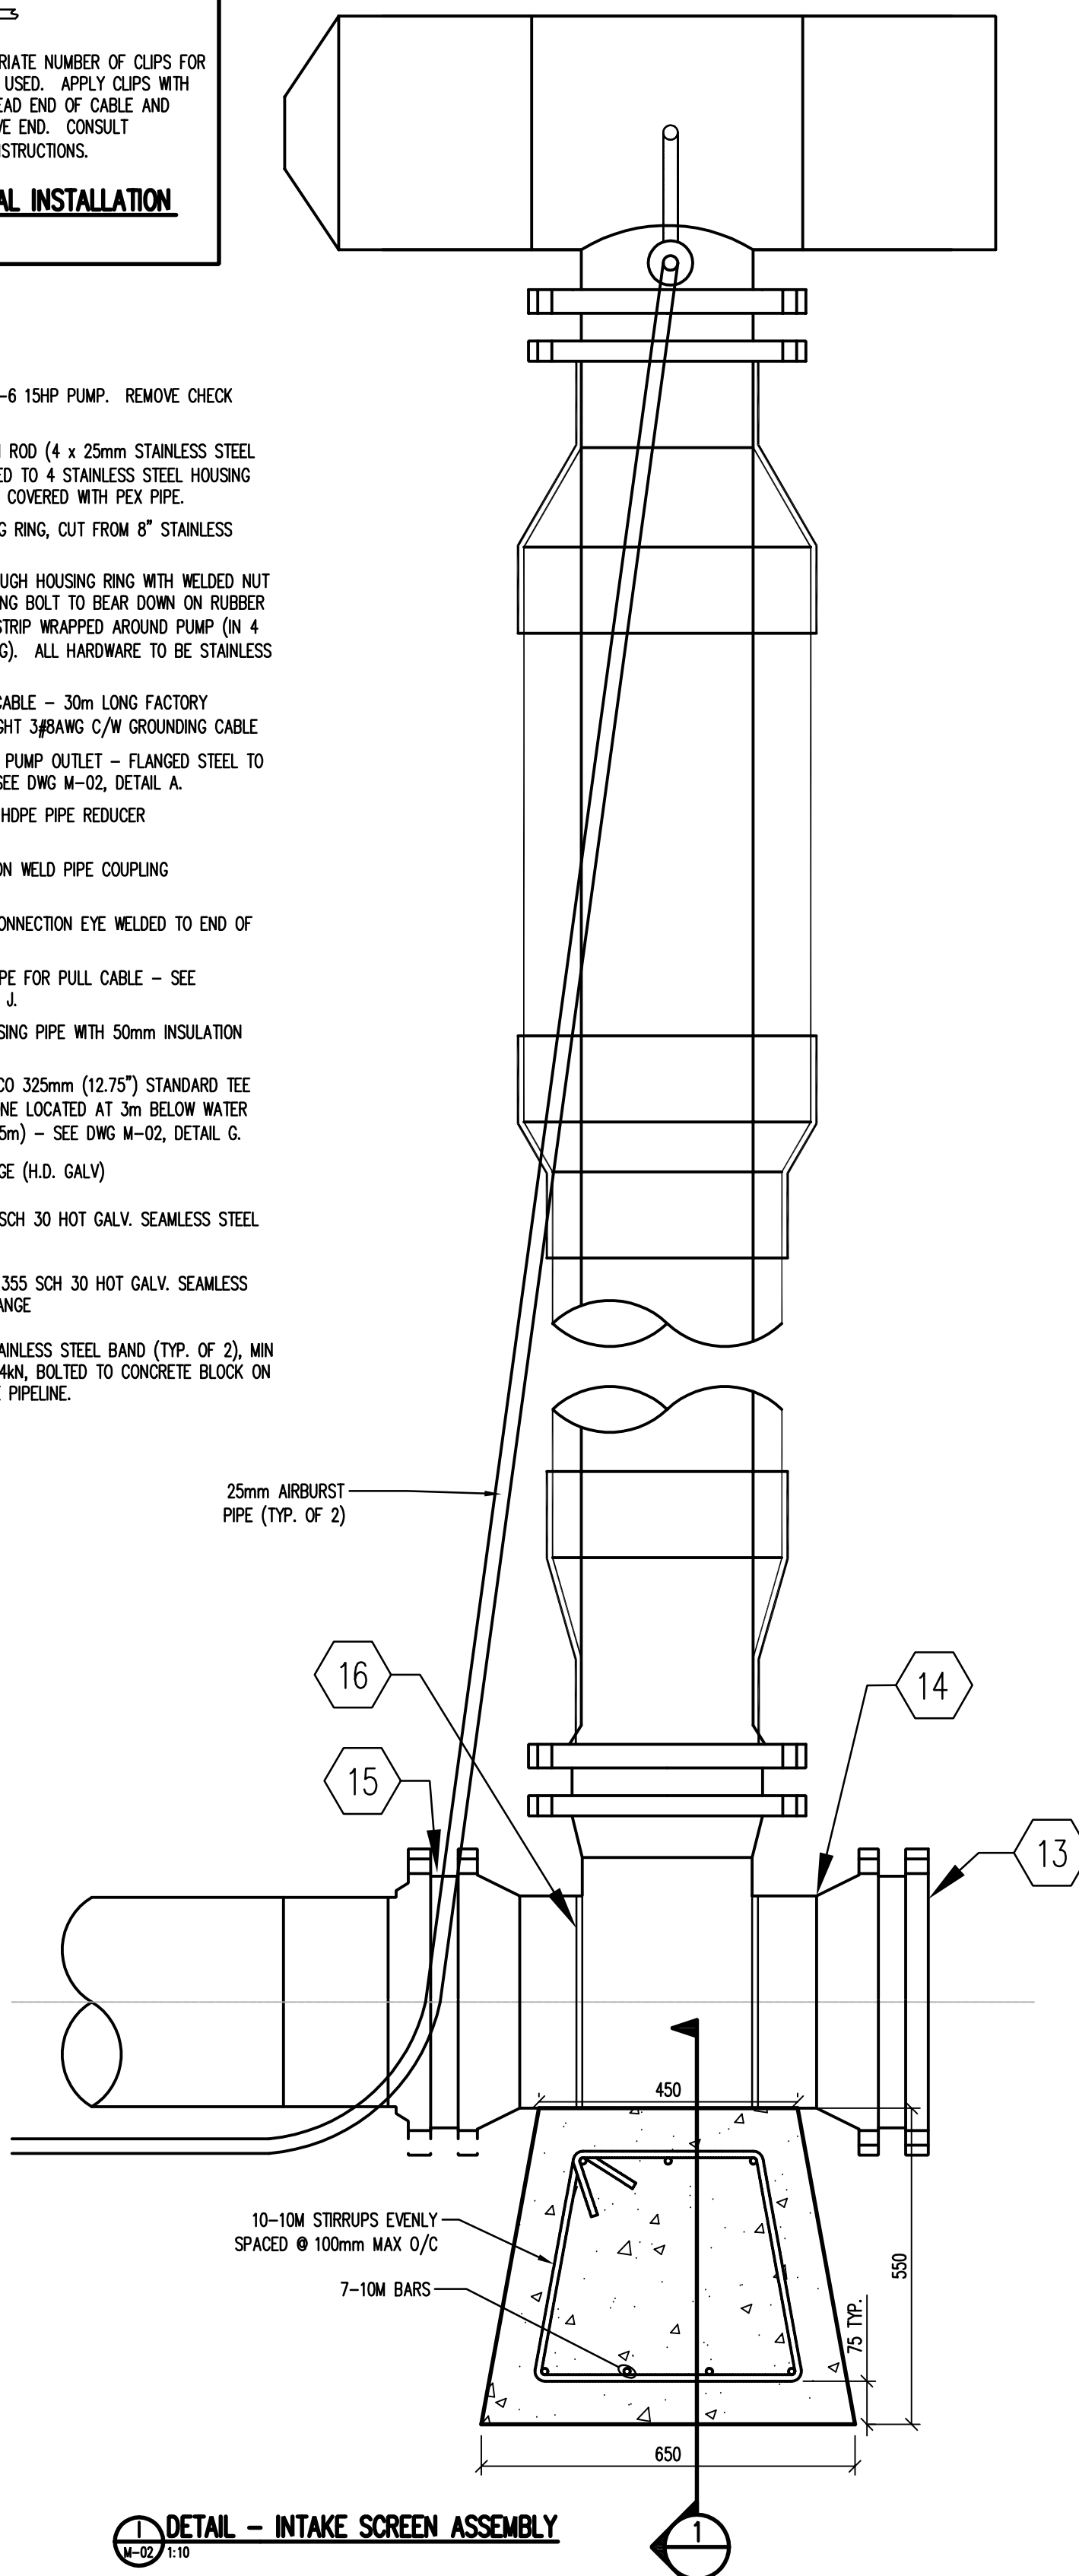

REVISIONS				
NO.	DESCRIPTION	DATE	BY	APP.
0	ISSUED FOR TENDER	2010.05.04	JG	JH
1	ISSUED FOR CONSTRUCTION	2010.08.06	JG	JH
2	RECORD DRAWING	2014.10.09	AC	

**RECORD DRAWING**  
DRAWINGS WERE BASED UPON INFORMATION SUBMITTED FROM OTHER PARTIES AND THE ENGINEER DOES NOT WARRANT OR CERTIFY THAT THE INFORMATION FROM THESE OTHER PARTIES IS ACCURATE.  
DATE (YYYY MM DD): 2014.10.09

**REFERENCE DRAWINGS**

FOR BEST PLOTTING RESULTS, BE SURE TO USE WILLIAMS ENGINEERING CANADA AUTOCAD PLOT CONFIGURATION FILES AVAILABLE FROM: [www.williamsengineering.com](http://www.williamsengineering.com)

**LEGEND**

SECTION # 1 A-001  
SOURCE / REFERENCE DWG.

DETAIL # 1 E-001  
SOURCE / REFERENCE DWG.

INFORMATION CONTAINED ON THIS DRAWING IS COPYRIGHTED AND HAS BEEN PREPARED FOR THE SOLE PURPOSE OF THIS PROJECT. UNAUTHORIZED USE OF THIS INFORMATION WILL BE CONSIDERED A BREACH OF COPYRIGHT AND MAY BE PURSUED AS SUCH. USE OF THIS INFORMATION FOR ANY OTHER PURPOSE OTHER THAN THIS PARTICULAR PROJECT IS AT THE RISK OF THE USER.

PERMIT STAMP:  
PERMIT TO PRACTICE  
WILLIAMS ENGINEERING CANADA INC.  
PERMIT NUMBER  
P 646  
NWT/NJ Association of Professional Engineers and Geoscientists

ENGINEER'S SEAL:

CLIENT:

YELLOWKNIFE OFFICE  
P.O. Box 1059  
4800 47 Street  
Yellowknife, NT X1A 2P2  
Bus: (867) 873-2386  
Tel Fax: 1-800-293-2383  
Fax: (867) 873-2547  
info@williamsengineering.com  
www.williamsengineering.com

**WILLIAMS ENGINEERING CANADA**

**WE**

**Nunavut**

**WATER SUPPLY IMPROVEMENTS PHASE 1 NEW INTAKE AND PUMPHOUSE KUGLUKTUK, NU**

**INTAKE PIPELINE DETAILS**

OWN. BY:	DES. BY:	PROJ. MGR.:
CB/JG	JH/JG/JC	JH


PEER REVIEW:	DATE:	SCALE:
JH	(Y-MM-DD) 2010.08.06	AS NOTED

CLIENT PROJ. #	CLIENT PROJ. #	REC PROJ. #
GN PROJECT #04-4417		13655.00


**M-02** 2 of 1






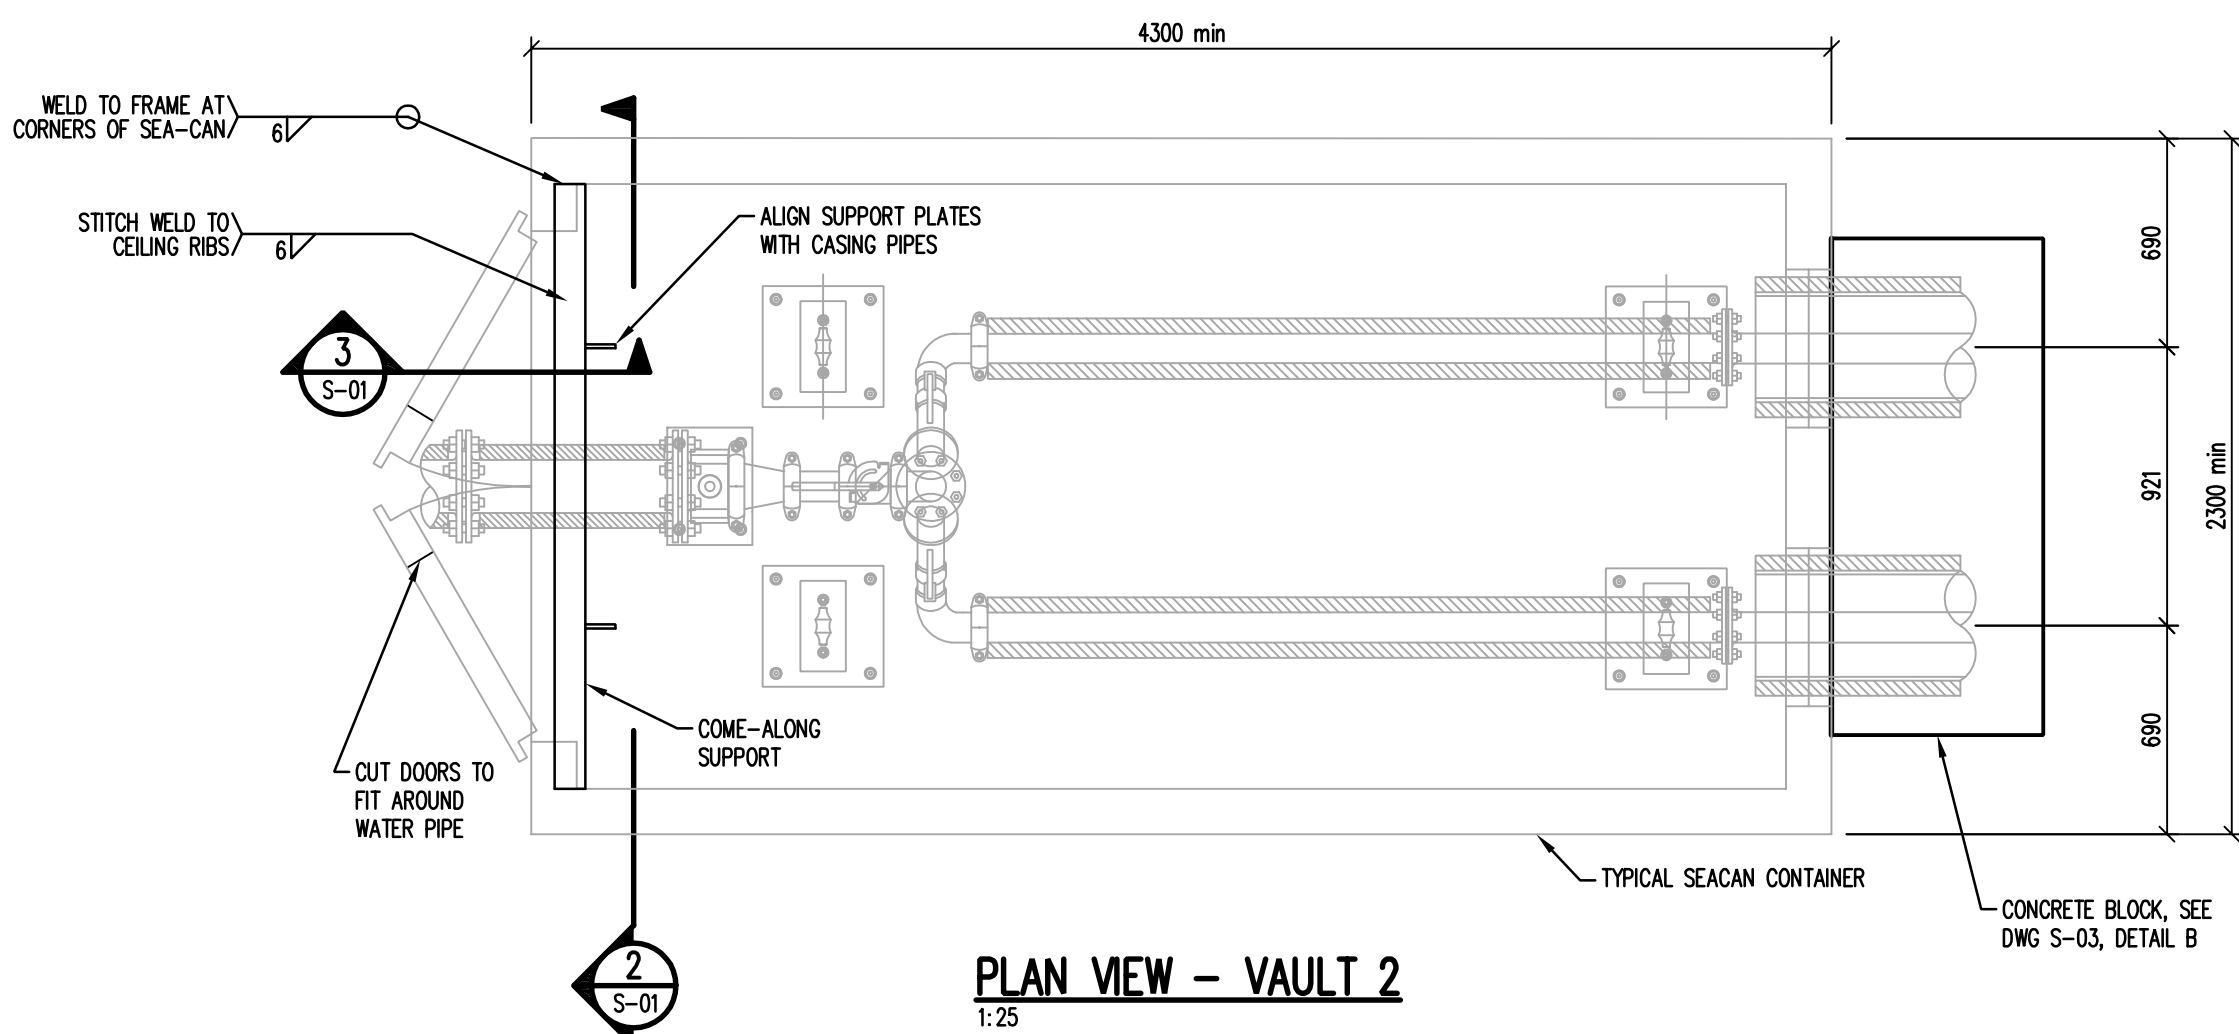


PLAN VIEW - VAULT 2  
1:25

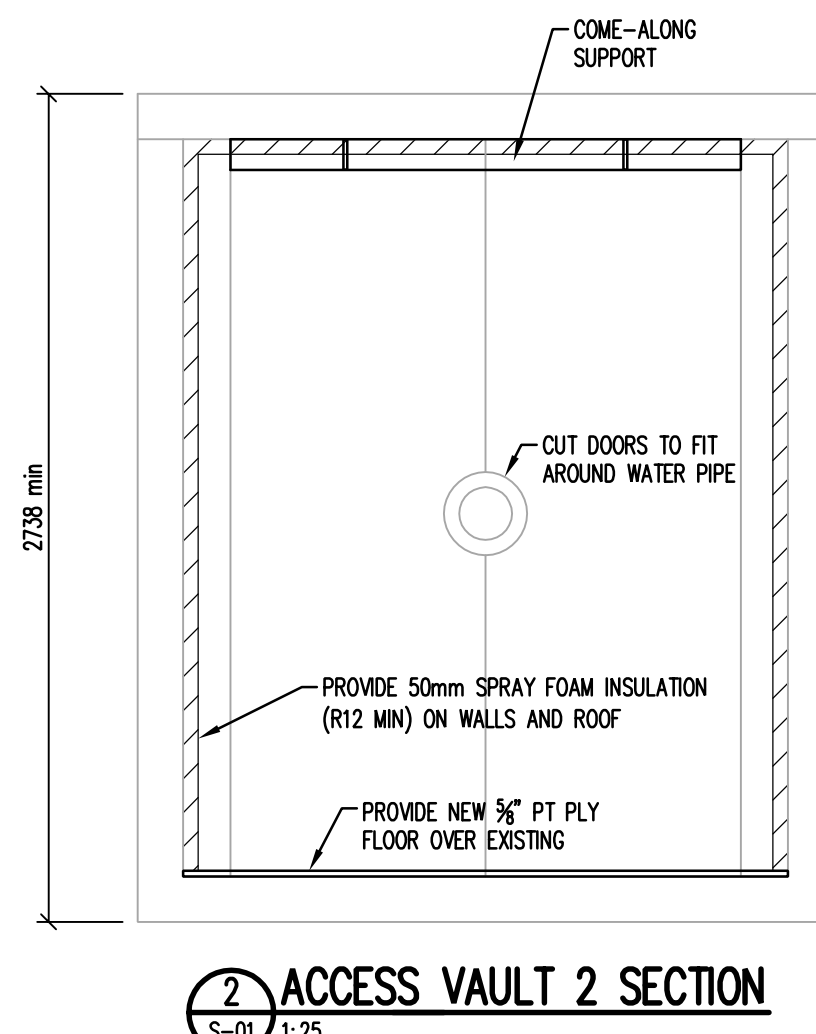


ACCESS VAULT 2 SECTION  
1:25

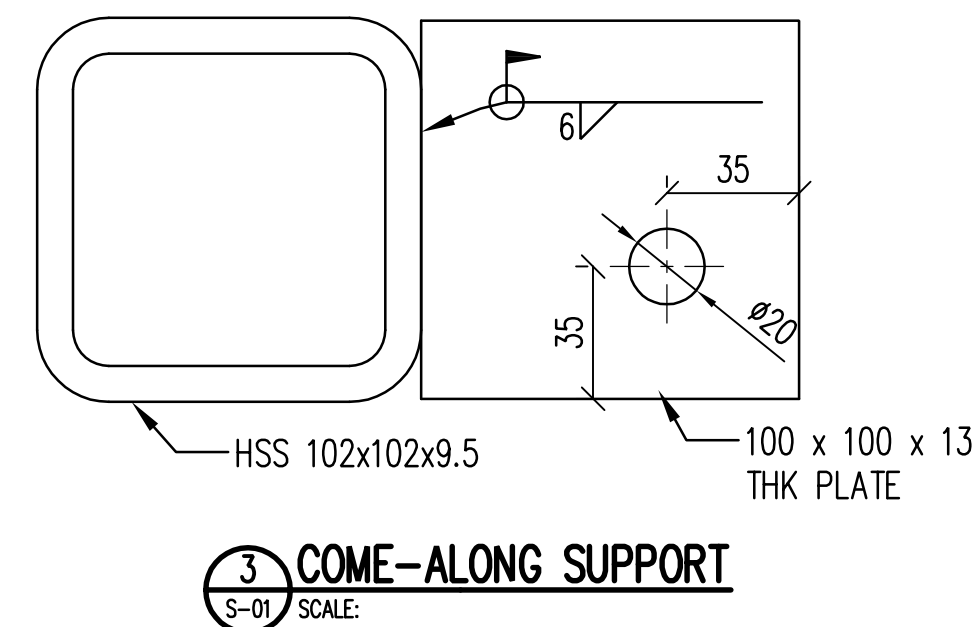


COME-ALONG SUPPORT  
SCALE:

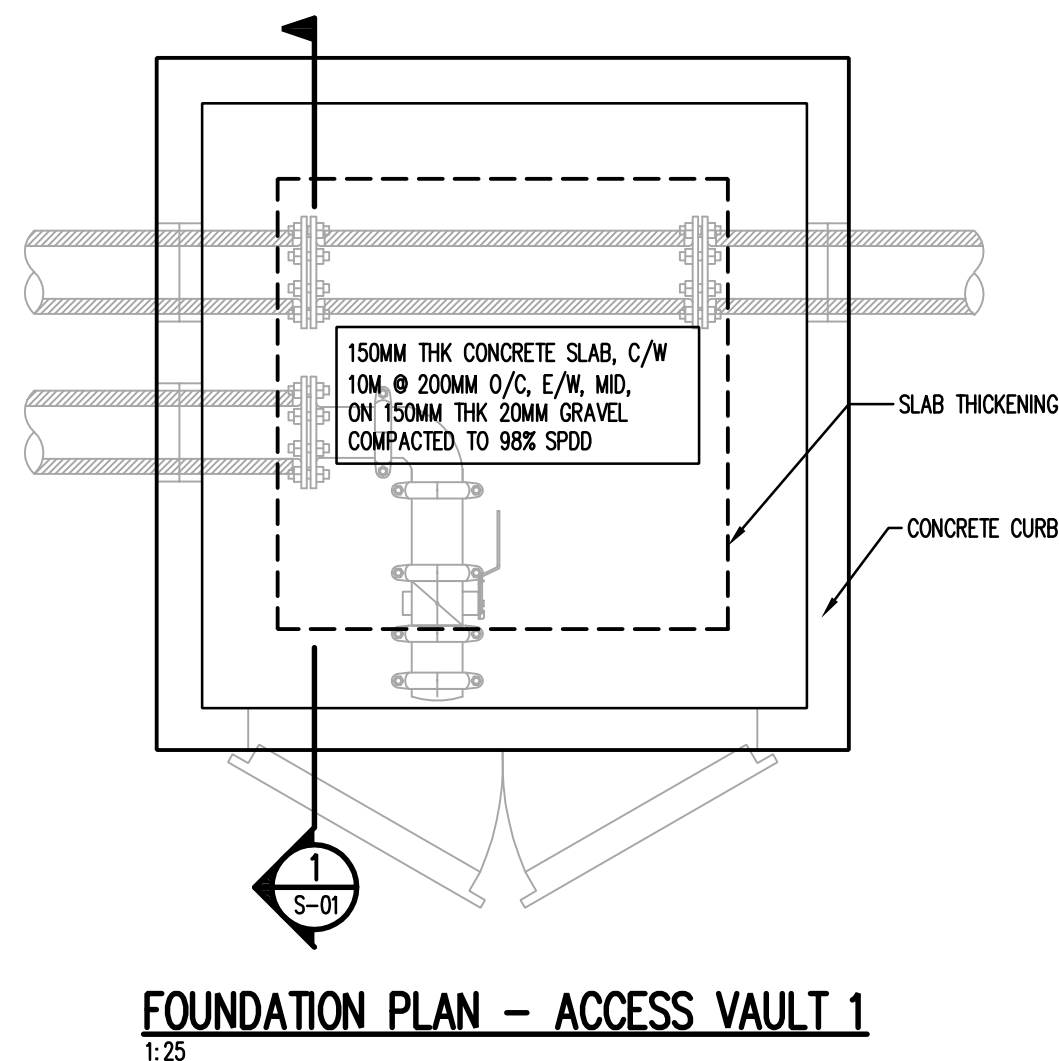


FOUNDATION PLAN - ACCESS VAULT 1  
1:25

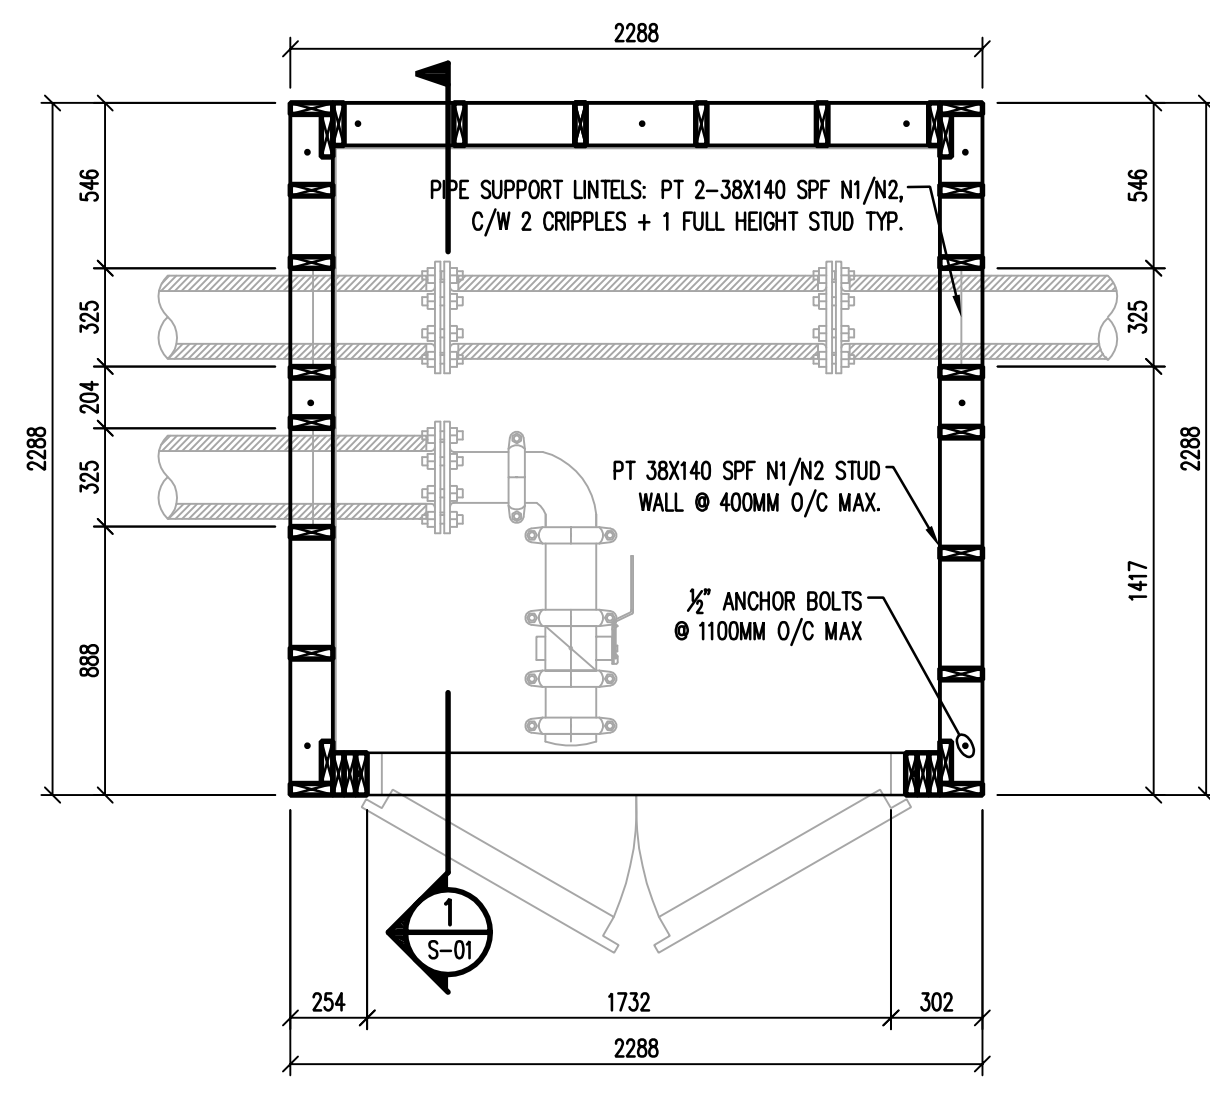

WALL FRAMING PLAN - ACCESS VAULT 1  
1:25

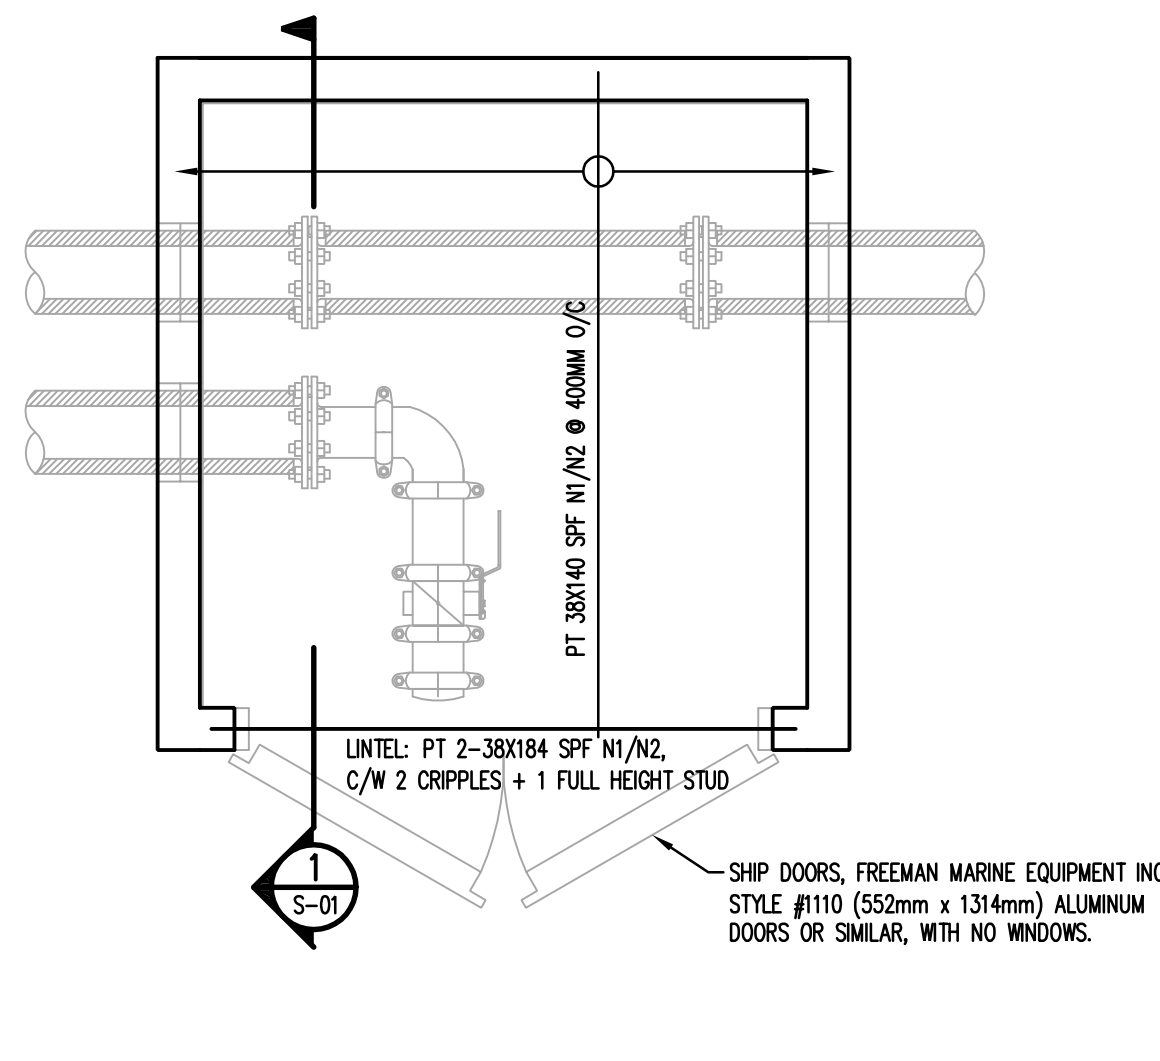

ROOF FRAMING PLAN - ACCESS VAULT 1  
1:25

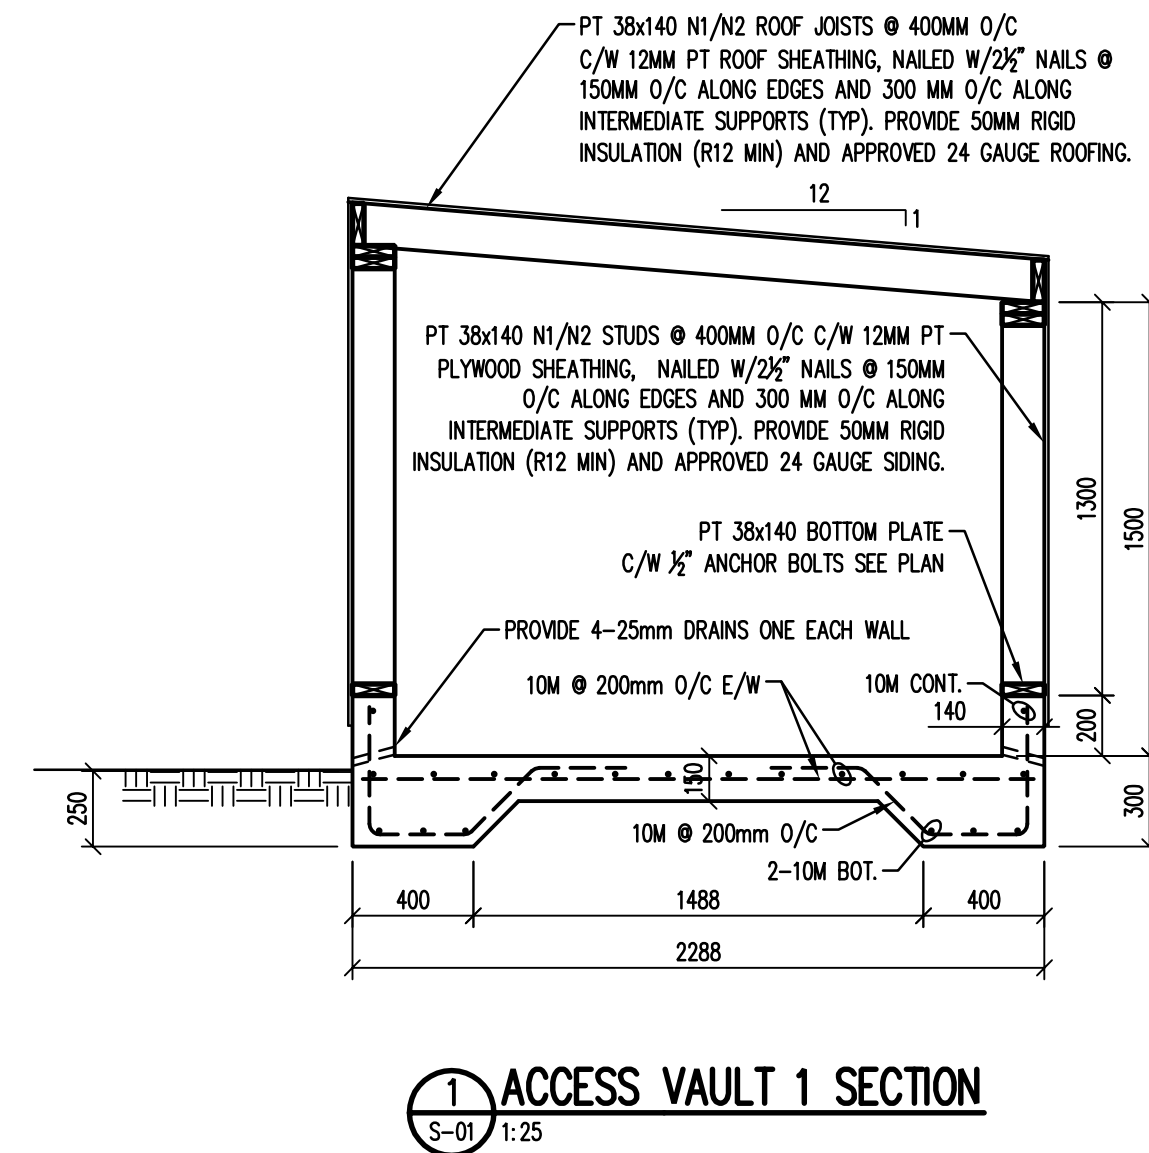

ACCESS VAULT 1 SECTION  
1:25

REVISIONS				
NO.	DESCRIPTION	DATE	BY	APP.
0	ISSUED FOR TENDER	2010.05.04	JG	JH
1	ISSUED FOR CONSTRUCTION	2010.08.06	JG	JH
2	RECORD DRAWING	2014.10.09	AC	

**RECORD DRAWING**  
DRAWINGS WERE BASED UPON INFORMATION SUBMITTED FROM OTHER PARTIES AND THE ENGINEER DOES NOT WARRANT OR CERTIFY THAT THE INFORMATION FROM THESE OTHER PARTIES IS ACCURATE.  
DATE (YYYY MM DD): 2014.10.09

DRAWING NO. DESCRIPTION  
REFERENCE DRAWINGS

FOR BEST PLOTTING RESULTS, BE SURE TO USE  
WILLIAMS ENGINEERING CANADA AUTOCAD PLOT CONFIGURATION  
FILES AVAILABLE FROM: [www.williamsengineering.com](http://www.williamsengineering.com)

**LEGEND**  
SECTION # A-001 SOURCE / REFERENCE DWG. DETAIL # E-001 SOURCE / REFERENCE DWG.

INFORMATION CONTAINED ON THIS DRAWING IS COPYRIGHTED AND HAS BEEN PREPARED FOR THE SOLE PURPOSE OF THIS PROJECT. UNAUTHORIZED USE OF THIS INFORMATION WILL BE CONSIDERED A BREACH OF COPYRIGHT AND MAY BE PURSUED AS SUCH. USE OF THIS INFORMATION FOR ANY OTHER PURPOSE OTHER THAN THIS PARTICULAR PROJECT IS AT THE RISK OF THE USER.

PERMIT STAMP:  
PERMIT TO PRACTICE  
WILLIAMS ENGINEERING CANADA INC.  
PERMIT NUMBER  
P 646  
NWT/NJ Association of Professional Engineers and Geoscientists

ENGINEER'S SEAL:

YELLOWKNIFE OFFICE  
P.O. Box 1529  
480 47 Street  
Yellowknife, NT X1A 2P2  
Bus: (867) 873-2386  
Tel Fax: 1-800-293-2383  
Fax: (867) 873-2547  
info@williamsengineering.com  
www.williamsengineering.com

**WILLIAMS ENGINEERING CANADA**  
**WE**

CLIENT:

JOB TITLE:  
**WATER SUPPLY IMPROVEMENTS  
PHASE 1  
NEW INTAKE AND PUMPHOUSE  
KUGLUKTUK, NU**

DWG. TITLE:  
**ACCESS VAULTS 1 AND 2**

OWN. BY:	DES. BY:	PROJ. MGR.:
JK	EP	JH
PEER REVIEW:	DATE: (YY-MM-DD)	SCALE:
AL	2010.08.06	AS SHOWN
CLIENT PROJ. #	REC PROJ. #	
GN PROJECT #04-4417		13655.00

DWG. NO. S-01 3 1

[illegible]





**RECORD DRAWING**  
 DRAWINGS WERE BASED UPON INFORMATION SUBMITTED  
 FROM OTHER PARTIES AND THE ENGINEER DOES NOT  
 WARRANT OR CERTIFY THAT THE INFORMATION FROM  
 THESE OTHER PARTIES IS ACCURATE.  
 DATE (YYYY MM DD): 2014.10.09

FOR BEST PLOTTING RESULTS, BE SURE TO USE  
WILLIAMS ENGINEERING CANADA AUTOCAD PLOT CONFIGURATION  
FILES AVAILABLE FROM: [www.williamsengineering.com](http://www.williamsengineering.com)

INFORMATION CONTAINED ON THIS DRAWING IS COPYRIGHTED AND HAS BEEN PREPARED FOR THE SOLE PURPOSE OF THIS PROJECT. UNAUTHORIZED USE OF THIS INFORMATION WILL BE CONSIDERED A BREACH OF COPYRIGHT AND MAY BE PURSUED AS SUCH. USE OF THIS INFORMATION FOR ANY OTHER PURPOSE OTHER THAN THIS PARTICULAR PROJECT IS AT THE RISK OF THE USER.

ENGINEER'S SEAL:

**WILLIAMS  
ENGINEERING**  
CANADA



## PIPE SUPPORTS

6-03	30	3	REV	1
------	----	---	-----	---