


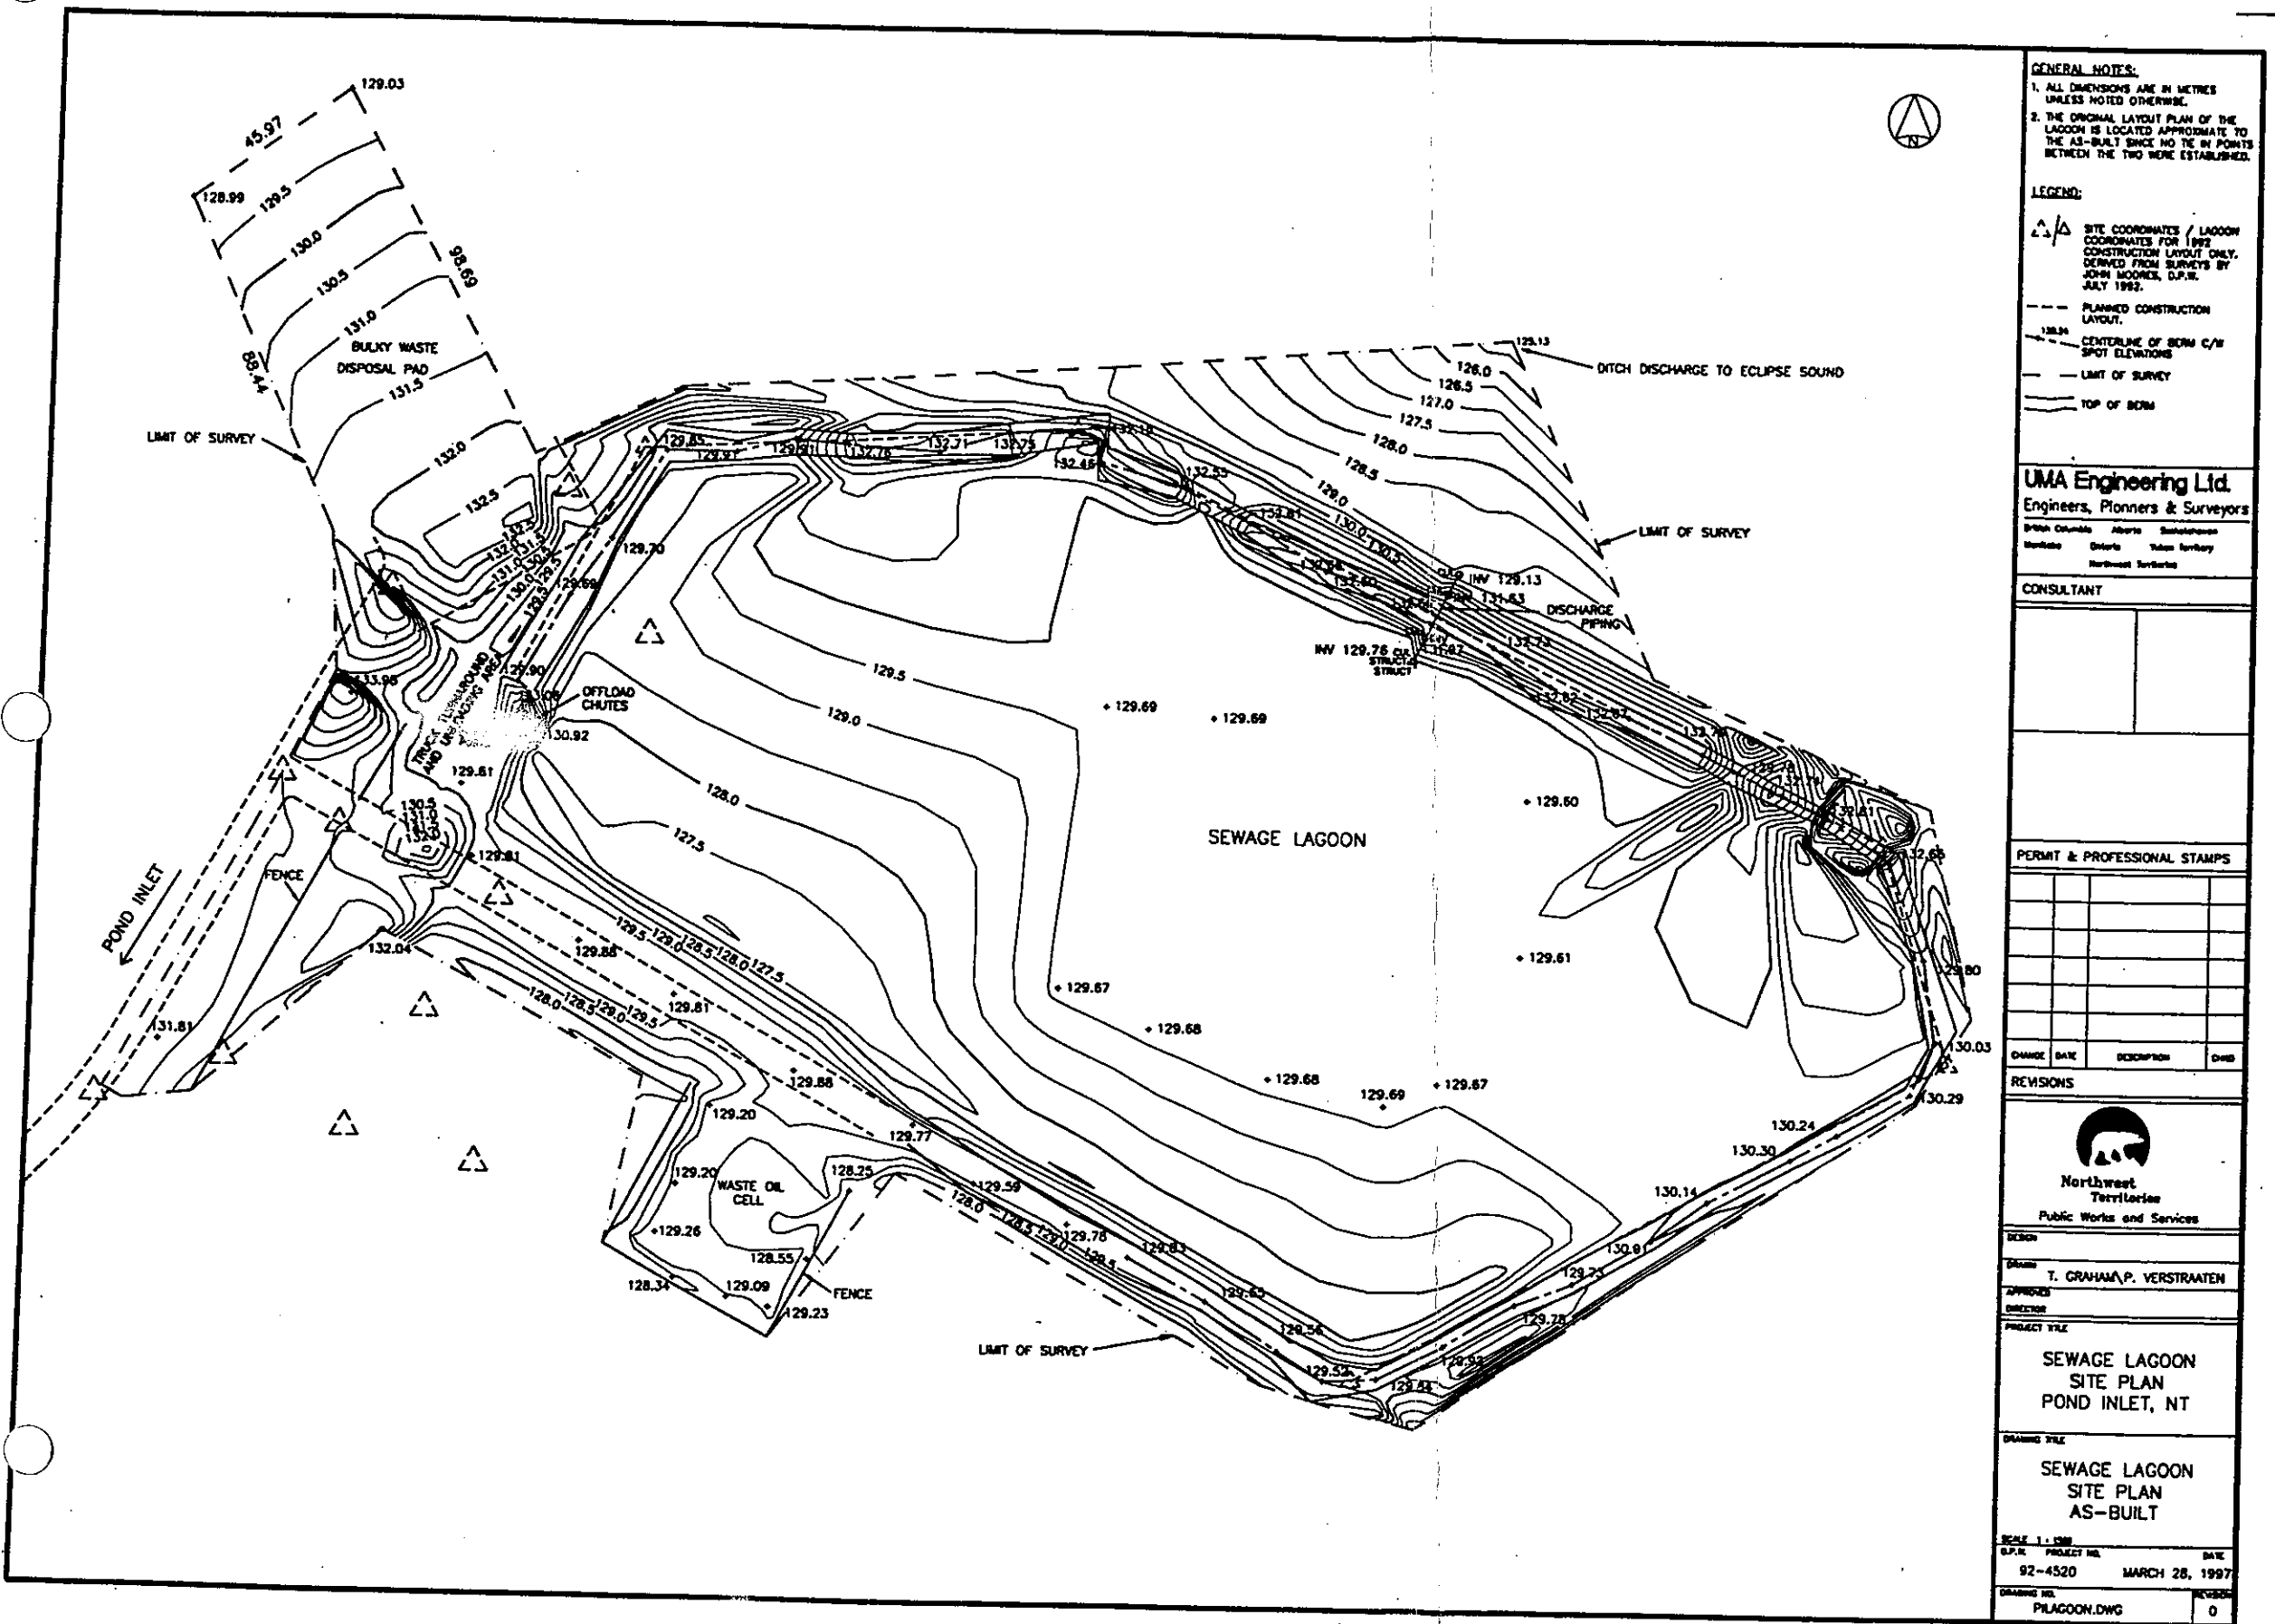

GENERAL NOTES:

1. ALL DIMENSIONS ARE IN METRES UNLESS NOTED OTHERWISE.
2. THE ORIGINAL LAYOUT PLAN OF THE LAGOON IS LOCATED APPROXIMATE TO THE AS-BUILT SINCE NO TIE IN POINTS BETWEEN THE TWO WERE ESTABLISHED.

LEGEND:

- △ SITE COORDINATES / LAGOON COORDINATES FOR 1992 CONSTRUCTION LAYOUT ONLY. DERIVED FROM SURVEYS BY JOHN BOONER, D.P.M. JULY 1992.
- PLANNED CONSTRUCTION LAYOUT.
- CENTERLINE OF BORN C/W SPOT ELEVATIONS
- LIMIT OF SURVEY
- TOP OF BERM

UMA Engineering Ltd.
Engineers, Planners & Surveyors
British Columbia Alberta Saskatchewan
Manitoba Ontario Yukon Northwest Territories

CONSULTANT

--	--

PERMIT & PROFESSIONAL STAMPS

REVISIONS

CHANGE	DATE	DESCRIPTION	DWG

Northwest Territories
Public Works and Services

DESIGN

DESIGNED BY: T. GRAHAM P. VERSTRAATEN

CHECKED BY:

DRAWN BY:

PROJECT TITLE

SEWAGE LAGOON
SITE PLAN
POND INLET, NT

DRAWING TITLE

SEWAGE LAGOON
SITE PLAN
AS-BUILT

SCALE: 1:1000

S.P.R. PROJECT NO. 92-4520 DATE: MARCH 28, 1997

DRAWING NO. PILAGOON.DWG REVISION: 0

12500 01 May 97

