
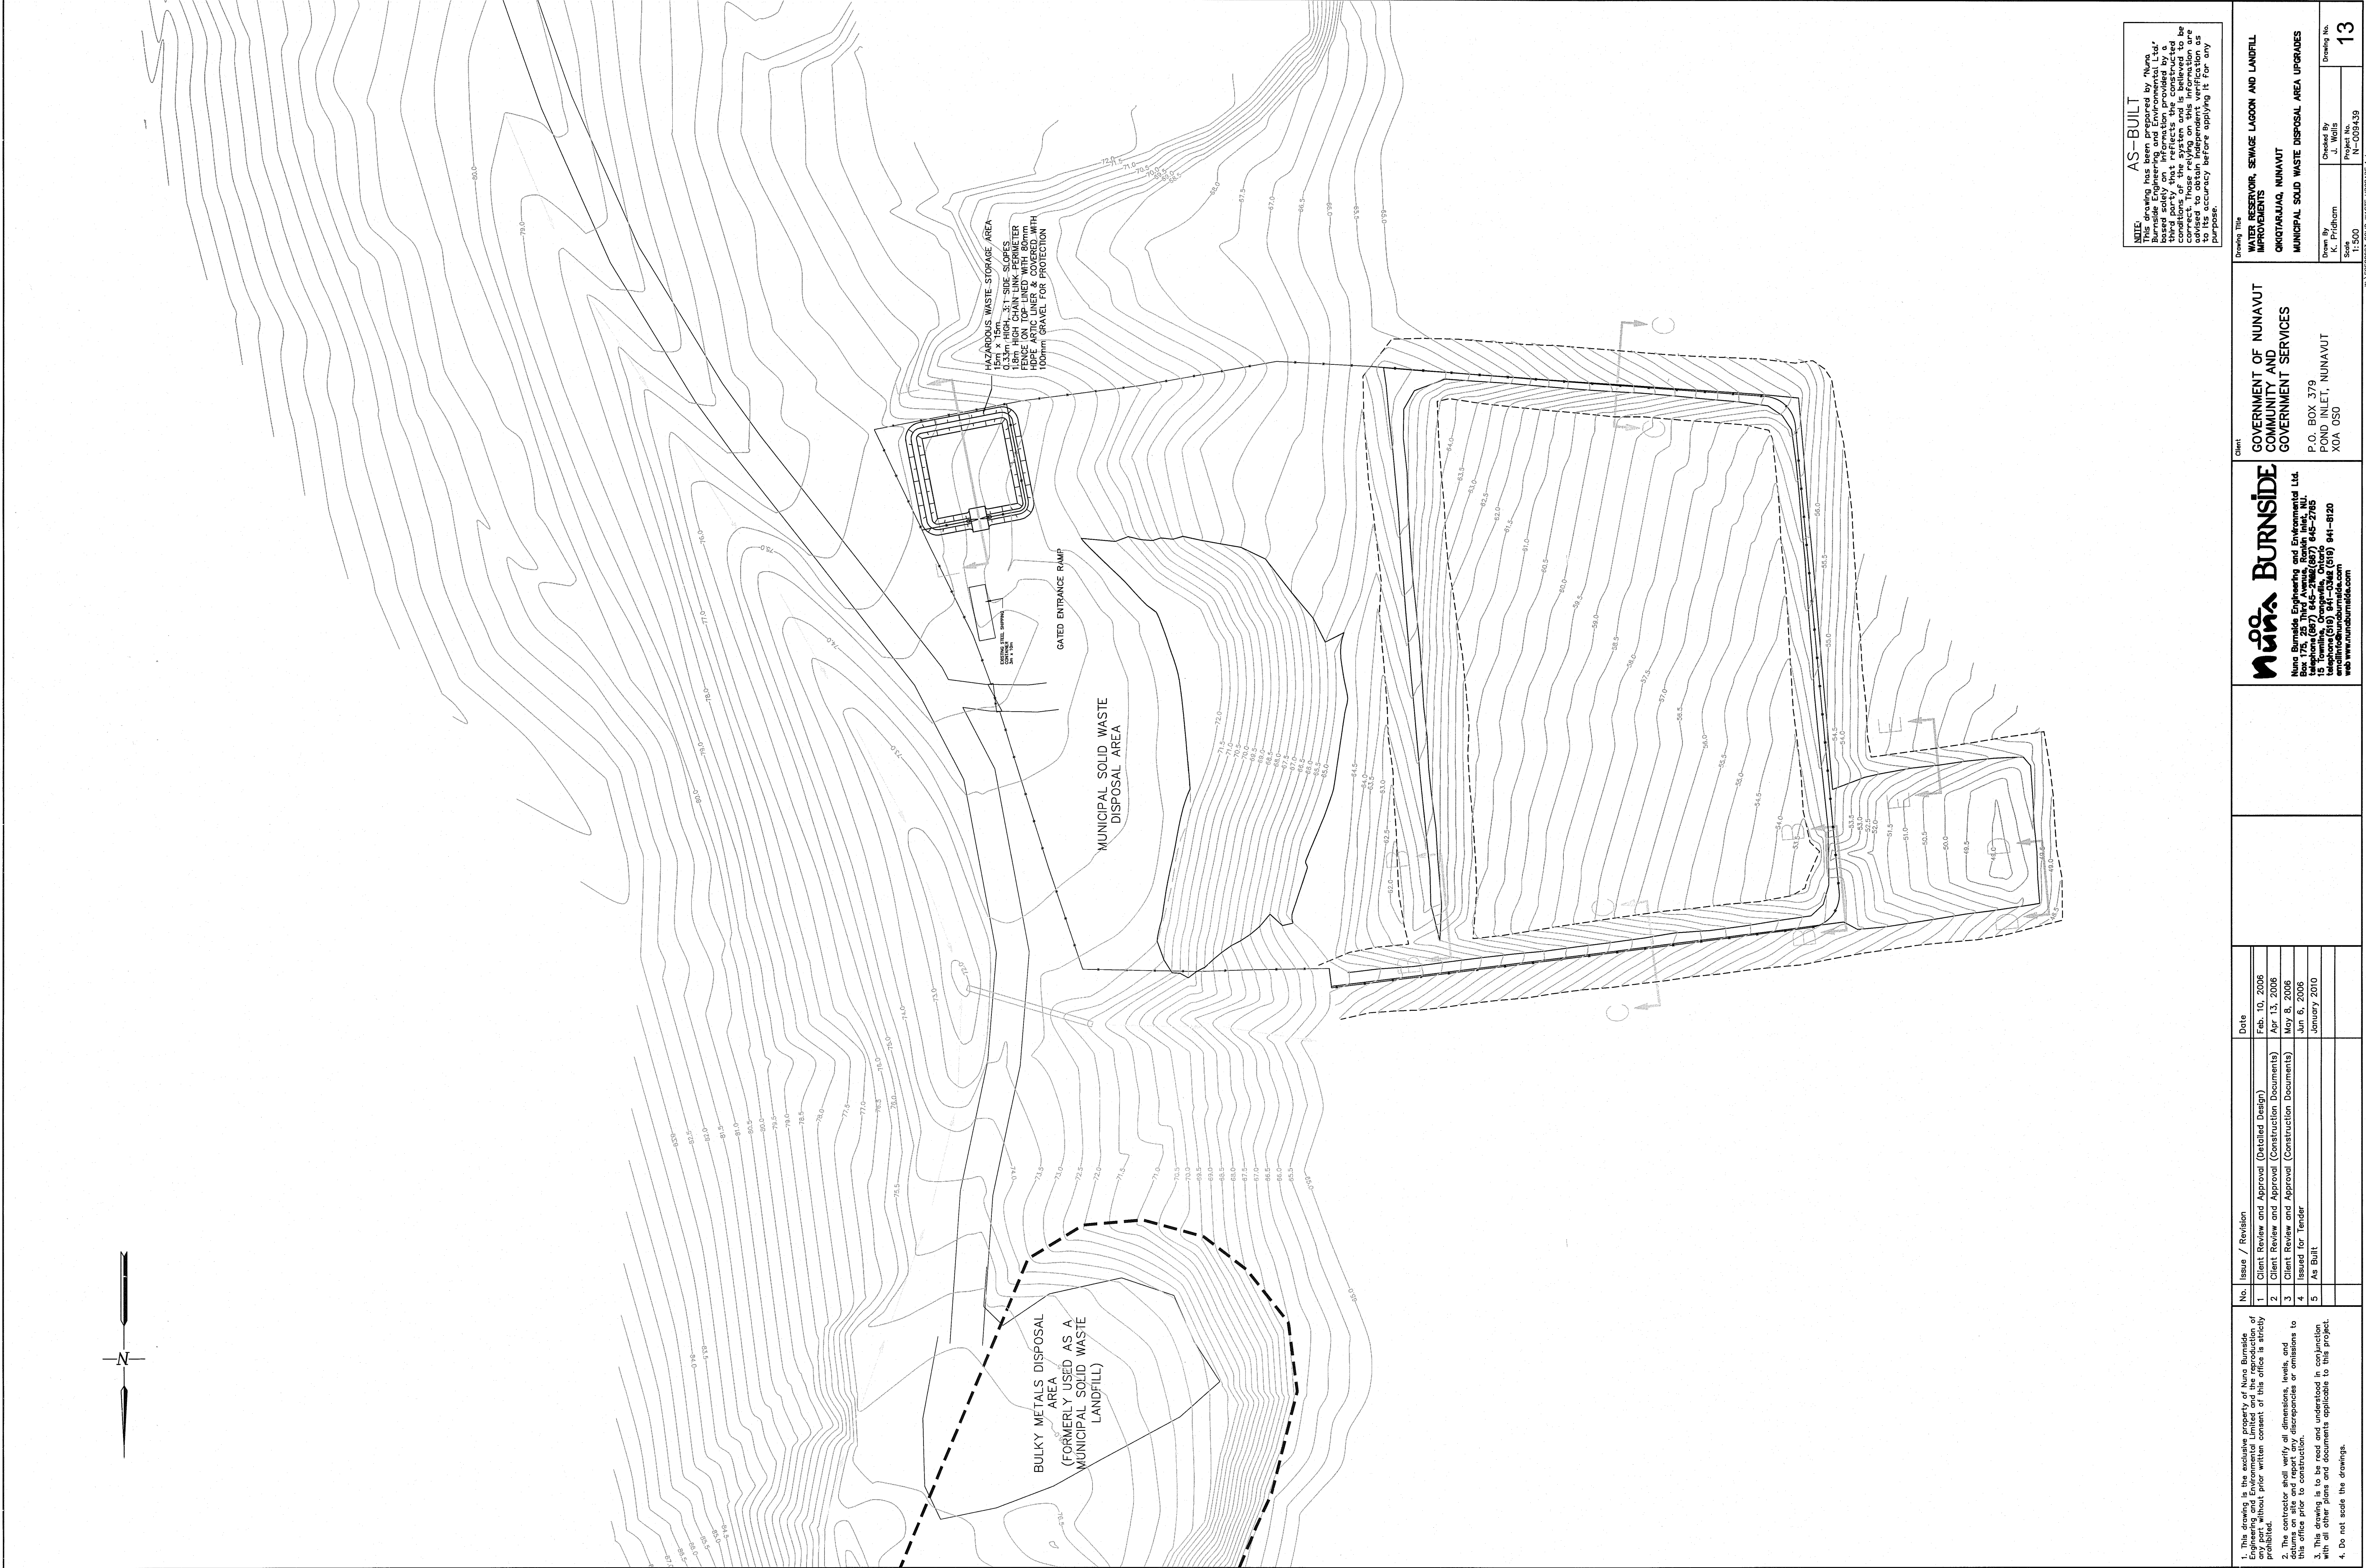


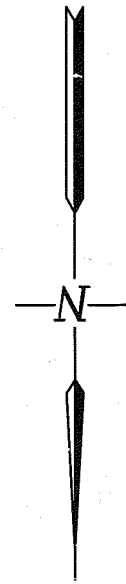

NOTE:
AS-BUILT
This drawing has been prepared by Nuno Burnside Engineering and Environmental Ltd. based on information provided by a third party that reflects the constructed works. The drawing is not a guarantee of accuracy and is not to be used for any purpose other than for information. Those relying on this information are advised to obtain independent verification as to the accuracy of the information as a basis for any purpose.

Issue / Revision		Date	
1	Client Review and Approval (Detailed Design)	Feb. 10, 2006	
2	Client Review and Approval (Construction Documents)	Apr 13, 2006	
3	Client Review and Approval (Construction Documents)	May 8, 2006	
4	Issued for Tender	Jun 6, 2006	
5	As Built	January 2010	

1. This drawing is the exclusive property of Nuno Burnside Engineering and Environmental Limited and the reproduction of any part of this drawing without prior written consent of this office is strictly prohibited.	
2. The contractor shall verify all dimensions, levels, and datum on site and report any discrepancies or emissions to this office prior to construction.	
3. This drawing is to be read and understood in conjunction with all other plans and documents applicable to this project.	
4. Do not scale the drawings.	

Drawing Title		Client	
WATER RESERVOIR, SEWAGE LAGOON AND LANDFILL IMPROVEMENTS		GOVERNMENT OF NUNAVUT	
PROJECT/AREA/LOCATION		COMMUNITY AND GOVERNMENT SERVICES	
PROJECT NO.		P.O. BOX 379	
DRAWN BY		FONUNUQ, NUNAVUT	
CHECKED BY		XQA USD	
SCALE		1:500	
DRAWING NO.		N-005439	
PROJECT NO.		13	

Nuno Burnside
Nuno Burnside Engineering and Environmental Ltd.
Box 175, 25 Third Avenue, Rankin Inlet, N.L.
15 Fort Smith, Ontario, Canada
Telephone (519) 841-0342 (519) 841-8120
www.nunoburnside.com