
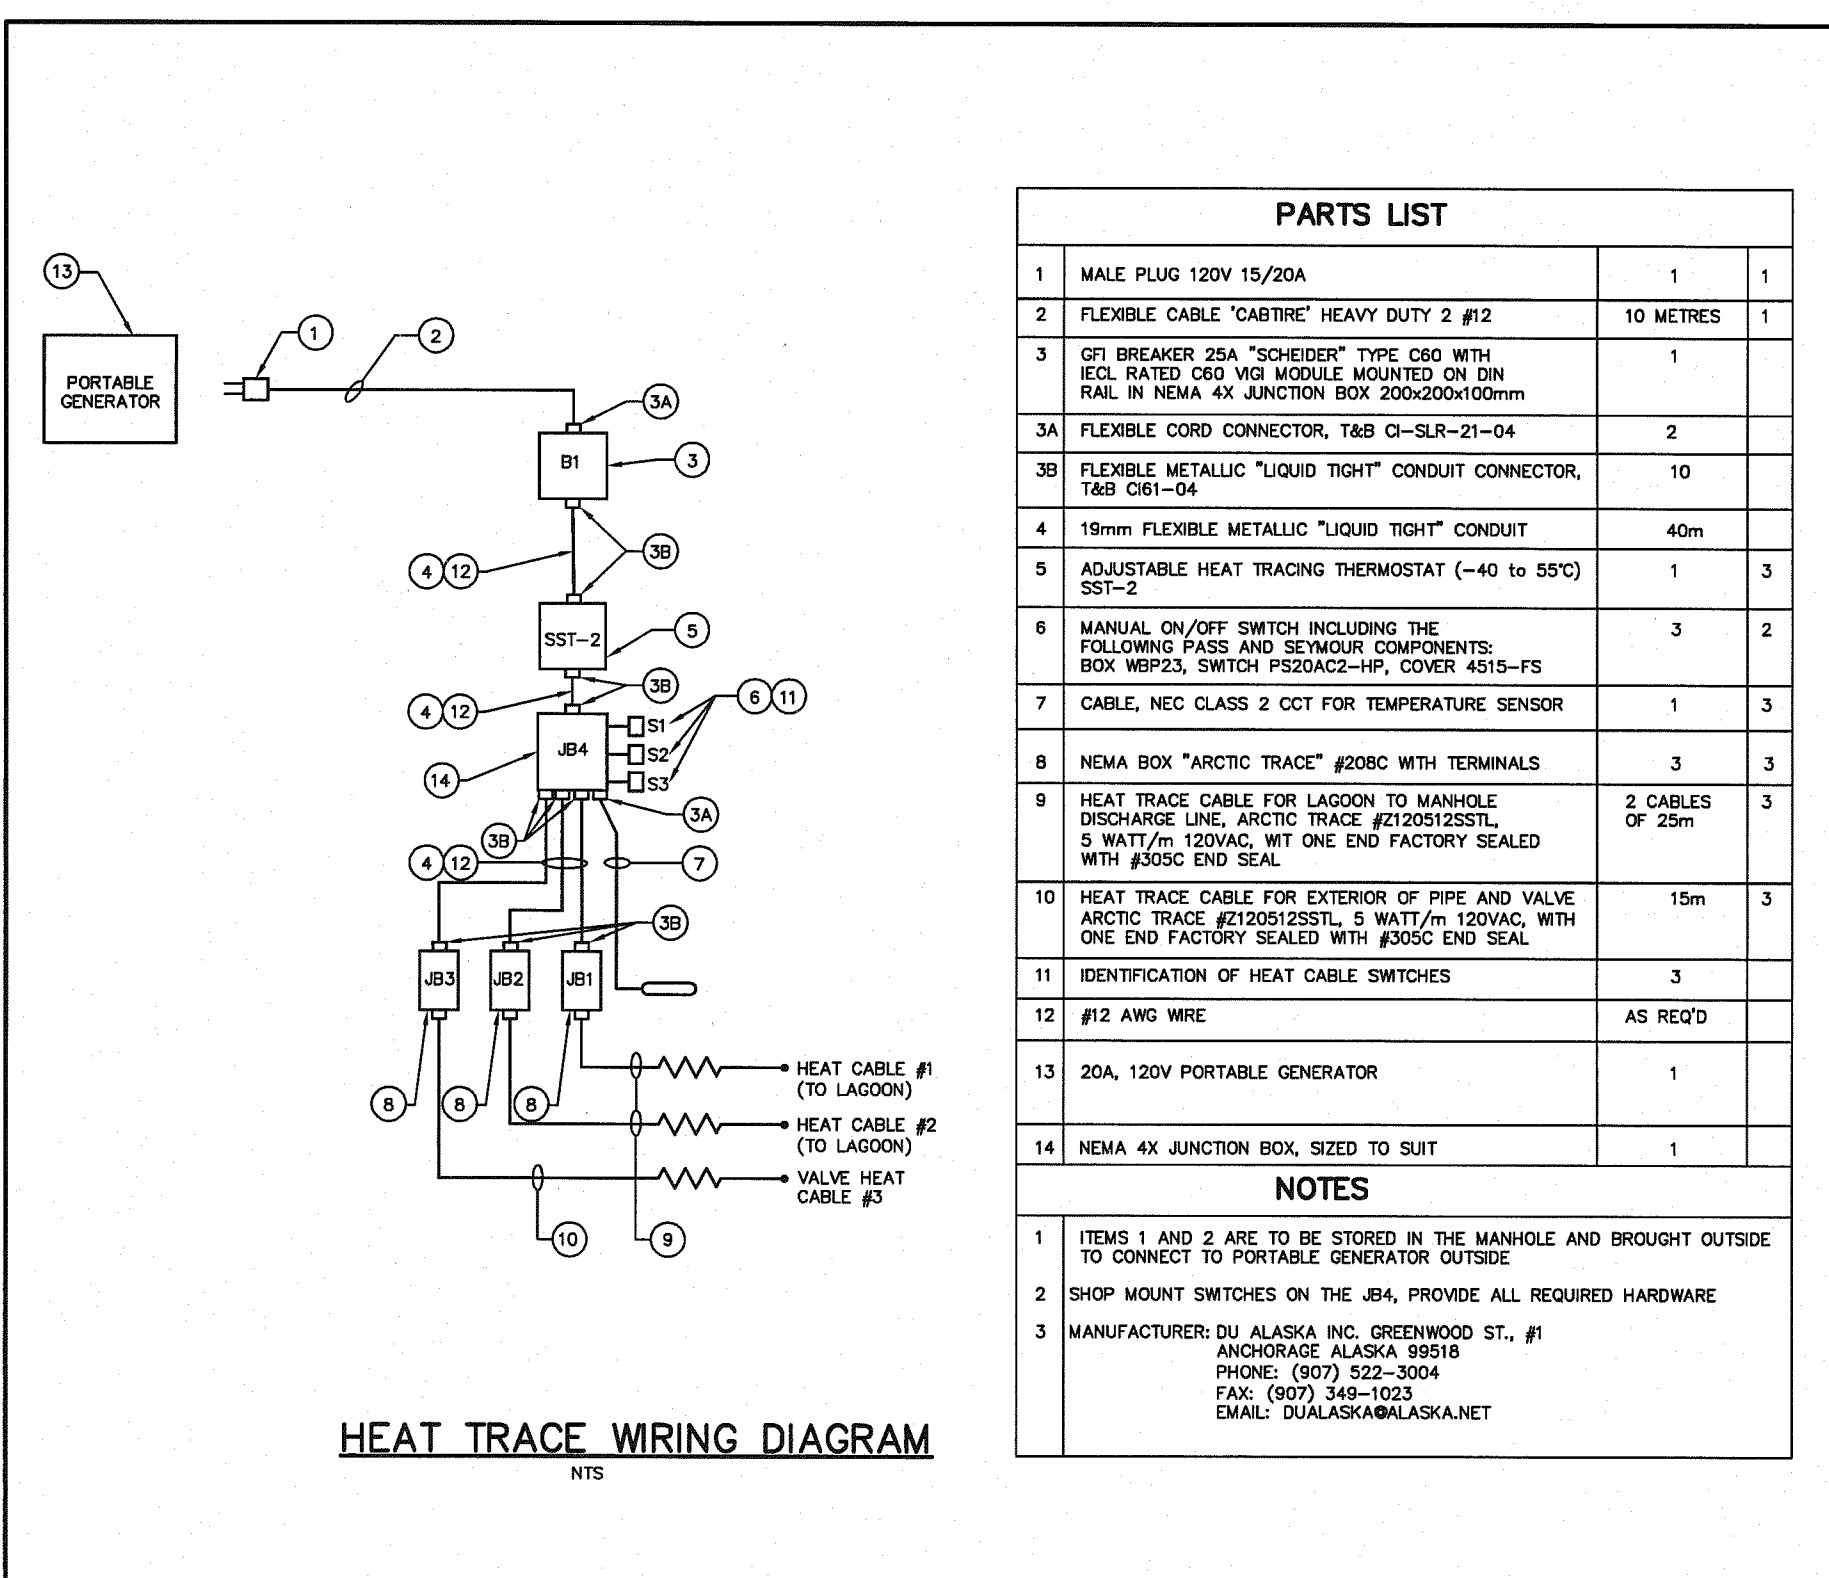
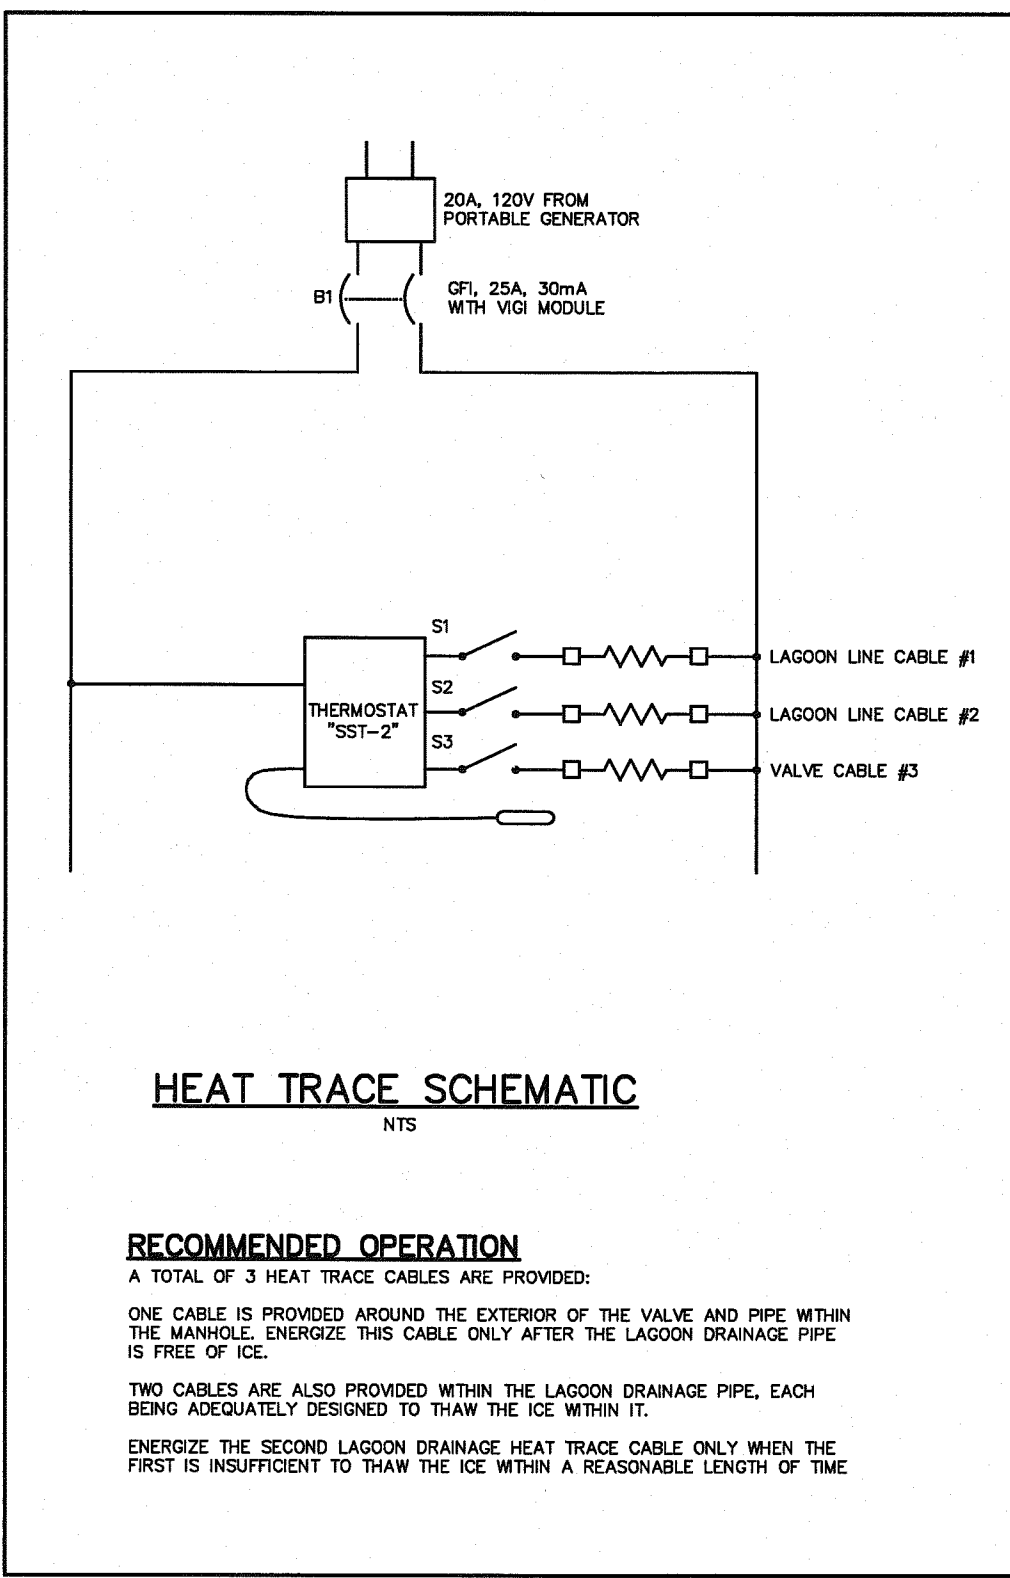
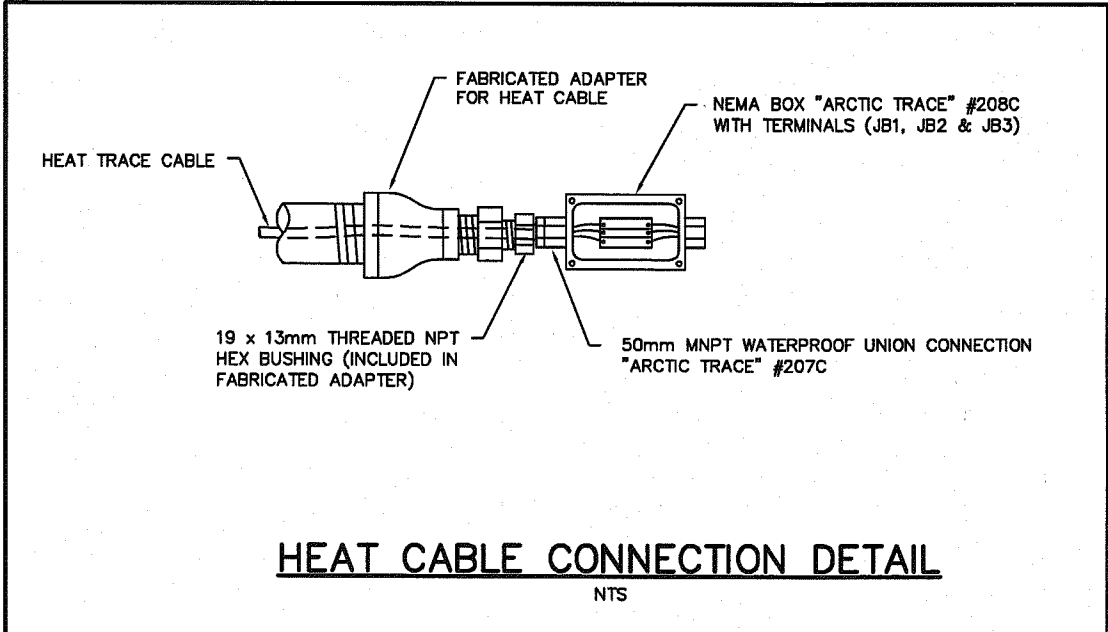
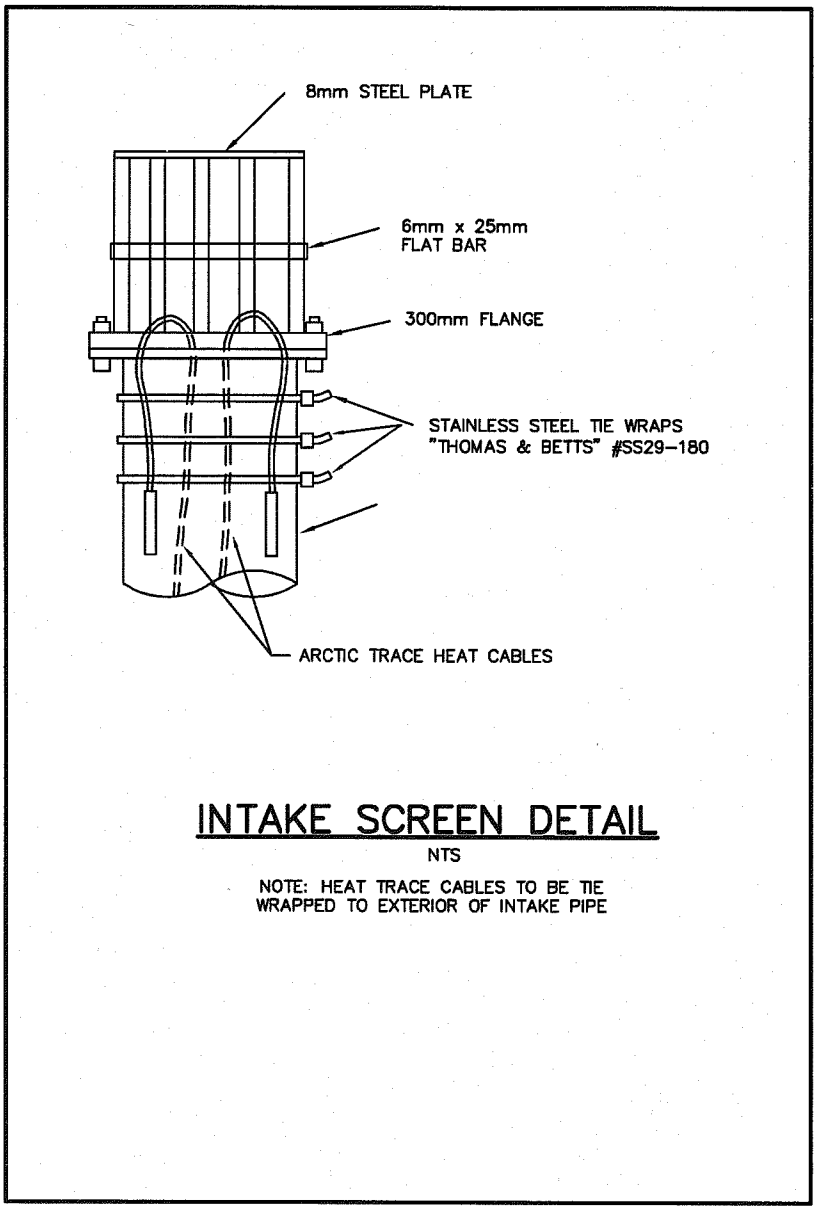
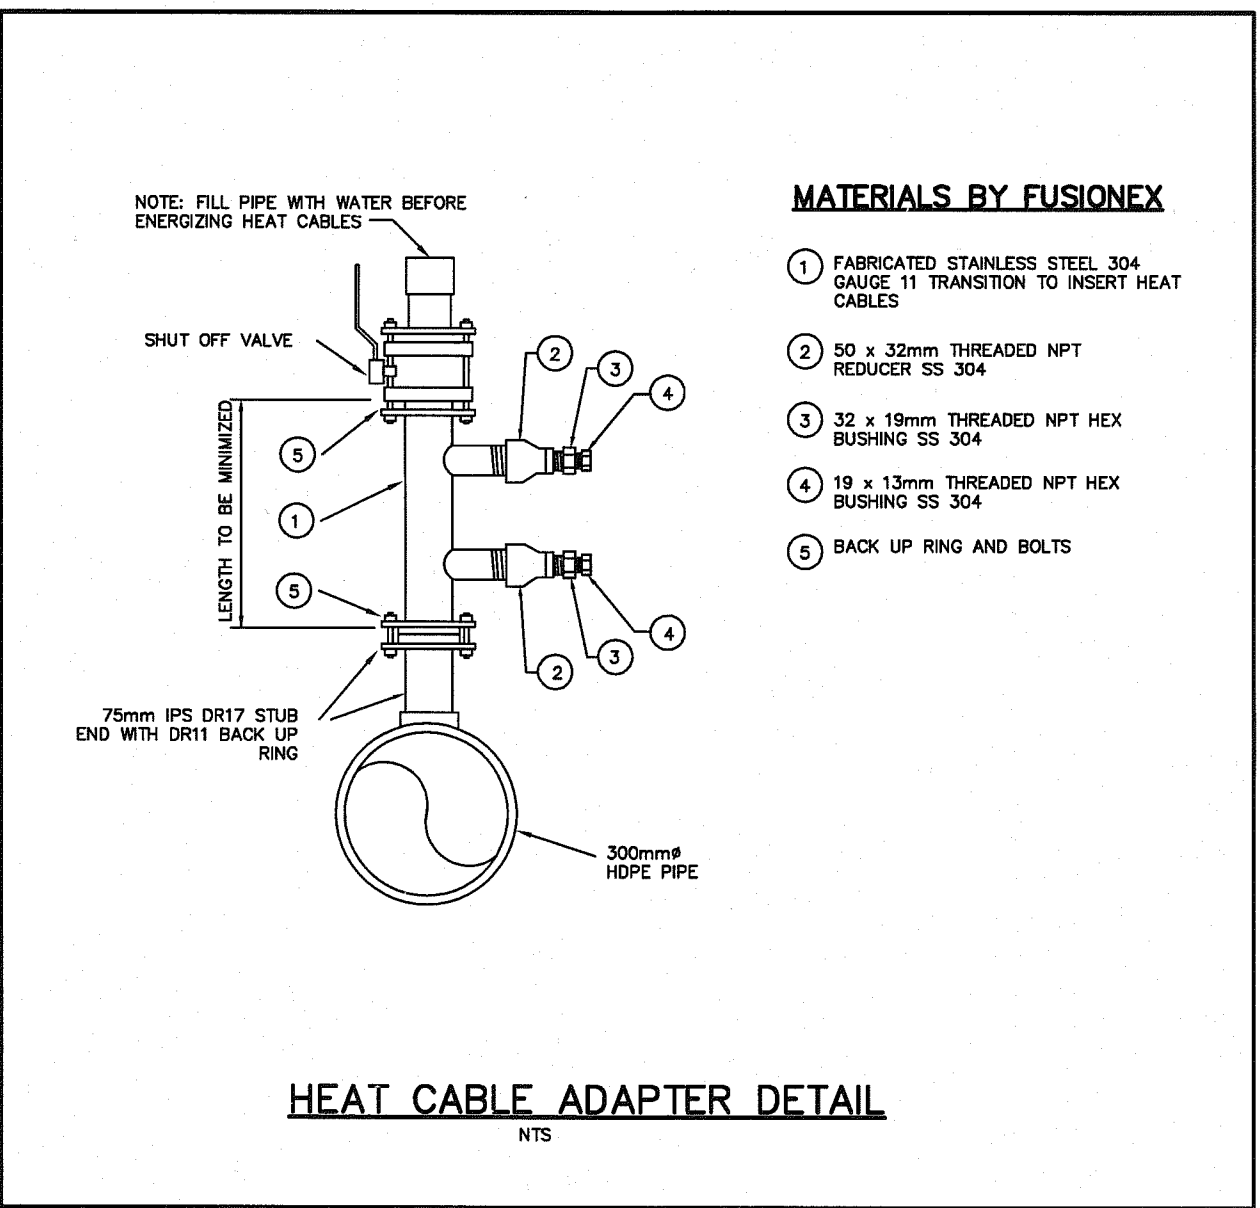


HEAT CABLES SPECIFICATION

HEAT CABLES #1 & #2: HEAT TRACING CABLE (50m).  
DISTANCE ON DRAWING = 25m.  
HEAT CABLES TO BE "ARCTIC TRACE" #2120512SSTL 5  
WATTS/M. 120 VAC. ONE END TERMINATED AT FACTORY WITH  
#505C END SEAL.  
HEAT CABLES AND ACCESSORIES CAN BE PURCHASED FROM:  
DU ALASKA INC.  
6705 GREENWOOD ST., #1  
ANCHORAGE ALASKA 99518  
PHONE: (907) 522-3004  
FAX: (907) 549-1023  
EMAIL: DUALASKA@ALASKA.NET

SPECIFICATION FOR ELECTRICAL WORK

GENERAL  
1. THIS SPECIFICATION COVERS ALL ELECTRICAL WORK AND CONTROL WIRING FOR THE SUPPLY AND INSTALLATION  
OF ELECTRICAL HEAT TRACING FOR THE LAGOON DISCHARGE LINE.  
2. ALL ELECTRICAL WORK AND CONTROL WIRING IS THE RESPONSIBILITY OF THE CONTRACTOR. THE FABRICATED  
ADAPTER FOR THE HEAT CABLE IS TO BE SUPPLIED BY THE CONTRACTOR.  
CODES AND STANDARDS  
1. THE INSTALLATION SHALL BE IN ACCORDANCE WITH THE LATEST CSA EDITION AND THE LOCAL ELECTRICAL  
CODE EXCEPT WHERE SPECIFIED OTHERWISE.  
SHOP DRAWINGS, PRODUCTS DATA AND SAMPLES  
1. SUBMIT SHOP DRAWINGS AND PRODUCT DATA TO ENGINEER IN PDF FORMAT  
2. INDICATE DETAILS OF WIRING DIAGRAMS, CONSTRUCTION, DIMENSIONS, CAPACITIES, WEIGHTS AND ELECTRICAL  
PERFORMANCE CHARACTERISTICS OF EQUIPMENT OR MATERIAL.  
OPERATION AND MAINTENANCE DATA  
1. PROVIDE OPERATION AND MAINTENANCE DATA FOR INCORPORATION INTO MAINTENANCE MANUAL.  
2. PROVIDE 3 COPIES OF OPERATION AND MAINTENANCE DATA.  
3. DATA TO INCLUDE DETAILS OF DESIGN ELEMENTS, CONSTRUCTION FEATURES, COMPONENT FUNCTION AND  
MAINTENANCE REQUIREMENTS TO PERMIT EFFECTIVE STARTUP, OPERATION, MAINTENANCE, REPAIR, MODIFICATION,  
EXTENSION AND EXPANSION OF ANY PORTION OR FEATURE OF INSTALLATION.  
4. TECHNICAL DATA IS TO INCLUDE PRODUCT DATA, SUPPLEMENTED BY BULLETINS, COMPONENT ILLUSTRATIONS,  
EXPLODED VIEWS, TECHNICAL DESCRIPTIONS OF ITEMS AND PARTS LISTS, ADVERTISING OR SALES LITERATURE  
NOT ACCEPTABLE.  
5. WIRING DIAGRAMS ARE TO BE INCLUDED AS PART OF OPERATION AND MAINTENANCE DATA.  
6. NAMES AND ADDRESSES OF LOCAL SUPPLIERS OF COMPONENTS TO BE INCLUDED IN MAINTENANCE MANUALS  
MAINTENANCE MATERIALS  
1. PROVIDE MAINTENANCE MATERIALS LIST IN MAINTENANCE MANUAL.  
OPERATION AND STARTUP  
THE FOLLOWING ITEMS SHALL BE COMPLETED AS A MINIMUM, TO ENSURE THAT THE WORK SHALL BE FREE OF  
DEFECTS AND FLAWS:  
1. PROVIDE INSTRUCTION TO ON-SITE OPERATING PERSONNEL IN THE OPERATION CARE AND MAINTENANCE OF  
EQUIPMENT  
2. PROVIDE ONE SET OF MARKED UP DRAWINGS TO THE ENGINEER FOR PREPARATION OF AS-BUILT DRAWINGS.  
VOLTAGE RATINGS  
1. OPERATING VOLTAGES: TO CSA ELECTRICAL CODE C22.2  
MATERIALS AND EQUIPMENT  
1. EQUIPMENT AND MATERIAL TO BE NEW, CSA CERTIFIED, AND MANUFACTURED TO STANDARDS QUOTED IN ORDER  
TO MEET THE PERFORMANCE SPECIFIED  
2. WHERE THERE IS NO ALTERNATIVE TO SUPPLYING EQUIPMENT THAT IS NOT CSA CERTIFIED, OBTAIN SPECIAL  
APPROVAL FROM THE AUTHORITIES HAVING JURISDICTION.  
3. CONTROL PANELS AND COMPONENT ASSEMBLIES TO BE FACTORY ASSEMBLED  
FINISHES  
1. CLEAN AND TOUCH UP SURFACES OF SHOP-PAINTED EQUIPMENT SCRATCHED OR MARRED DURING SHIPMENT OR  
INSTALLATION TO MATCH ORIGINAL PAINT  
2. CLEAN, PRIME AND PAINT EXPOSED HANGERS, RACKS AND FASTENINGS TO PREVENT RUSTING.  
EQUIPMENT IDENTIFICATION  
1. IDENTIFY ELECTRICAL EQUIPMENT WITH NAMEPLATES  
2. NAMEPLATES: LAMINATED 3mm THICK PLASTIC ENGRAVING SHEET, BLACK FACE, WHITE CORE, SELF-ADHESIVE  
UNLESS SPECIFIED OTHERWISE  
NAMEPLATE SIZES SIZE 1: 12 x 50mm 1 LINE 3mm HIGH LETTERS  
SIZE 2: 19 x 50mm 1 LINE 6mm HIGH LETTERS  
WIRING IDENTIFICATION  
1. IDENTIFY WIRING WITH PERMANENT INDELIBLE IDENTIFYING MARKINGS WITH EITHER NUMBERED OR COLORED  
PLASTIC TUBES ON BOTH ENDS OF PHASE CONDUCTORS OF FEEDERS, BRANCH CIRCUIT WIRING AND CONTROL  
WIRING. GUMMED TAPE IS UNACCEPTABLE  
2. COLOUR CODE: TO CSA  
WIRING TERMINATIONS  
1. LUGS, TERMINALS AND SCREWS USED FOR TERMINATION OF WIRING TO BE SUITABLE FOR COPPER.  
MANUFACTURERS AND CSA LABELS  
1. MANUFACTURERS NAMEPLATES AND CSA LABELS TO BE VISIBLE AND LEGIBLE AFTER EQUIPMENT IS INSTALLED  
WARNING SIGNS  
1. PROVIDE WARNING SIGNS, AS PER CSA FOR EACH HEAT CABLE. YELLOW TAGS SHALL BE SUPPLIED BY THE  
HEAT CABLE SUPPLIER  
MOUNTING HEIGHTS  
1. MOUNTING HEIGHT OF EQUIPMENT IS FROM FINISHED FLOOR TO CENTRELINE OF EQUIPMENT UNLESS SPECIFIED  
OR INDICATED OTHERWISE  
CONDUIT AND CABLE INSTALLATION  
1. INSTALL FLEXIBLE "LIQUID TIGHT" CONDUITS INSIDE MANHOLE AND ANCHOR TO MANHOLE WALLS, ENSURING THE  
SCREWS DO NOT PERFORATE HDPE WALLS  
TESTING  
1. MEGGER ALL HEAT TRACING CABLES BEFORE AND AFTER PULLING INTO THE WATER LINES.  
2. MEGGER TEST CIRCUITS, FEEDERS AND EQUIPMENT UP TO 350V WITH A 500V INSTRUMENT.  
3. TEST OPERATION OF HEAT TRACING CONTROLS BY SIMULATION OF A FROZEN LINE WHILE MEASURING CURRENT  
ON HEAT CABLE  
4. PROVIDE INSTRUMENTS, METERS, EQUIPMENT AND PERSONNEL REQUIRED TO CONDUCT TESTS DURING  
COMMISSIONING  
5. SUBMIT TEST RESULTS TO THE ENGINEER  
6. ENSURE CIRCUIT PROTECTIVE DEVICES SUCH AS OVER CURRENT TRIPS, RELAYS, AND FUSES ARE INSTALLED TO  
THE VALUES AND SETTINGS AS INDICATED.  
CLEANING  
1. PERFORM A FINAL CLEANING UPON COMPLETION OF THE WORK  
2. REMOVE ALL DEBRIS FROM INSIDE OF MANHOLE AND FROM THE PROJECT SITE  
SCOPE OF WORK  
1. THE PERFORMANCE SPECIFICATION PRESENTED COVERS THE DESIGN, SUPPLY, FABRICATION, INSTALLATION AND  
STARTUP OF THE FOLLOWING WORKS: INSTALLATION OF HEAT TRACING CABLES IN THE LAGOON DISCHARGE  
LINE.  
-USE FISHING EQUIPMENT TO PULL THE HEAT TRACING CABLES THROUGH THE PIPES  
-ATTACH THE HEAT CABLES TO THE INTAKE SCREEN IN THE LAGOON  
-INSTALL THE FABRICATED ADAPTER FOR HEAT CABLE AND PULL THE HEAT CABLE THROUGH  
-TEST THE HEAT CABLE AND MEGGER TEST BEFORE CUTTING THE HEAT CABLE TO THE CORRECT LENGTH  
-INSTALL THE CONTROLLERS, SENSORS WIRING AND JUNCTION BOXES.  
-TEST THE WHOLE SYSTEM WITH THE PORTABLE GENERATOR  
DEFINITION OF AREAS  
1. MANHOLE: NET LOCATION: CORROSION PROOF EQUIPMENT REQUIRED  
CONDUITS, FITTINGS, JUNCTION BOXES AND FASTENERS  
1. ALL CONDUITS IN THE MANHOLE SHALL BE LIQUID TIGHT, NON-METALLIC.  
2. CONDUIT FASTENERS TO BE RUST PROOF.  
POWER AND CONTROL WIRING  
1. ALL POWER WIRES TO BE RW90 OR T90 NYLON  
2. ALL WIRES TO BE COPPER  
3. ALL CONDUCTORS TO BE STRANDED TYPE  
4. WIRES AND CABLES TO BE IDENTIFIED WITH EQUIPMENT NUMBER, AS DETAILED ON THE LIST OF CONTROL AND  
SENSOR POINTS. USE THERMO ENGRAVED TUBES.  
GROUNDING  
1. EQUIPMENT AND CIRCUITS TO BE GROUNDED AS PER ELECTRICAL SAFETY CODE  
HEAT TRACING EQUIPMENT  
1. ALL PARTS RELATED TO THE HEAT TRACING ARE SPECIFIED ON THE DRAWINGS

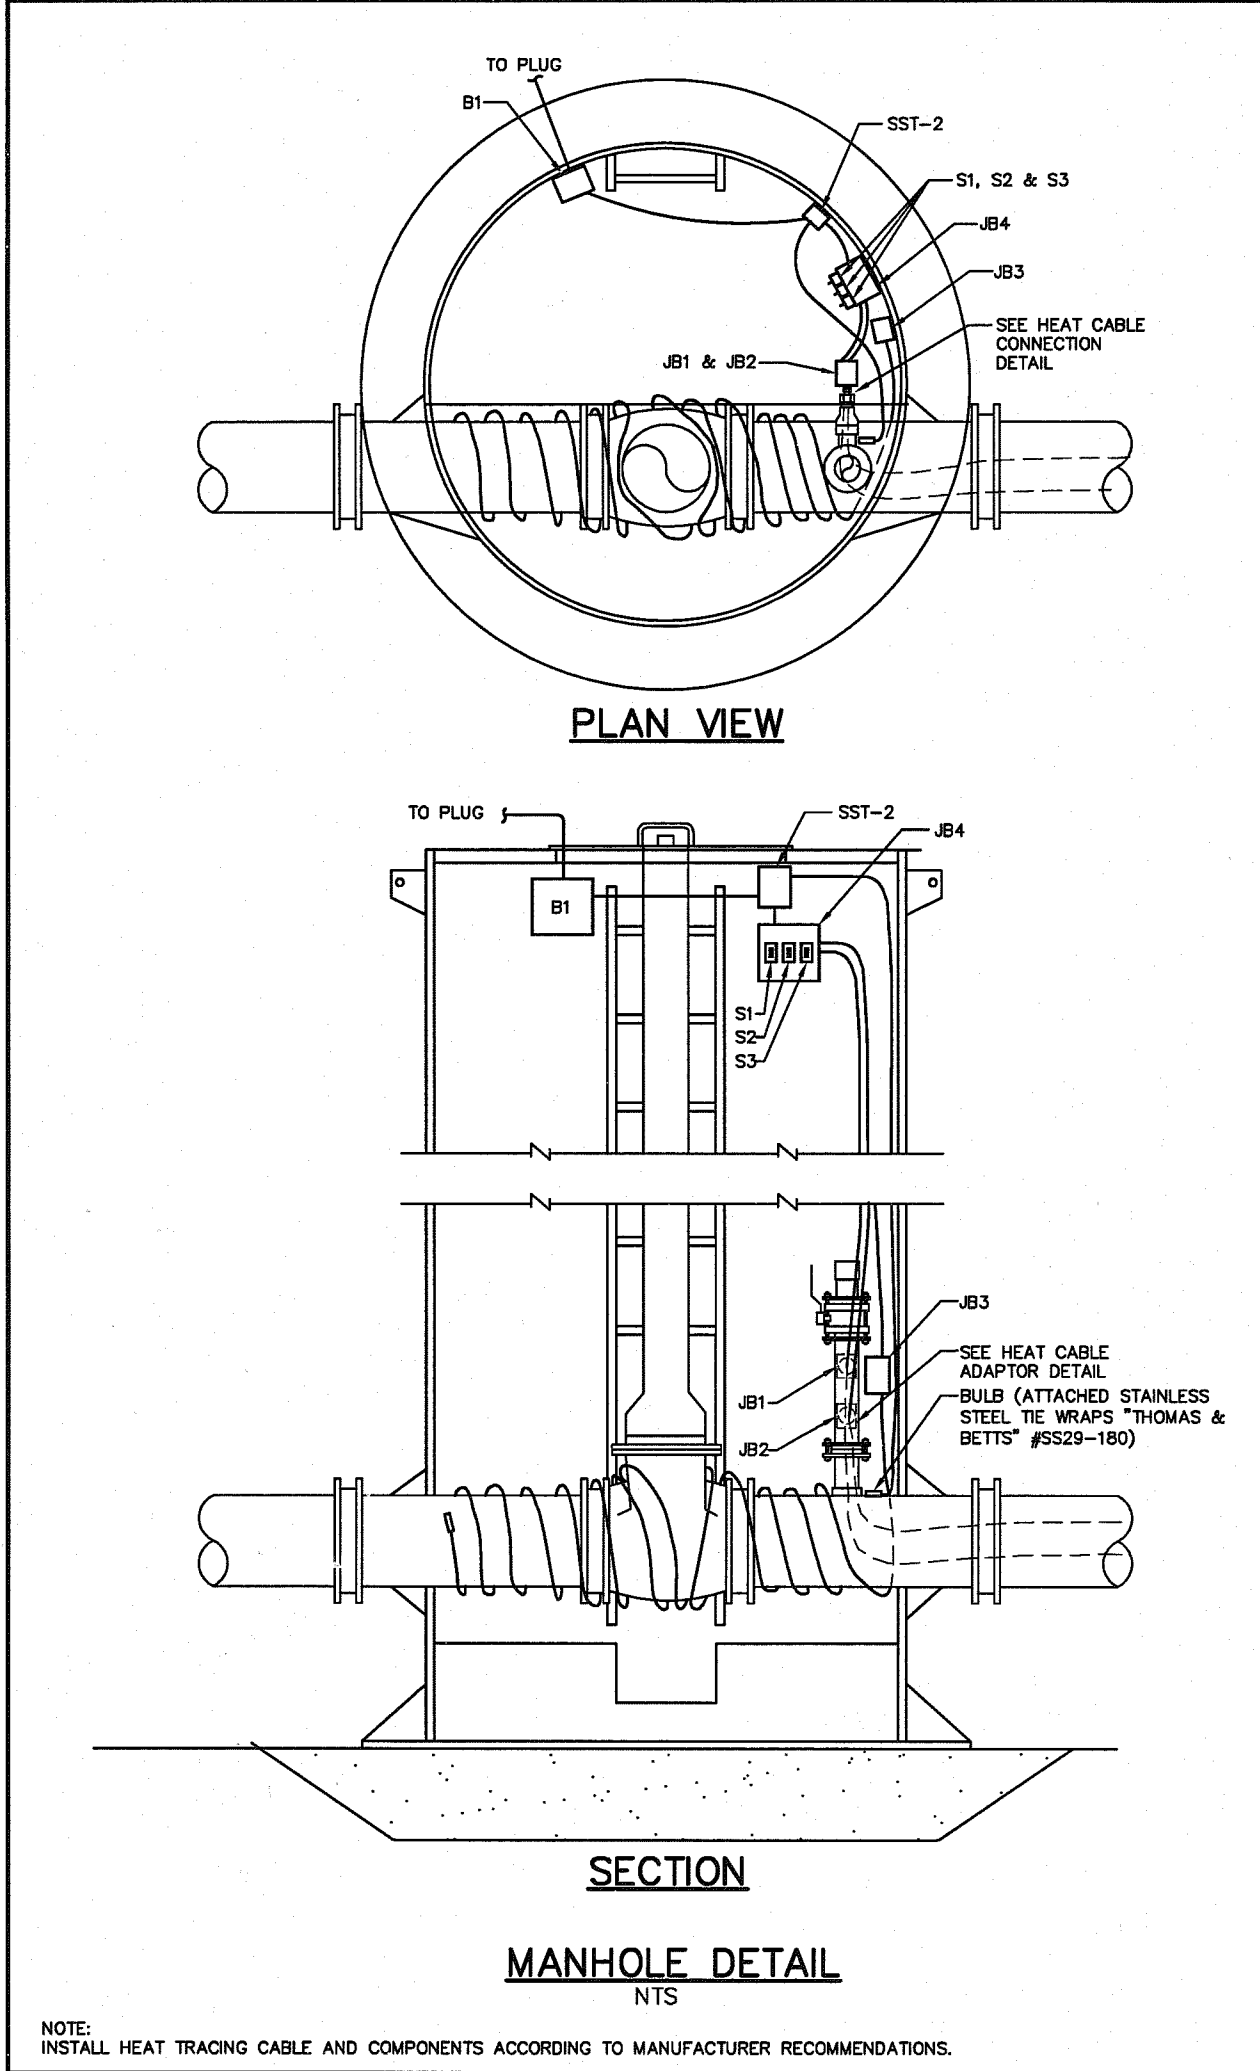

1. This drawing is the exclusive property of Nuna Burnside Engineering and Environmental Ltd. and the reproduction of any part without prior written consent of this office is strictly prohibited.  
2. The contractor shall verify all dimensions, levels, and returns on site and report any discrepancies or omissions to this office prior to construction.  
3. This drawing is to be read and understood in conjunction with all other plans and documents applicable to this project.  
4. Do not scale the drawings.

No.	Issue / Revision	Date
1	Client Review and Approval (Detailed Design)	Feb 10, 2006
2	Client Review and Approval (Construction Documents)	Apr 13, 2006
3	Client Review and Approval (Construction Documents)	May 8, 2006
4	Issued for Tender	Jun 6, 2006
5	Redesign of Discharge Arrangement	May 15, 2009
6	As Built	January 2010

NOTE: AS-BUILT  
This drawing has been prepared by "Nuna Burnside Engineering and Environmental Ltd." based solely on information provided by a third party that reflects the constructed conditions of the system and is believed to be correct. Those relying on this information are advised to obtain independent verification as to its accuracy before applying it for any purpose.

runge & associates inc. ENGINEERS  
864 Hurontario Street  
P.O. Box 387  
Collingwood, ON, L9Y 3Z7  
Telephone: (867) 645-2762 fax: (867) 645-2765  
15 Townline, Orangeville, Ontario  
Telephone: (519) 941-0242 fax: (519) 941-8120  
email: info@rungeinc.com  
t: (705) 446-3588  
www.rungeinc.com

burnside  
Nuna Burnside Engineering and Environmental Ltd.  
Box 175, 25 Third Avenue, Ramoth, NJ  
Telephone: (867) 645-2762 fax: (867) 645-2765  
15 Townline, Orangeville, Ontario  
Telephone: (519) 941-0242 fax: (519) 941-8120  
email: info@burnside.com  
web: www.burnside.com

Client: GOVERNMENT OF NUNAVUT  
COMMUNITY AND GOVERNMENT SERVICES  
P.O. BOX 379  
POND INLET, NUNAVUT  
X0A 0S0

Drawing Title: WATER RESERVOIR, SEWAGE LAGOON AND LANDFILL IMPROVEMENTS QINGTARJUAQ, NUNAVUT SEWAGE LAGOON DETAILS		
Drawn By: J. Randall	Checked By: M. O'Hara / M. Poznar	Drawing No. 10
Scale: N.T.S.	Project No: N-O 09439	