




# WATER RESERVOIR, SEWAGE LAGOON AND LANDFILL IMPROVEMENTS HAMLET OF QIKIQTARJUAQ, NUNAVUT

GOVERNMENT OF NUNAVUT  
COMMUNITY AND GOVERNMENT SERVICES  
P.O. BOX 379, POND INLET, NUNAVUT X0A 0S0

AS BUILT JANUARY 2010

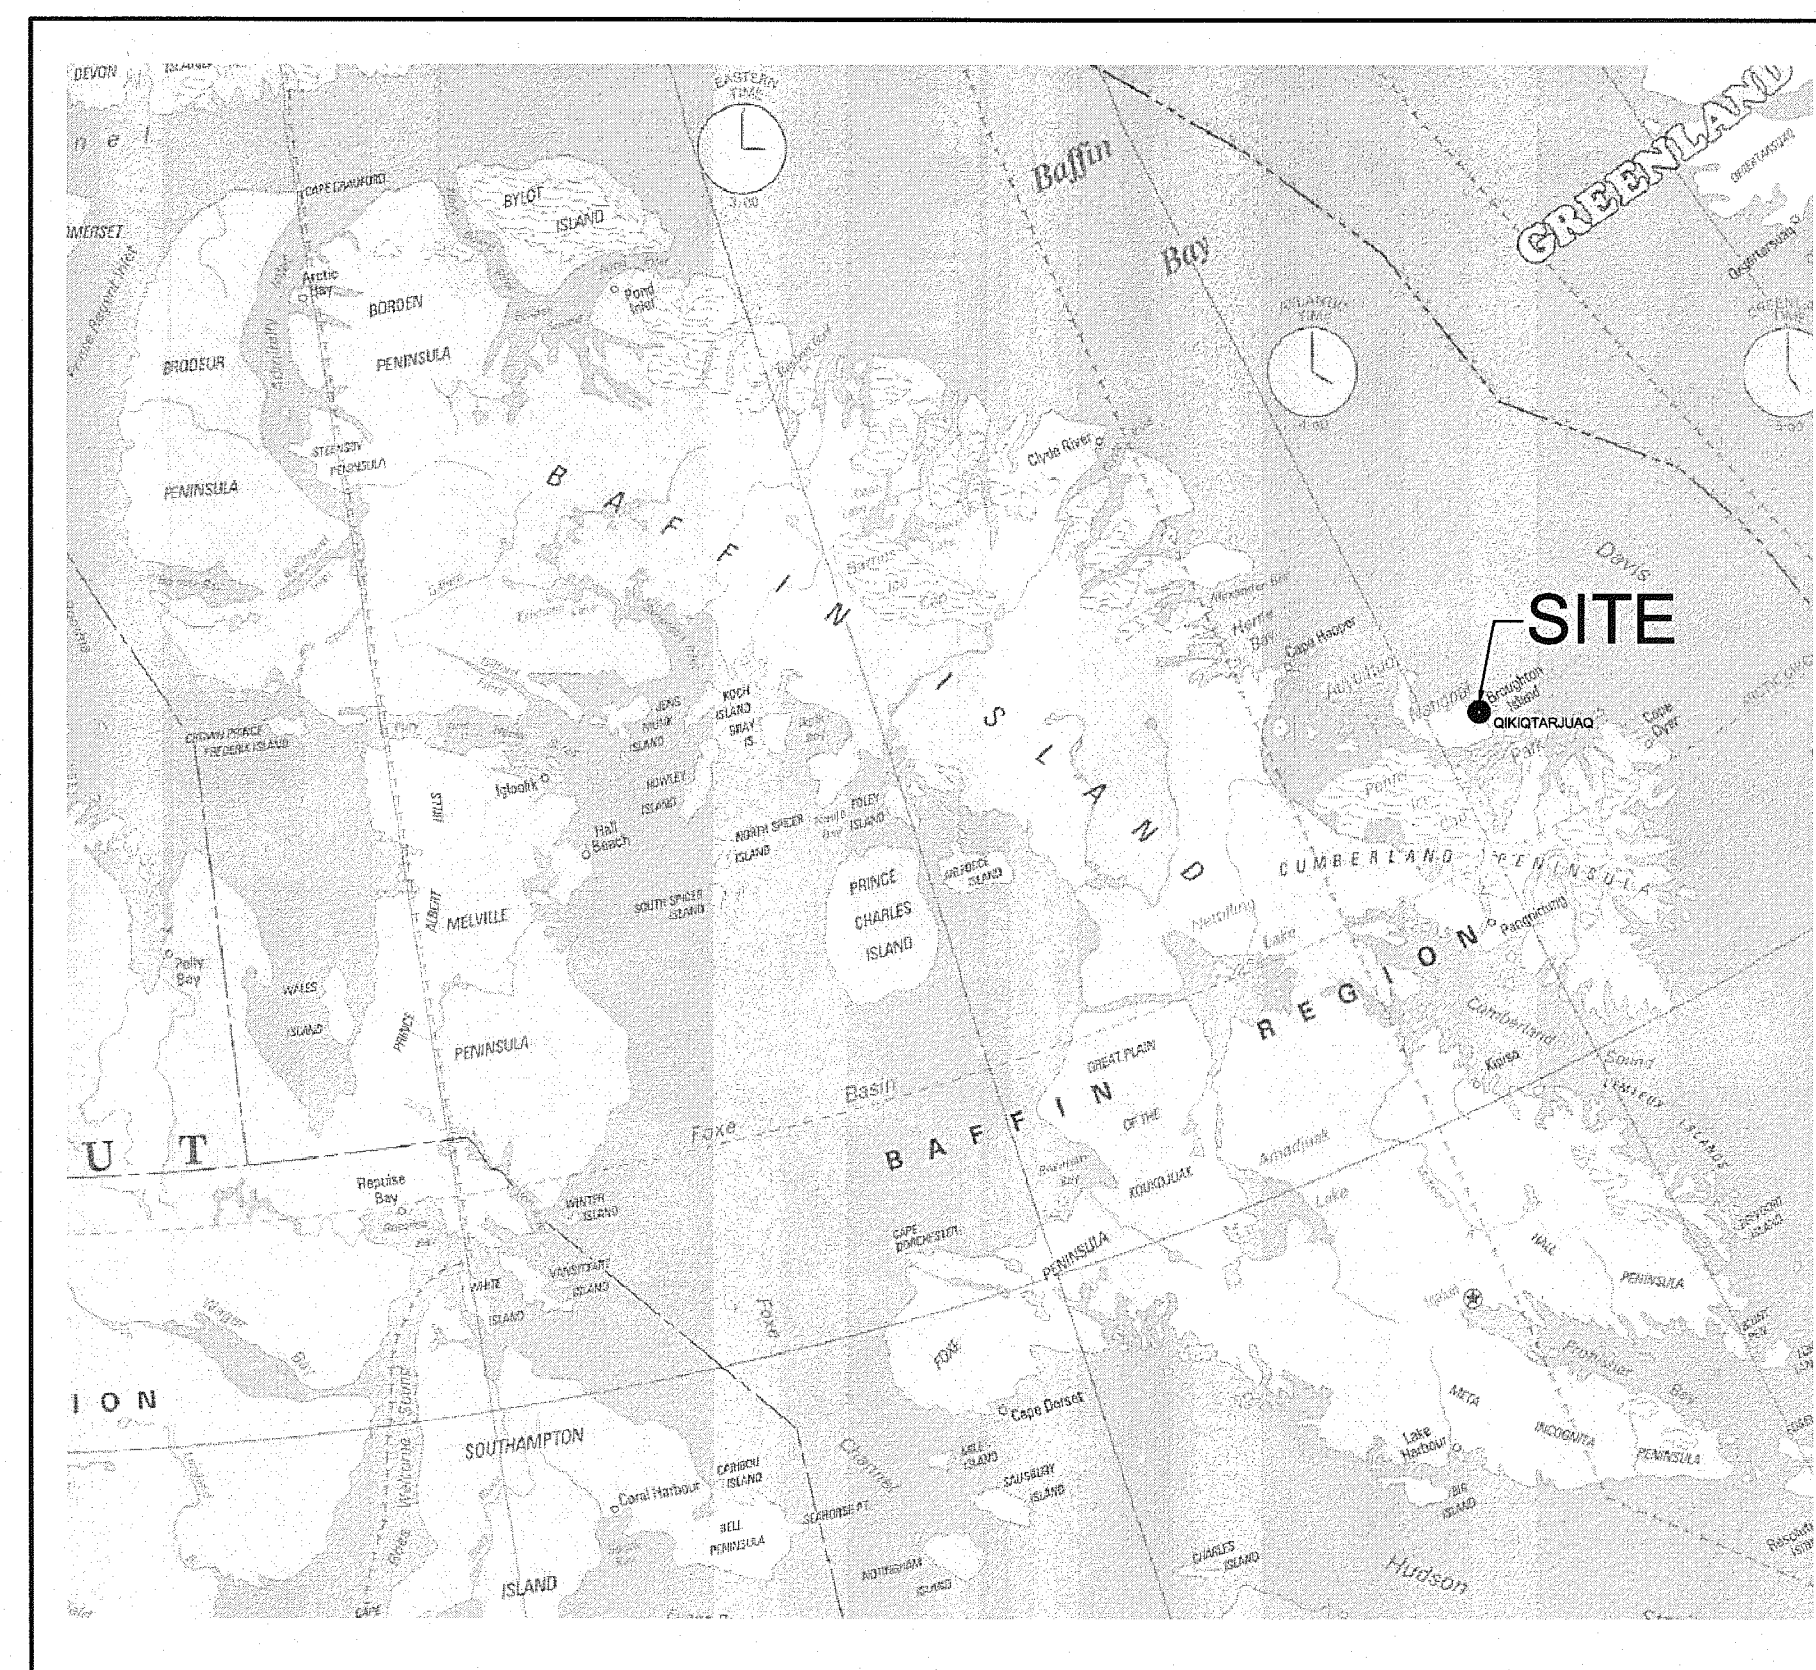

Map Reference:  
Map of Canada  
Published by the CIA

KEY MAP

## DRAWING INDEX

COVER PAGE AND DRAWING INDEX

- |                 |   |
|-----------------|---|
| <del>1</del>    | <del>EXISTING WATER RESERVOIR AND INTAKE</del>                        |
| <del>2</del>    | <del>WATER RESERVOIR AND INTAKE PHASE 1 EXPANSION</del>               |
| <del>3</del>    | <del>WATER RESERVOIR AND INTAKE EXPANSION</del>                       |
| <del>4</del>    | <del>WATER RESERVOIR AND INTAKE X-SECTIONS AND PROFILES SHEET 1</del> |
| <del>5</del>    | <del>WATER RESERVOIR AND INTAKE X-SECTIONS AND PROFILES SHEET 2</del> |
| <del>6</del>    | <del>WATER RESERVOIR AND INTAKE X-SECTIONS AND PROFILES SHEET 3</del> |
| <del>7</del>    | <del>WATER RESERVOIR AND INTAKE DETAILS</del>                         |
| <del>8</del>    | <del>SEWAGE LAGOON PLAN</del>   |
| <del>9</del>    | <del>SEWAGE LAGOON SECTIONS</del>                                     |
| <del>10</del>   | <del>SEWAGE LAGOON DETAILS</del>                                      |
| <del>11</del>   | <del>EXISTING SOLID WASTE DISPOSAL FACILITY (LANDFILL)</del>          |
| <del>12</del>   | <del>SOLID WASTE DISPOSAL FACILITY (LANDFILL) UPGRADES</del>          |
| <del>13</del>   | <del>MUNICIPAL SOLID WASTE DISPOSAL AREA UPGRADES</del>               |
| <del>14</del>   | <del>BULKY METALS DISPOSAL AREA UPGRADES AND DETAILS</del>            |
| <del>15</del>   | <del>TRUCK FILL STATION UPGRADES FLOOR PLAN AND X-SECTIONS</del>      |
| <del>E-01</del> | <del>ELECTRICAL MODIFICATIONS</del>                                   |

**NOTE:**  
**AS-BUILT**  
This drawing has been prepared by "Nuna Burnside Engineering and Environmental Ltd." based solely on information provided by a third party that reflects the constructed conditions of the system and is believed to be correct. Those relying on this information are advised to obtain independent verification as to its accuracy before applying it for any purpose.

**नूना BURNSIDE**

Nuna Burnside Engineering and Environmental Ltd.  
Box 175, 25 Third Avenue, Rankin Inlet, NU.  
telephone (867) 645-2762 fax (867) 645-2765  
15 Townline, Orangeville, Ontario  
telephone (519) 941-0342 fax (519) 941-8120  
email info@nunaburnside.com  
web www.nunaburnside.com

PROJECT NO. N-0 09439