




APPROVED BY \_\_\_\_\_ DATE \_\_\_\_\_

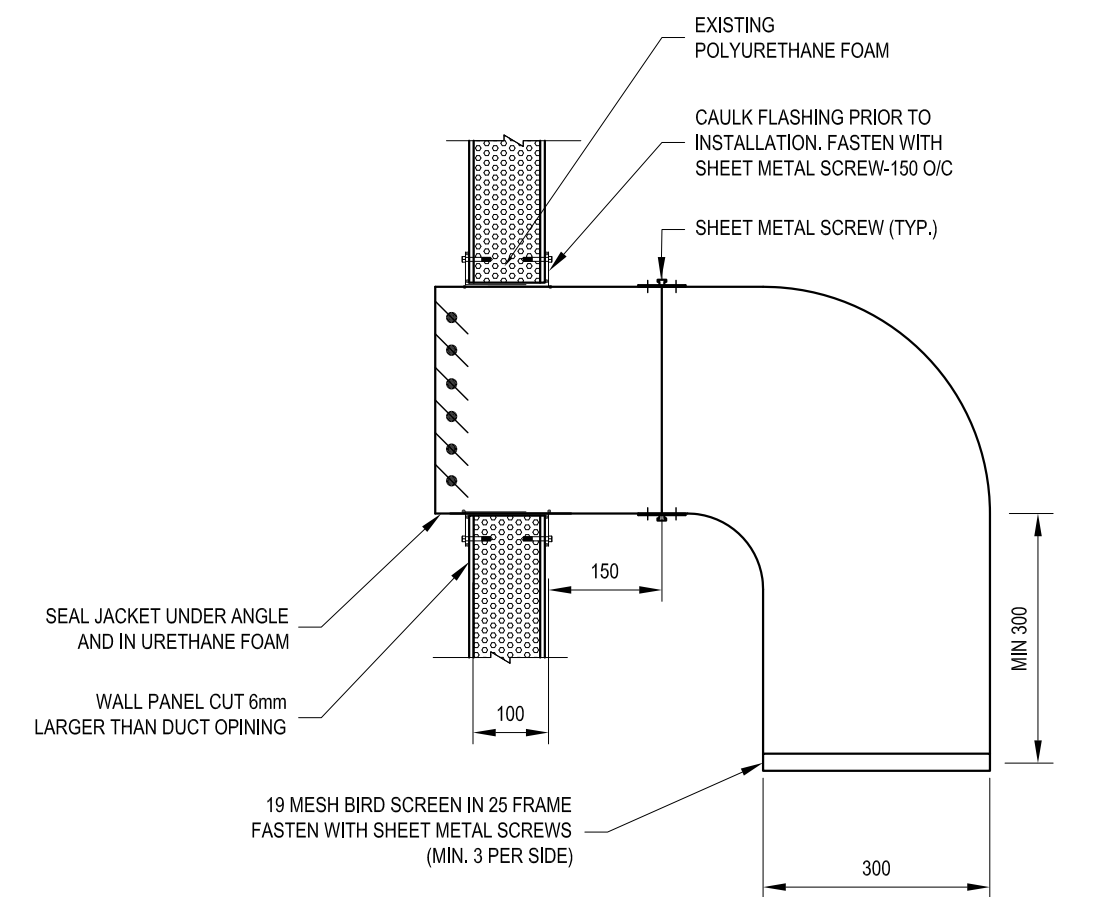

5 WEATHERHEAD WALL PENETRATION DETAIL  
201 201 SCALE 1:10

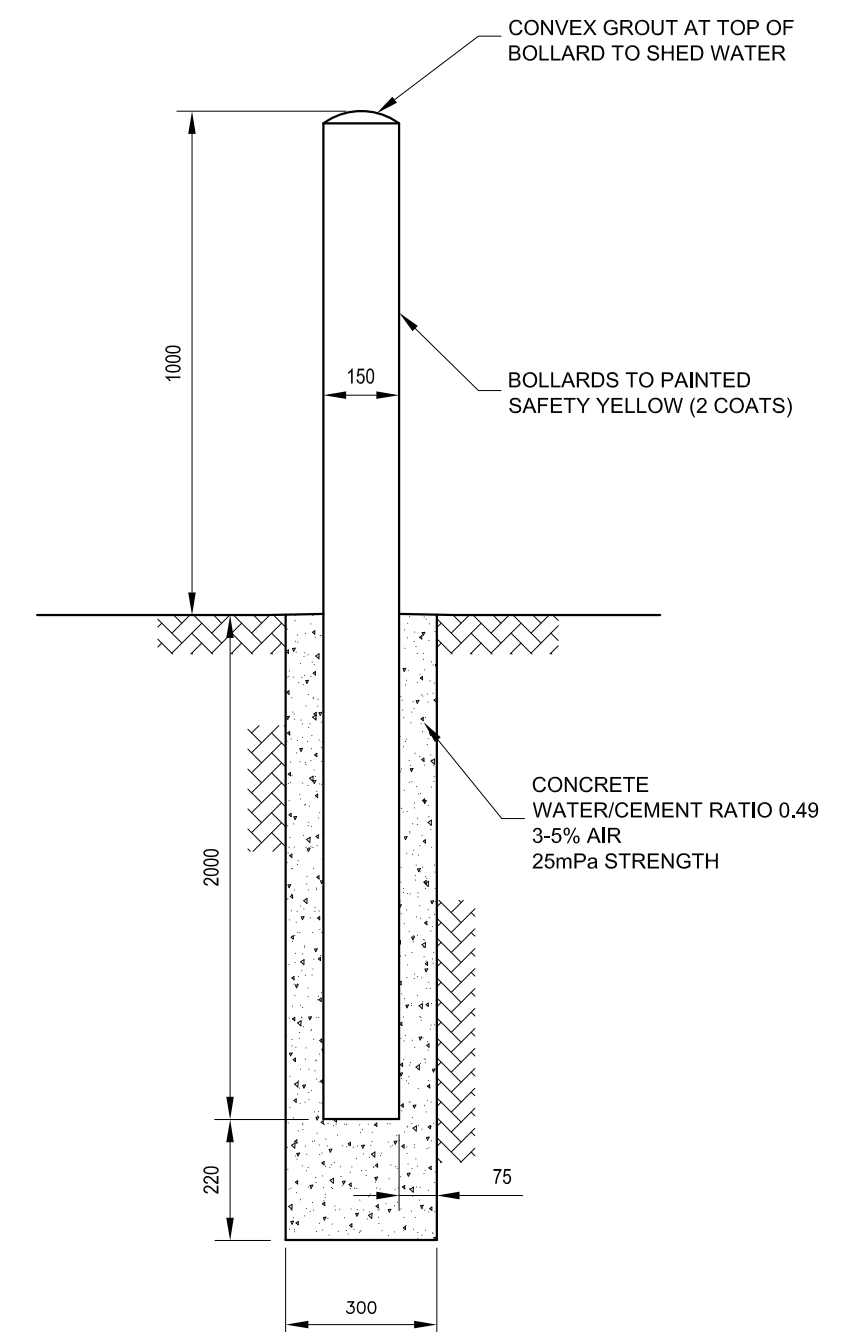

6 BOLLARD DETAIL  
201 201 SCALE N.T.S.

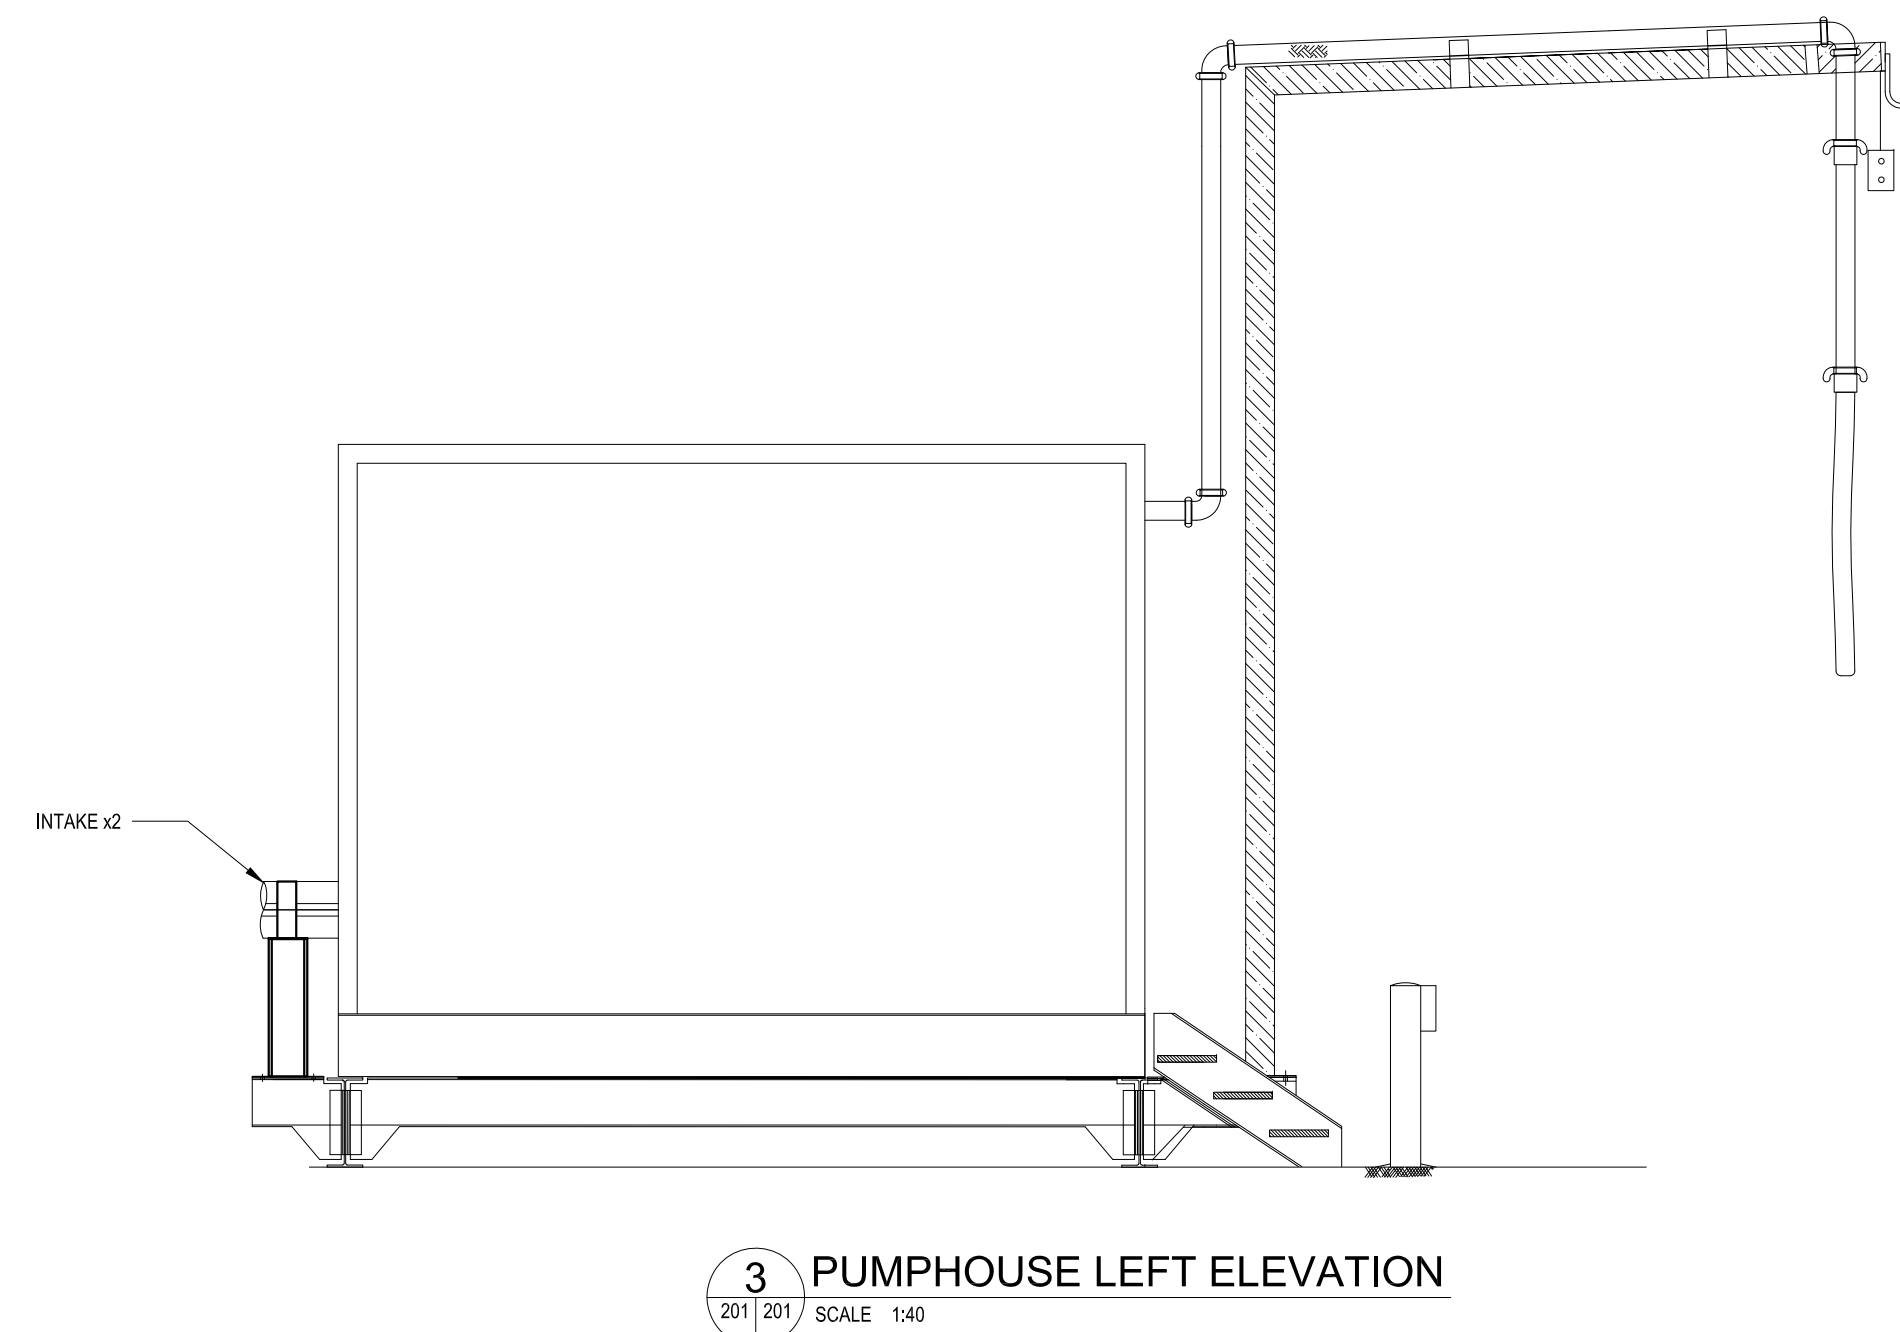

3 PUMPHOUSE LEFT ELEVATION  
201 201 SCALE 1:40

\\file\Name:g:\cad\078107\record drawings\201.dwg

THIS RECORD DOCUMENT HAS BEEN PREPARED BASED IN PART UPON INFORMATION FURNISHED BY OTHERS, DILLON CONSULTING LTD. CANNOT ASSURE THE ACCURACY OF OTHERS' INFORMATION AND THUS IS NOT RESPONSIBLE FOR THE ACCURACY OF THIS RECORD DOCUMENT OR FOR ANY ERROR OR OMISSION THAT MAY HAVE BEEN INCORPORATED INTO IT AS A RESULT, THOSE RELYING ON THIS RECORD DOCUMENT ARE ADVISED TO OBTAIN INDEPENDENT VERIFICATION OF ITS ACCURACY BEFORE APPLYING IT FOR ANY PURPOSE.

[illegible]

**TALOYOAK WATER TREATMENT PLANT RECORD DRAWINGS  
TALOYOAK, NUNAVUT**

PROJECT NO.  
**07-8107-2000**

EET NO.

## PUMPHOUSE ELEVATIONS

201