



RECORD DRAWING


APPROVED BY _____ DATE _____

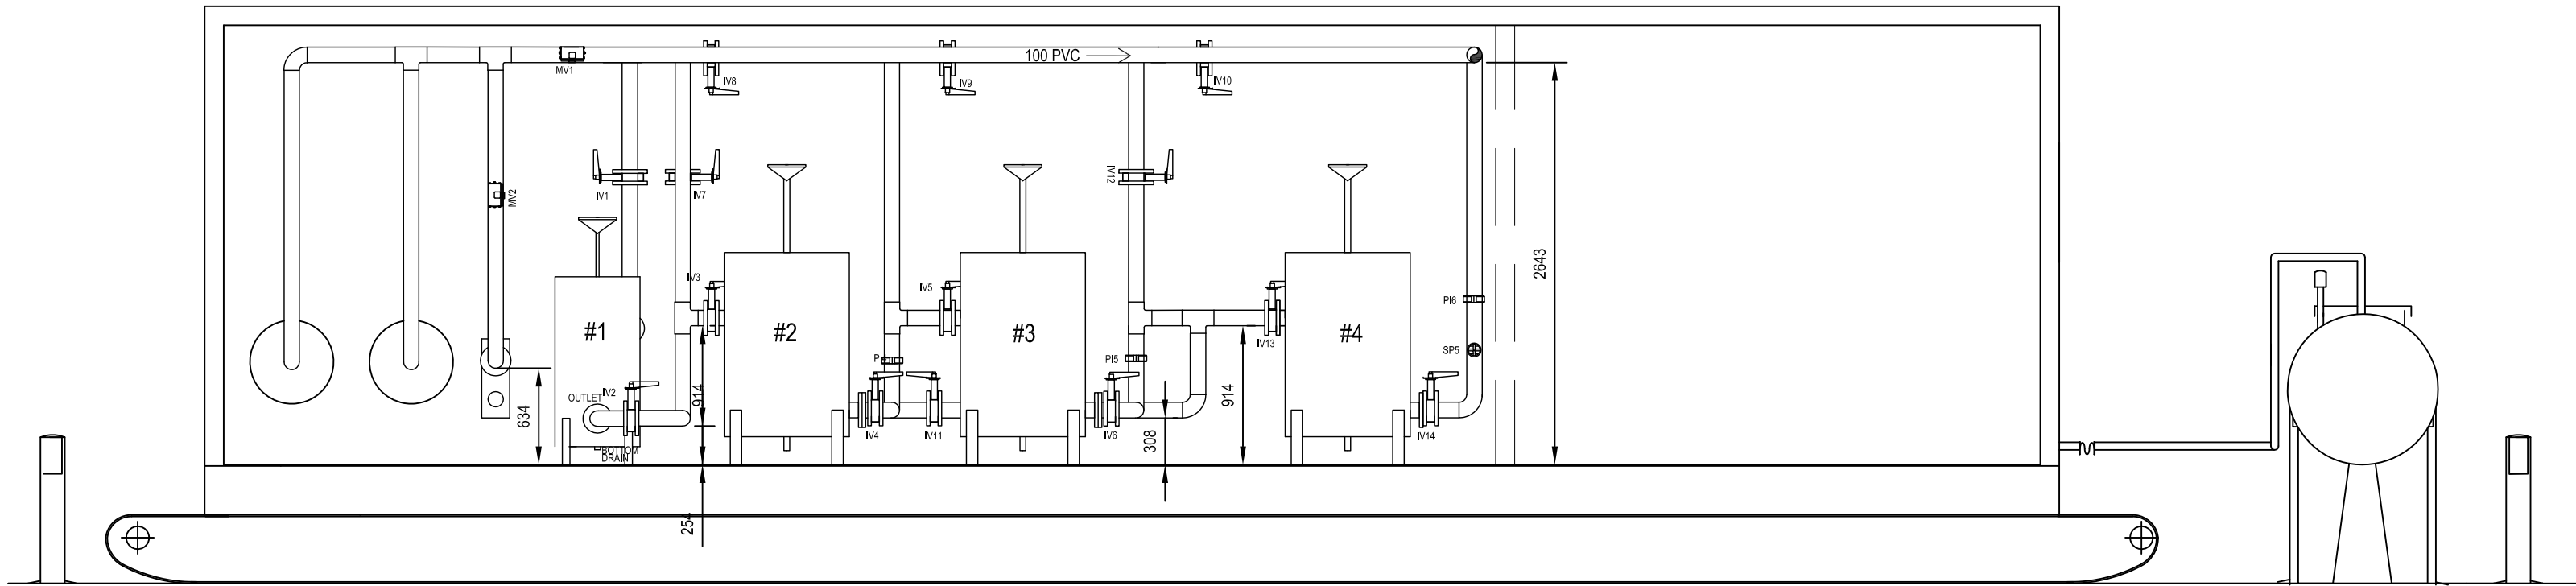


2 FRONT ELEVATION
304 304 SCALE 1:40

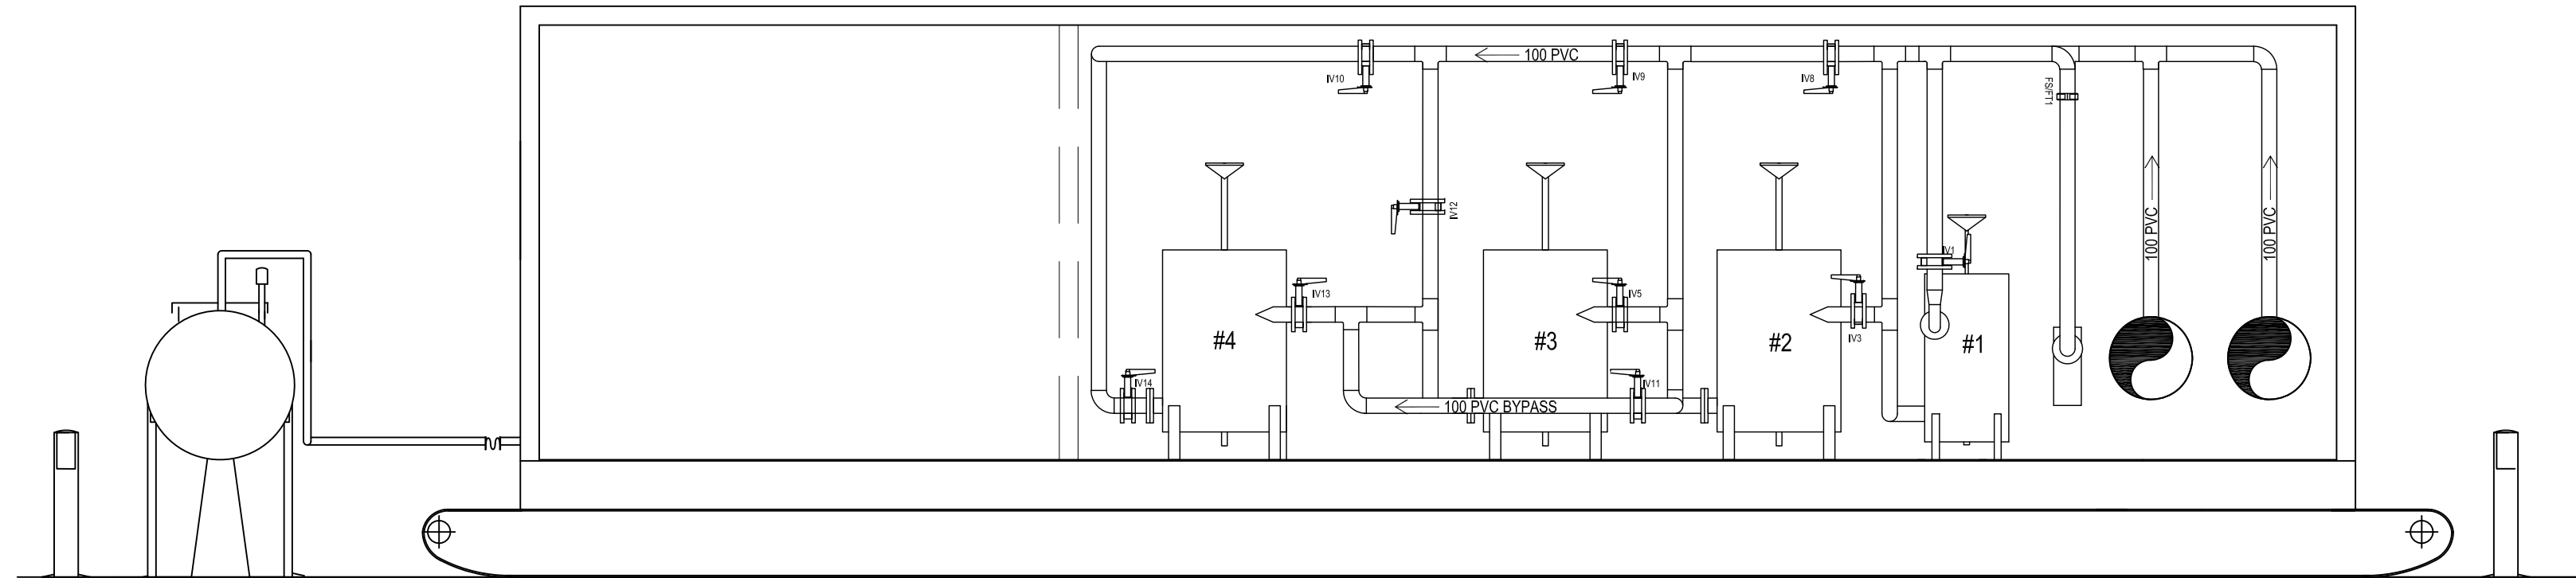

3 BACK ELEVATION
304 304 SCALE 1:40

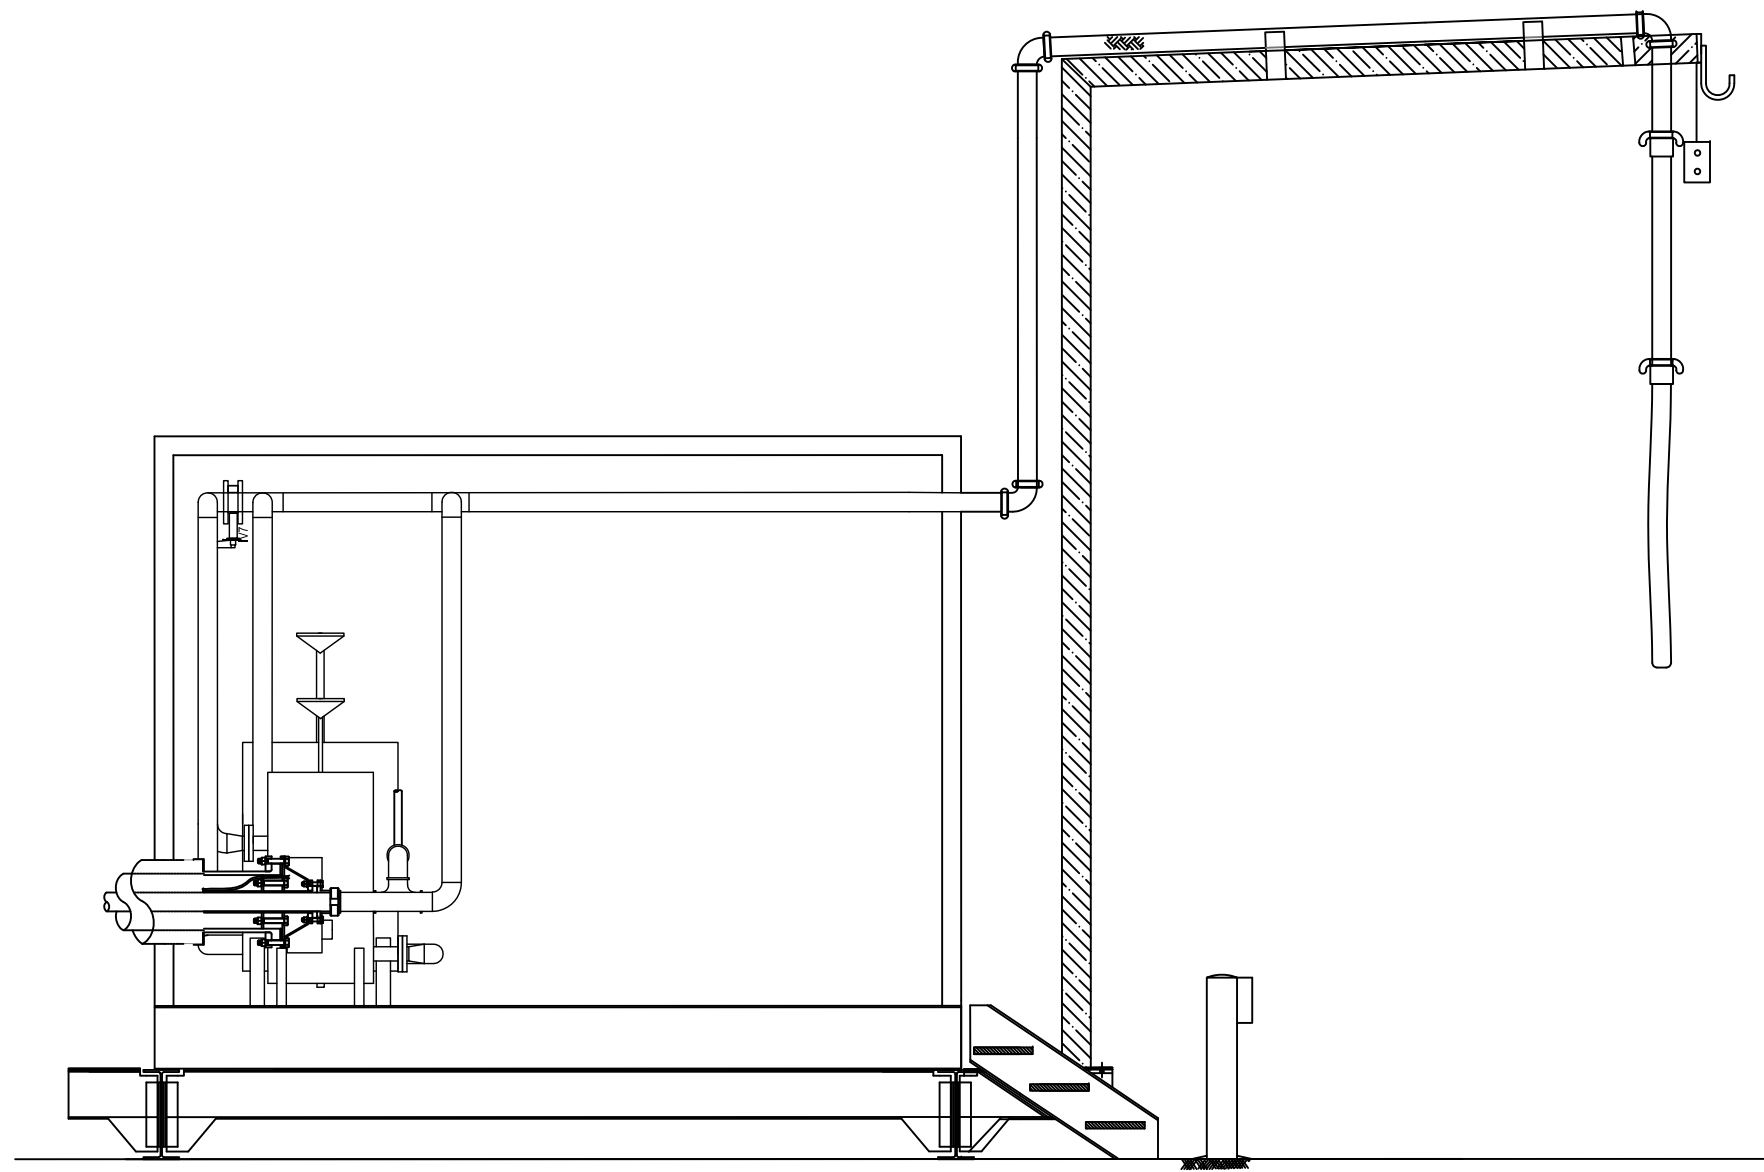

4 LEFT ELEVATION
304 304 SCALE 1:40

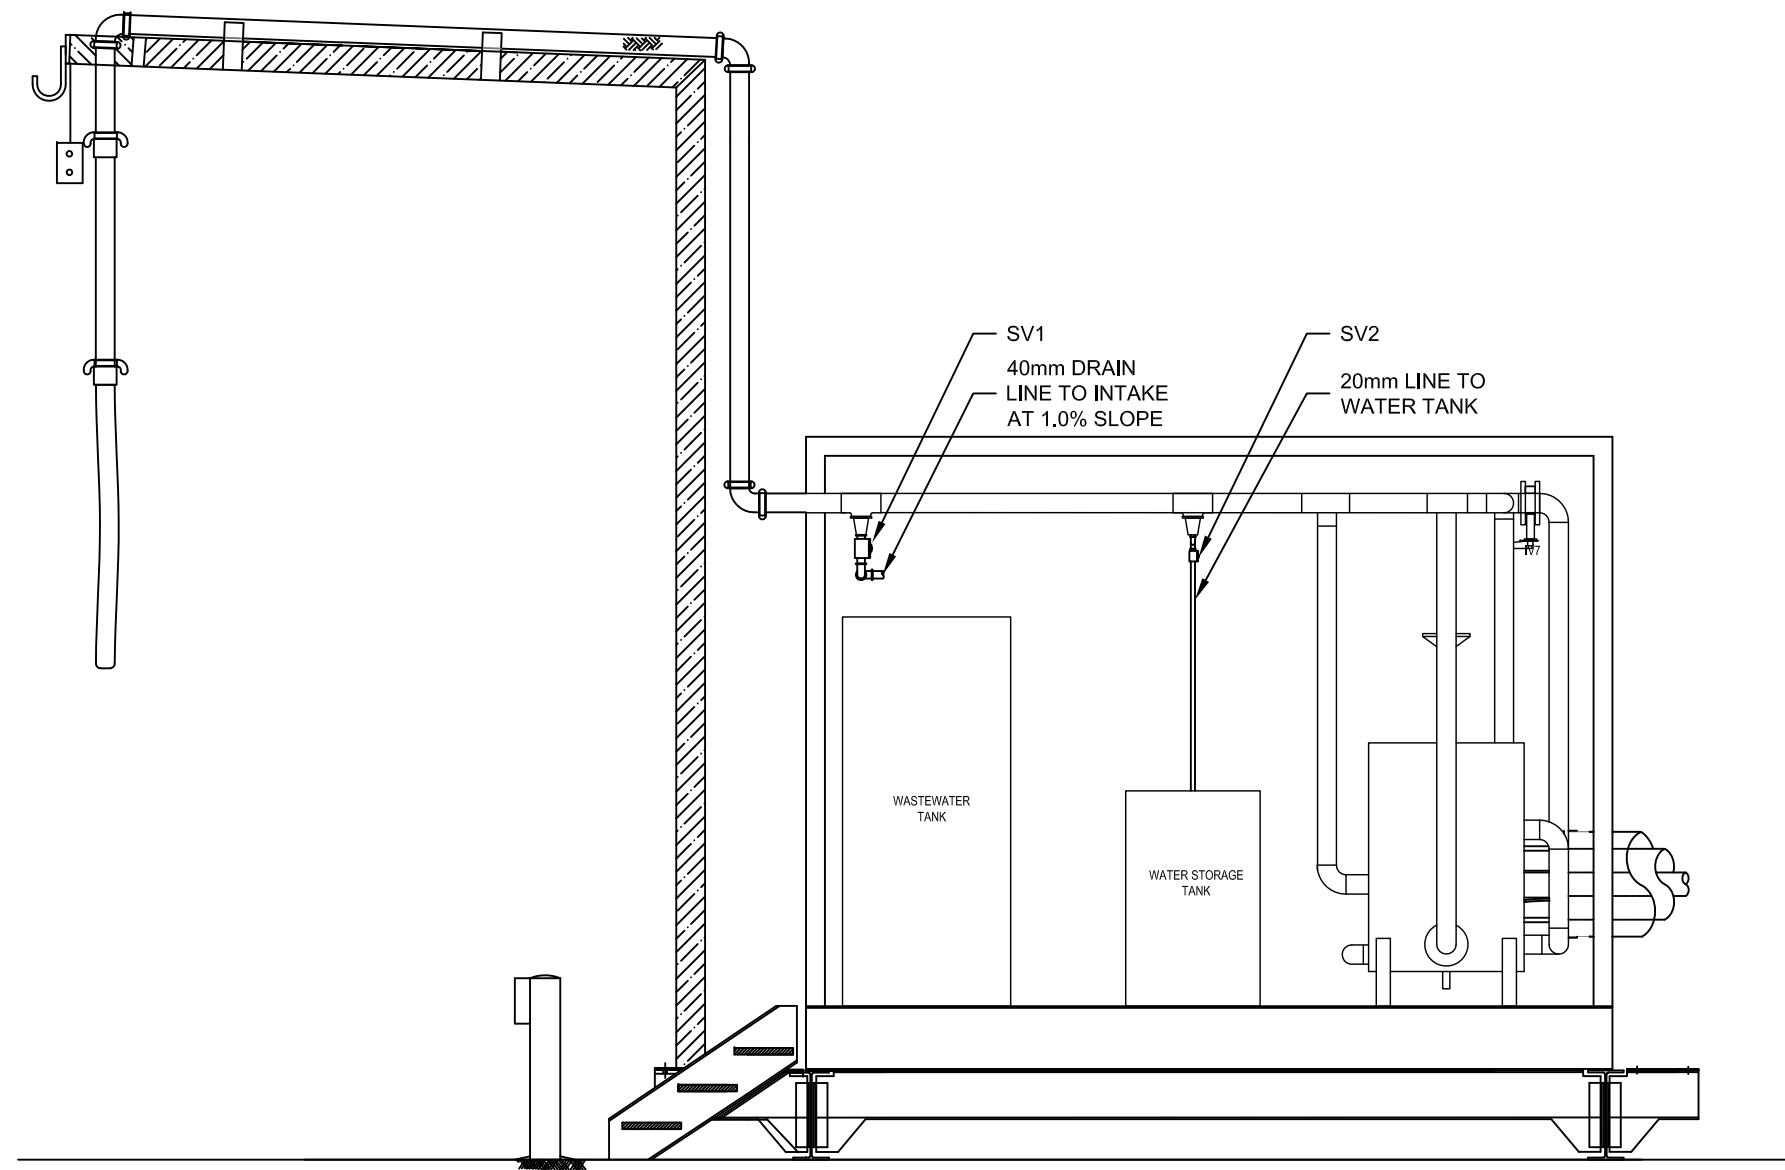

5 RIGHT ELEVATION
304 304 SCALE 1:40

4820 47TH STREET, YELLOWKNIFE NT, X1A 2P1, PHONE 867-920-4555

F:\hmc\gs\cad\07107\record drawings\304-304.dwg

THIS RECORD DOCUMENT HAS BEEN PREPARED BASED IN PART UPON INFORMATION FURNISHED BY OTHERS. DILLON CONSULTING LTD. CANNOT ASSURE THE ACCURACY OF OTHERS' INFORMATION AND THIS IS NOT RESPONSIBLE FOR THE ACCURACY OF THIS RECORD DOCUMENT OR FOR ANY ERROR OR OMISSION THAT MAY HAVE BEEN INCORPORATED INTO IT. AS A RESULT, THOSE RELYING ON THIS RECORD DOCUMENT ARE ADVISED TO OBTAIN INDEPENDENT VERIFICATION OF ITS ACCURACY BEFORE APPLYING IT FOR ANY PURPOSE.



			DESIGN	GS	REVIEWED BY	GS
			DRAWN	NTB	CHECKED BY	GS
			DATE	MARCH 2012		
			SCALE	HOR: 1:500 VERT: 1:50		
No.	ISSUED FOR	DATE	BY			
5	ASBUILT DRAWING	03/28/12	GS			
5	RE-ISSUED FOR TENDER	01/05/10	GS			
4	RE-ISSUED FOR TENDER	01/28/09	GS			
3	ISSUED FOR TENDER	06/06/08	GS			
2	ISSUED FOR 100% CLIENT REVIEW	04/30/08	GS			
1	ISSUED FOR CLIENT REVIEW	03/15/08	GS			

TALOYOAK WATER TREATMENT PLANT RECORD DRAWINGS
TALOYOAK, NUNAVUT

PROJECT NO.
07-8107-2000

FILTER PROCESS SYSTEM - SECTIONS

SHEET NO.

304