



APPROVED BY	DATE
-------------	------



CH₃Memorandum#078407second submission\404.doc

THIS RECORD DOCUMENT HAS BEEN PREPARED BASED IN PART UPON INFORMATION FURNISHED BY OTHERS. DILLON CONSULTING LTD. CANNOT ASSURE THE ACCURACY OF OTHERS' INFORMATION AND THUS IS NOT RESPONSIBLE FOR THE ACCURACY OF THIS RECORD DOCUMENT OR FOR ANY ERROR OR OMISSION THAT MAY HAVE BEEN INCORPORATED INTO IT AS A RESULT. THOSE RELYING ON THIS RECORD DOCUMENT ARE ADVISED TO OBTAIN INDEPENDENT VERIFICATION OF ITS ACCURACY BEFORE APPLYING IT FOR ANY PURPOSE.

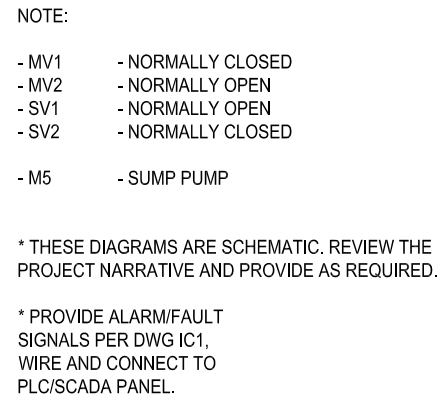

				DESIGN SAI	REVIEWED BY GS	TALOYOAK WATER TREATMENT PLANT RECORD DRAWINGS TALOYOAK, NUNAVUT	PROJECT NO. 07-8107-2000		
				DRAWN JPM	CHECKED BY GS		CONTROL DIAGRAM	SHEET NO. 404	
	ASBUILT DRAWING	03/28/12	GS	DATE MARCH 2012					
5	RE-ISSUED FOR TENDER	01/05/10	GS						
4	RE-ISSUED FOR TENDER	01/28/09	GS						
3	ISSUED FOR TENDER	06/06/08	GS						
2	ISSUED FOR 100% CLIENT REVIEW	04/30/08	GS						
1	ISSUED FOR CLIENT REVIEW	03/15/08	GS	SCALE NTS					
No.	ISSUED FOR	DATE	BY						