

BI Pure Water  
(Canada) Inc.  
#2, 9790 - 190th Street  
Surrey, BC V4N 3M9  
Phone: (604) 882-6650  
Fax: (604) 882-6659  
http://www.bipurewater.ca

THE INFORMATION CONTAINED IN THIS  
DRAWING IS THE SOLE PROPERTY OF  
**BI PURE WATER (CANADA) INC.**  
ANY REPRODUCTION IN PART OR WHOLE  
OF THE INFORMATION HEREIN, WITHOUT  
THE WRITTEN PERMISSION OF  
BI PUREWATER (CANADA) INC.,  
IS STRICTLY PROHIBITED.

Status

AS PER  
RECORD

Issue	Date	App'd	Revision Description
05	MAR 26/12	JT	AS PER RECORD
04	MAR 14/12	JT	AS PER RECORD
03	NOV 4/11	JT	AS PER RECORD
02	JUN 15/10	JT	ISSUED FOR CONSTRUCTION
01	MAY 14/10	JT	ISSUED FOR APPROVAL

Design By:	JT
Drawn By:	RS
Checked By:	
Submitted	
Approved	

Client:


KITNUNA  
PROJECTS  
INC.

Title: PIPING & EQUIPMENT LAYOUT

Project: TALOYOAK WATER  
TREATMENT SYSTEM  
UPGRADE

Drawing #: 1772-ME-102

Scale	Date
14/05/2010	
Sheet	1 of 4
Job#	
Rev:	05

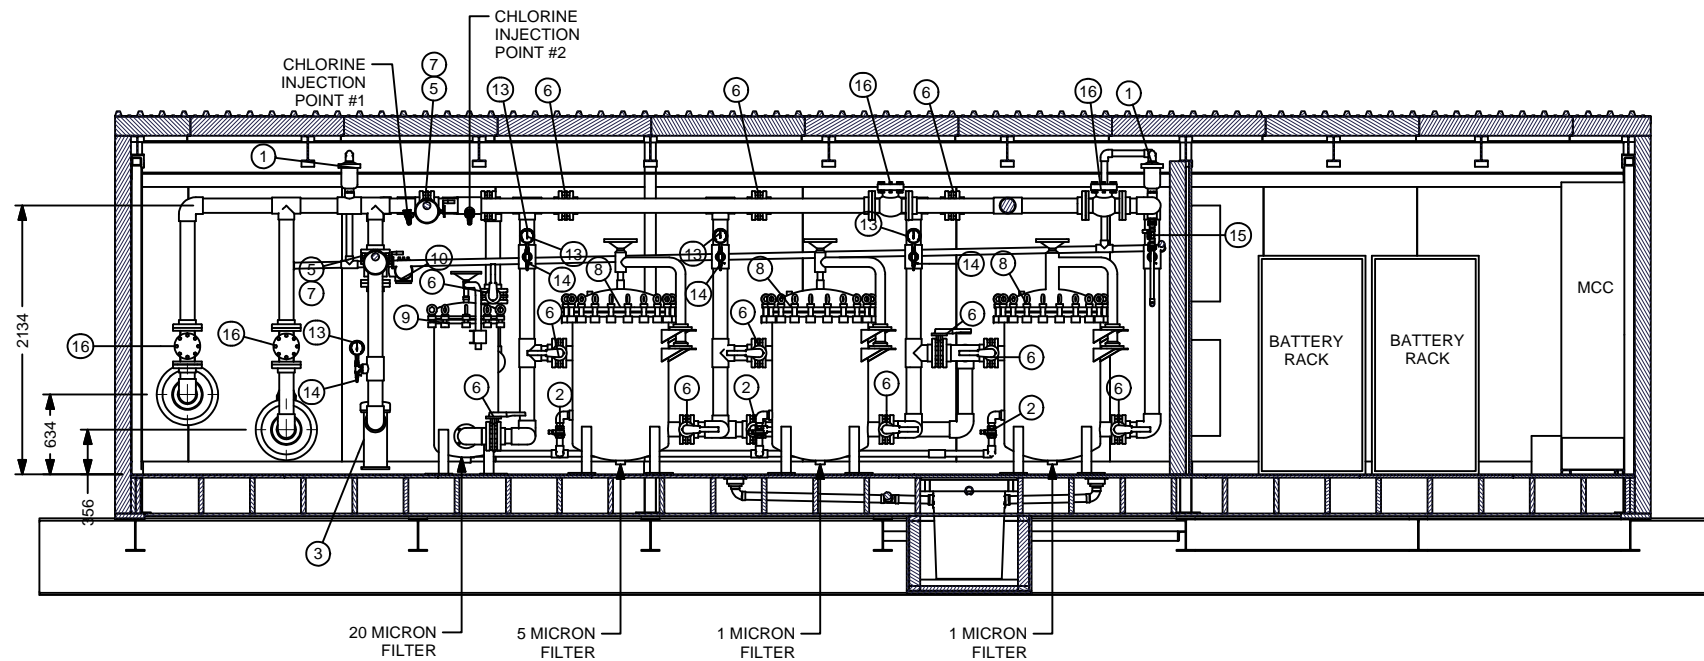

SECTION A-A



BI Pure Water  
(Canada) Inc.  
#2, 9790 - 190th Street  
Surrey, BC V4N 3M9  
Phone: (604) 882-6650  
Fax: (604) 882-6659  
<http://www.bipurewater.ca>

THE INFORMATION CONTAINED IN THIS  
DRAWING IS THE SOLE PROPERTY OF  
**BI PURE WATER (CANADA) INC.**  
ANY REPRODUCTION IN PART OR WHOLE  
OF THE INFORMATION HEREIN, WITHOUT  
THE WRITTEN PERMISSION OF  
BI PUREWATER (CANADA) INC.,  
IS STRICTLY PROHIBITED.

Status

AS PER  
RECORD

Issue	Date	App'd	Revision Description
05	MAR 26/12	JT	AS PER RECORD
04	MAR 14/12	JT	AS PER RECORD
03	NOV 4/11	JT	AS PER RECORD
02	JUN 15/10	JT	ISSUED FOR CONSTRUCTION
01	MAY 14/10	JT	ISSUED FOR APPROVAL

Design By:	JT
Drawn By:	RS
Checked By:	
Submitted	
Approved	

Client:


KITNUNA  
PROJECTS  
INC.

Title: PIPING & EQUIPMENT LAYOUT

Project: TALOYOAK WATER  
TREATMENT SYSTEM  
UPGRADE

Drawing #: 1772-ME-102

Scale	
Date	14/05/2010
Sheet	2 of 4
Job#	
Rev:	05

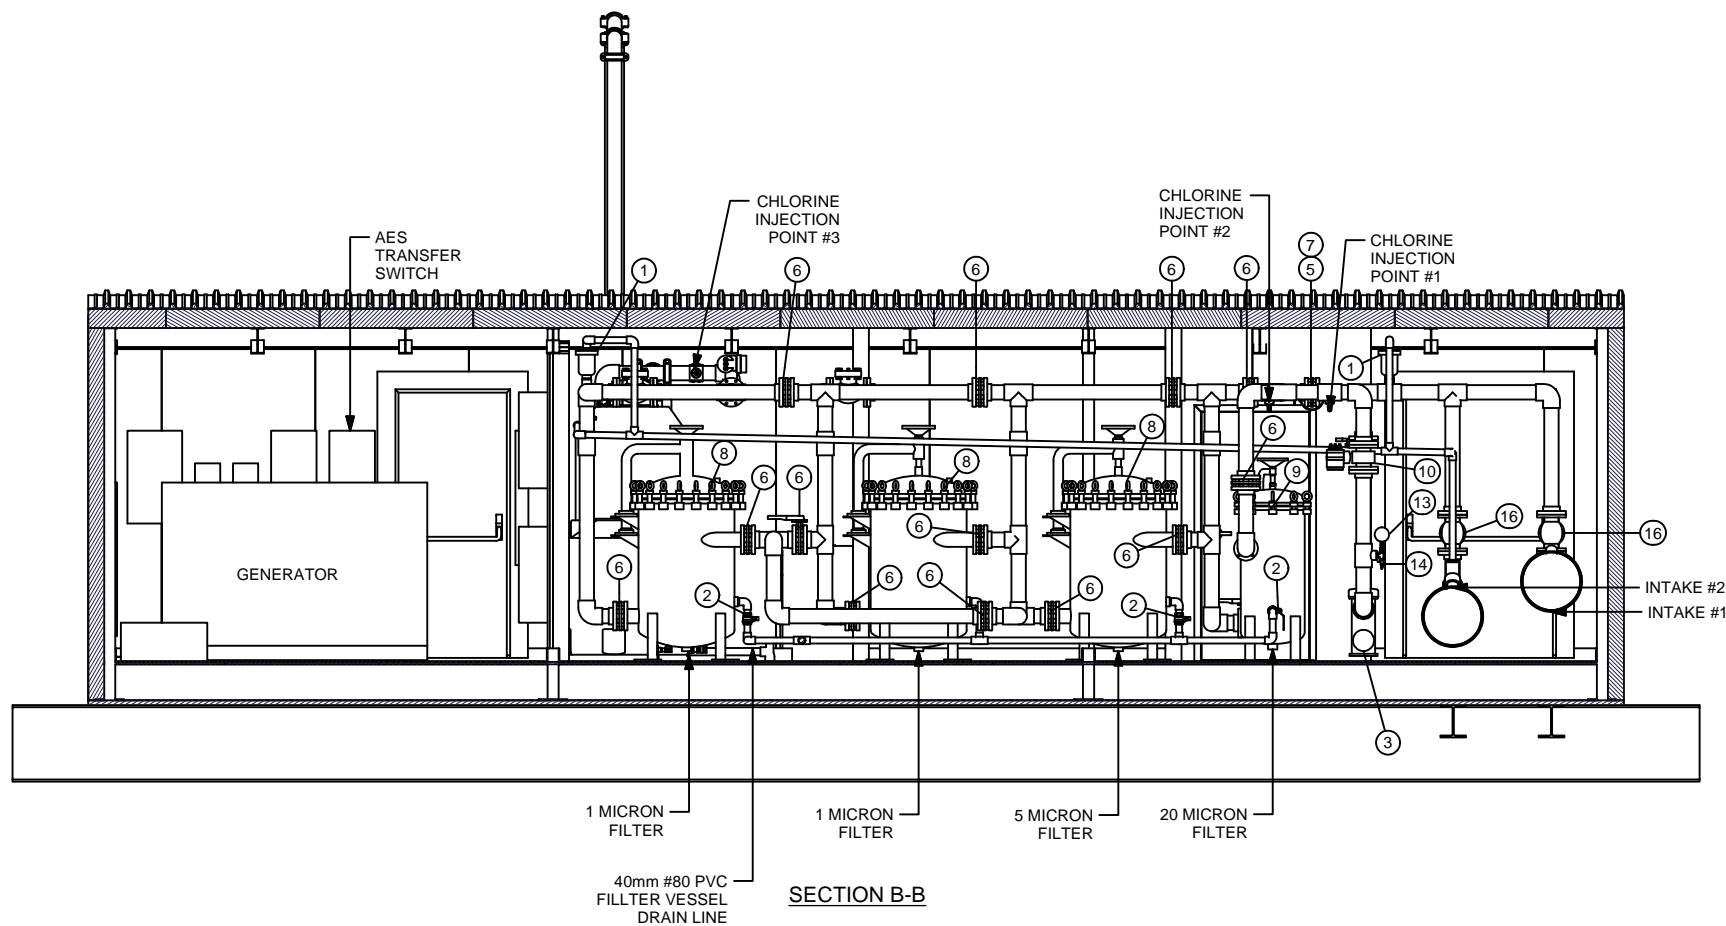

BI Pure Water  
(Canada) Inc.  
#2, 9790 - 190th Street  
Surrey, BC V4N 3M9  
Phone: (604) 882-6650  
Fax: (604) 882-6659  
<http://www.bipurewater.ca>

THE INFORMATION CONTAINED IN THIS DRAWING IS THE SOLE PROPERTY OF **BI PURE WATER (CANADA) INC.**  
ANY REPRODUCTION IN PART OR WHOLE OF THE INFORMATION HEREIN, WITHOUT THE WRITTEN PERMISSION OF BI PUREWATER (CANADA) INC., IS STRICTLY PROHIBITED.

Status

AS PER  
RECORD

Issue	Date	App'd	Revision Description
05	MAR 26/12	JT	AS PER RECORD
04	MAR 14/12	JT	AS PER RECORD
03	NOV 4/11	JT	AS PER RECORD
02	JUN 15/10	JT	ISSUED FOR CONSTRUCTION
01	MAY 14/10	JT	ISSUED FOR APPROVAL

Design By: JT  
Drawn By: RS  
Checked By:  
Submitted  
Approved

Client:

KITNUNA  
PROJECTS  
INC.

Title: PIPING & EQUIPMENT LAYOUT

Project: TALOYOAK WATER  
TREATMENT SYSTEM  
UPGRADE

Drawing #: 1772-ME-102


Scale

Date 14/05/2010

Sheet 3 of 4

Job#

Rev: 05

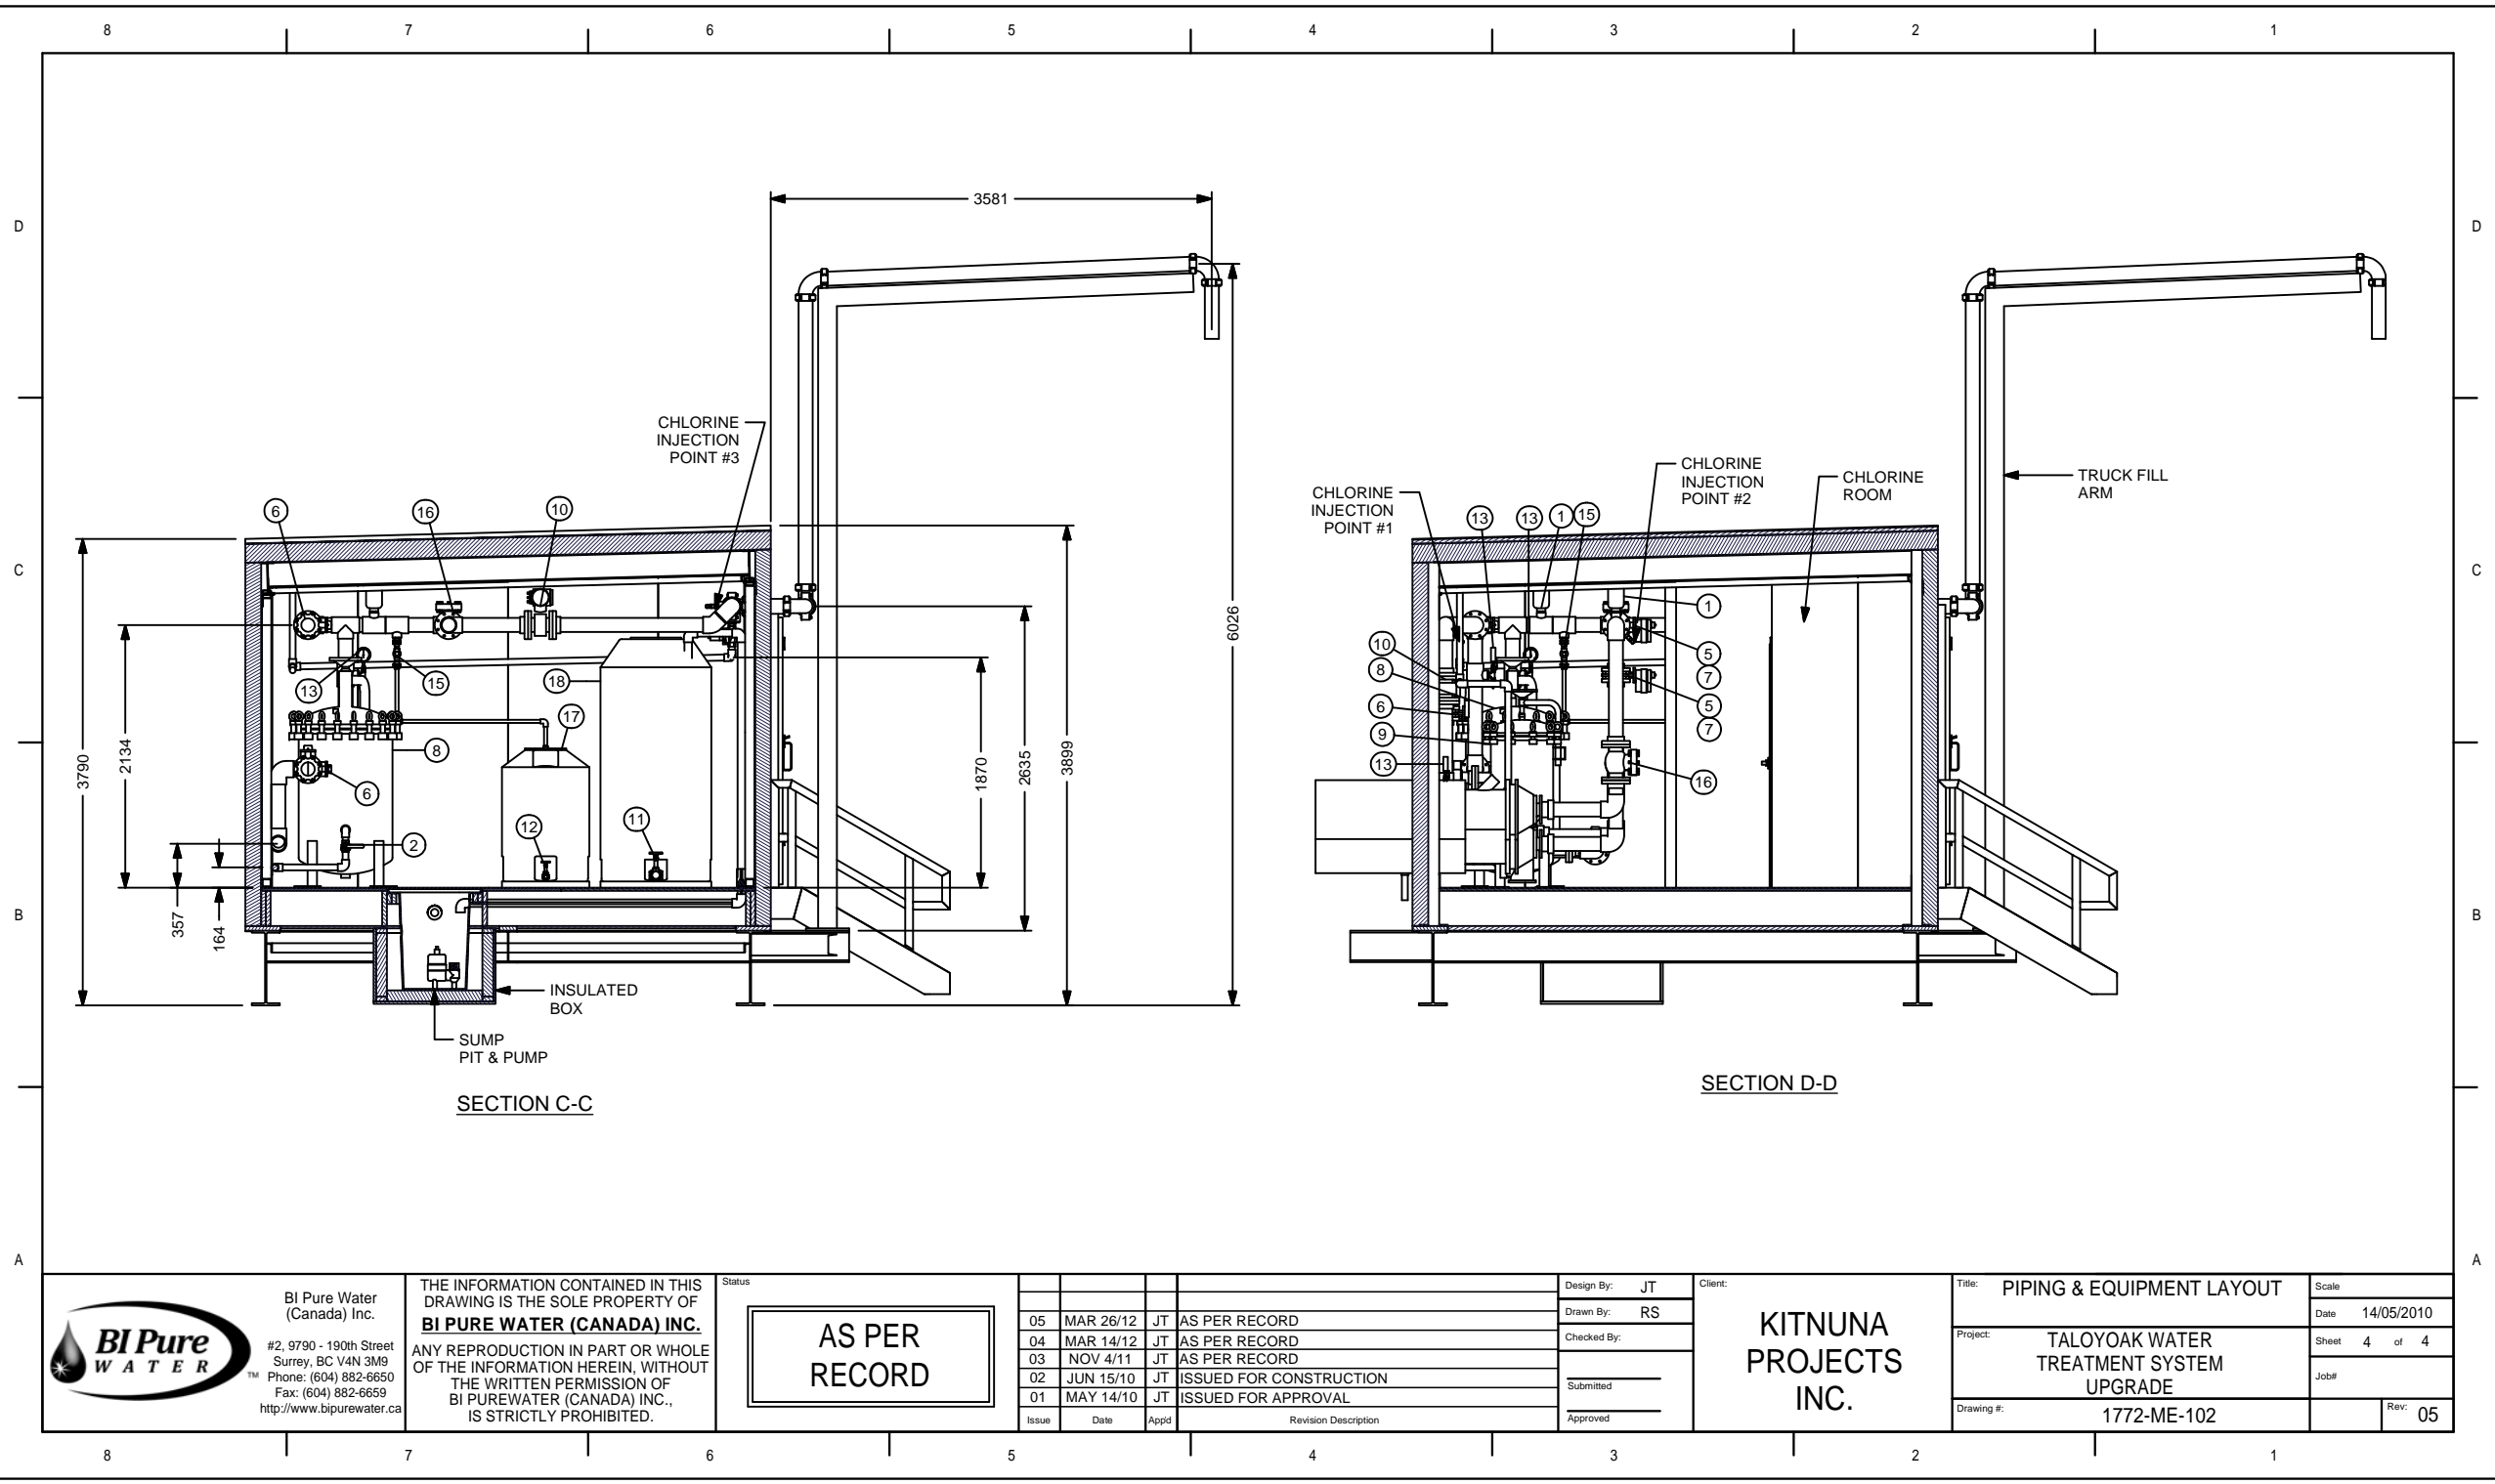

BI Pure Water  
(Canada) Inc.  
#2, 9790 - 190th Street  
Surrey, BC V4N 3M9  
Phone: (604) 882-6650  
Fax: (604) 882-6659  
<http://www.bipurewater.ca>

THE INFORMATION CONTAINED IN THIS  
DRAWING IS THE SOLE PROPERTY OF  
**BI PURE WATER (CANADA) INC.**  
ANY REPRODUCTION IN PART OR WHOLE  
OF THE INFORMATION HEREIN, WITHOUT  
THE WRITTEN PERMISSION OF  
BI PUREWATER (CANADA) INC.,  
IS STRICTLY PROHIBITED.

Status

AS PER  
RECORD

Issue	Date	App'd	Revision Description
05	MAR 26/12	JT	AS PER RECORD
04	MAR 14/12	JT	AS PER RECORD
03	NOV 4/11	JT	AS PER RECORD
02	JUN 15/10	JT	ISSUED FOR CONSTRUCTION
01	MAY 14/10	JT	ISSUED FOR APPROVAL

Design By:	JT
Drawn By:	RS
Checked By:	
Submitted	
Approved	

Client:	KITNUNA PROJECTS INC.	
Title:		PIPING & EQUIPMENT LAYOUT
Project:		TALOYOAK WATER TREATMENT SYSTEM UPGRADE
Drawing #:		1772-ME-102

Scale	Date	14/05/2010
Sheet	4	of 4
Job#		
Rev:	05	