


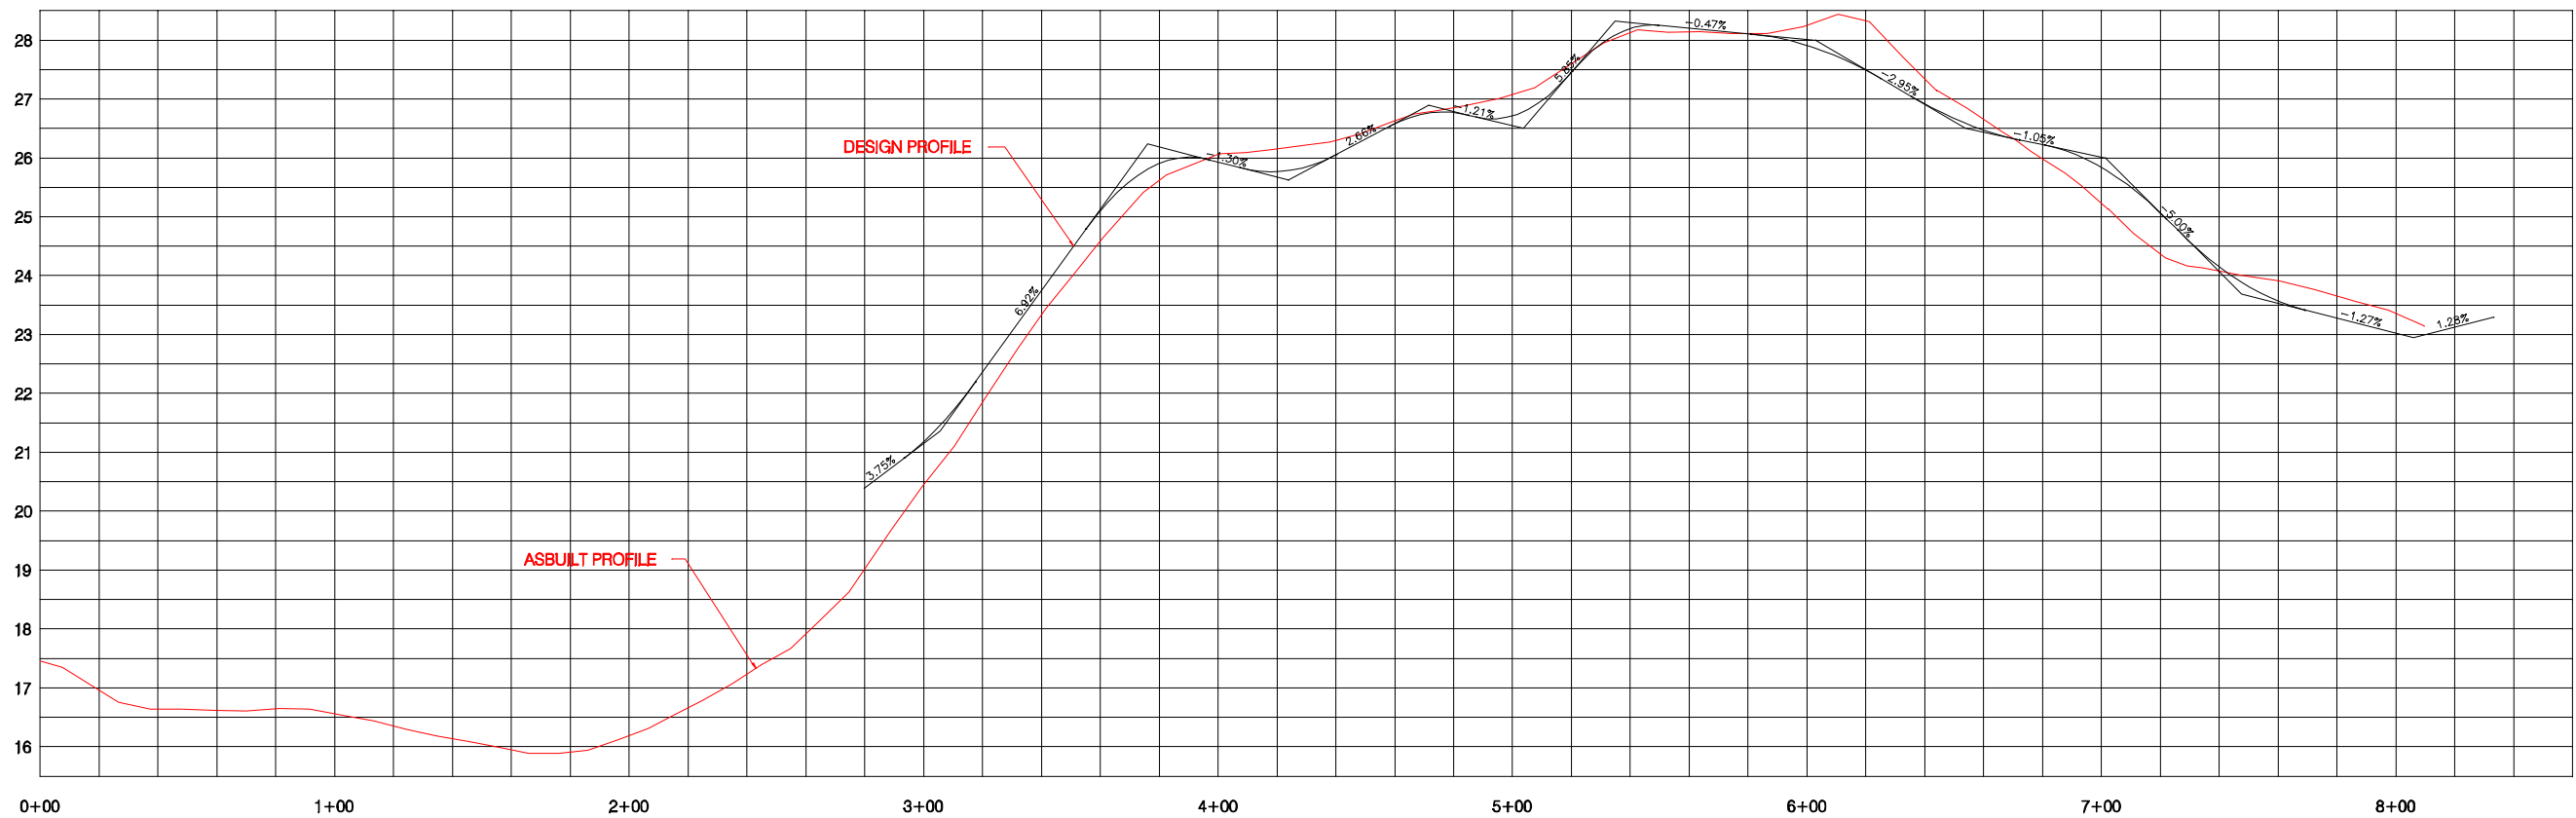

SOUTHWEST

WATER TREATMENT PLANT ROAD PROFILE

EAST



SCALE: 1:2500



NOTE:
RED INK DENOTES AS CONSTRUCTED SURVEY
BLANK INK DENOTES DILLON CONSULTING DESIGN

				Proj: WATER TREATMENT PLANT ROAD	
				Drwg: ROAD PROFILE	
				Drwn: P. Holtkamp A.Sc.T. 2011/10	
				Apvd:	Sht 2 of 6
No.	Date	By	Revision		


GNG
SURVEYS LTD

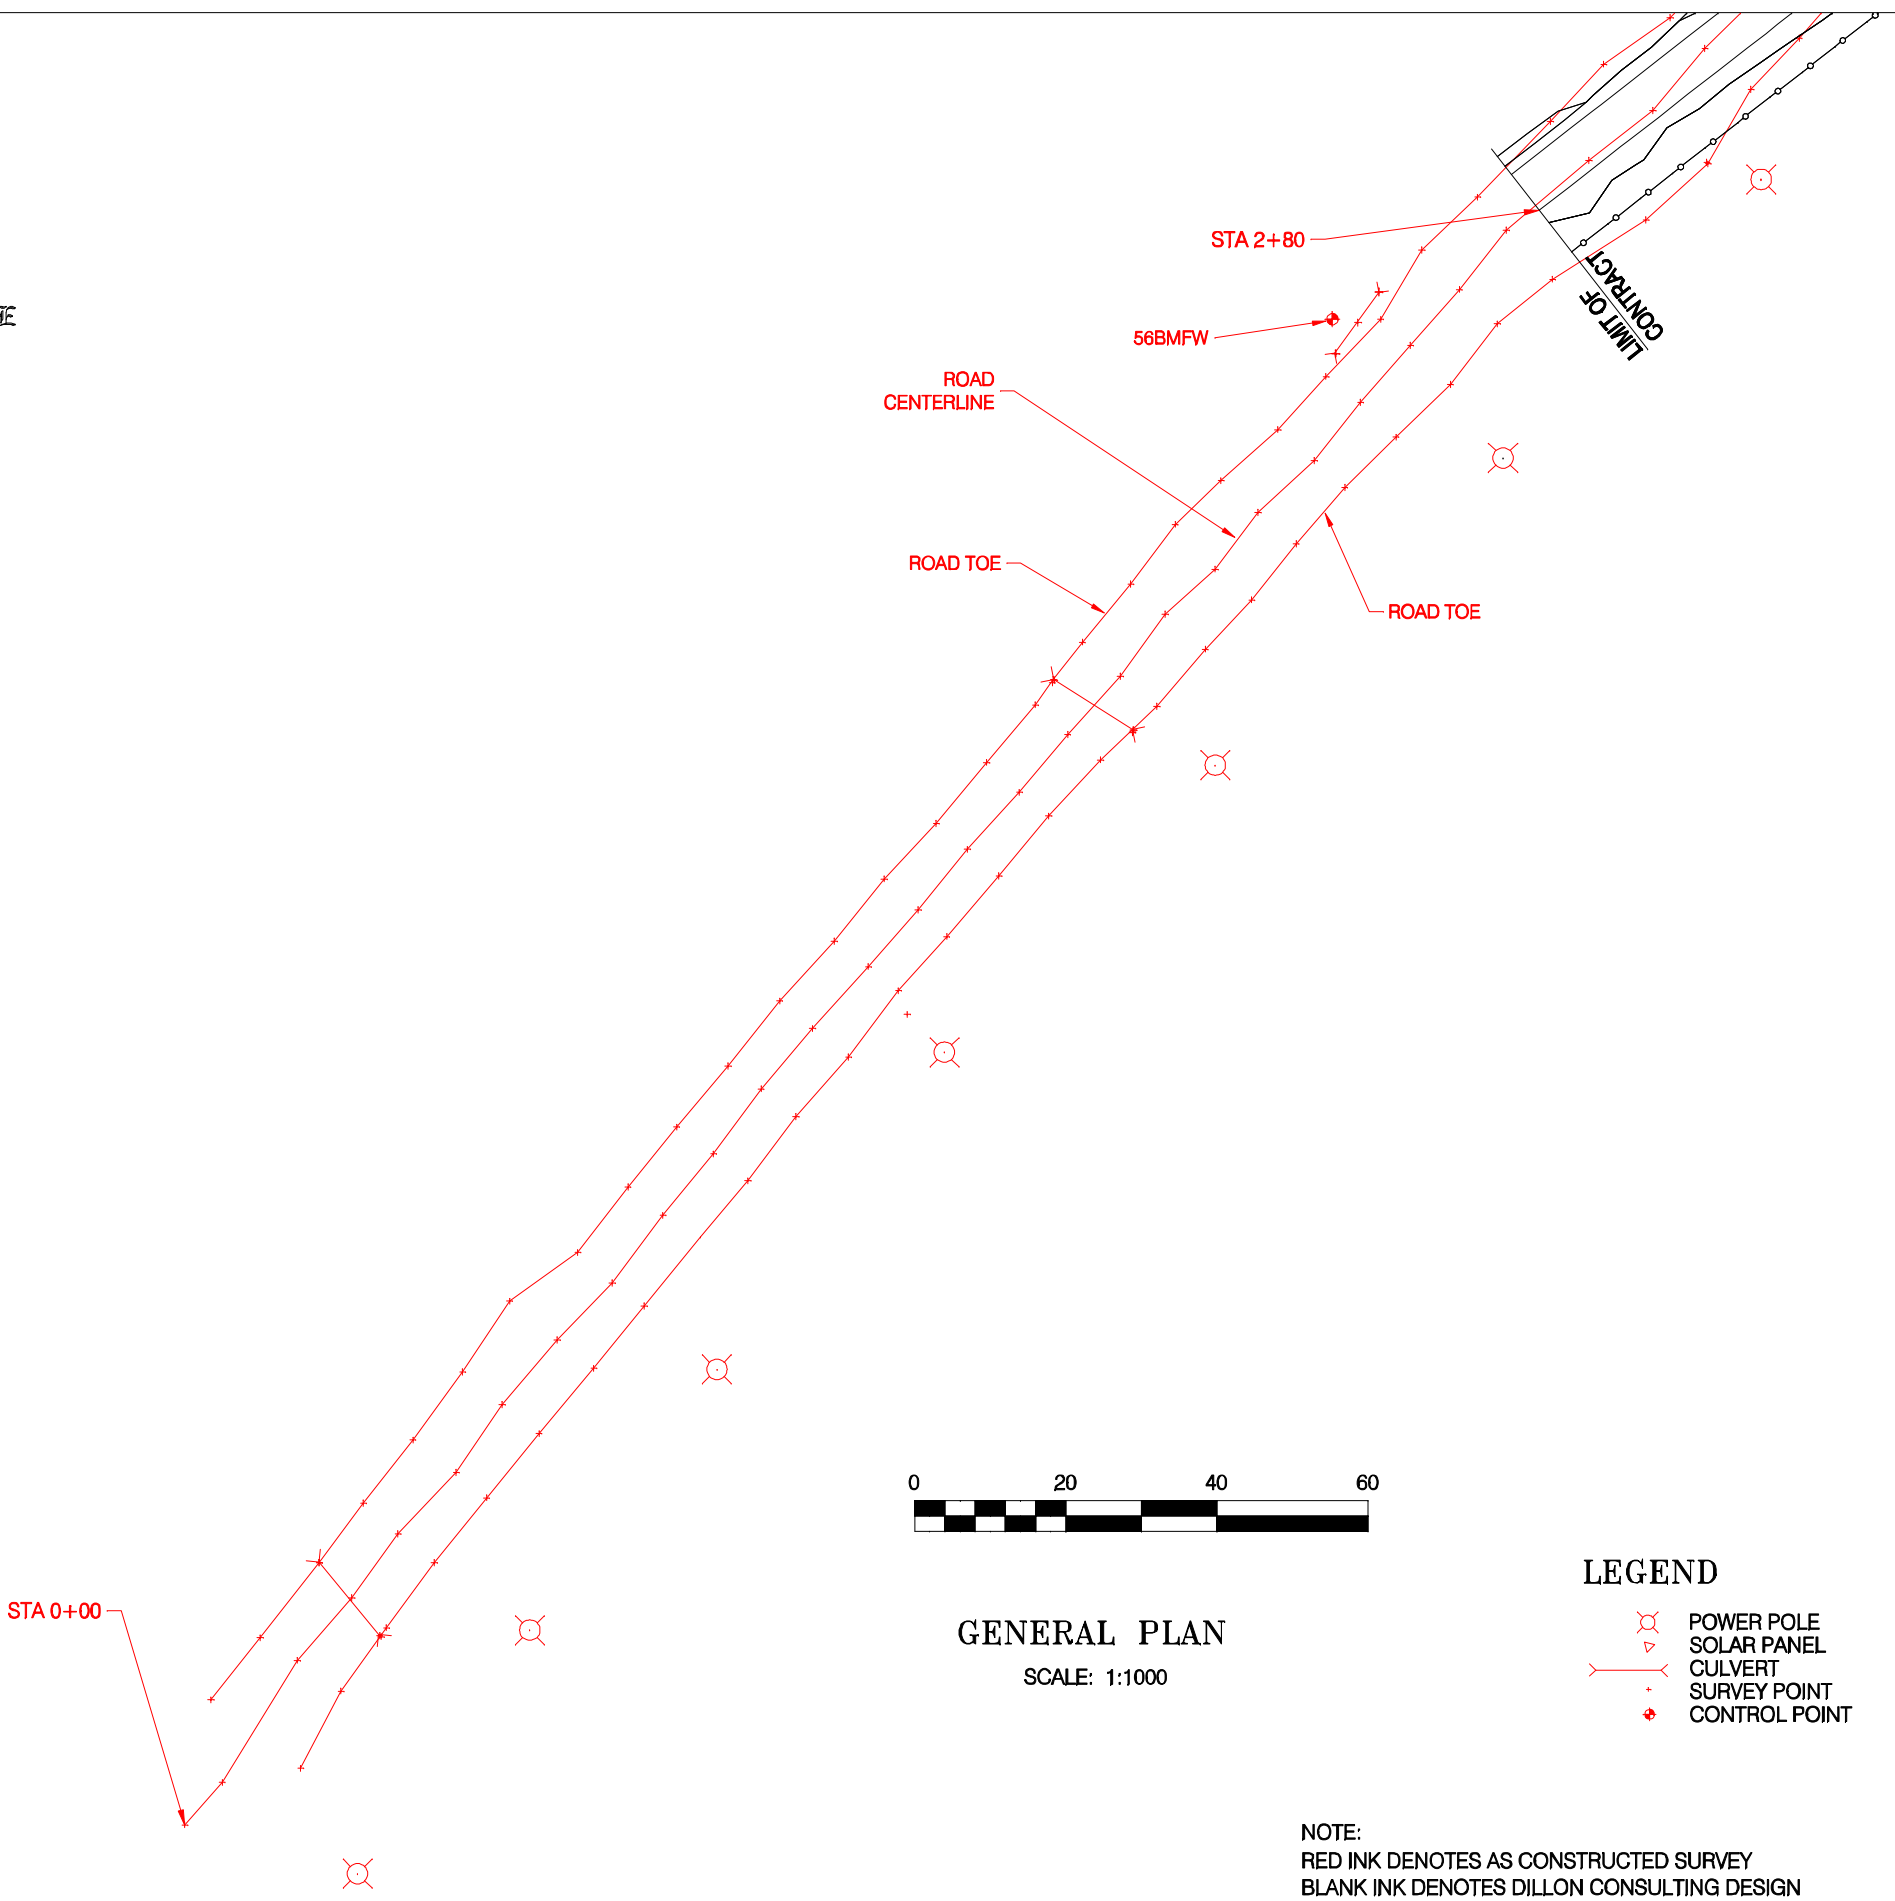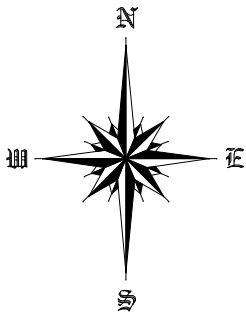

GENERAL PLAN
SCALE: 1:1000

- LEGEND
- POWER POLE
 - SOLAR PANEL
 - CULVERT
 - SURVEY POINT
 - CONTROL POINT

				Proj: WATER TREATMENT PLANT ROAD	
				Drwg: GENERAL PLAN STA 0+00 TO 2+80	
				Drwn: P. Holtkamp A.Sc.T. 08/07	
				Apvd:	Sht 3 of 6
No.	Date	By	Revision		


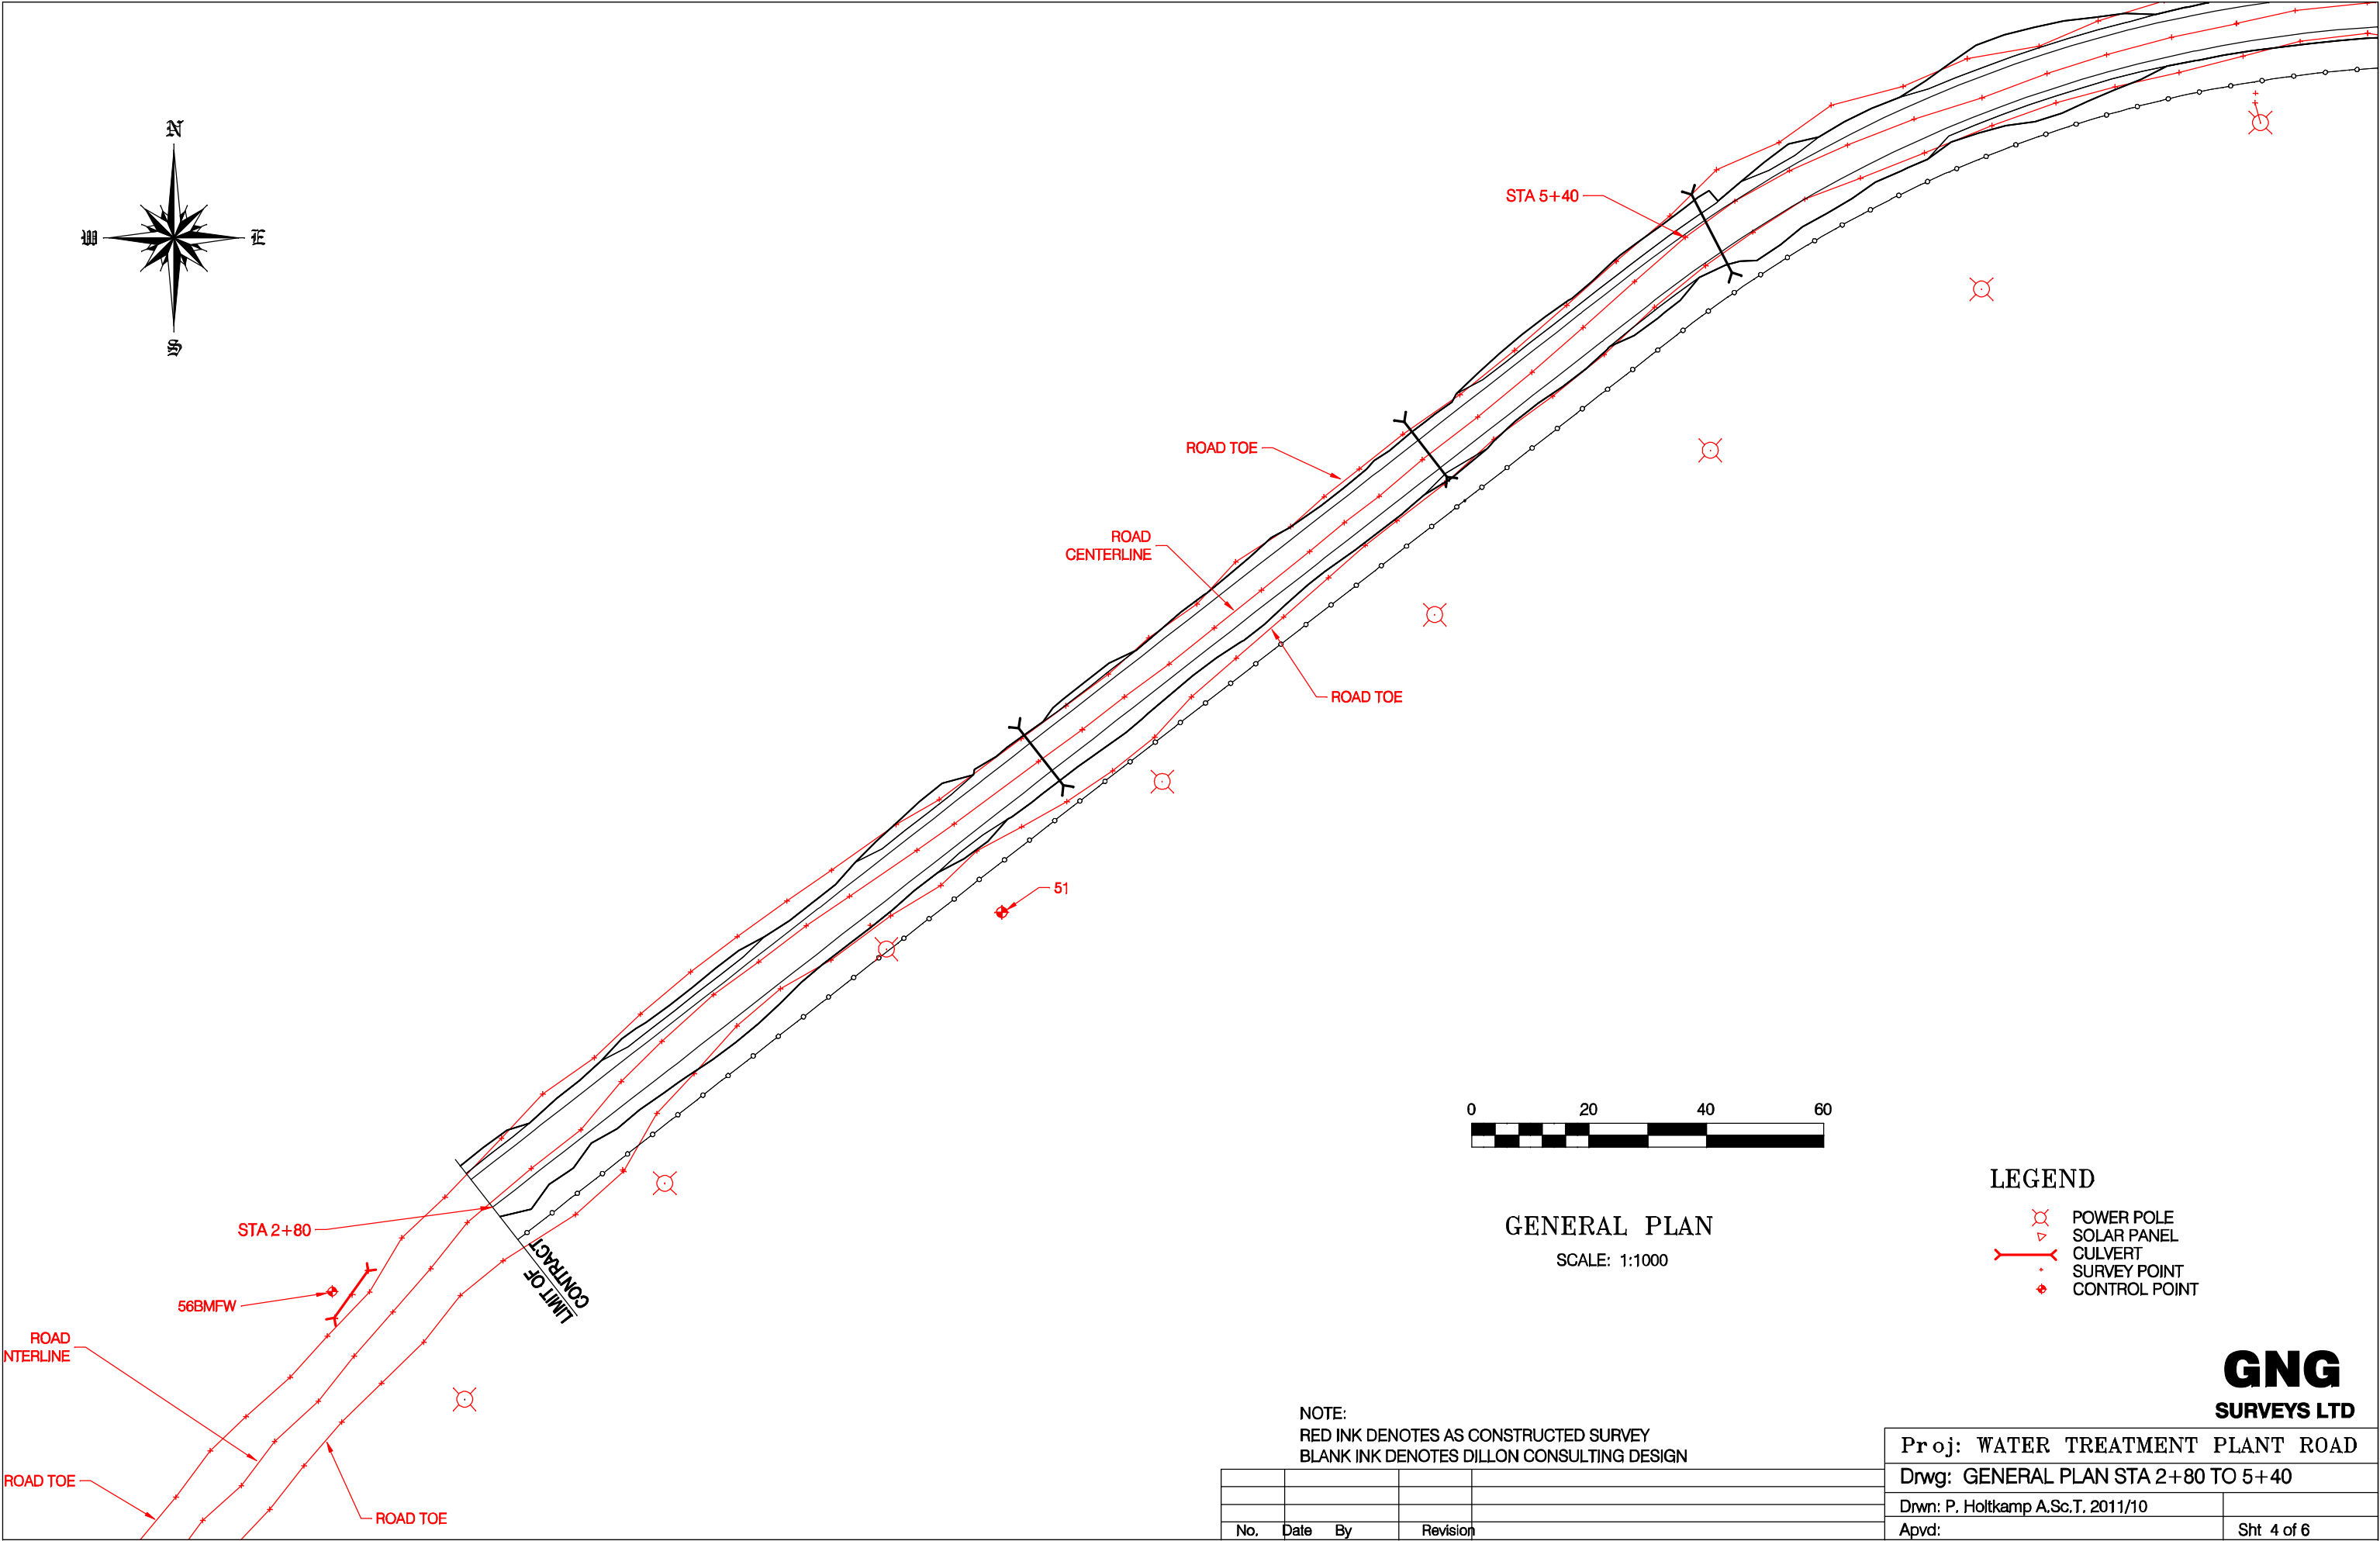


NOTE:
RED INK DENOTES AS CONSTRUCTED SURVEY
BLACK INK DENOTES DILLON CONSULTING DESIGN

No.	Date	By	Revision

GNG
SURVEYS LTD

Proj: WATER TREATMENT PLANT ROAD	
Drwg: GENERAL PLAN STA 2+80 TO 5+40	
Drwn: P. Holtkamp A.Sc.T. 2011/10	
Apvd:	Sht 4 of 6

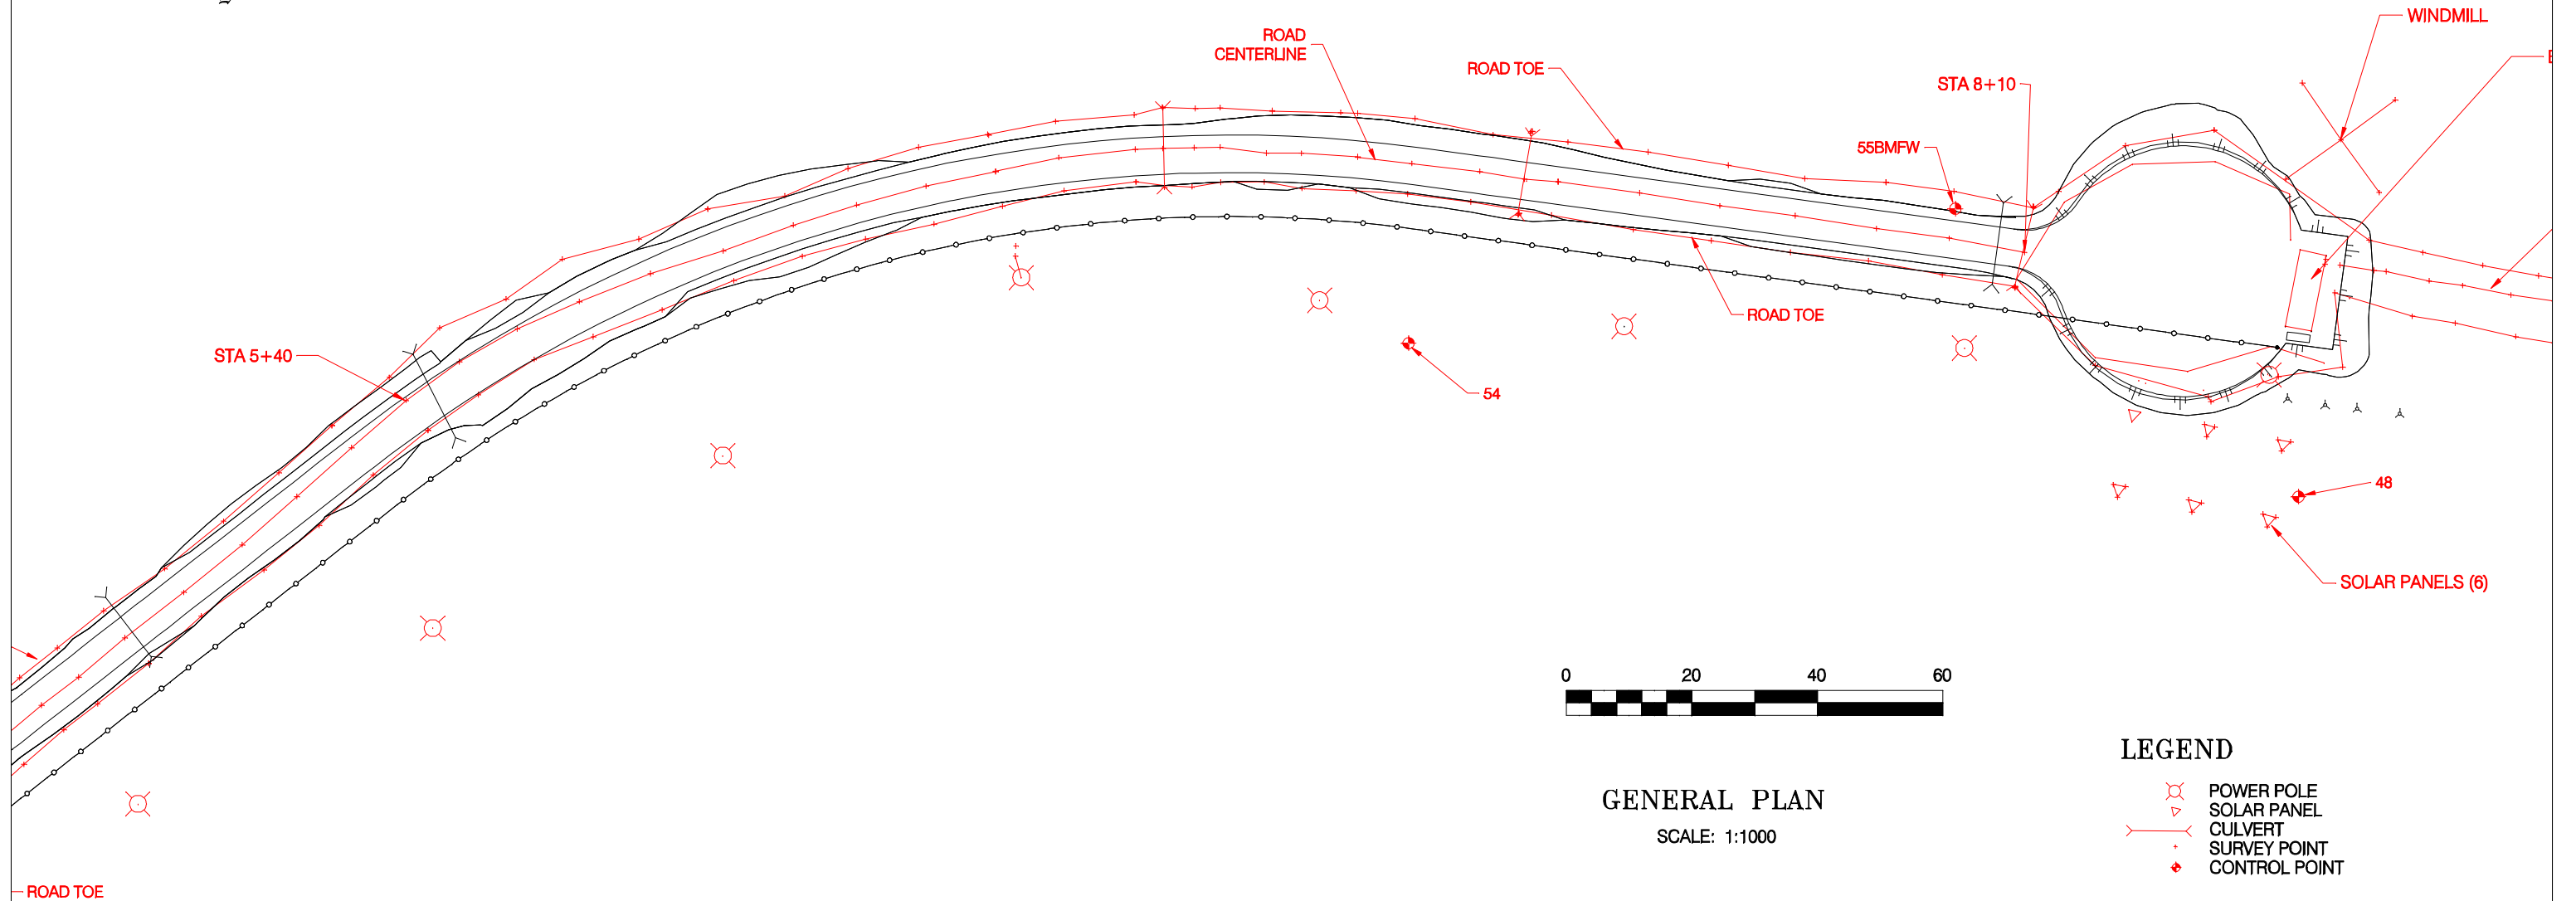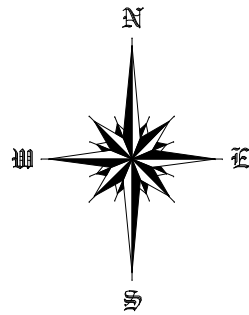

GENERAL PLAN

SCALE: 1:1000

LEGEND

- POWER POLE
- SOLAR PANEL
- CULVERT
- SURVEY POINT
- CONTROL POINT

NOTE:

RED INK DENOTES AS CONSTRUCTED SURVEY
BLANK INK DENOTES DILLON CONSULTING DESIGN

No.	Date	By	Revision

GNG
SURVEYS LTD

Proj: WATER TREATMENT PLANT ROAD	
Drwg: GENERAL PLAN STA 5+40 TO 8+10	
Drwn: P. Holtkamp A.Sc.T. 2011/10	
Apvd:	Sht 5 of 6

