



SERVICE AND MCC

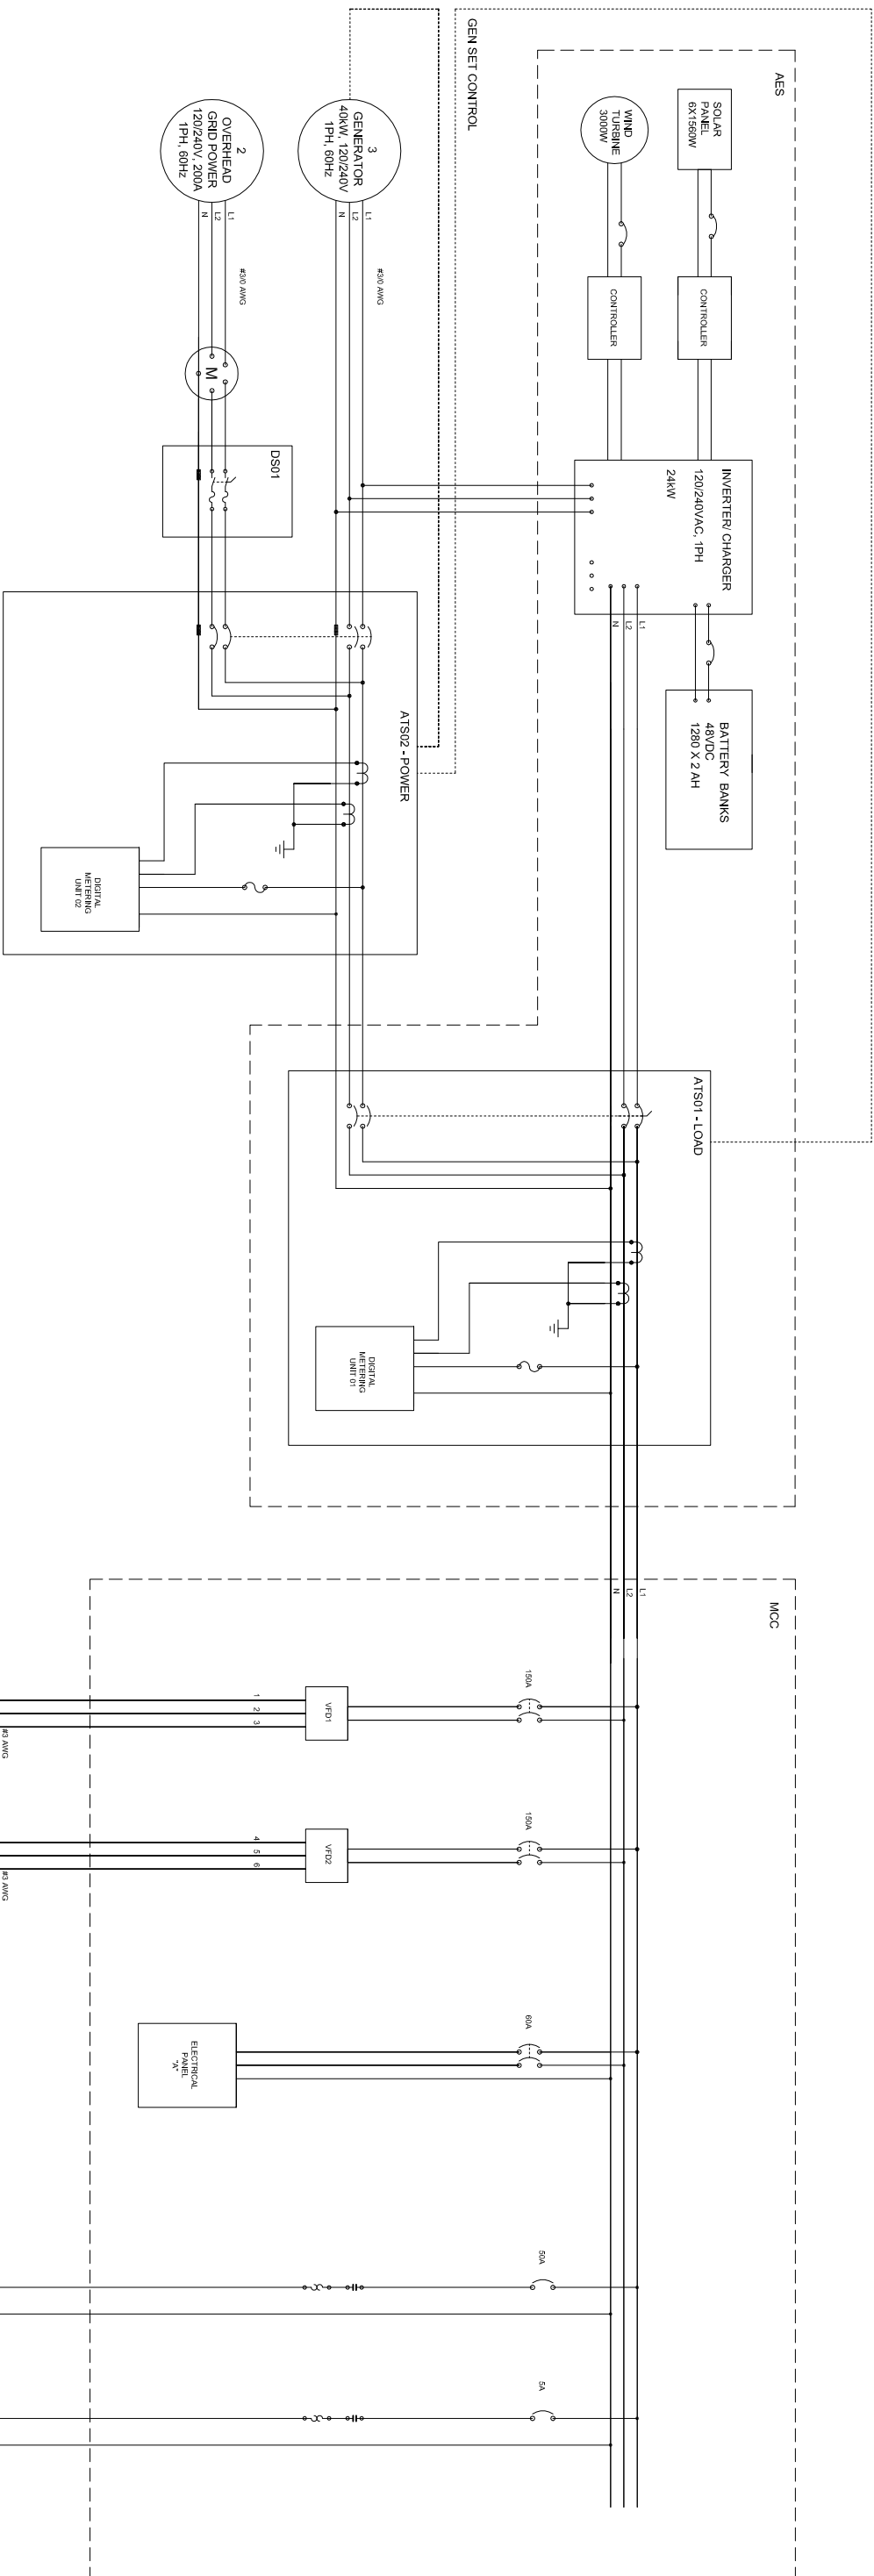

NOTES:

1. ATS1 IS CONTROLLED BY AES AND ATS2
2. ATS2 IS CONTROLLED BY UTILITY POWER AND GENERATOR
3. GENERATOR IS CONTROLLED BY BOTH ATS1 AND ATS2 IN SERIES
4. SEE AES DRAWING FOR DETAIL
5. SEE MOC/VED DRAWING FOR DETAIL

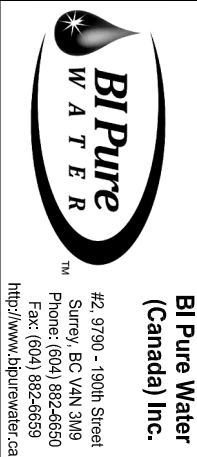


THE INFORMATION CONTAINED IN THIS
DRAWING IS THE SOLE PROPERTY OF
BI PURE WATER (CANADA) INC.
ANY REPRODUCTION IN PART OR WHOLE
OF THE INFORMATION HEREIN, WITHOUT
THE WRITTEN PERMISSION OF
BI PURE WATER (CANADA) INC.,
IS STRICTLY PROHIBITED.

AS BUILT

			Design By: JK
			Drawn By: JK
			Checked By: JT
04	JUN 16/10	GT	ISSUED FOR REVIEW
03	JUN 09/10	GT	ISSUED FOR REVIEW
02	MAY 17/10	GT	ISSUED FOR REVIEW
01	APR 25/10	GT	ISSUED FOR REVIEW
Issue	Date	App'd	Revision Description
			Submitted
			Approved

Client: **KITNUNA
PROJECTS
INC.**

Title:	ELECTRICAL CONSTRUCTION		
	SCHEMATIC 01		
Project:	TALOYAK WATER TREATMENT SYSTEM UPGRADE		
Drawing #:	1772-EL-200-S05-01		Rev: 04
	Scale	NTS	
	Date	APR 25, 2010	
	Sheet 03 of 05	Job# 1772	

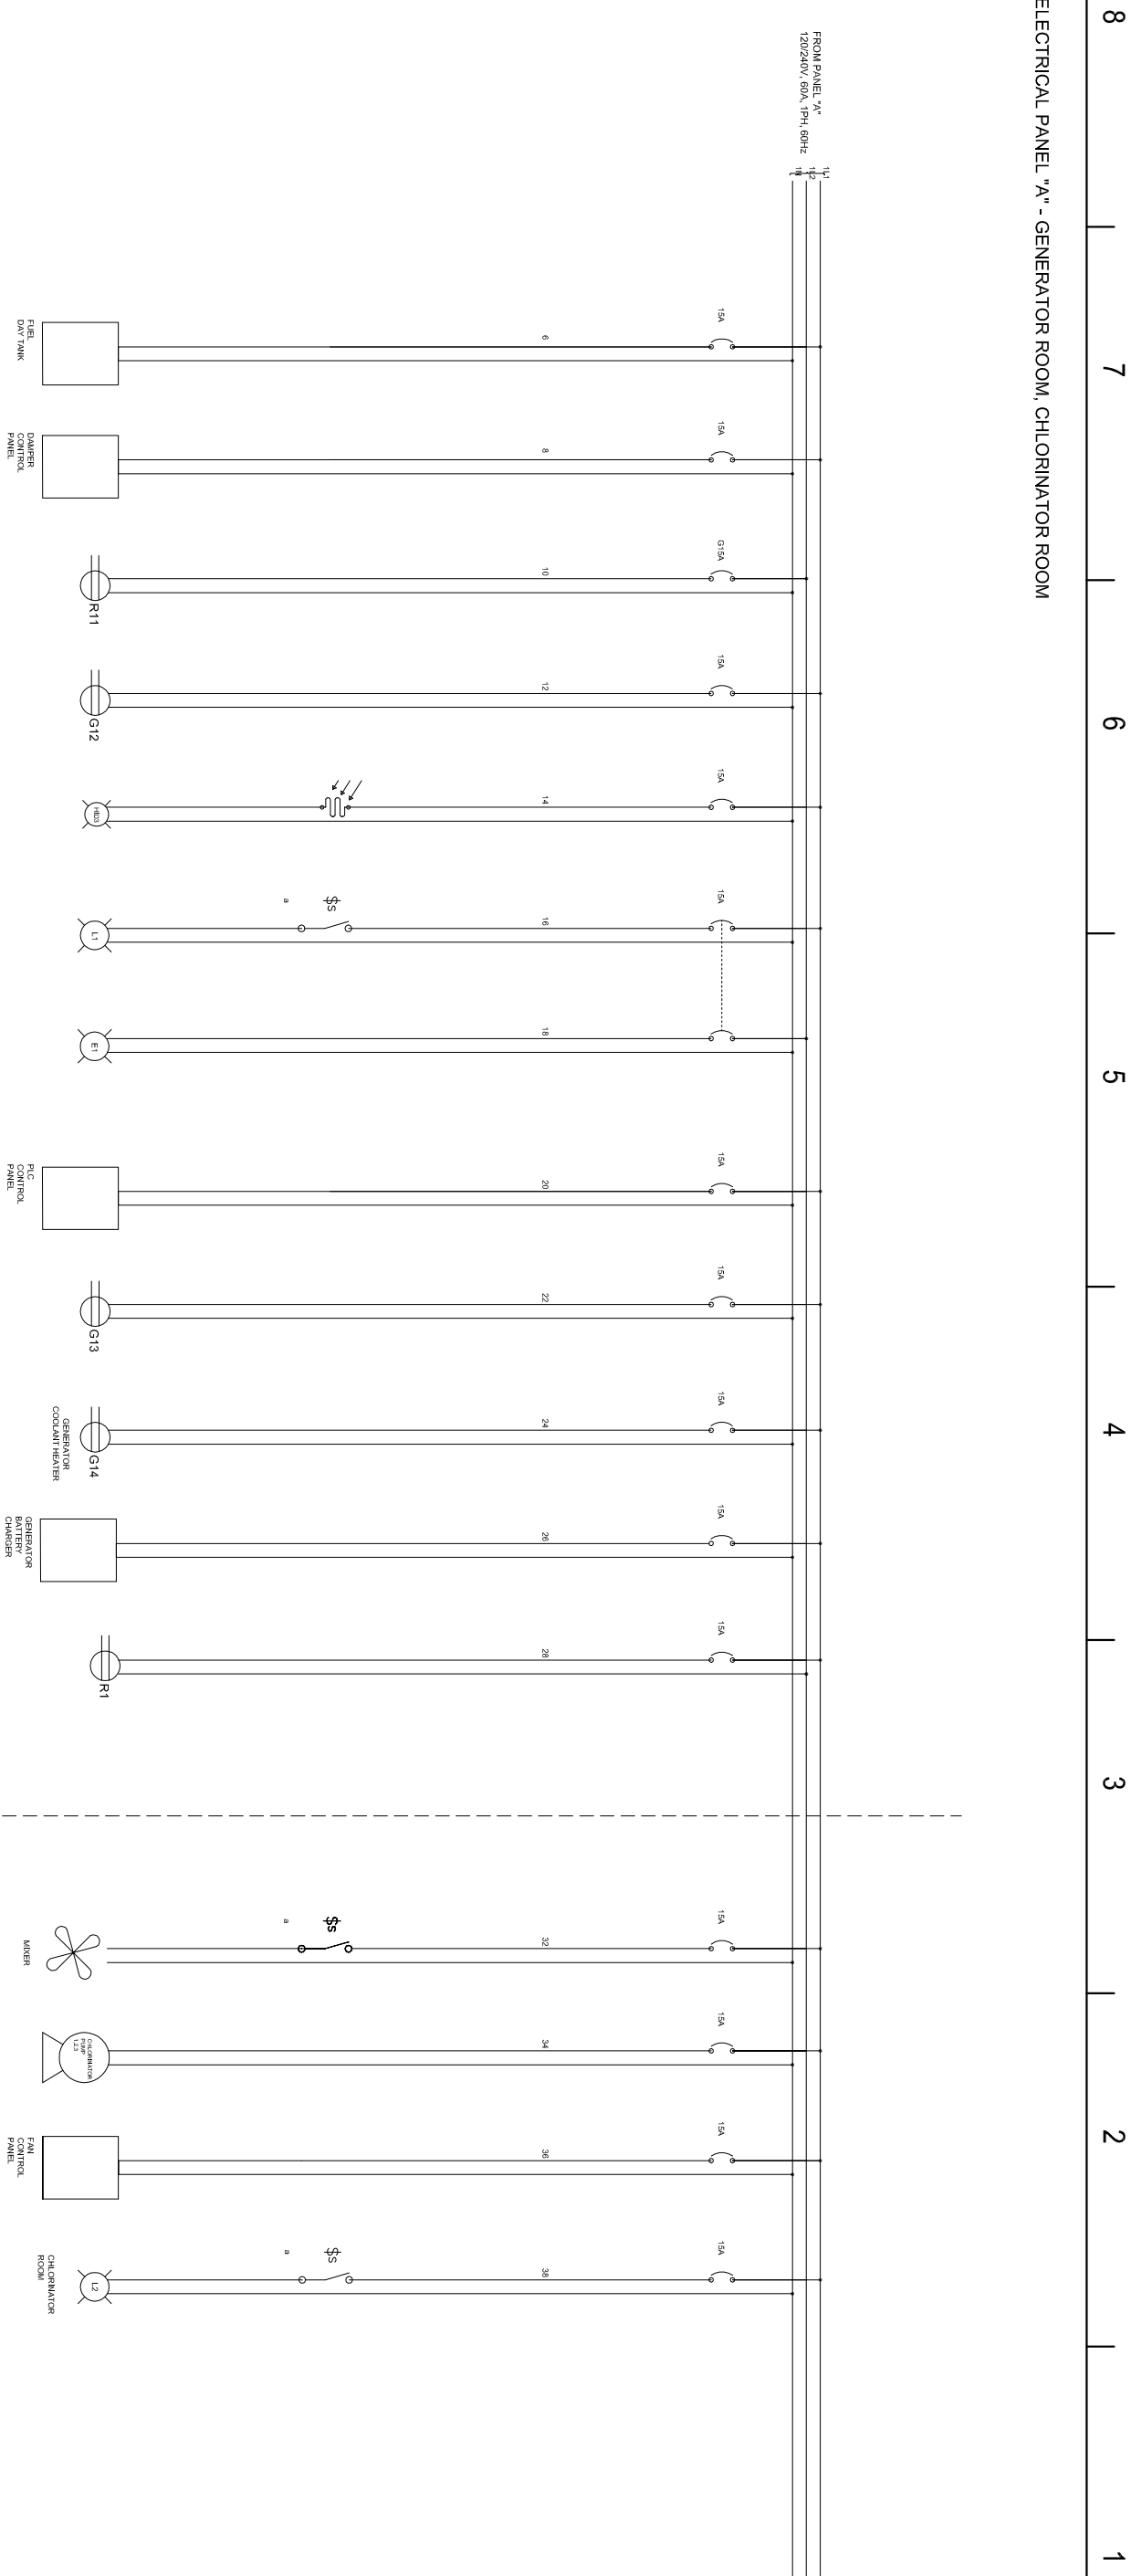

NOTES:

1. PHASE IS BY CIRCUIT NUMBER NOT BY DRAWING
2. HID LIGHTS ARE CONTROLLED BY INTEGRATED PHOTO CELL
3. SEE DAMPER CONTROL PANEL DRAWING FOR DETAIL
4. SEE FAN CONTROL PANEL DRAWING FOR DETAIL



**BI Pure Water
(Canada) Inc.**
#2, 9790 - 190th Street
Surrey, BC V4N 3M9
Phone: (604) 882-6650
Fax: (604) 882-6659
<http://www.bipurewater.ca>

THE INFORMATION CONTAINED IN THIS DRAWING IS THE SOLE PROPERTY OF **BI PURE WATER (CANADA) INC.**. ANY REPRODUCTION IN PART OR WHOLE OF THE INFORMATION HEREIN, WITHOUT THE WRITTEN PERMISSION OF BI PURE WATER (CANADA) INC., IS STRICTLY PROHIBITED.

Status

AS BUILT

				Design By:	JK
				Drawn By:	JK
				Checked By:	JT
04	JUN 16/10	GT	ISSUED FOR REVIEW	Revision Description	Submitted Approved
03	JUN 09/10	GT	ISSUED FOR REVIEW		
02	MAY 17/10	GT	ISSUED FOR REVIEW		
01	APR 25/10	GT	ISSUED FOR REVIEW		
Issue	Date	Appt			

Client:

KITNUNA
PROJECTS
INC.

Tide:

ELECTRICAL CONSTRUCTION SCHEMATIC 03

TALOYOK WATER
TREATMENT SYSTEM

1772-EL-200-S05-03

Scale

Date APR 25, 2010

Sheet 05 of 05

Job# 1112

Rev: 04