

BI Pure Water
(Canada) Inc.
#2, 9790 - 190th Street
Surrey, BC V4N 3M9
Phone: (604) 882-6650
Fax: (604) 882-6659
http://www.bipurewater.ca

THE INFORMATION CONTAINED IN THIS
DRAWING IS THE SOLE PROPERTY OF
BI PURE WATER (CANADA) INC.
ANY REPRODUCTION IN PART OR WHOLE OF
THE INFORMATION HEREIN, WITHOUT THE
WRITTEN PERMISSION OF
BI PUREWATER (CANADA) INC.,
IS STRICTLY PROHIBITED.

Status

AS PER
RECORD



Issue	Date	App'd	Revision Description
04	NOV 4/11	JT	AS PER RECORD
03	JUN 10/10	JT	INCREASED SIZE OF CHLORINE ROOM
02	MAY 21/10	JT	ISSUED FOR CONSTRUCTION
01	MAY 4/10	JT	ISSUED FOR APPROVAL

Design By:	JT
Drawn By:	RS
Checked By:	
Submitted	
Approved	

Client:

KITNUNA
PROJECTS
INC.

Title:	BUILDING DETAILS	Scale	
		Date	04/05/2010
Project:	TALOYOAK WATER TREATMENT SYSTEM UPGRADE	Sheet	1 of 2
		Job#	
Drawing #:	1772-ST-101	Rev:	04

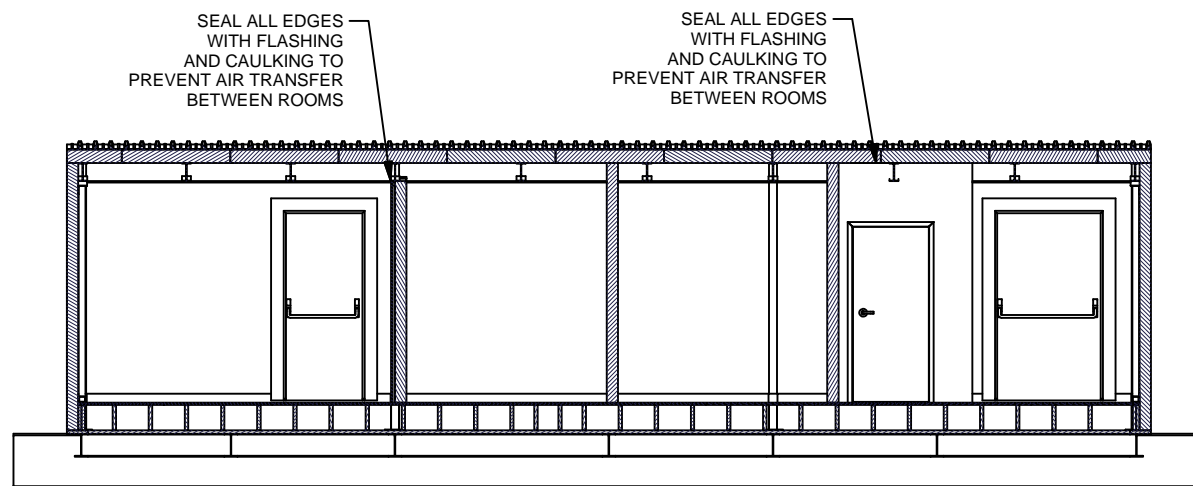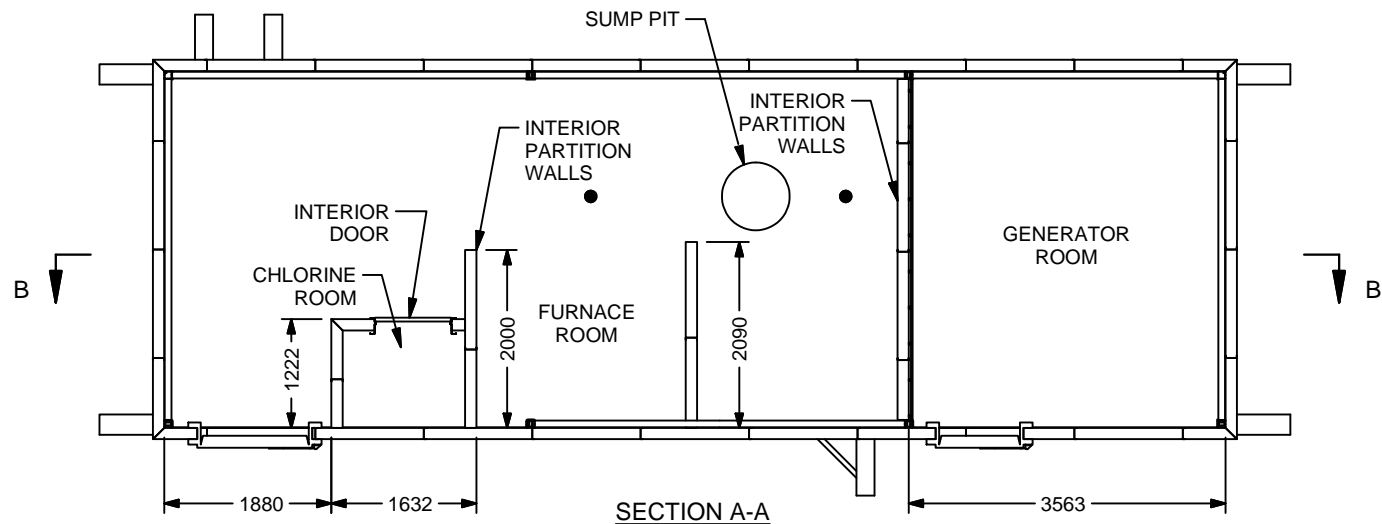

SECTION B-B



BI Pure Water
(Canada) Inc.
#2, 9790 - 190th Street
Surrey, BC V4N 3M9
Phone: (604) 882-6650
Fax: (604) 882-6659
<http://www.bipurewater.ca>

THE INFORMATION CONTAINED IN THIS
DRAWING IS THE SOLE PROPERTY OF
BI PURE WATER (CANADA) INC.
ANY REPRODUCTION IN PART OR WHOLE OF
THE INFORMATION HEREIN, WITHOUT THE
WRITTEN PERMISSION OF
BI PUREWATER (CANADA) INC.,
IS STRICTLY PROHIBITED.

Status

AS PER
RECORD

Issue	Date	App'd	Revision Description
04	NOV 4/11	JT	AS PER RECORD
03	JUN 10/10	JT	INCREASED SIZE OF CHLORINE ROOM
02	MAY 21/10	JT	ISSUED FOR CONSTRUCTION
01	MAY 4/10	JT	ISSUED FOR APPROVAL

Design By: JT
Drawn By: RS
Checked By:
Submitted
Approved

Client:

KITNUNA
PROJECTS
INC.

Title: BUILDING DETAILS
Project: TALOYOAK WATER
TREATMENT SYSTEM
UPGRADE
Drawing #: 1772-ST-101

Scale
Date 04/05/2010
Sheet 2 of 2
Job#
Rev: 04