


HAMLET OF WHALE COVE

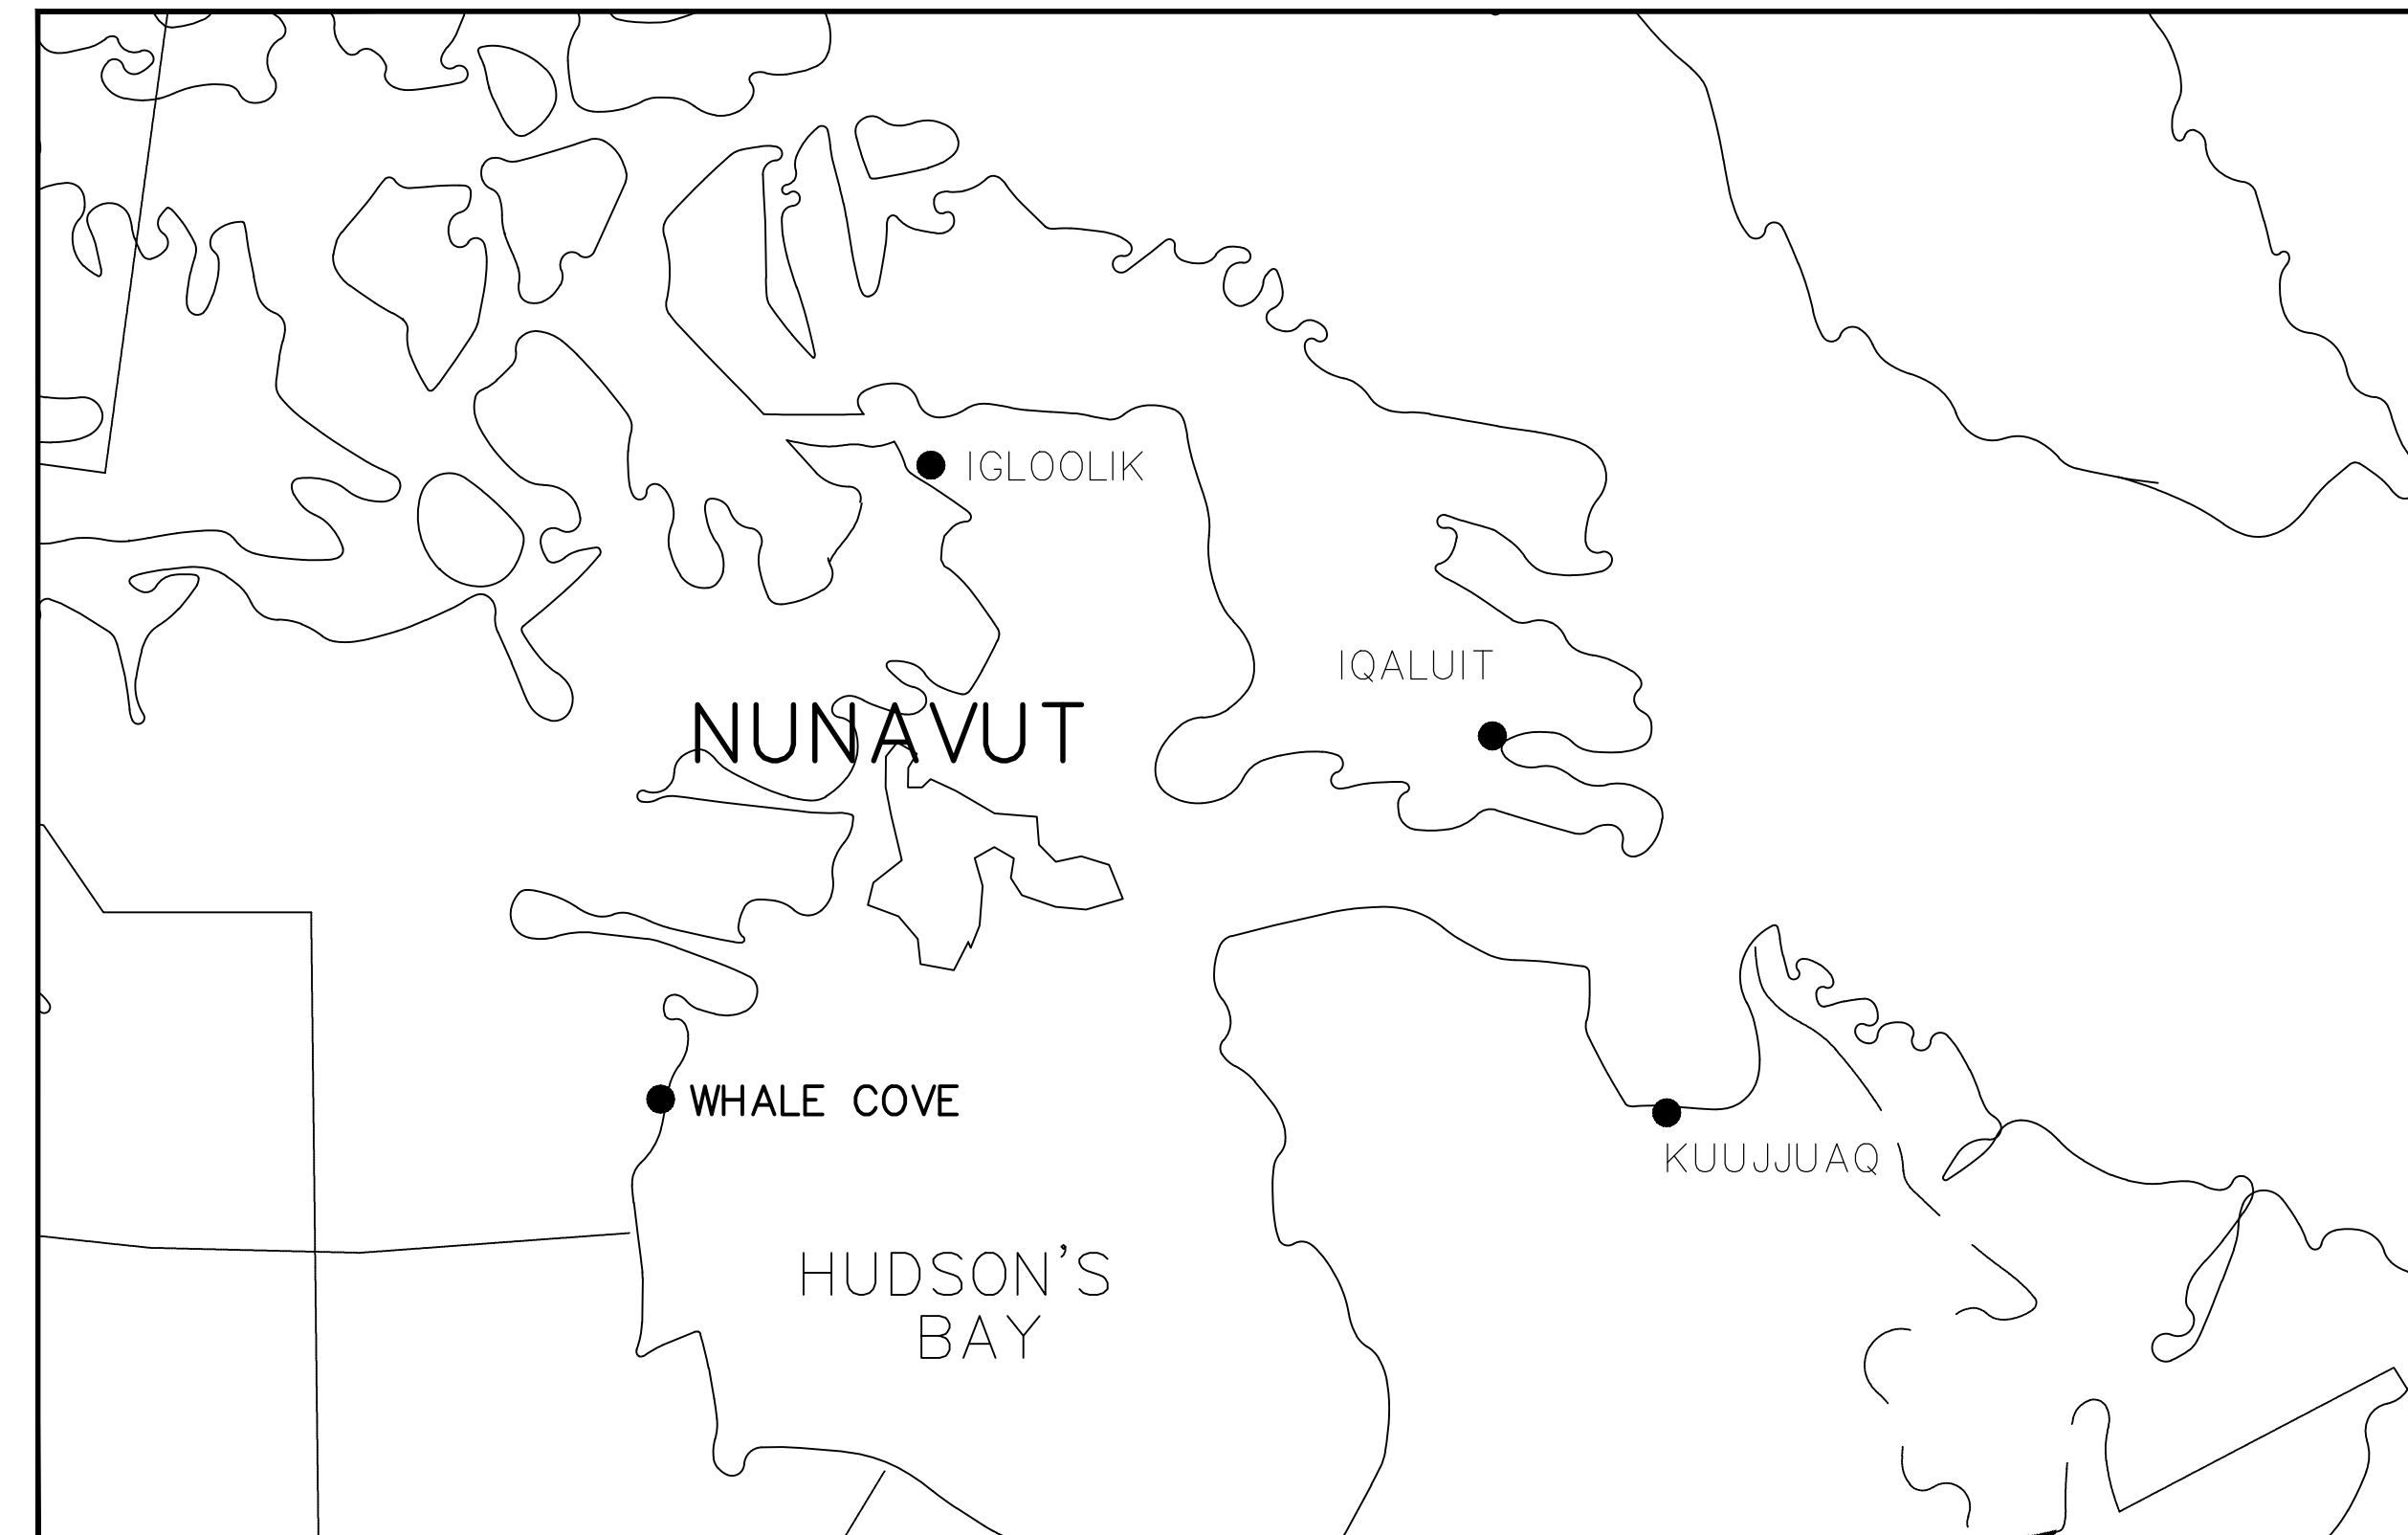

INDEX OF INCLUDED DRAWINGS

DRAWING NO.	REVISION	DESCRIPTION
OTT-00201369-COV-1		COVER SHEET
OTT-00201369-SLP-1	REV 3	SITE LOCATION PLAN
OTT-00201369-OSP-1	REV 3	OVERALL SITE PLAN
OTT-00201369-CMP-1	REV 3	CONSTRUCTION MANAGEMENT PLAN
OTT-00201369-PLMP-1	REV 3	PROPOSED LAGOON MODIFICATIONS PLAN
OTT-00201369-TDSP-1	REV 3	TRUCK DISCHARGE SITE PLANS
OTT-00201369-CS-1	REV 3	BERM CROSS SECTIONS
OTT-00201369-DE-1	REV 3	PUMPING AND DEWATERING DETAILS
OTT-00201369-DE-2	REV 3	BERM AND THERMISTOR DETAILS
OTT-00201369-DE-3	REV 3	TRUCK DISCHARGE AND MISC. DETAILS

RECORD DRAWING

DATE: NOVEMBER 22nd, 2016

GOVERNMENT OF NUNAVUT

WASTEWATER MANAGEMENT FACILITY

PROJECT OTT-00201369-A exp.



exp Services Inc.

t: +1.613.688.1899 | f: +1.613.225.7330
2650 Queensview Drive, Unit 100
Ottawa, ON K2B 8H6
Canada

www.exp.com

• BUILDINGS • EARTH & ENVIRONMENT • ENERGY •
• INDUSTRIAL • INFRASTRUCTURE • SUSTAINABILITY •

HUDSON BAY

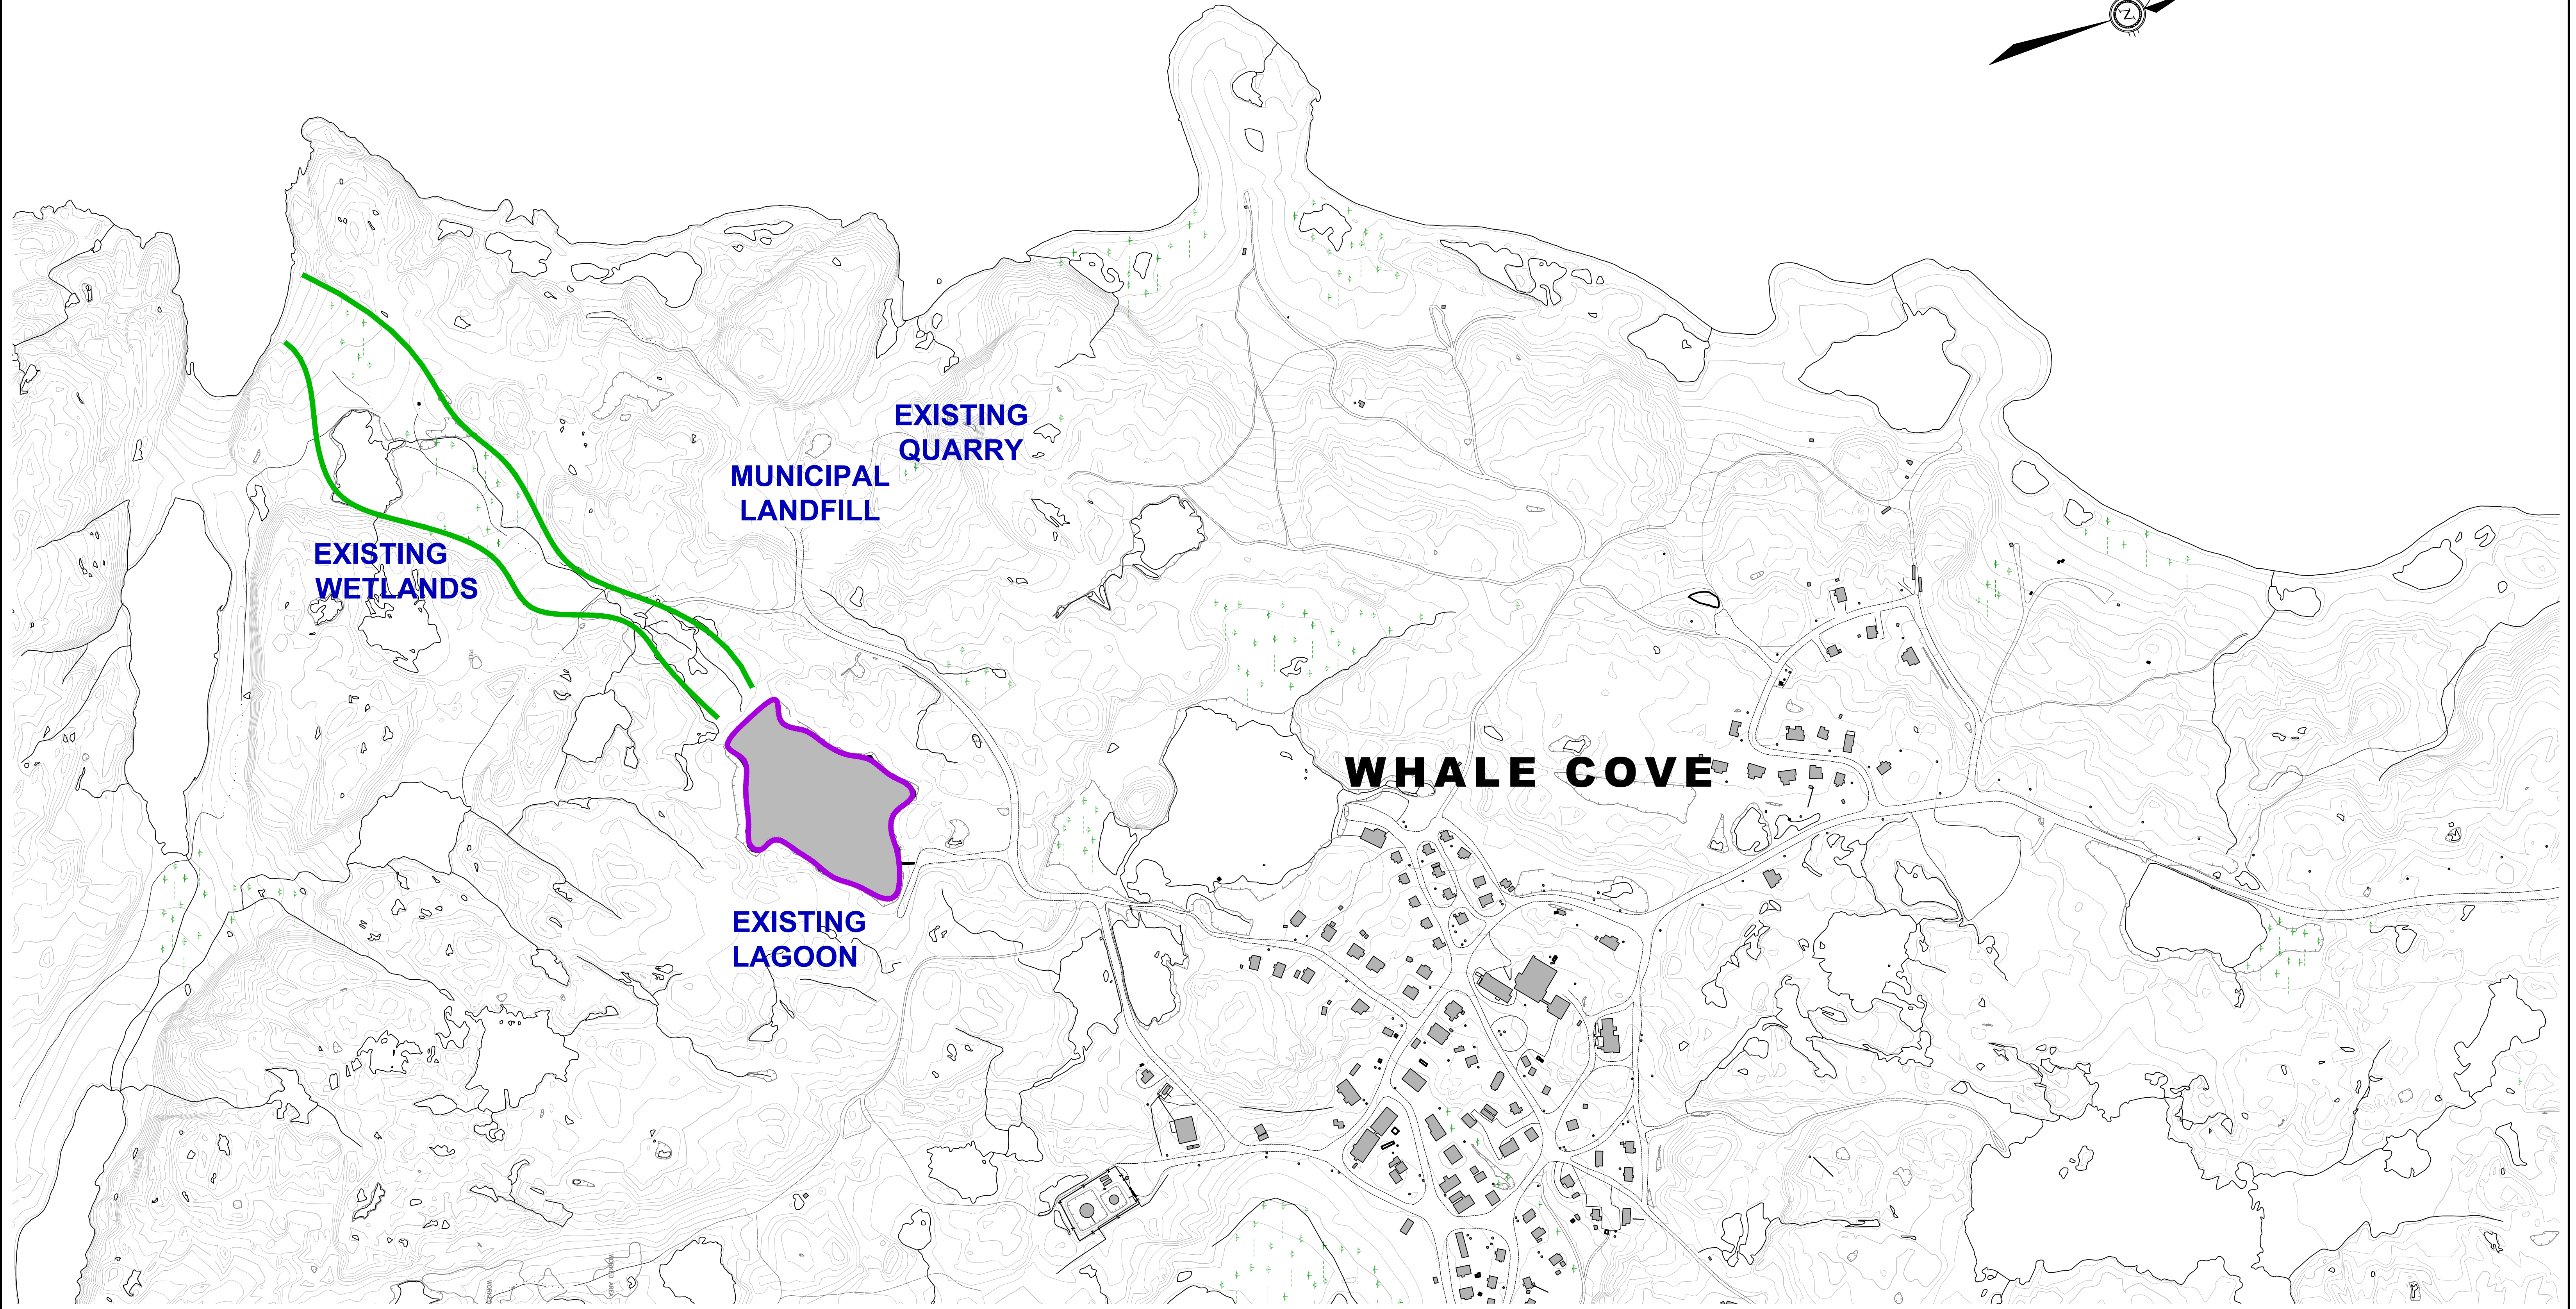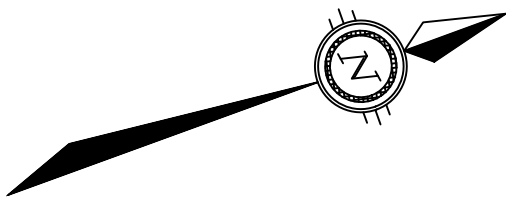

NOTES

THE POSITION OF ALL POLE LINES, CONDUITS, WATERMAINS, SEWERS AND OTHER UNDERGROUND AND OVERGROUND UTILITIES AND STRUCTURES IS NOT NECESSARILY SHOWN ON THE CONTRACT DRAWINGS, AND WHERE SHOWN, THE ACCURACY OF THE POSITION OF SUCH UTILITIES AND STRUCTURES IS NOT GUARANTEED. BEFORE STARTING WORK, DETERMINE THE EXACT LOCATION OF ALL SUCH UTILITIES AND STRUCTURES AND ASSUME ALL LIABILITY FOR DAMAGE TO THEM.

NO.	REVISION DESCRIPTION	DATE	BY	APPD
4	ISSUED FOR CONSTRUCTION	14/04/16	IPC	SLB
3	ISSUED FOR TENDER	19/12/14	IPC	SLB
2	ISSUED FOR TENDER	25/02/14	MCK	SLB
1	ISSUED FOR REVIEW	24/02/12	SAD	SLB

SCALE
HORZ 1:3000
HORIZONTAL 1:3000

DESIGNED BY

REVIEWED BY

CLIENT


GOVERNMENT OF NUNAVUT
DEPARTMENT OF COMMUNITY
AND GOVERNMENT SERVICES

exp Services Inc.
1-813-566-1889 | 1-813-225-7337
3025 Glenview Drive, Suite 100
Ottawa, ON K2B 6R6
Canada
www.exp.com
• BUILDINGS • EARTH & ENVIRONMENT • ENERGY •
• INDUSTRIAL • INFRASTRUCTURE • SUSTAINABILITY •

BASEPLAN
S.BUTLER
DESIGN
S.DOUGLAS
CHECKED
S.DOUGLAS
CAD
S.BUTLER
PROJ. MAN
S.BURDEN
APPROVED
S.BURDEN

PROJECT
SEWAGE LAGOON WHALE COVE, NUNAVUT
TITLE
SITE LOCATION PLAN

PROJ. NO.
OTT-00201369A
SURVEY
DATE
FEB 01, 2012
DRAWING NO.
SLP-1

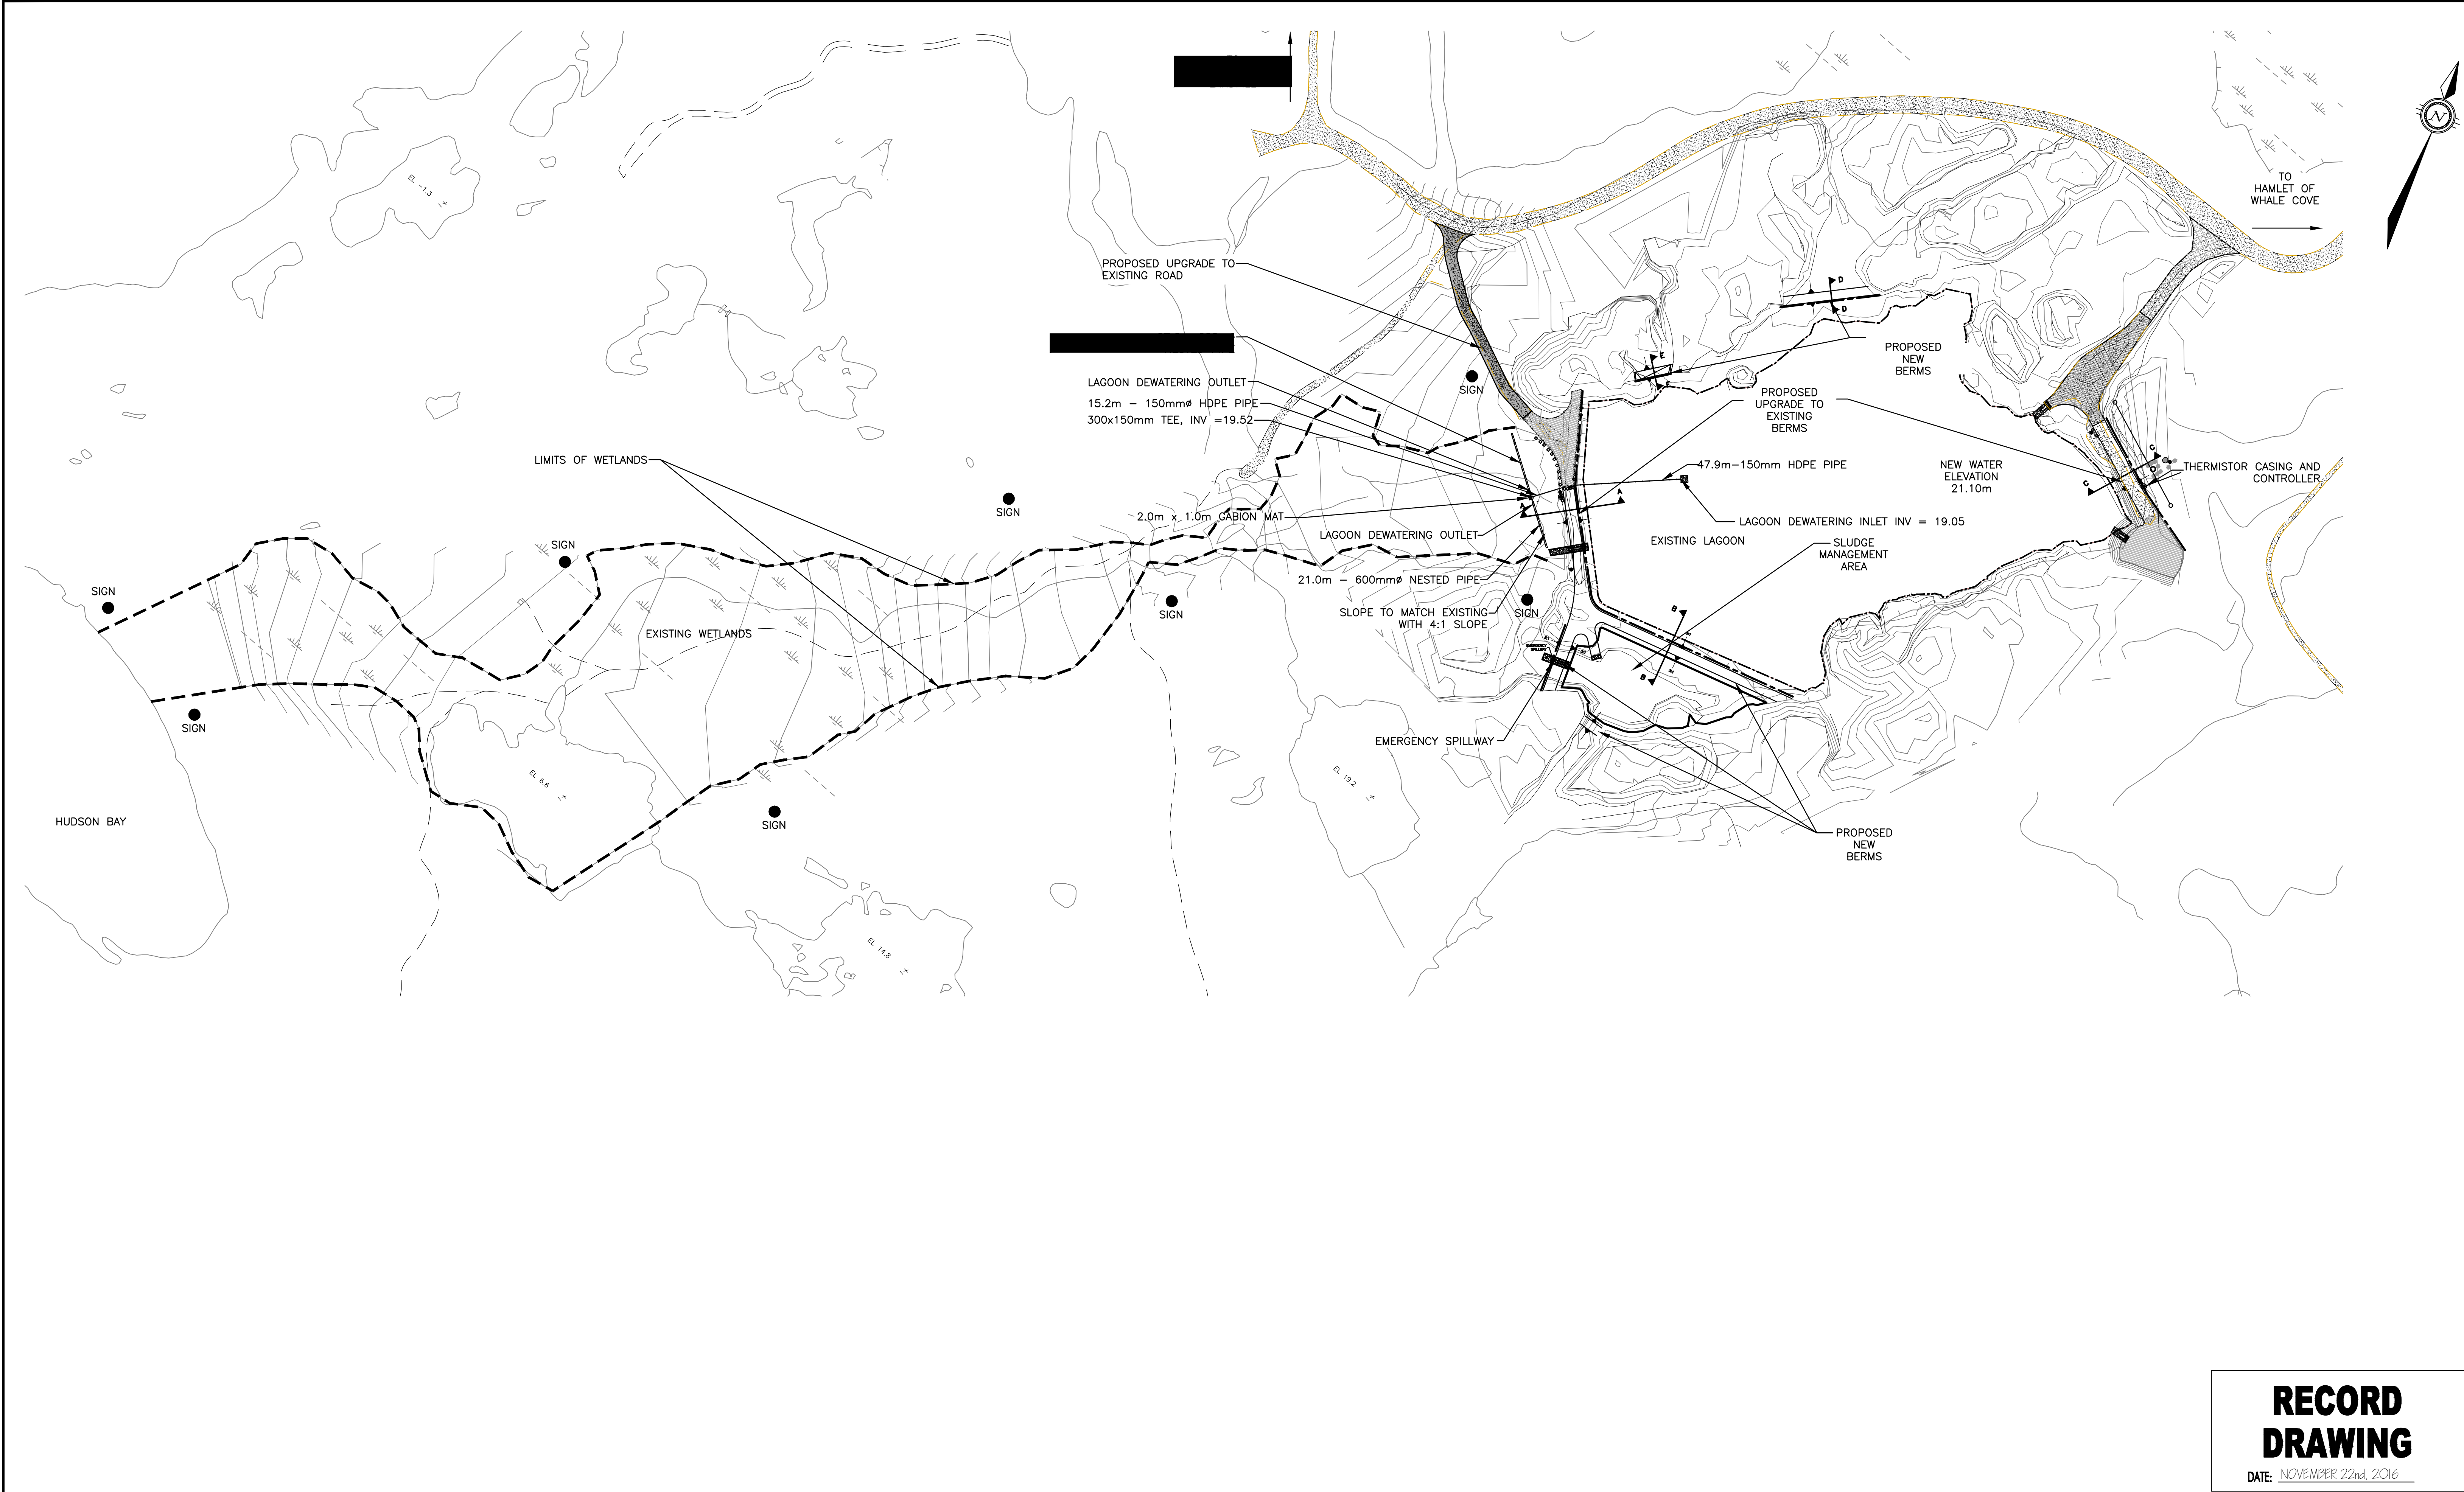

RECORD DRAWING

DATE: NOVEMBER 22nd, 2016

NOTES
THE POSITION OF ALL POLE LINES, CONDUITS, WATERMANS,
SEWERS AND OTHER UNDERGROUND AND OVERGROUND
UTILITIES AND STRUCTURES IS NOT NECESSARILY SHOWN ON
THE CONTRACT DRAWINGS, AND WHERE SHOWN, THE
ACCURACY OF THE POSITION OF SUCH UTILITIES AND
STRUCTURES IS NOT GUARANTEED. BEFORE STARTING WORK,
DETERMINE THE EXACT LOCATION OF ALL SUCH UTILITIES
AND STRUCTURES AND ASSUME ALL LIABILITY FOR DAMAGE
TO THEM.

NO.	REVISION DESCRIPTION	DATE	BY	APPD	NO.	REVISION DESCRIPTION	DATE	BY	APPD
					5	ISSUED FOR RECORD DRAWINGS	11/10/16	IPC	SLB
					4	ISSUED FOR CONSTRUCTION	14/04/16	IPC	SLB
					3	ISSUED FOR TENDER	19/12/14	IPC	SLB
					2	ISSUED FOR TENDER	25/02/14	MCK	SLB
					1	ISSUED FOR REVIEW	24/02/12	SAB	SLB

SCALE
HORZ 1:1250
0 10m 20m 30m

DESIGNED BY

REVIEWED BY

CLIENT
**GOVERNMENT OF NUNAVUT
DEPARTMENT OF COMMUNITY
AND GOVERNMENT SERVICES**


exp Services Inc.
1-813-568-1889 | 1-813-225-7330
2025 Queen Street East, Unit 100
Oshawa, ON M1B 5R6
Canada
www.exp.com
• BUILDINGS • EARTH & ENVIRONMENT • ENERGY •
• INDUSTRIAL • INFRASTRUCTURE • SUSTAINABILITY •

BASEPLAN
S.BUTLER
DESIGN
S.DOUGLAS
CHECKED
S.DOUGLAS
CAD
S.BUTLER
PROJ. MAN
S.BURDEN
APPROVED
S. BURDEN

PROJECT
**SEWAGE LAGOON
WHALE COVE, NUNAVUT**
TITLE
OVERALL SITE PLAN

PROJ. NO.
OTT-00201369A
SURVEY

DATE
FEB 01, 2012
DRAWING NO.
OSP-1

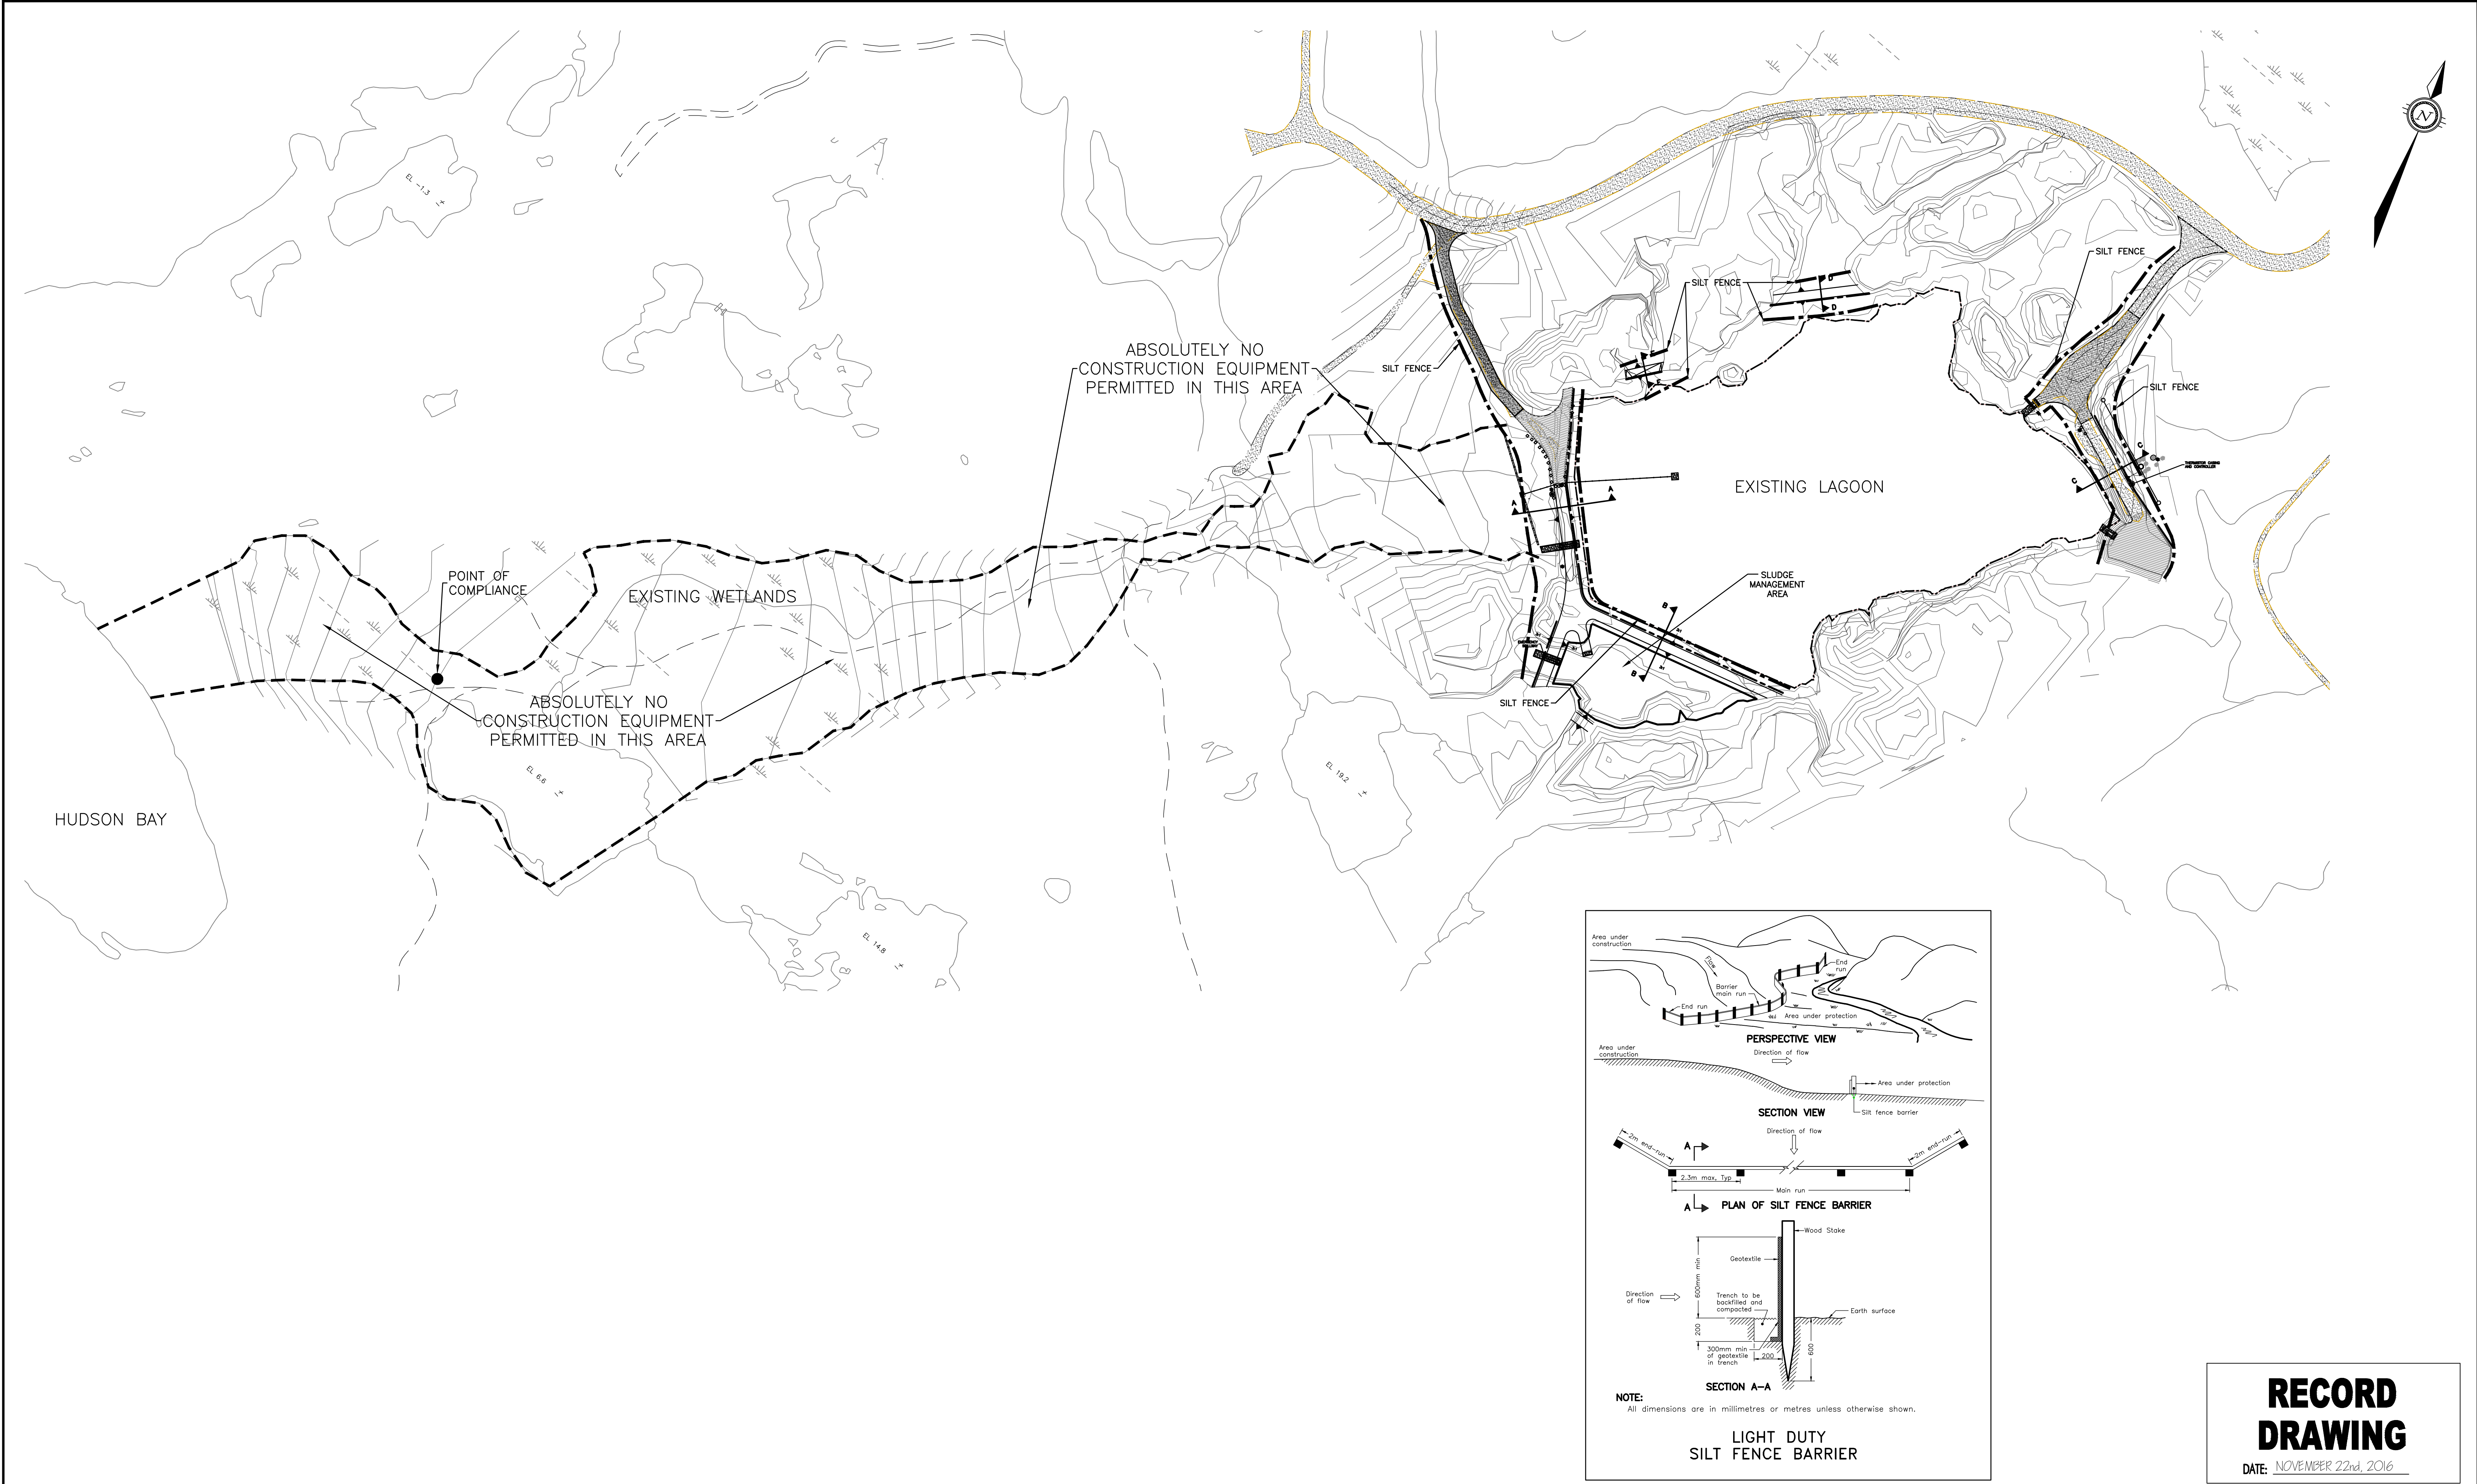

NOTES
THE POSITION OF ALL POLE LINES, CONDUITS, WATERMANS, SEWERS AND OTHER UNDERGROUND AND OVERGROUND UTILITIES AND STRUCTURES IS NOT NECESSARILY SHOWN ON THE CONTRACT DRAWINGS, AND WHERE SHOWN, THE ACCURACY OF THE POSITION OF SUCH UTILITIES AND STRUCTURES IS NOT GUARANTEED. BEFORE STARTING WORK, DETERMINE THE EXACT LOCATION OF ALL SUCH UTILITIES AND STRUCTURES AND ASSUME ALL LIABILITY FOR DAMAGE TO THEM.

NO.	REVISION DESCRIPTION	DATE	BY	APPD	NO.	REVISION DESCRIPTION	DATE	BY	APPD
					4	ISSUED FOR CONSTRUCTION	14/04/16	IPC	SLB
					3	ISSUED FOR TENDER	19/12/14	IPC	SLB
					2	ISSUED FOR TENDER	25/02/14	MCK	SLB
					1	ISSUED FOR REVIEW	24/02/12	SAB	SLB

SCALE
HORZ 1:1250
0 10m 20m 30m

DESIGNED BY
REVIEWED BY


CLIENT
GOVERNMENT OF NUNAVUT DEPARTMENT OF COMMUNITY AND GOVERNMENT SERVICES

	exp Services Inc. 1-813-588-1889 1-813-225-7330 1605 Commercial Drive, Unit 100 Ottawa, ON K2B 6R6 Canada www.exp.com • BUILDINGS • EARTH & ENVIRONMENT • ENERGY • • INDUSTRIAL • INFRASTRUCTURE • SUSTAINABILITY •
--	--

BASEPLAN
S.BUTLER
DESIGN
S.DOUGLAS
CHECKED
S.DOUGLAS
CAD
S.BUTLER
PROJ. MAN
S.BURDEN
APPROVED

PROJECT
SEWAGE LAGOON WHALE COVE, NUNAVUT
TITLE
CONSTRUCTION MANAGEMENT PLAN

PROJ. NO.
OTT-00201369A
SURVEY
exp.
DATE
FEB 01, 2012
DRAWING NO.
CMP-1

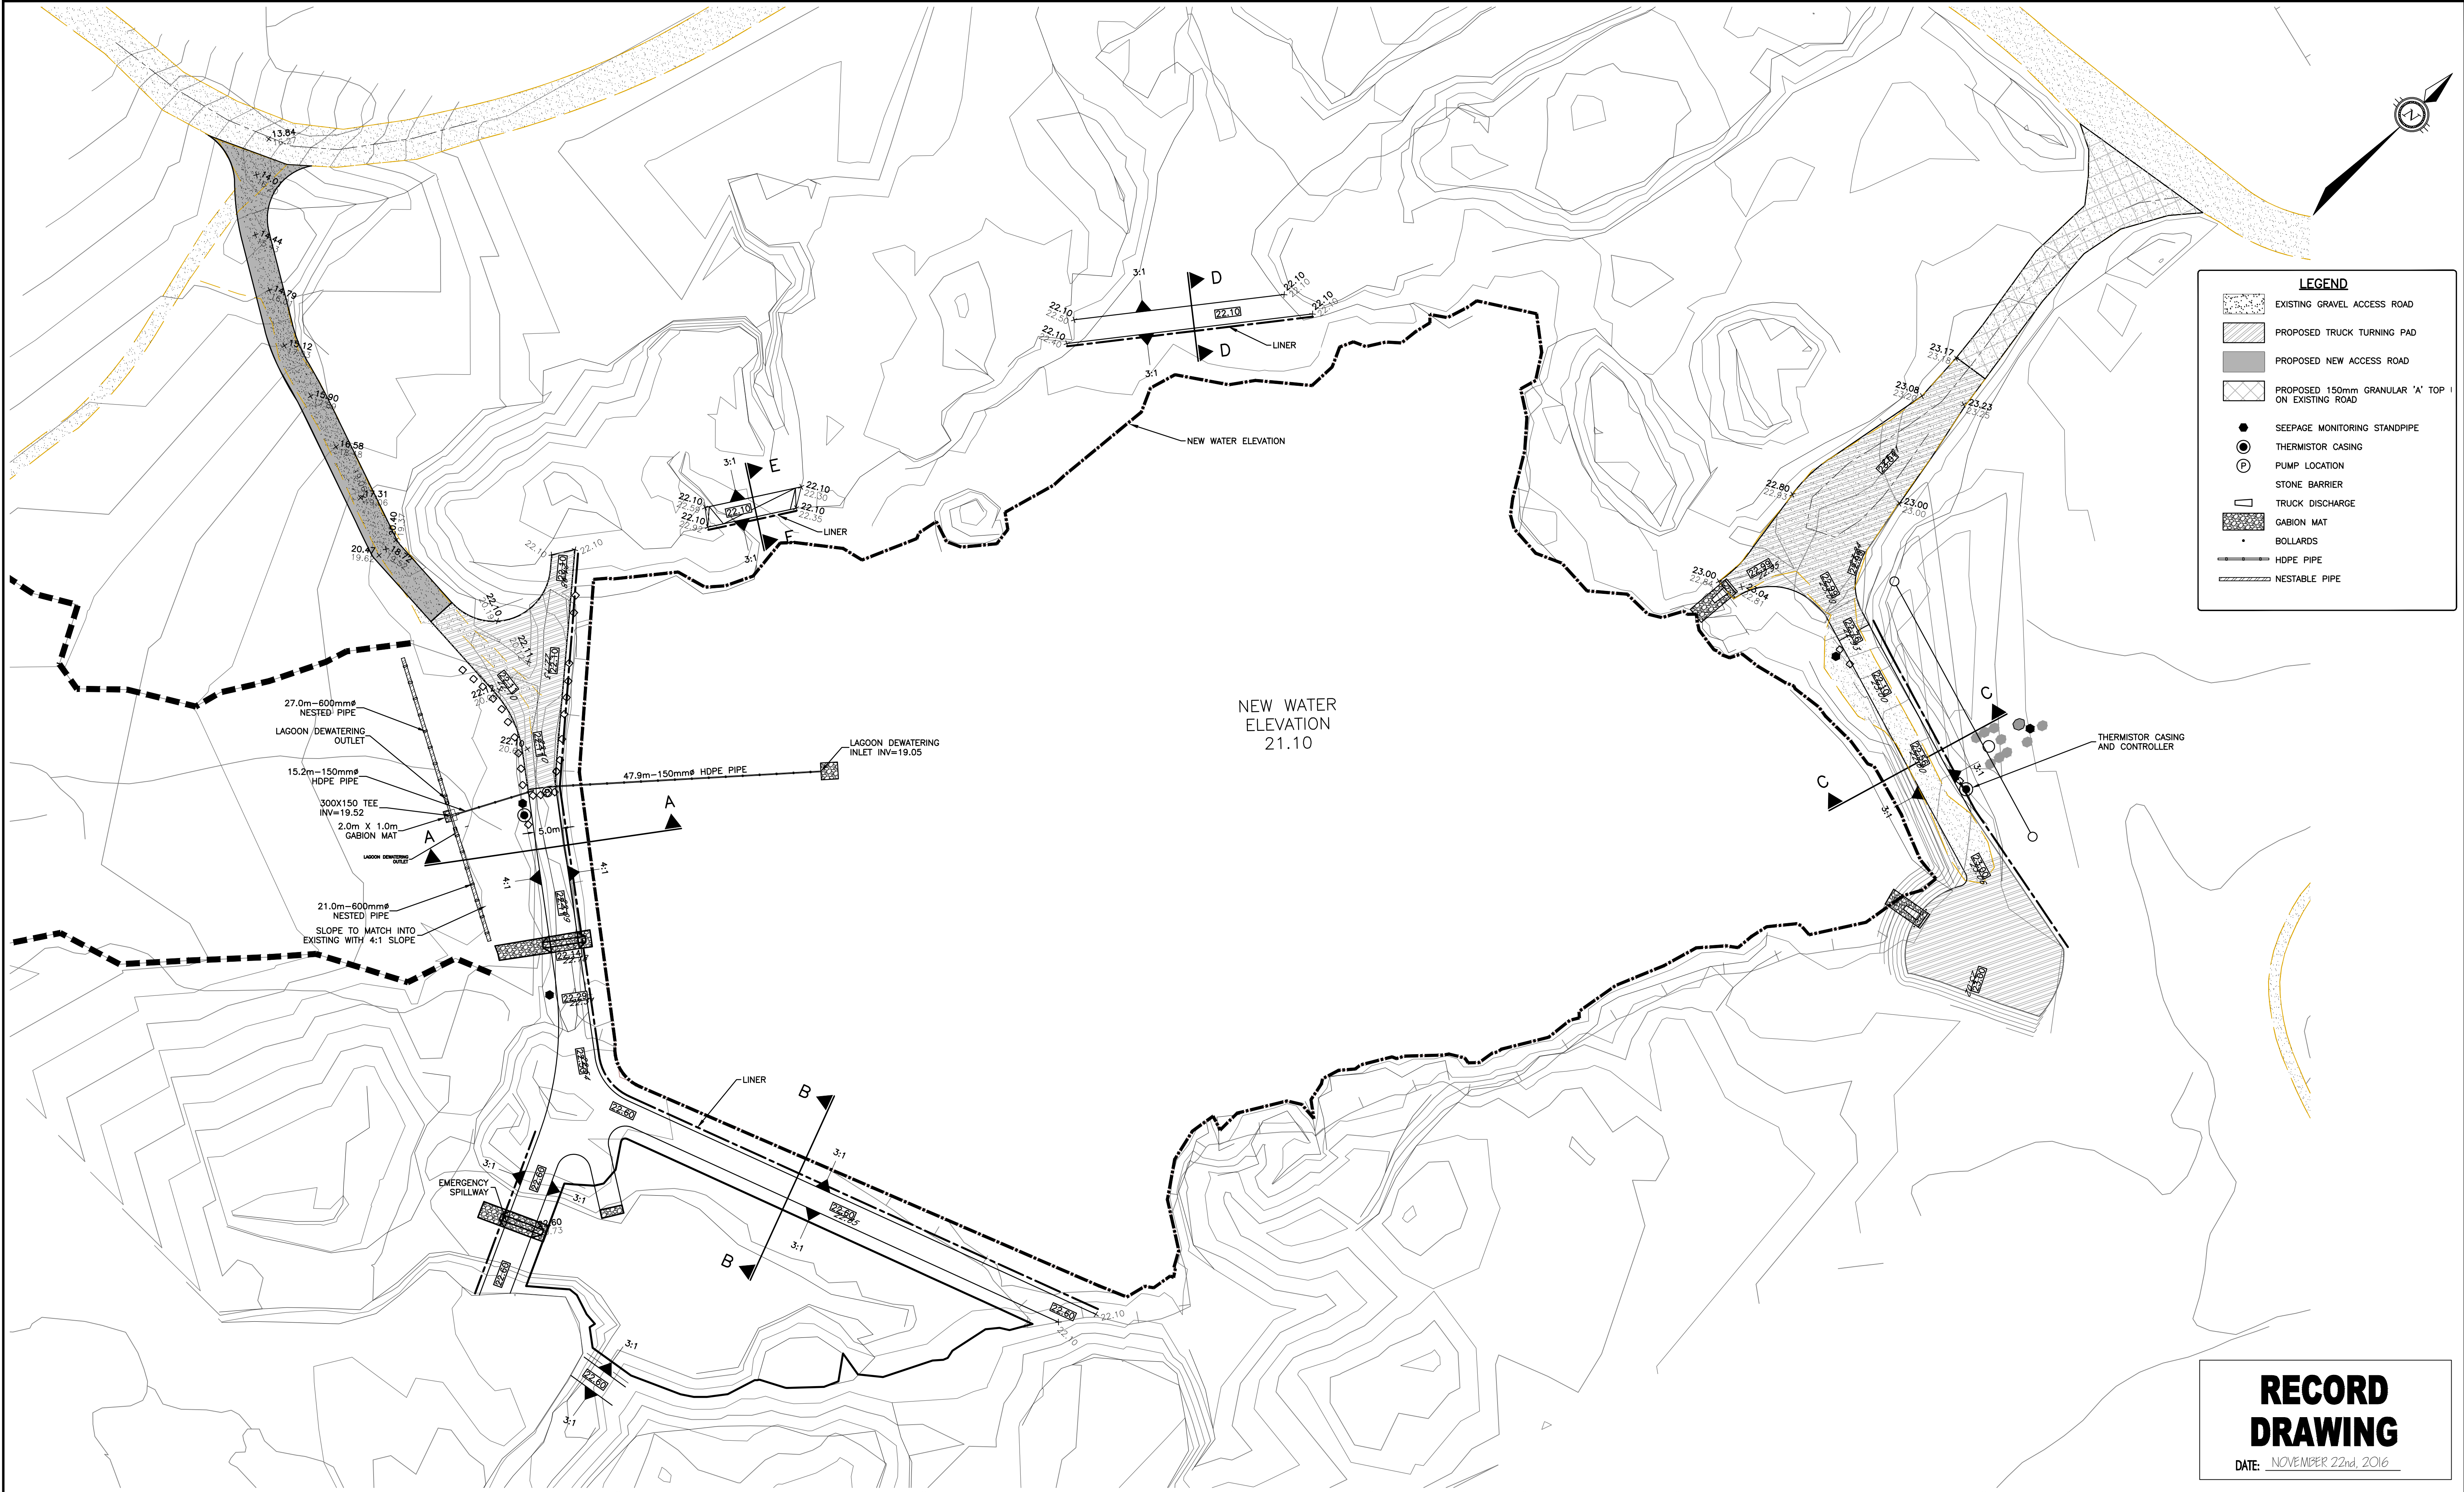

LEGEND

- EXISTING GRAVEL ACCESS ROAD
- PROPOSED TRUCK TURNING PAD
- PROPOSED NEW ACCESS ROAD
- PROPOSED 150mm GRANULAR 'A' TOP ON EXISTING ROAD
- SEEPAGE MONITORING STANDPIPE
- THERMISTOR CASING
- PUMP LOCATION
- STONE BARRIER
- TRUCK DISCHARGE
- GABION MAT
- BOLLARDS
- HDPE PIPE
- NESTABLE PIPE

RECORD DRAWING


DATE: NOVEMBER 22nd, 2016

NOTES																																																																																																																																																																																																																																																																																																																																																																																																																																																																																																																																																																																																																																																																																																																																																																																																																																																																																																																																																																																																																																																																																																																																																																																																																																																																																																																																																																																																																																																																																																																																																																																																																																																																																																																																																																																																																																																																																																																																																																																																																																																																																																																																																																																																																																																																																																																																																																																																																																																																																																																																																																																																																																																																																																																																																																																																																																																																																																																																																																																																																																																																																																																																																																																																																																																																																																																																																																																																																																																																																																																																																																																																																																																																																																																																																																																																																																																																																																																																																																																																																																																																																																																																																																																																																																																																																																																																																																																																																																																																																																																																																																																																																																																																																																																																																																																																																																																																																																																																																																																																																																																																																																																																																																																																																																																																																																																																																																																																																																																																																																																																																																																																																																																																																																																																																																																																																																																																																																																																																																																																																																																																																																																																																																																																																																																																																																																																																																																																																																																																		</									
-------	--	--	----	--	--	--	--	--	--	--	--	--

File name: p:\geographic information services\20100606-0001-369-a0-sewage lagoon eastland upgrade-whale cove-grfdrawing\04-2016-pro.dwg
 User: S.Burden
 Date Plotted: 11/22/2016 11:56:42 AM
 Plotted by: S.Burden
 Plotter: HP DesignJet T1100e
 Plot Device: HP DesignJet T1100e
 Plotter Driver: HP DesignJet T1100e
 Plotter Model: HP DesignJet T1100e
 Plotter Location: HP DesignJet T1100e
 Plotter Status: HP DesignJet T1100e
 Plotter Type: HP DesignJet T1100e
 Plotter Color: HP DesignJet T1100e
 Plotter Paper: HP DesignJet T1100e
 Plotter Scale: HP DesignJet T1100e
 Plotter Orientation: HP DesignJet T1100e
 Plotter Units: HP DesignJet T1100e
 Plotter Language: HP DesignJet T1100e
 Plotter Version: HP DesignJet T1100e
 Plotter Model: HP DesignJet T1100e
 Plotter Location: HP DesignJet T1100e
 Plotter Status: HP DesignJet T1100e
 Plotter Type: HP DesignJet T1100e
 Plotter Color: HP DesignJet T1100e
 Plotter Paper: HP DesignJet T1100e
 Plotter Scale: HP DesignJet T1100e
 Plotter Orientation: HP DesignJet T1100e
 Plotter Units: HP DesignJet T1100e
 Plotter Language: HP DesignJet T1100e
 Plotter Version: HP DesignJet T1100e

DATE: NOVEMBER 22nd, 2016

	EXISTING GRAVEL ACCESS ROAD
	PROPOSED TRUCK TURNING PAD
	PROPOSED NEW ACCESS ROAD
	PROPOSED 150mm GRANULAR 'A' TOP UP ON EXISTING ROAD
	SEEPAGE MONITORING STANDPIPE
	THERMISTOR CASING
	PUMP LOCATION
	STONE BARRIER
	TRUCK DISCHARGE
	GABION MAT
	BOLLARDS
	HDPE PIPE
	NESTABLE PIPE

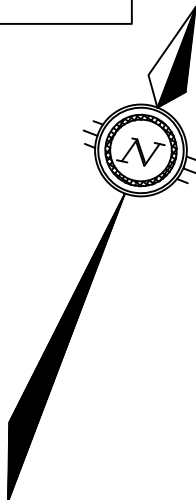

THE POSITION OF ALL POLE LINES, CONDUITS, WATERMAINS, SEWERS AND OTHER UNDERGROUND AND OVERGROUND UTILITIES AND STRUCTURES IS NOT NECESSARILY SHOWN ON THE CONTRACT DRAWINGS, AND WHERE SHOWN, THE ACCURACY OF THE POSITION OF SUCH UTILITIES AND STRUCTURES IS NOT GUARANTEED. BEFORE STARTING WORK, DETERMINE THE EXACT LOCATION OF ALL SUCH UTILITIES AND STRUCTURES AND ASSUME ALL LIABILITY FOR DAMAGE TO THEM.

[illegible]

CLIENT



exp Services Inc.
t: +1.613.688.1809 | f: +1.613.225.7338
2650 Queensview Drive, Unit 100
Ottawa, ON K2B 8H6
Canada
www.exp.com

• BUILDINGS • EARTH & ENVIRONMENT
• INDUSTRIAL • INFRASTRUCTURE

CAD	S.BUTLER
PROJ. MAN	S.BURDEN
APPROVED	S.BURDEN

SEWAGE LAGOON
WHALE COVE, NUNAVUT






TITLE

TRUCK DISCHARGE AND PUMP LOCATION
SITE PLANS

11

TDSP-1

DATE: NOVEMBER 22nd, 2016

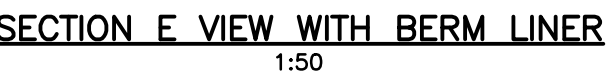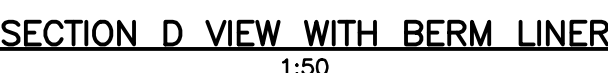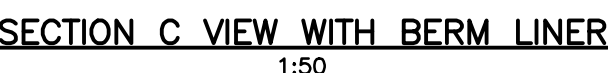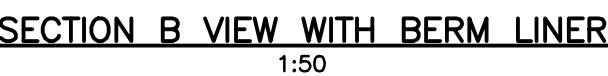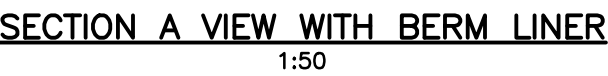


THE POSITION OF ALL POLE LINES, CONDUITS, WATERMAINS, SEWERS AND OTHER UNDERGROUND AND OVERGROUND UTILITIES AND STRUCTURES IS NOT NECESSARILY SHOWN ON THE CONTRACT DRAWINGS, AND WHERE SHOWN, THE ACCURACY OF THE POSITION OF SUCH UTILITIES AND STRUCTURES IS NOT GUARANTEED. BEFORE STARTING WORK DETERMINE THE EXACT LOCATION OF ALL SUCH UTILITIES AND STRUCTURES AND ASSUME ALL LIABILITY FOR DAMAGE TO THEM.


[illegible]

RECORD
DRAWING


DATE: NOVEMBER 22nd, 2016

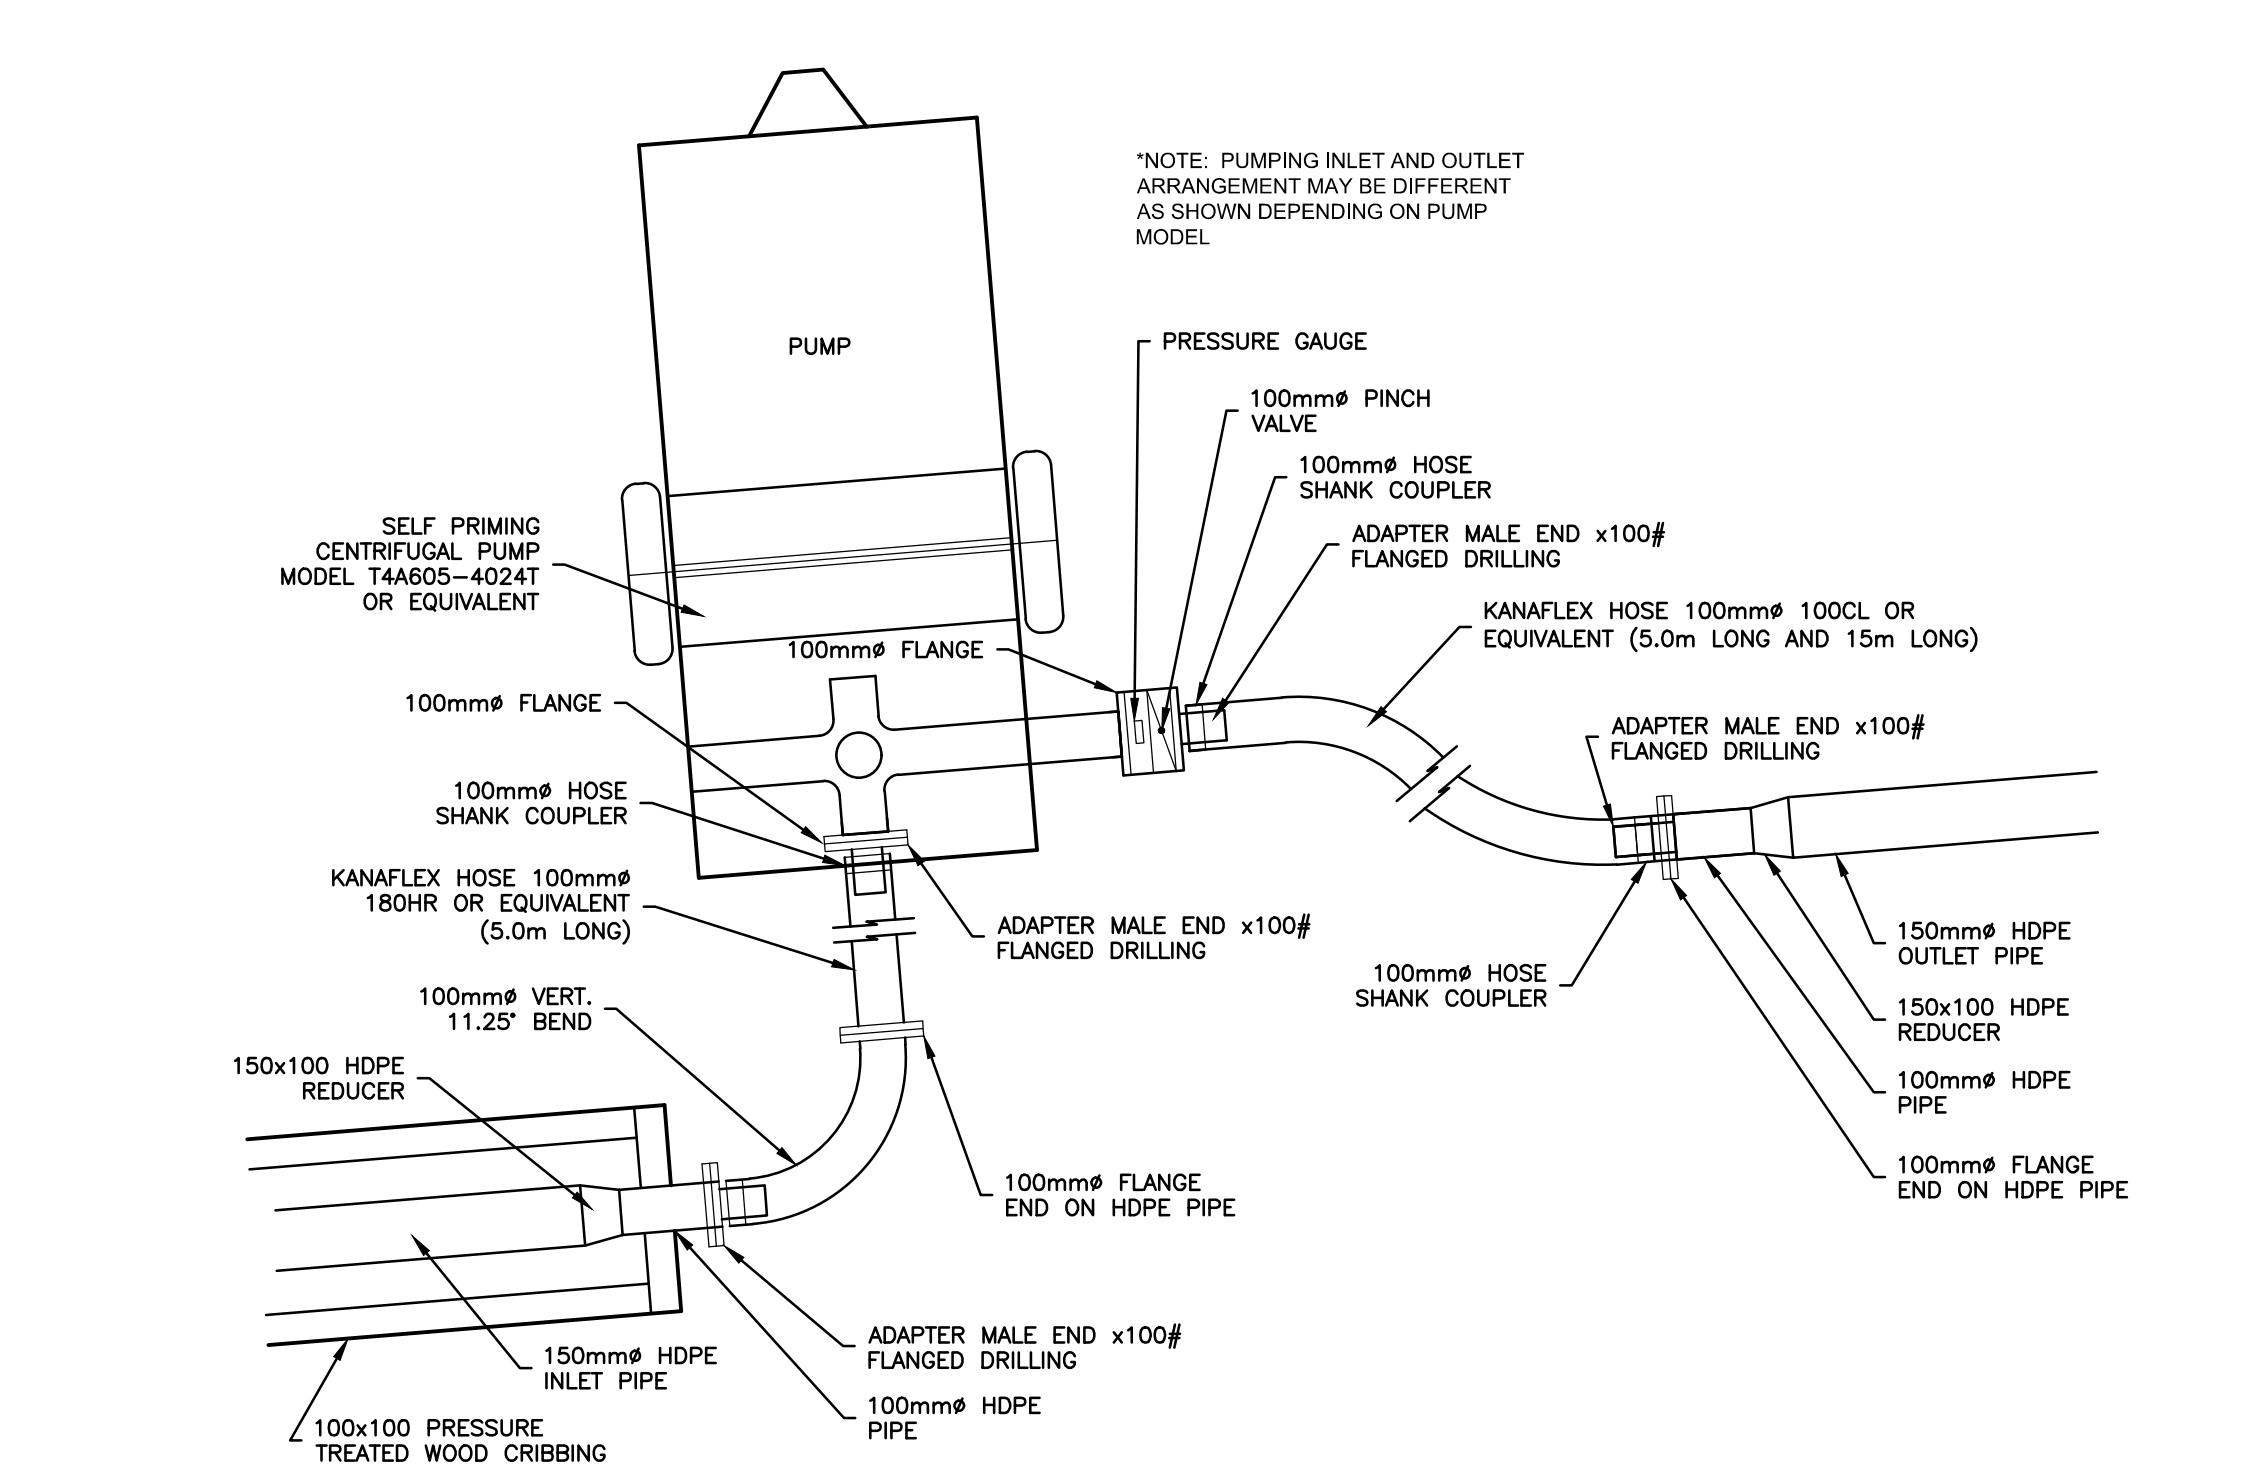


LAGOON DEWATERING PUMP INFRASTRUCTURE PLAN VIEW
1:25

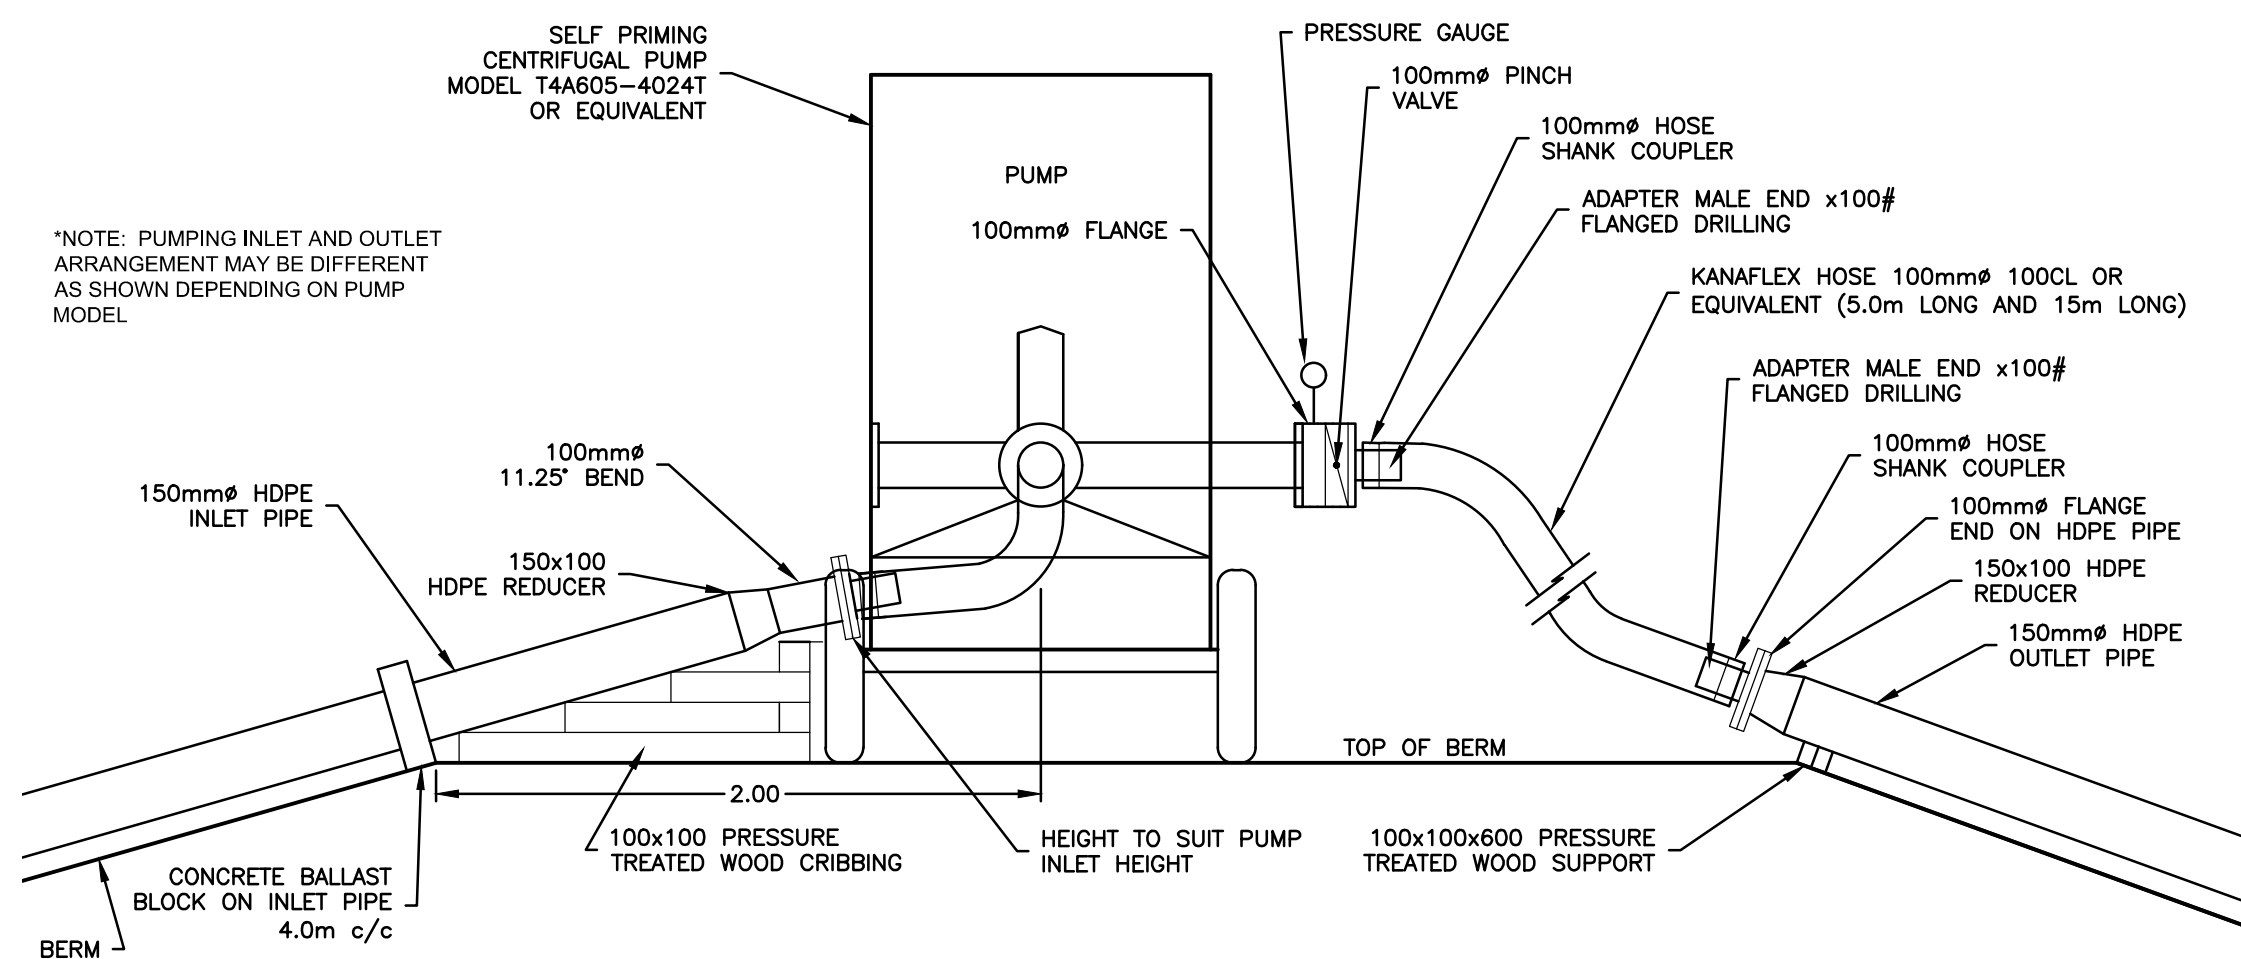

LAGOON DEWATERING PUMP INFRASTRUCTURE
1:25

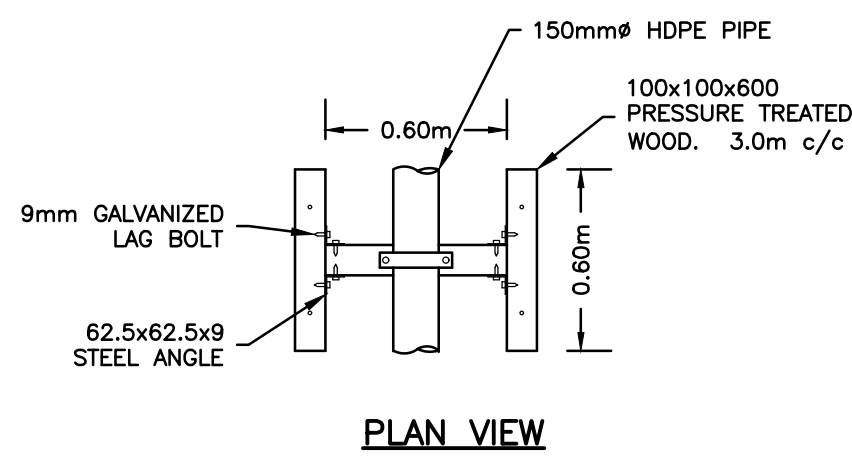


PLAN VIEW

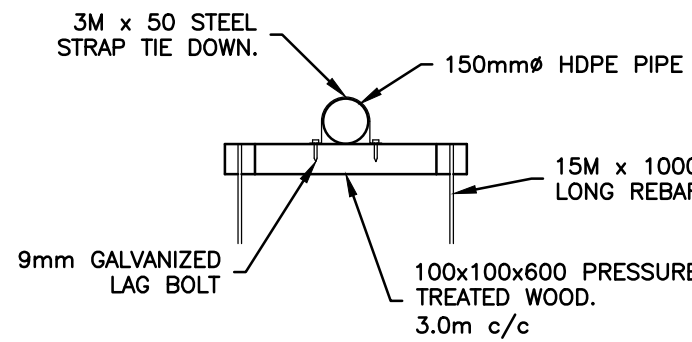


SECTION VIEW


OUTLET PIPE SUPPORT
1:25

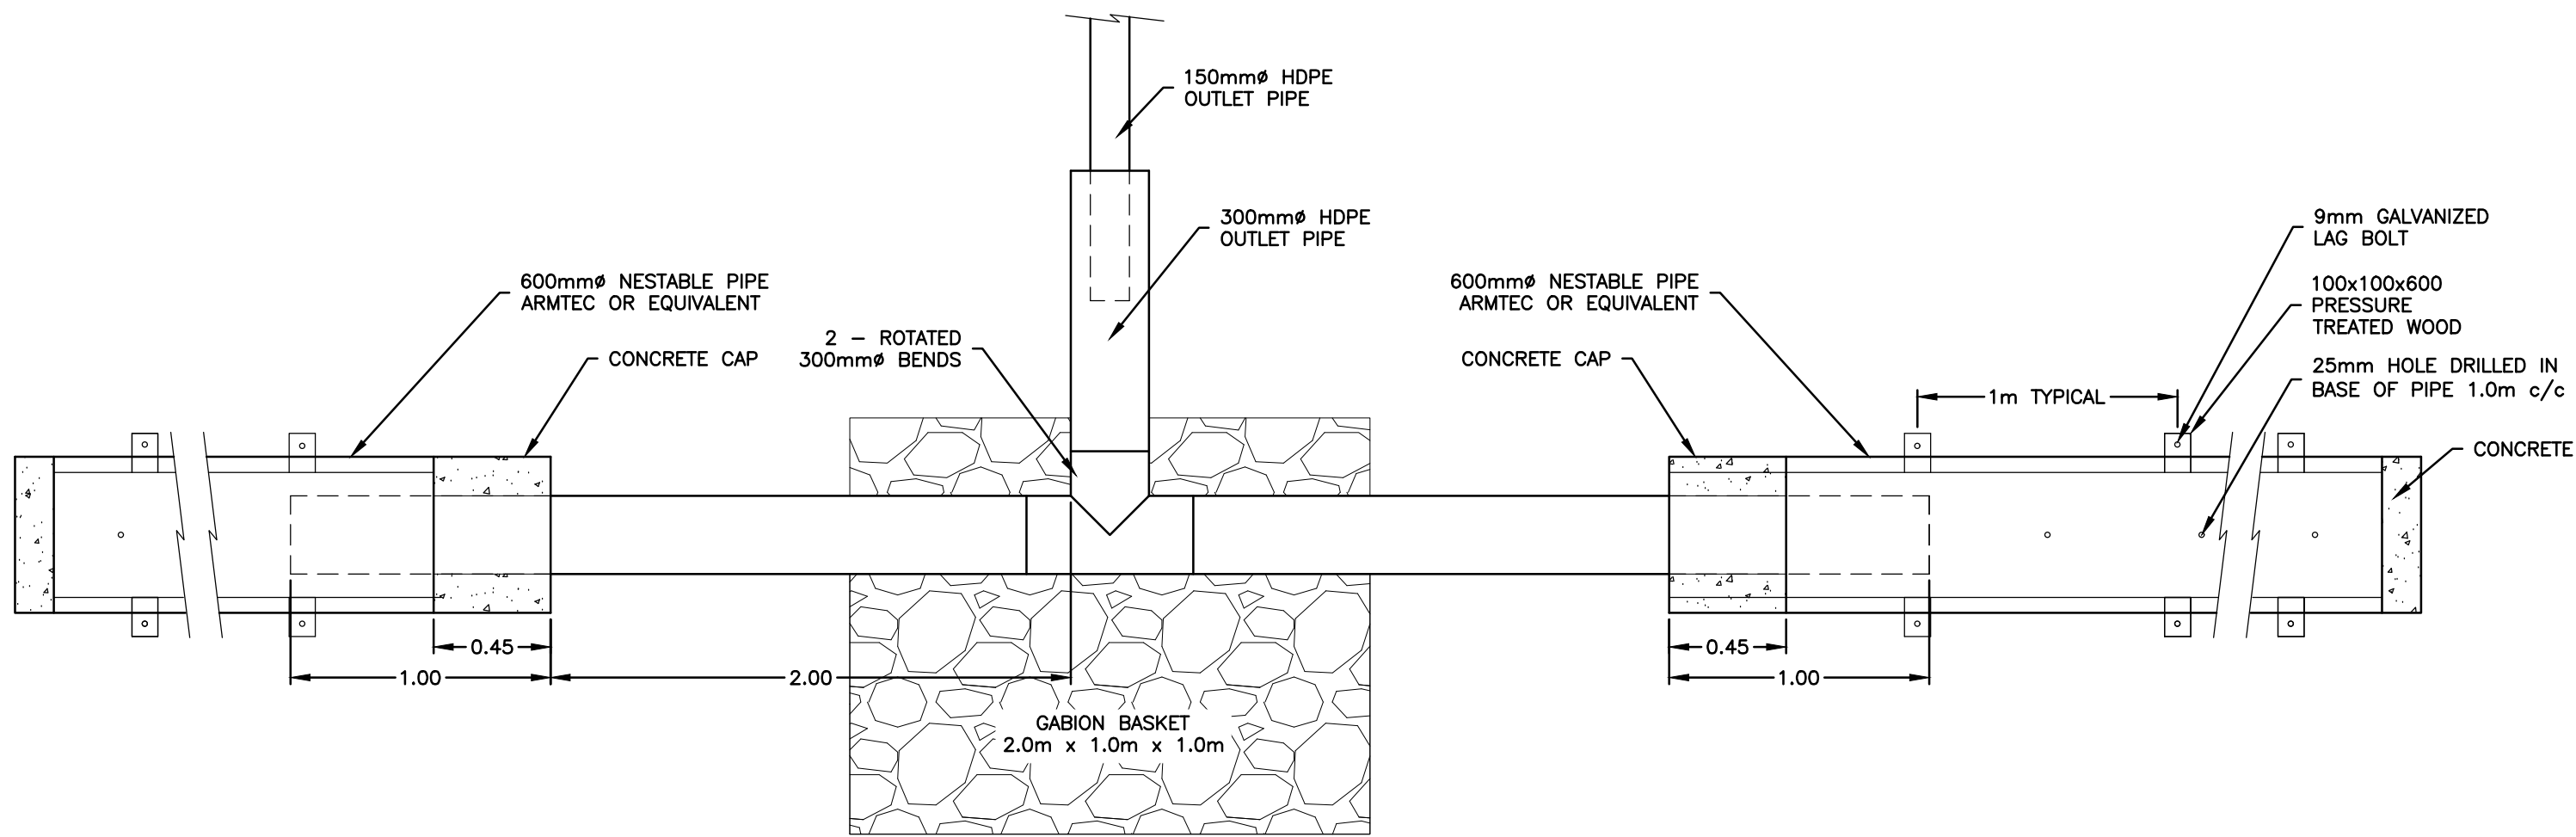


PLAN VIEW
1:25

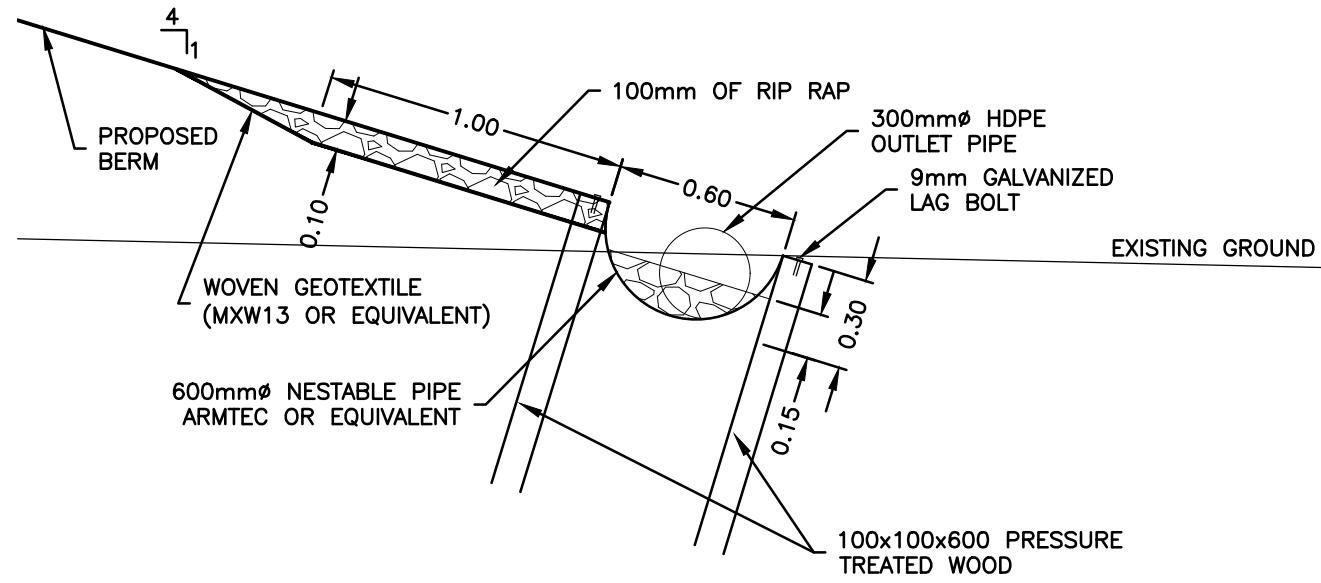

NESTABLE PIPE DETAIL END VIEW
1:25

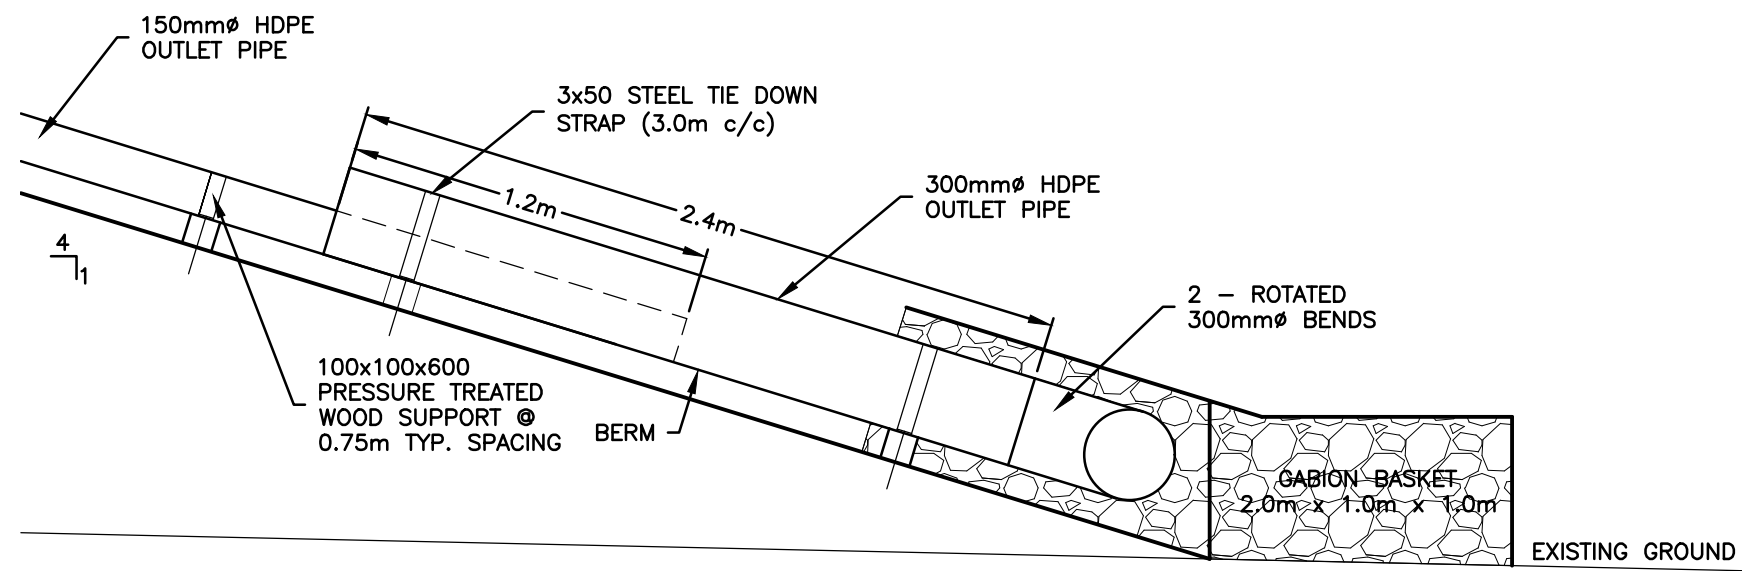


LAGOON DEWATERING OUTLET INFRASTRUCTURE SECTION VIEW
1:25

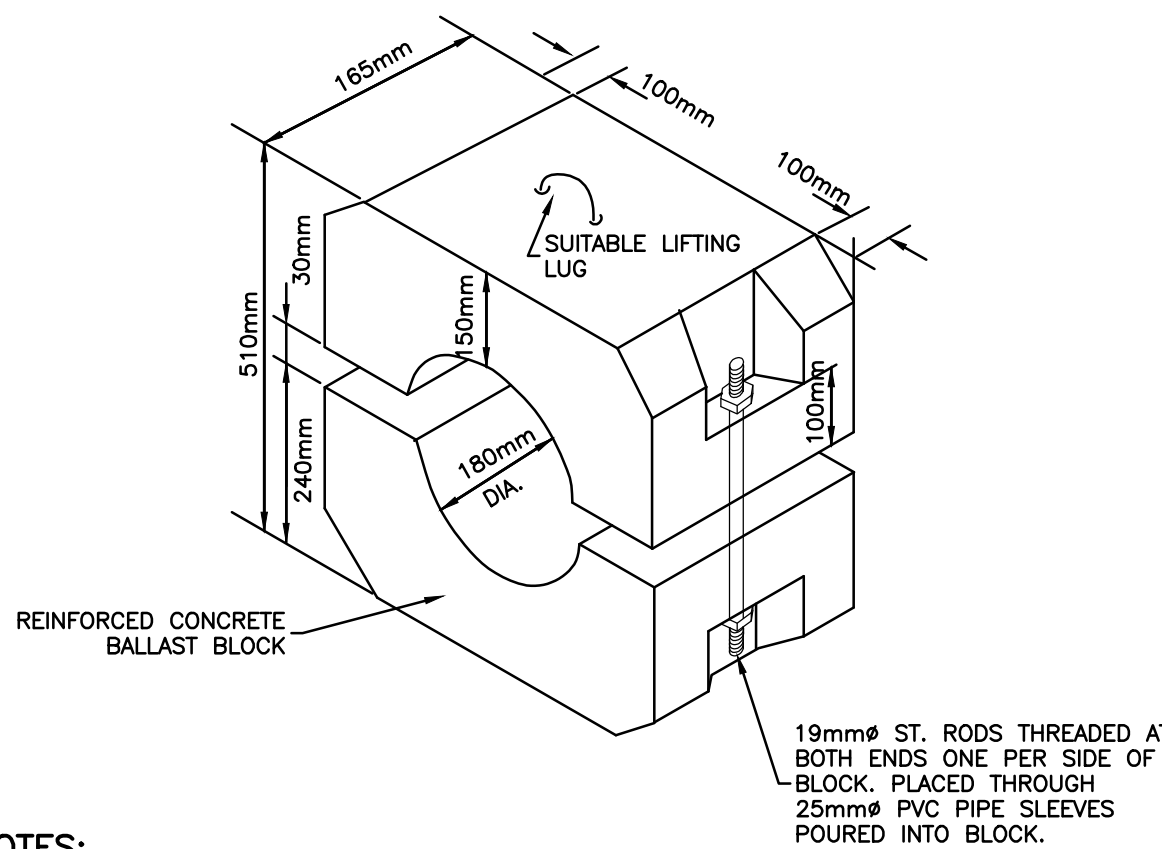

NOTES:

- CONTRACTOR TO SUBMIT SHOP DRAWINGS FOR CONCRETE BALLAST BLOCKS C/W REINFORCING.
- CONTRACTOR TO USE 6.25mm THICK NEOPRENE SPONGE PADDING BETWEEN PIPE AND BLOCKS TO PREVENT CONTACT. WIDTH TO BE 180mm.

CONCRETE BALLAST BLOCK
N.T.S

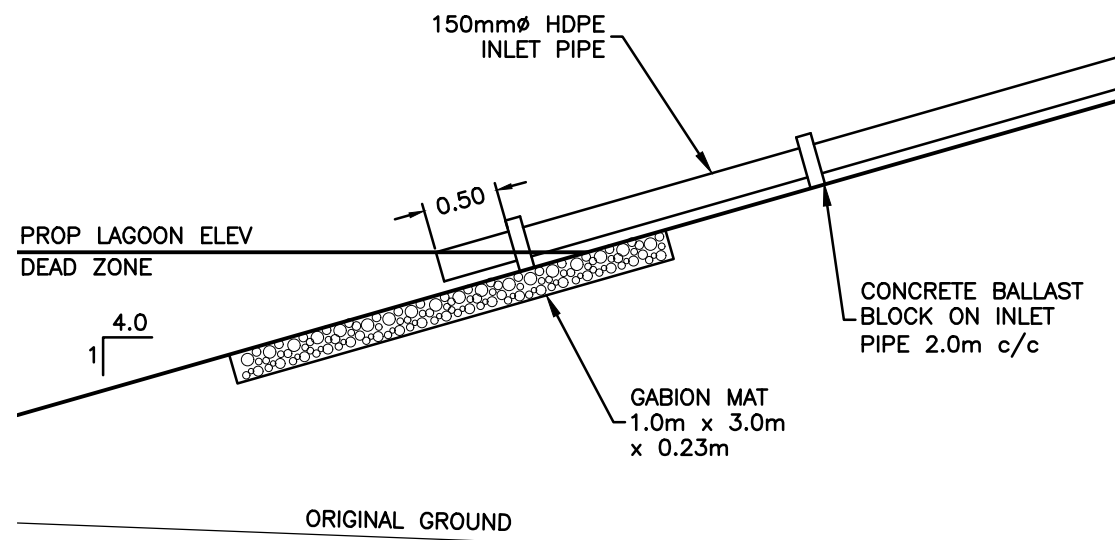

LAGOON DEWATERING INLET
1:50

NOTES

THE POSITION OF ALL POLE LINES, CONDUITS, WATERMAINS, SEWERS AND OTHER UNDERGROUND AND OVERGROUND UTILITIES AND STRUCTURES IS NOT NECESSARILY SHOWN ON THE CONTRACT DRAWINGS, AND WHERE SHOWN, THE ACCURACY OF THE POSITION OF SUCH UTILITIES AND STRUCTURES IS NOT GUARANTEED. BEFORE STARTING WORK, DETERMINE THE EXACT LOCATION OF ALL SUCH UTILITIES AND STRUCTURES AND ASSUME ALL LIABILITY FOR DAMAGE TO THEM.

NO.	REVISION DESCRIPTION	DATE	BY	APPD	NO.	REVISION DESCRIPTION	DATE	BY	APPD
					4	ISSUED FOR CONSTRUCTION	14/04/16	IPC	SLB
					3	ISSUED FOR TENDER	19/12/14	IPC	SLB
					2	ISSUED FOR TENDER	25/02/14	MCK	SLB
					1	ISSUED FOR REVIEW	24/02/12	SAB	SLB

SCALE

DESIGNED BY

REVIEWED BY

CLIENT

GOVERNMENT OF NUNAVUT
DEPARTMENT OF COMMUNITY
AND GOVERNMENT SERVICES



exp Services Inc.
1-813-588-1880 | 1-813-225-7337
2025 Carleton Place, Suite 100
Ottawa, ON K2B 6R6
Canada
www.exp.com

• BUILDINGS • EARTH & ENVIRONMENT • ENERGY •
• INDUSTRIAL • INFRASTRUCTURE • SUSTAINABILITY •

BASEPLAN
DESIGN
CHECKED
CADD
PROJ. MAN
APPROVED

S.BUTLER

S.DOUGLAS

S.DOUGLAS

S.BUTLER

S.BURDEN

S. BURDEN

PROJECT

SEWAGE LAGOON
WHALE COVE, NUNAVUT

DETAIL PLAN
PUMPING AND DEWATERING DETAILS

PROJ. NO.

OTT-00201369A

SURVEY

DATE


FEB 2012

DRAWING NO.


DE-1

RECORD
DRAWING


DATE: NOVEMBER 22nd, 2016

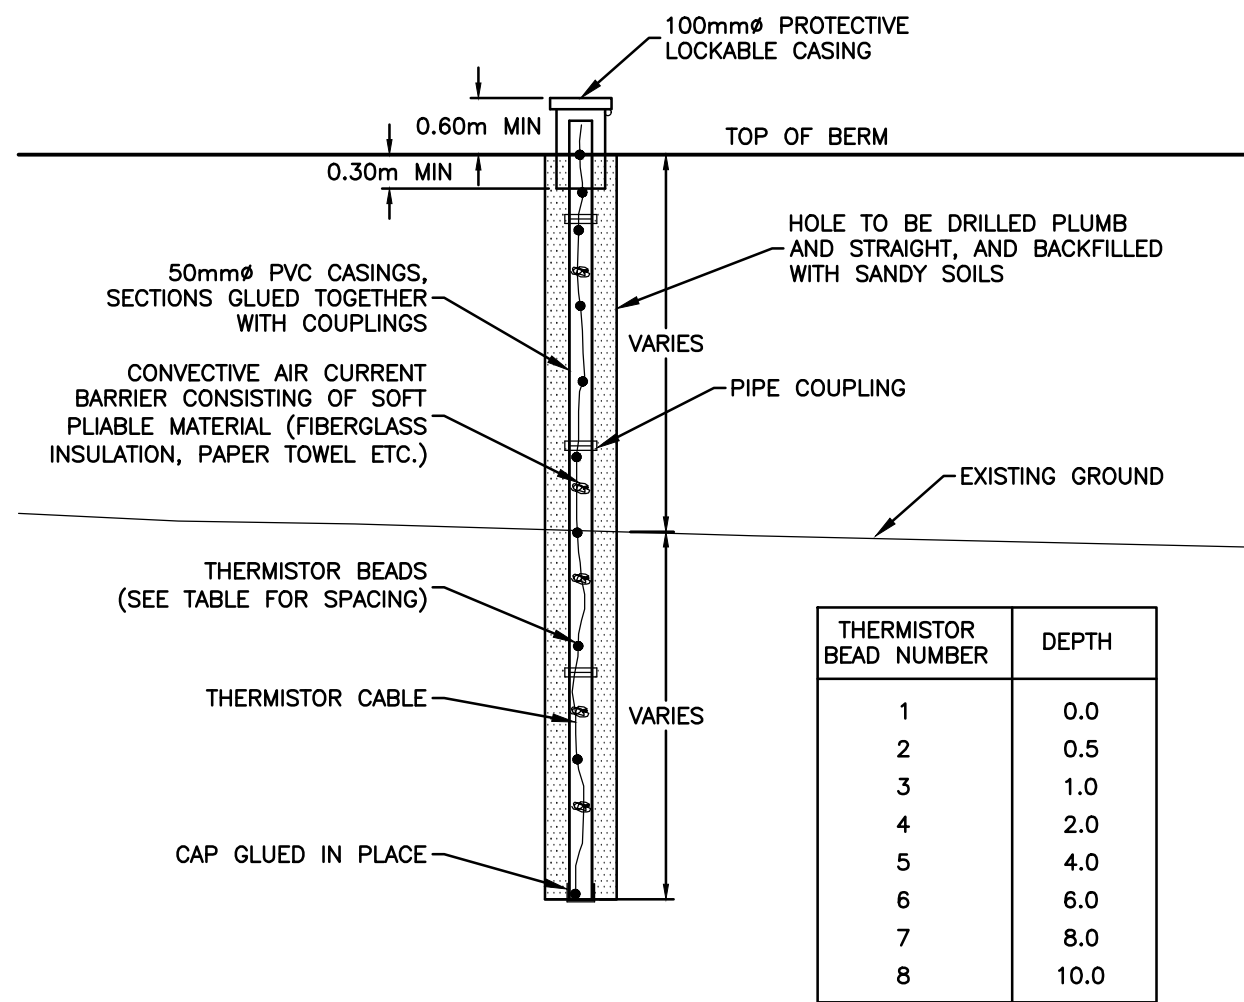


THERMISTOR DETAIL
N.T.S.

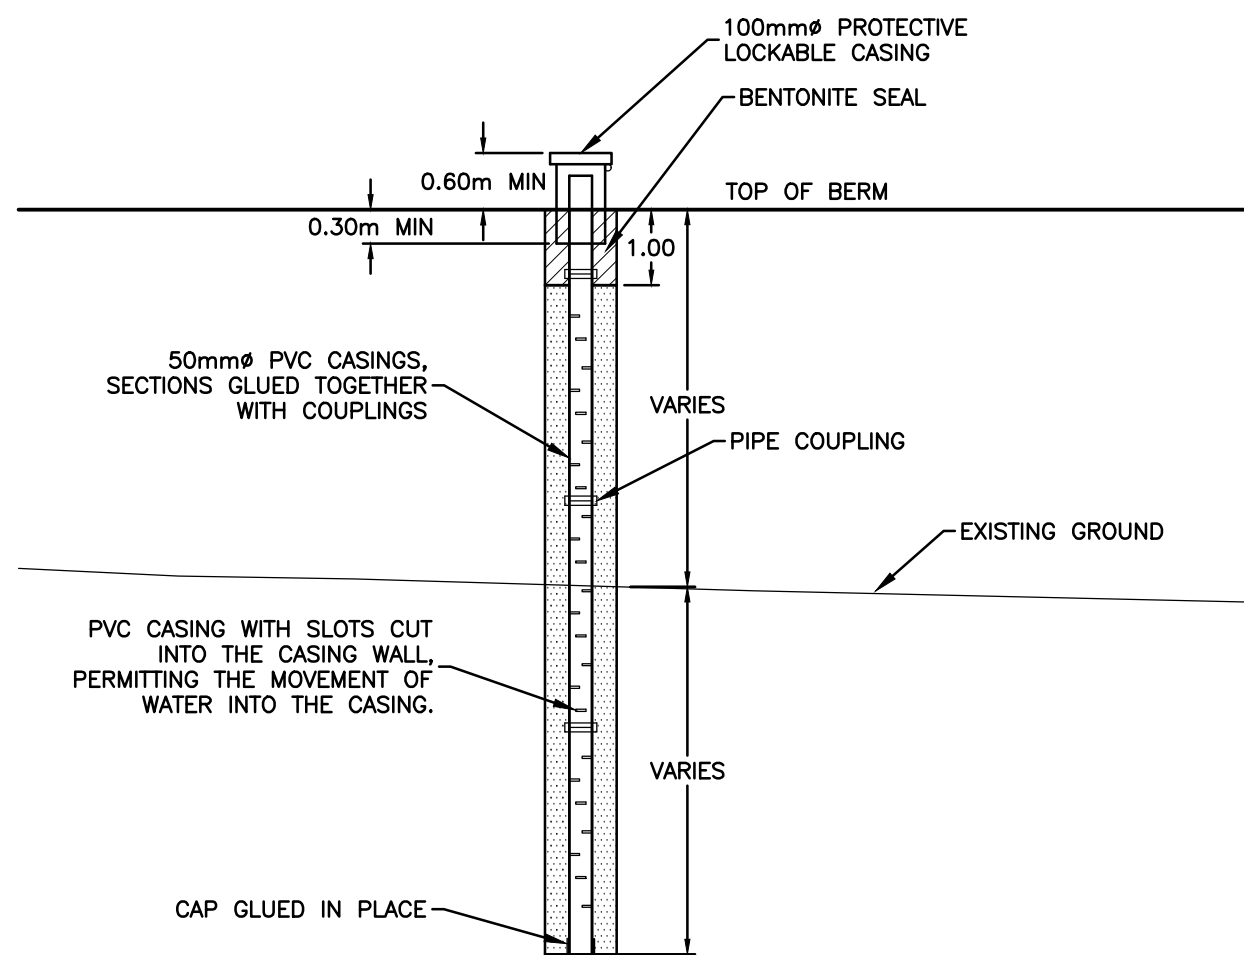


SEEPAGE MONITORING CASING DETAIL
N.T.S.

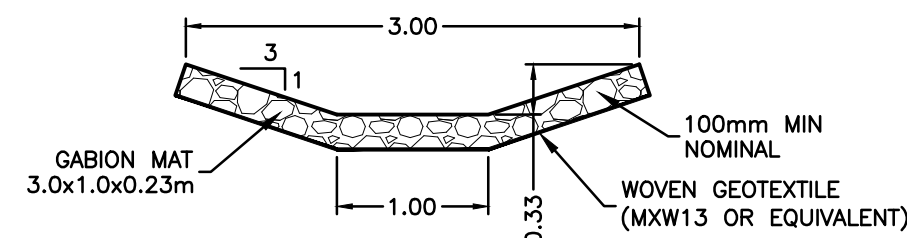


SPILLWAY DETAIL SECTION VIEW A-A

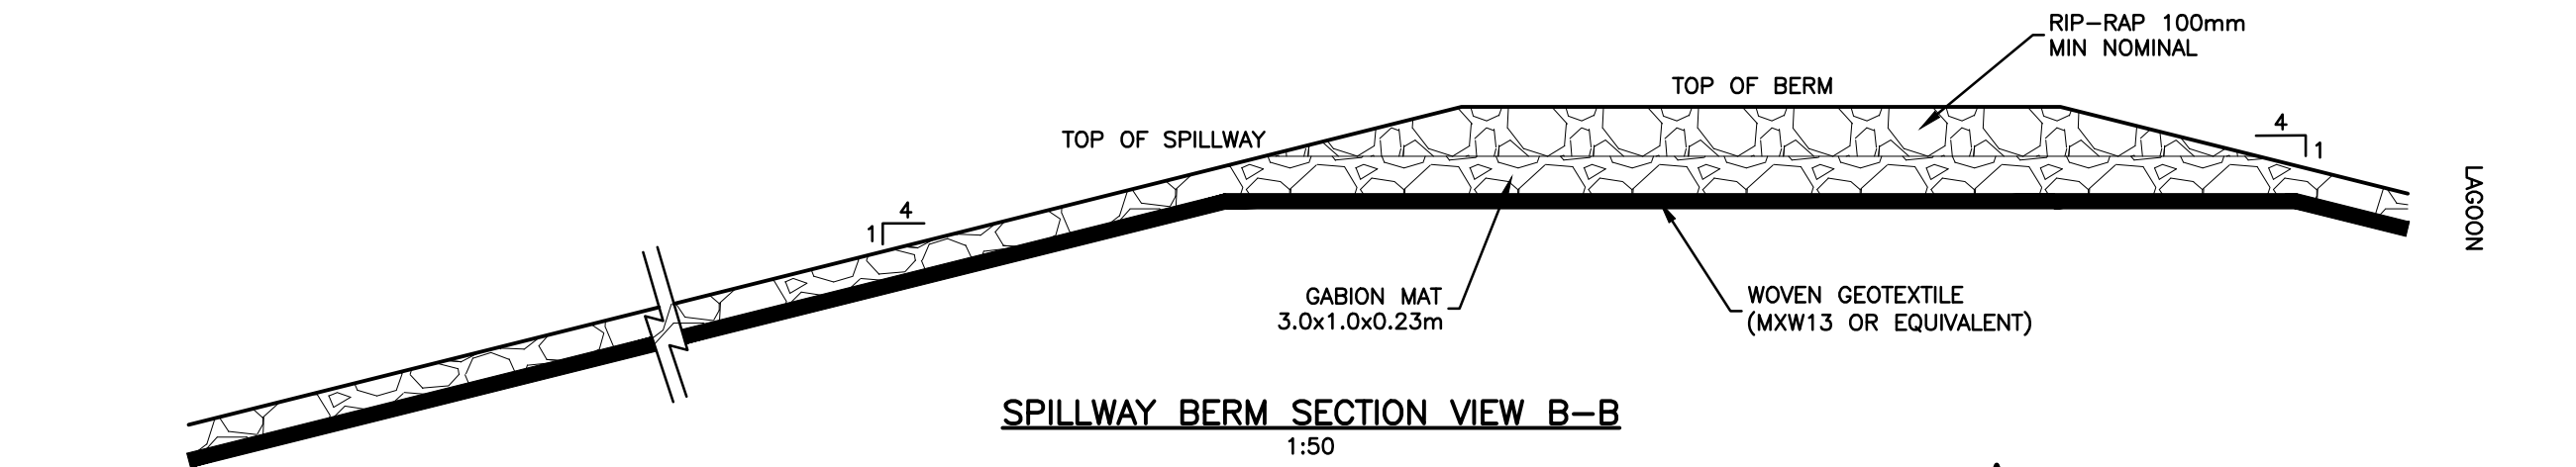


SPILLWAY BERM SECTION VIEW B-B

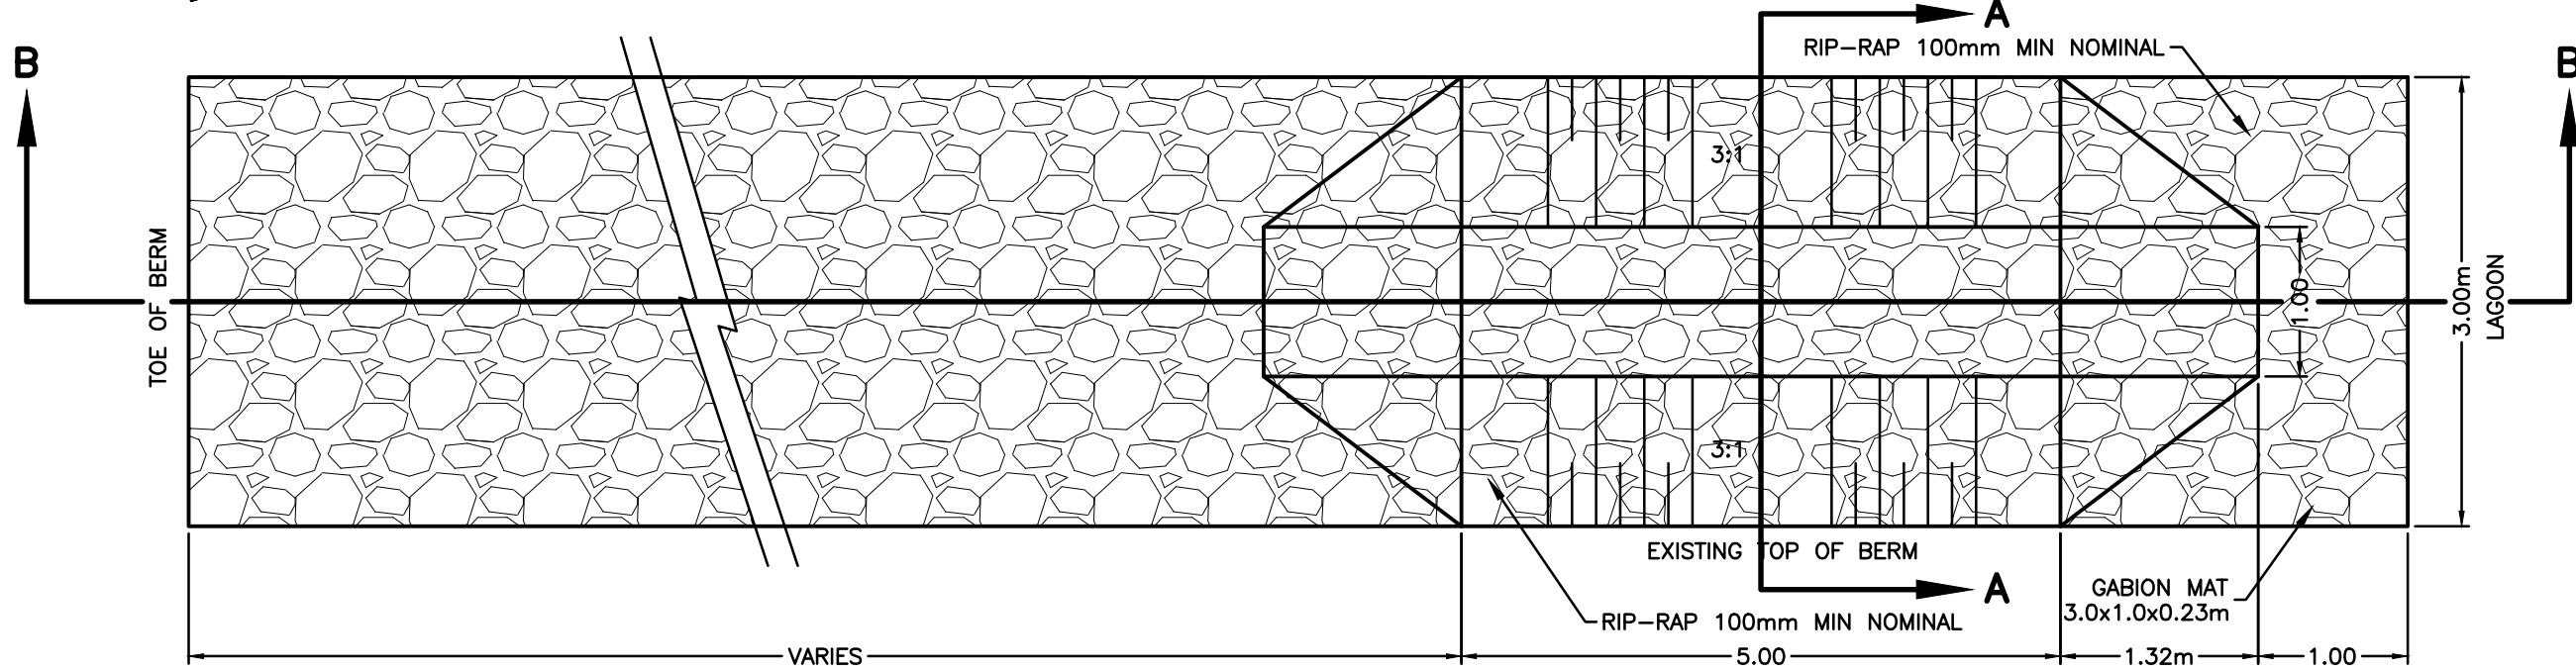


SPILLWAY BERM PLAN VIEW

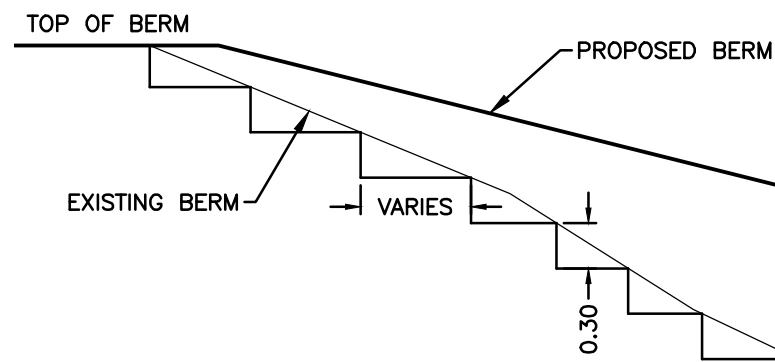


KEY IN DETAIL
1:50

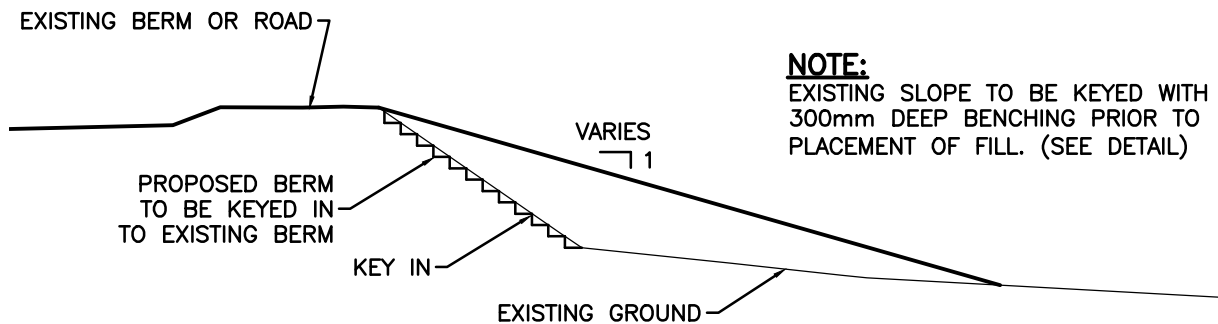

EXISTING BERM REHABILITATION DETAIL
1:200

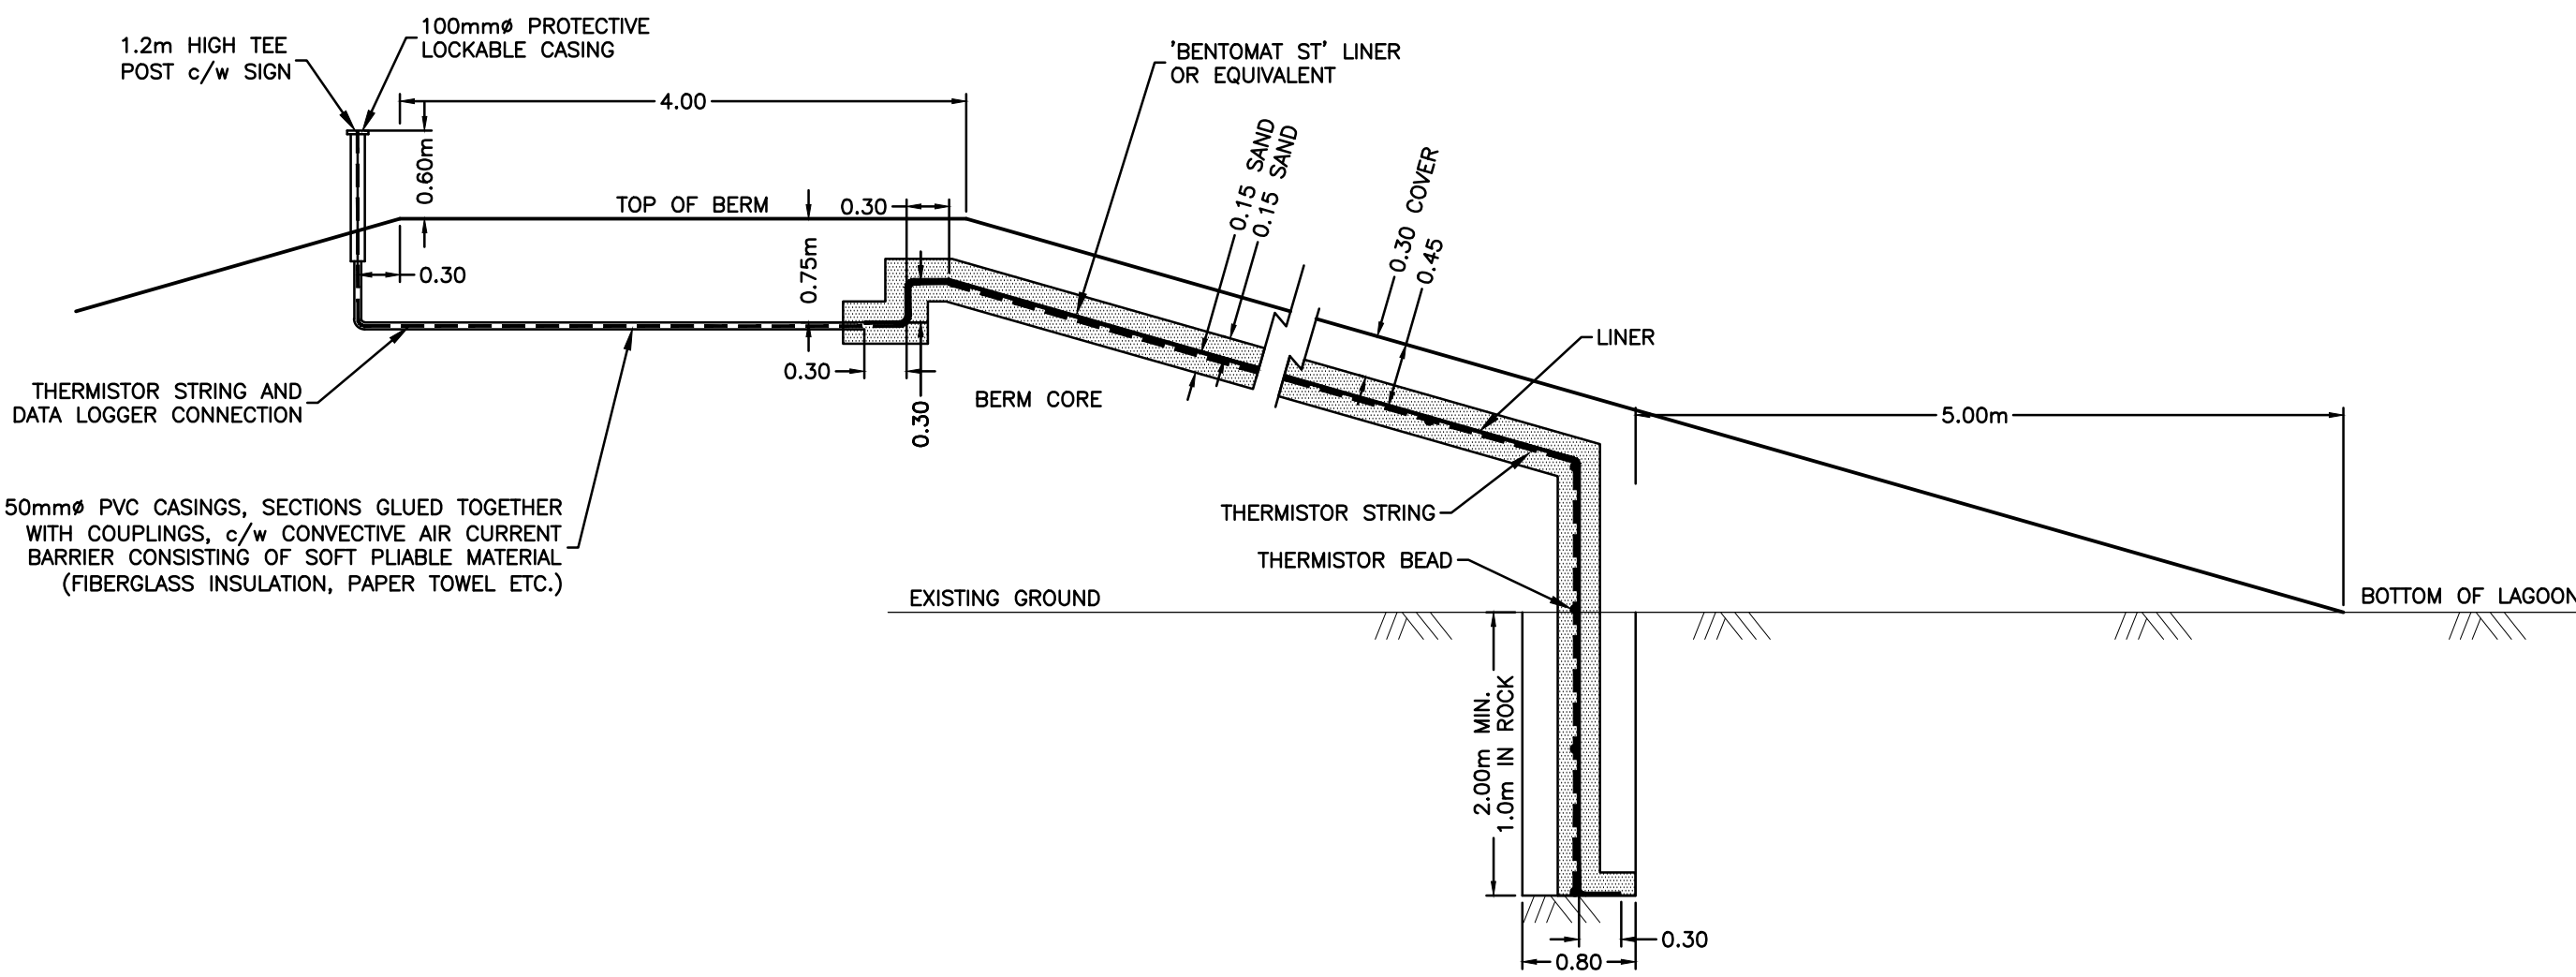

BERM LINER AND LINER DETECTION - THERMISTOR STRING DETAIL
1:50

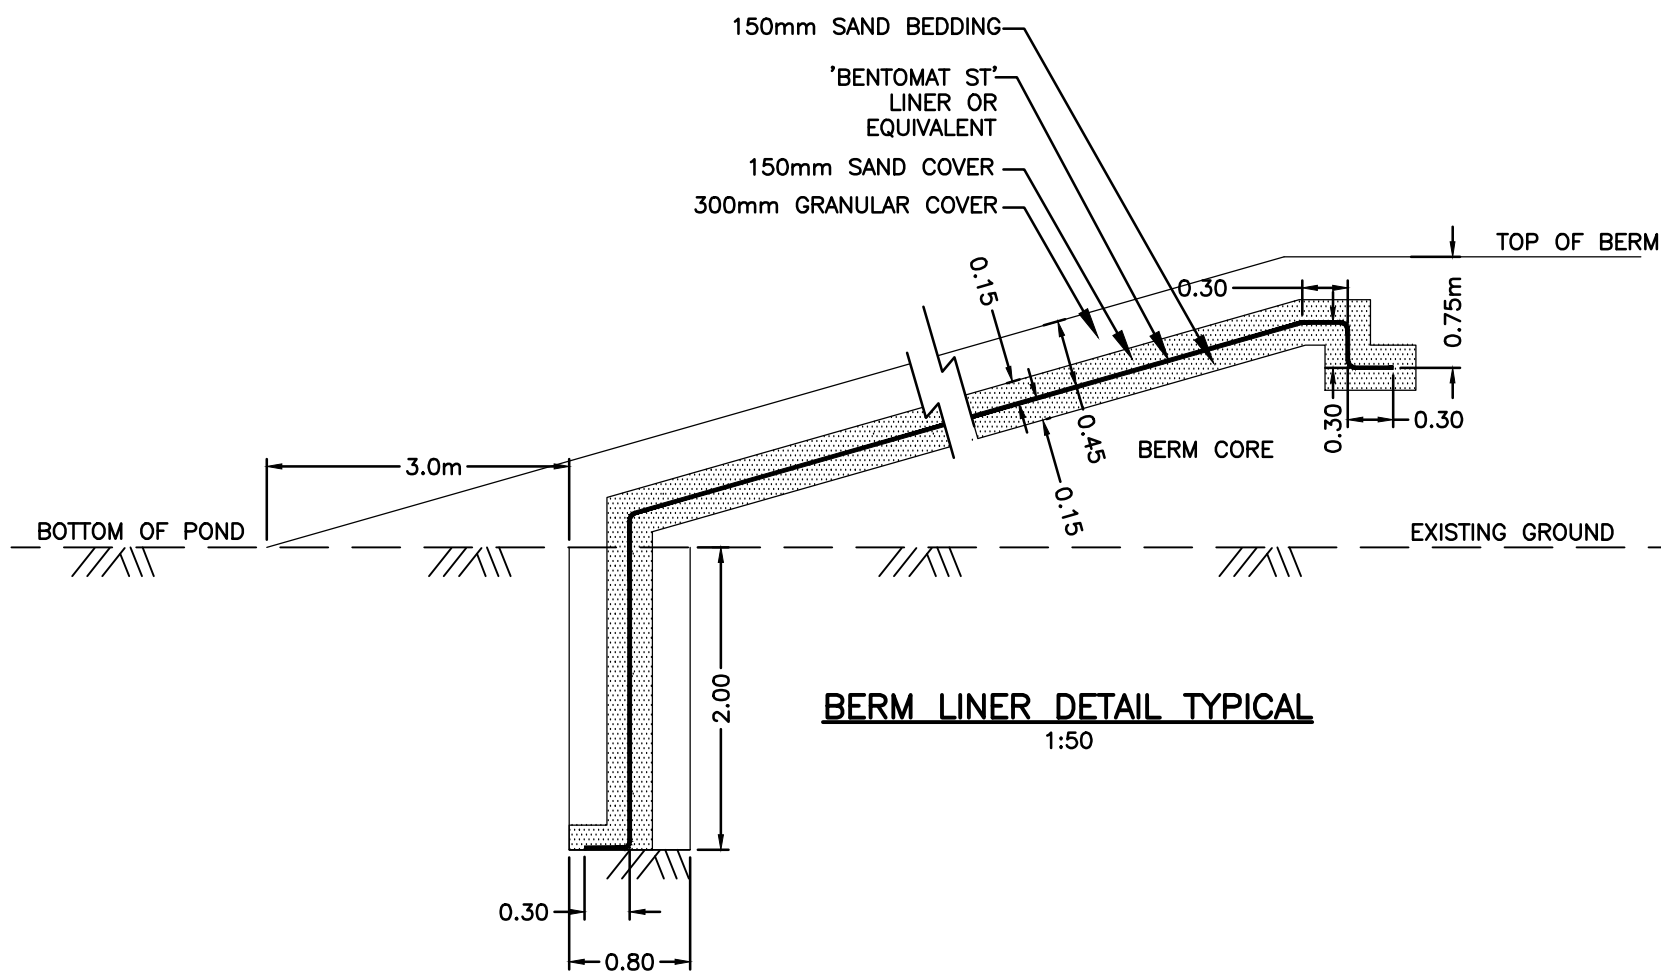

BERM LINER DETAIL TYPICAL
1:50

NOTES

THE POSITION OF ALL POLE LINES, CONDUITS, WATERMAINS, SEWERS AND OTHER UNDERGROUND AND OVERGROUND UTILITIES AND STRUCTURES IS NOT NECESSARILY SHOWN ON THE CONTRACT DRAWINGS, AND WHERE SHOWN, THE ACCURACY OF THE POSITION OF SUCH UTILITIES AND STRUCTURES IS NOT GUARANTEED. BEFORE STARTING WORK, DETERMINE THE EXACT LOCATION OF ALL SUCH UTILITIES AND STRUCTURES AND ASSUME ALL LIABILITY FOR DAMAGE TO THEM.

NO.	REVISION DESCRIPTION	DATE	BY	APPD	NO.	REVISION DESCRIPTION	DATE	BY	APPD
					4	ISSUED FOR CONSTRUCTION	14/04/16	IPC	SLB
					3	ISSUED FOR TENDER	19/12/14	IPC	SLB
					2	ISSUED FOR TENDER	25/02/14	MCK	SLB
					1	ISSUED FOR REVIEW	24/02/12	SAB	SLB

SCALE

DESIGNED BY

REVIEWED BY

CLIENT

GOVERNMENT OF NUNAVUT
DEPARTMENT OF COMMUNITY
AND GOVERNMENT SERVICES



exp Services Inc.
1-813-688-1880 | 1-813-225-7337
2025 Queen's Road East, Suite 100
Oshawa, ON M5B 6H6
Canada
www.exp.com
• BUILDINGS • EARTH & ENVIRONMENT • ENERGY •
• INDUSTRIAL • INFRASTRUCTURE • SUSTAINABILITY •

BASEPLAN	S.BUTLER
DESIGN	S.DOUGLAS
CHECKED	S.DOUGLAS
CAD	S.BUTLER
PROJ. MAN	S.BURDEN
APPROVED	

PROJECT
SEWAGE LAGOON
WHALE COVE, NUNAVUT


DETAIL PLAN
BERM AND THERMISTOR DETAILS

PROJ. NO.
OTT-00201369A


SURVEY
exp.

DATE
FEB 2012


DRAWING NO.
DE-2

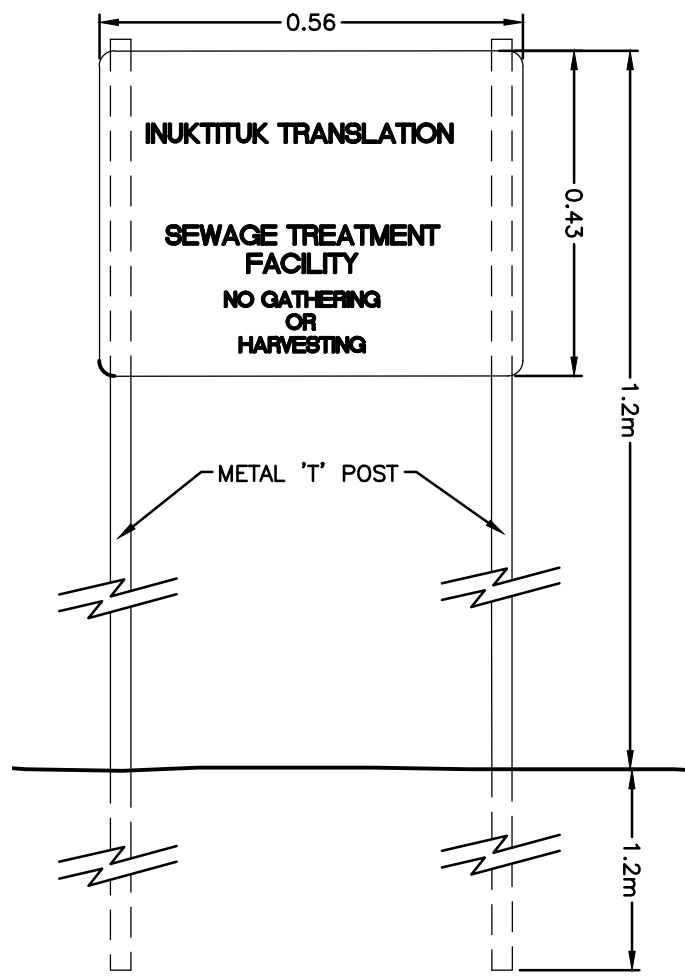


SIGN DETAIL
SCALE 1:10

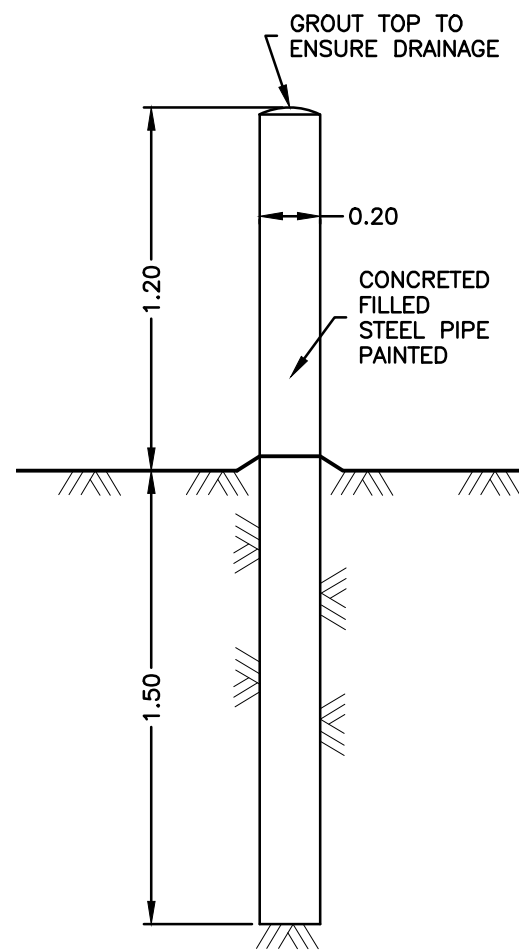


BOLLARD DETAIL
1:25

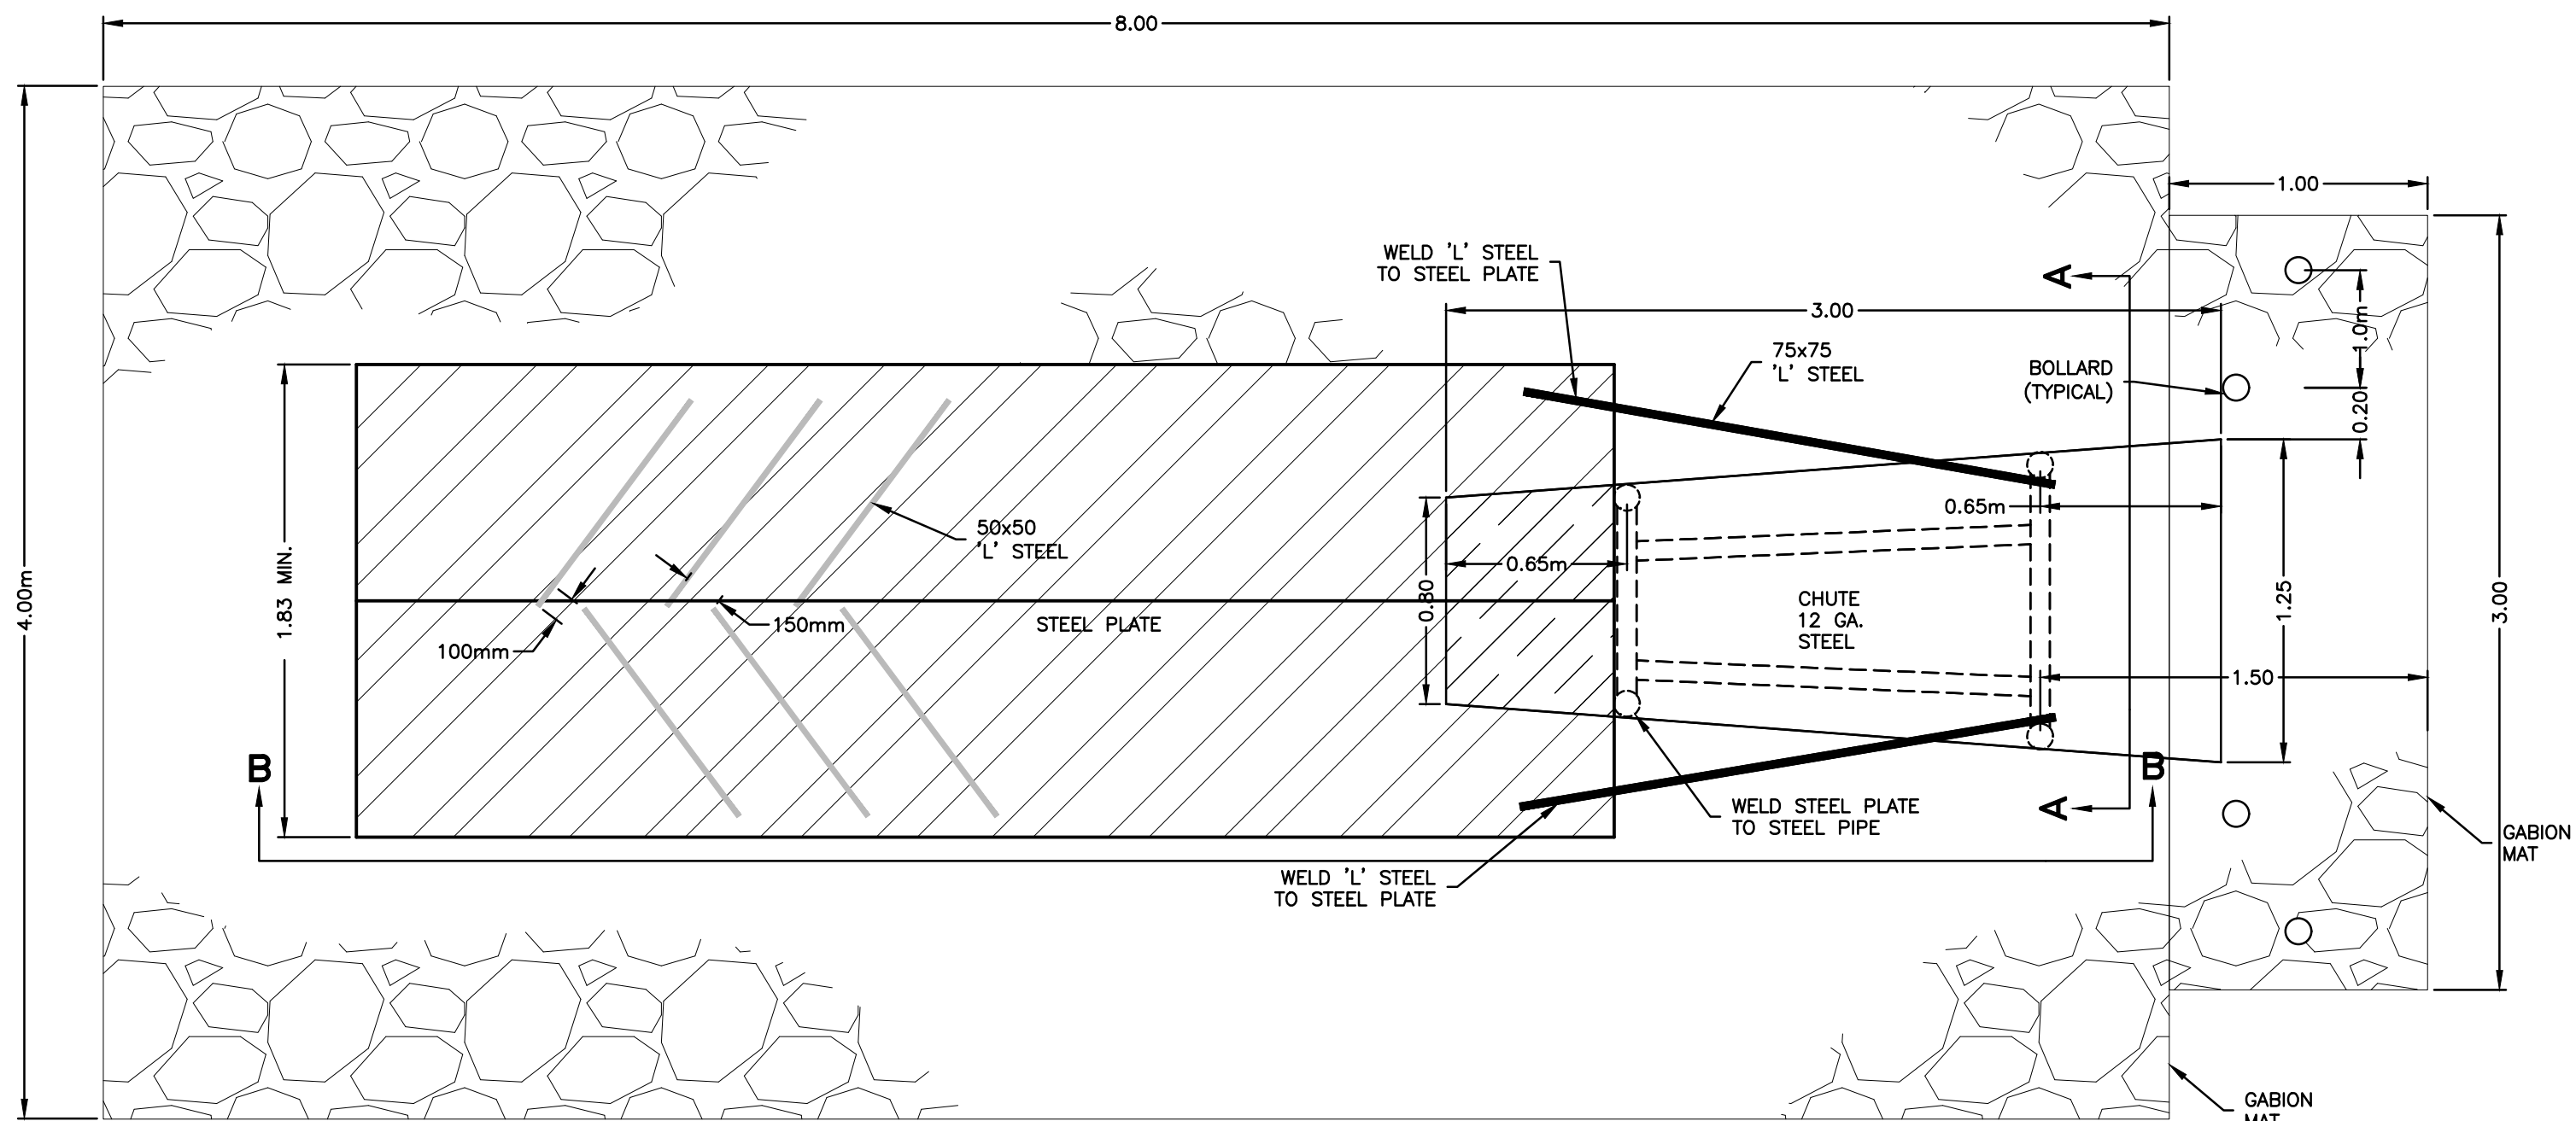


PLAN VIEW
1:25

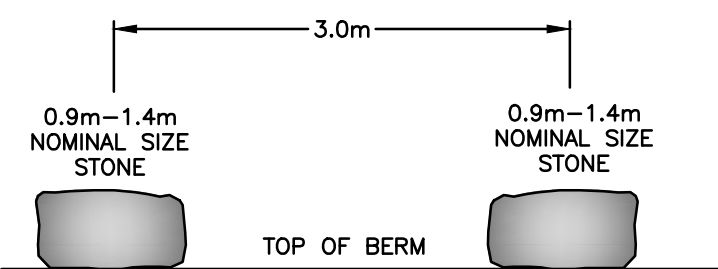


STONE BARRIER DETAIL SECTION VIEW
N.T.S.

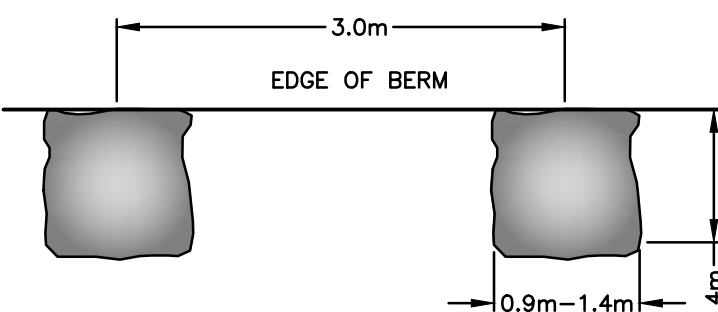

STONE BARRIER DETAIL PLAN VIEW
N.T.S.

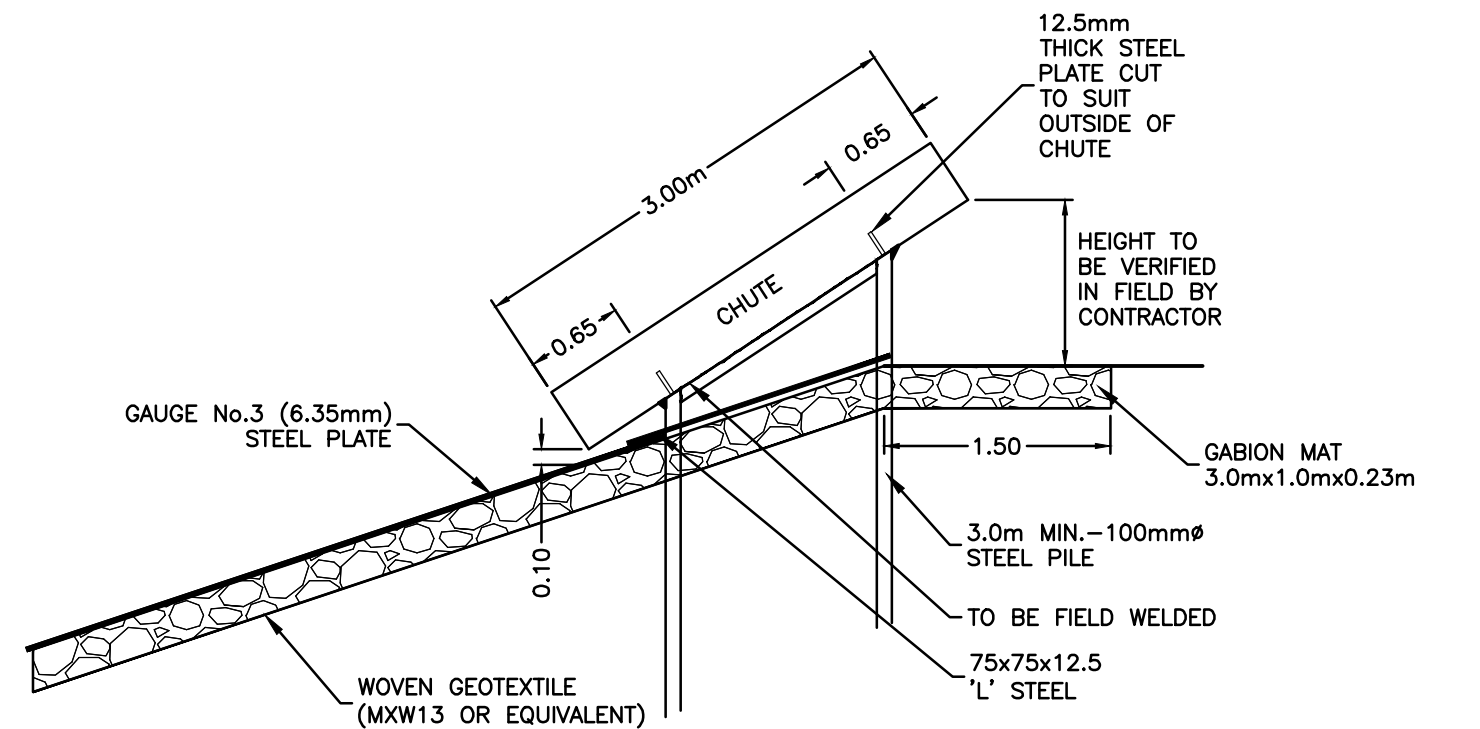

TRUCK DISCHARGE CHUTE SECTION B-B VIEW
1:50

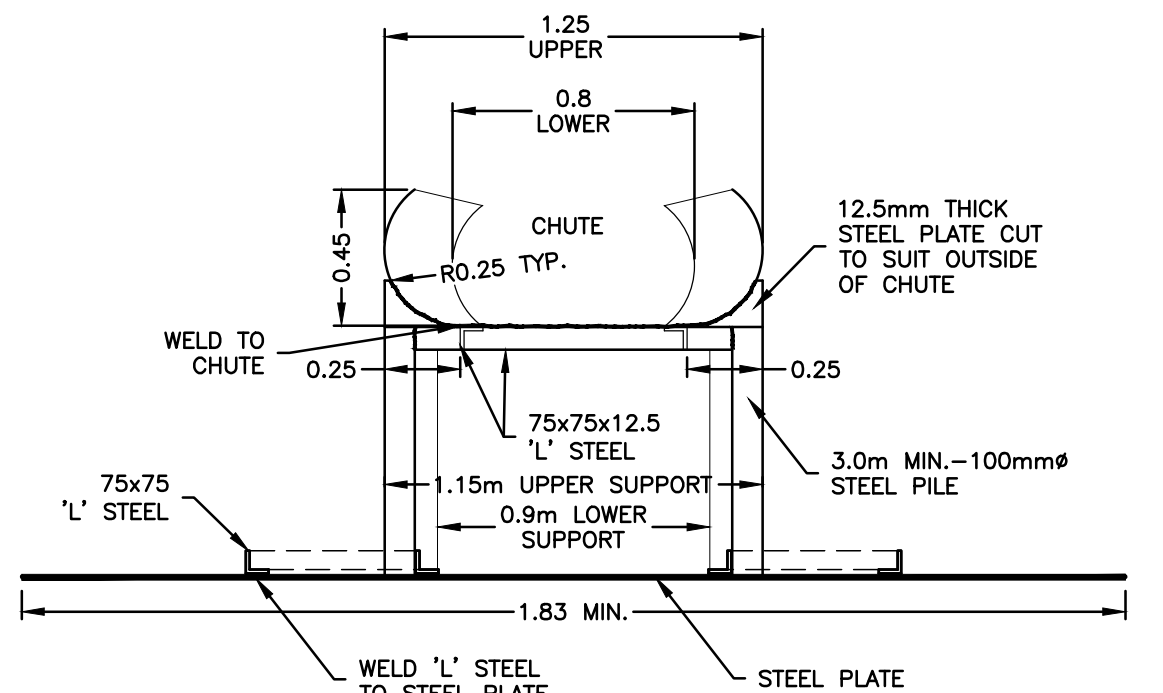

TRUCK DISCHARGE CHUTE SECTION A-A VIEW
1:25

**RECORD
DRAWING**

DATE: NOVEMBER 22nd, 2016

NOTES

THE POSITION OF ALL POLE LINES, CONDUITS, WATERMAINS, SEWERS AND OTHER UNDERGROUND AND OVERGROUND UTILITIES AND STRUCTURES IS NOT NECESSARILY SHOWN ON THE CONTRACT DRAWINGS, AND WHERE SHOWN, THE ACCURACY OF THE POSITION OF SUCH UTILITIES AND STRUCTURES IS NOT GUARANTEED. BEFORE STARTING WORK, DETERMINE THE EXACT LOCATION OF ALL SUCH UTILITIES AND STRUCTURES AND ASSUME ALL LIABILITY FOR DAMAGE TO THEM.

NO.	REVISION DESCRIPTION	DATE	BY	APPD	NO.	REVISION DESCRIPTION	DATE	BY	APPD
					4	ISSUED FOR CONSTRUCTION	14/04/16	IPC	SLB
					3	ISSUED FOR TENDER	19/12/14	IPC	SLB
					2	ISSUED FOR TENDER	25/02/14	MCK	SLB
					1	ISSUED FOR REVIEW	24/02/12	SAB	SLB

SCALE

DESIGNED BY

REVIEWED BY

CLIENT

GOVERNMENT OF NUNAVUT
DEPARTMENT OF COMMUNITY
AND GOVERNMENT SERVICES



exp Services Inc.
1-813-588-1880 | 1-813-225-7337
2025 Queen Street East, Suite 100
Ottawa, ON K2B 6R6
Canada
www.exp.com

• BUILDINGS • EARTH & ENVIRONMENT • ENERGY •
• INDUSTRIAL • INFRASTRUCTURE • SUSTAINABILITY •

BASEPLAN	S.BUTLER
DESIGN	S.DOUGLAS
CHECKED	S.DOUGLAS
CAD	S.BUTLER
PROJ. MAN	S.BURDEN
APPROVED	S.BURDEN

PROJECT

SEWAGE LAGOON
WHALE COVE, NUNAVUT

DETAIL PLAN
TRUCK DISCHARGE AND MISC. DETAILS

PROJ. NO.	OTT-201369A
SURVEY	exp.
DATE	FEB 2012
DRAWING NO.	DE-3