


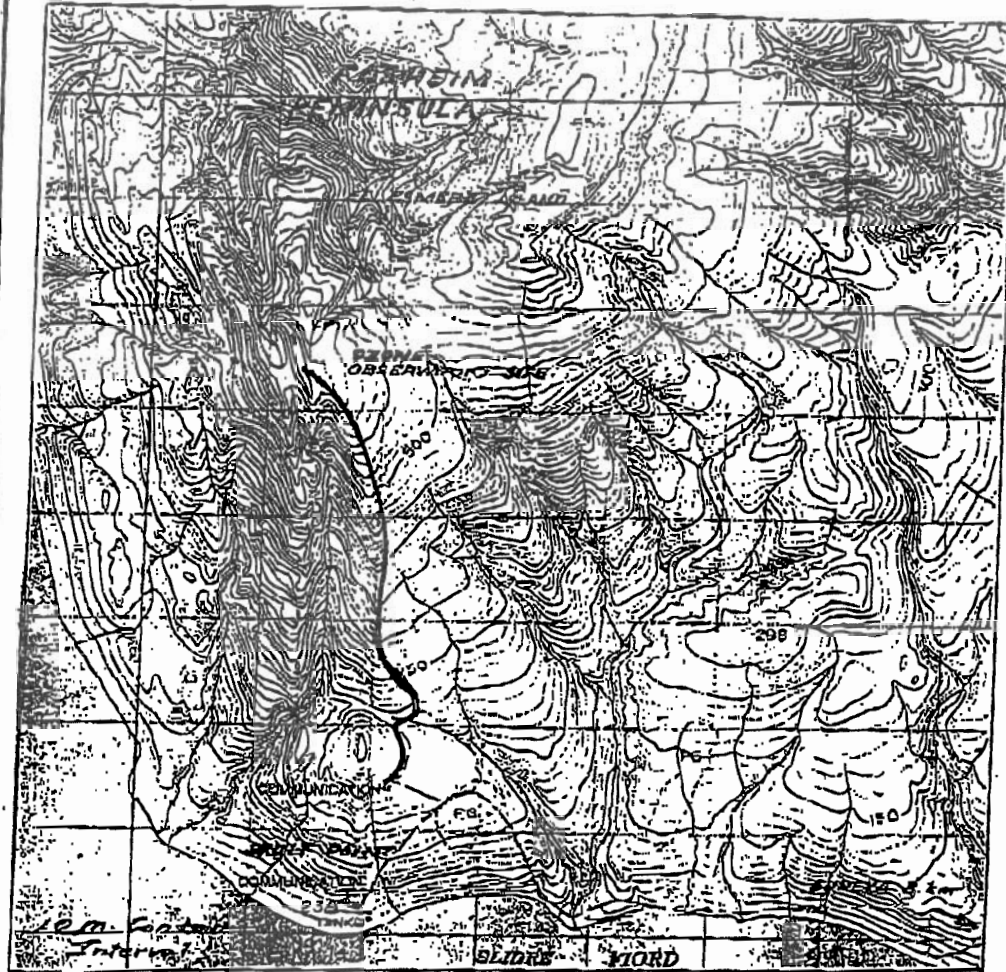


~ Proposed Access Road Alignment

Public Works Canada Travaux publics Canada	drawing title: titre du dessin: Figure 4	designed by: conçu par:	date:
	scale: échelle: 1:50,000	drawn by: dessiné par: G. Levesque	dated: daté: May 16/91
	date:	reviewed by: revu par:	
	revisions:	approved by: approuvé par:	
		project no.: no. du projet:	sheet no.: feuille no.:

4/4

2006-Sep-08 08:33 PM Environment Canada 4167394281

x 1 - Lab Site

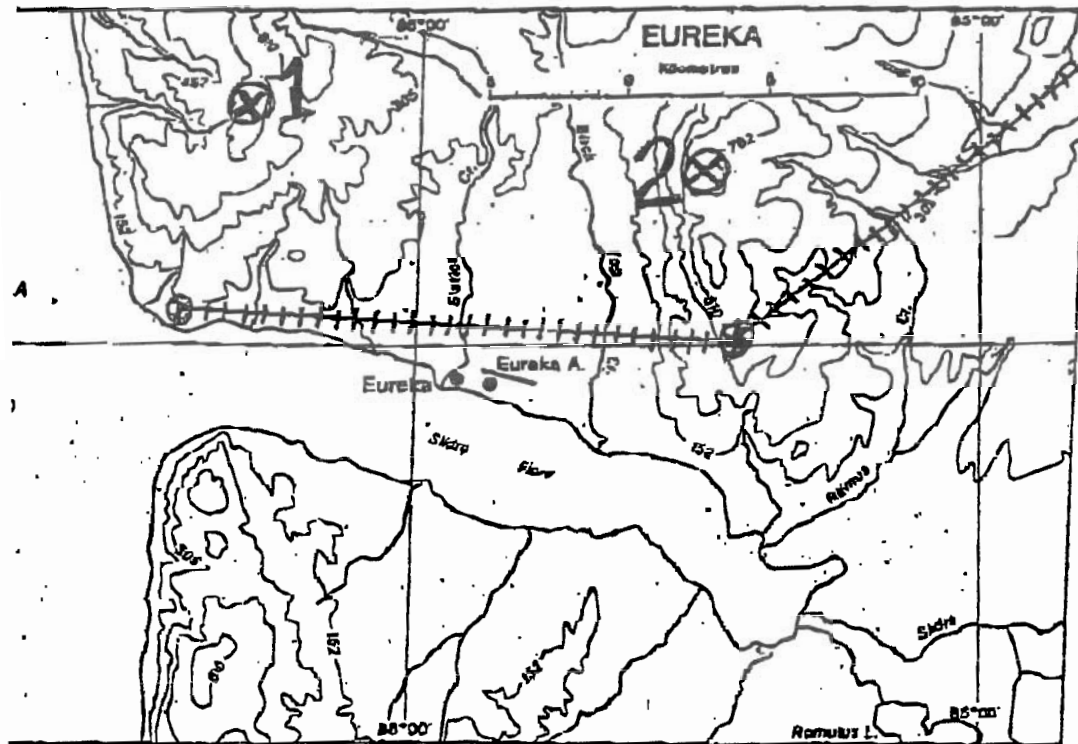


1: Eureka Sound Site (80.09°N, 86.30°W; 600 m. altitude)
- also referred to as Upper Skull Point.

2: Blacktop Ridge Site (80.07°N, 85.48°W; 800 m. altitude)

++: Microwave transmission path.

2/4

2005-Sep-08 08:33 PM Environment Canada 4167394281

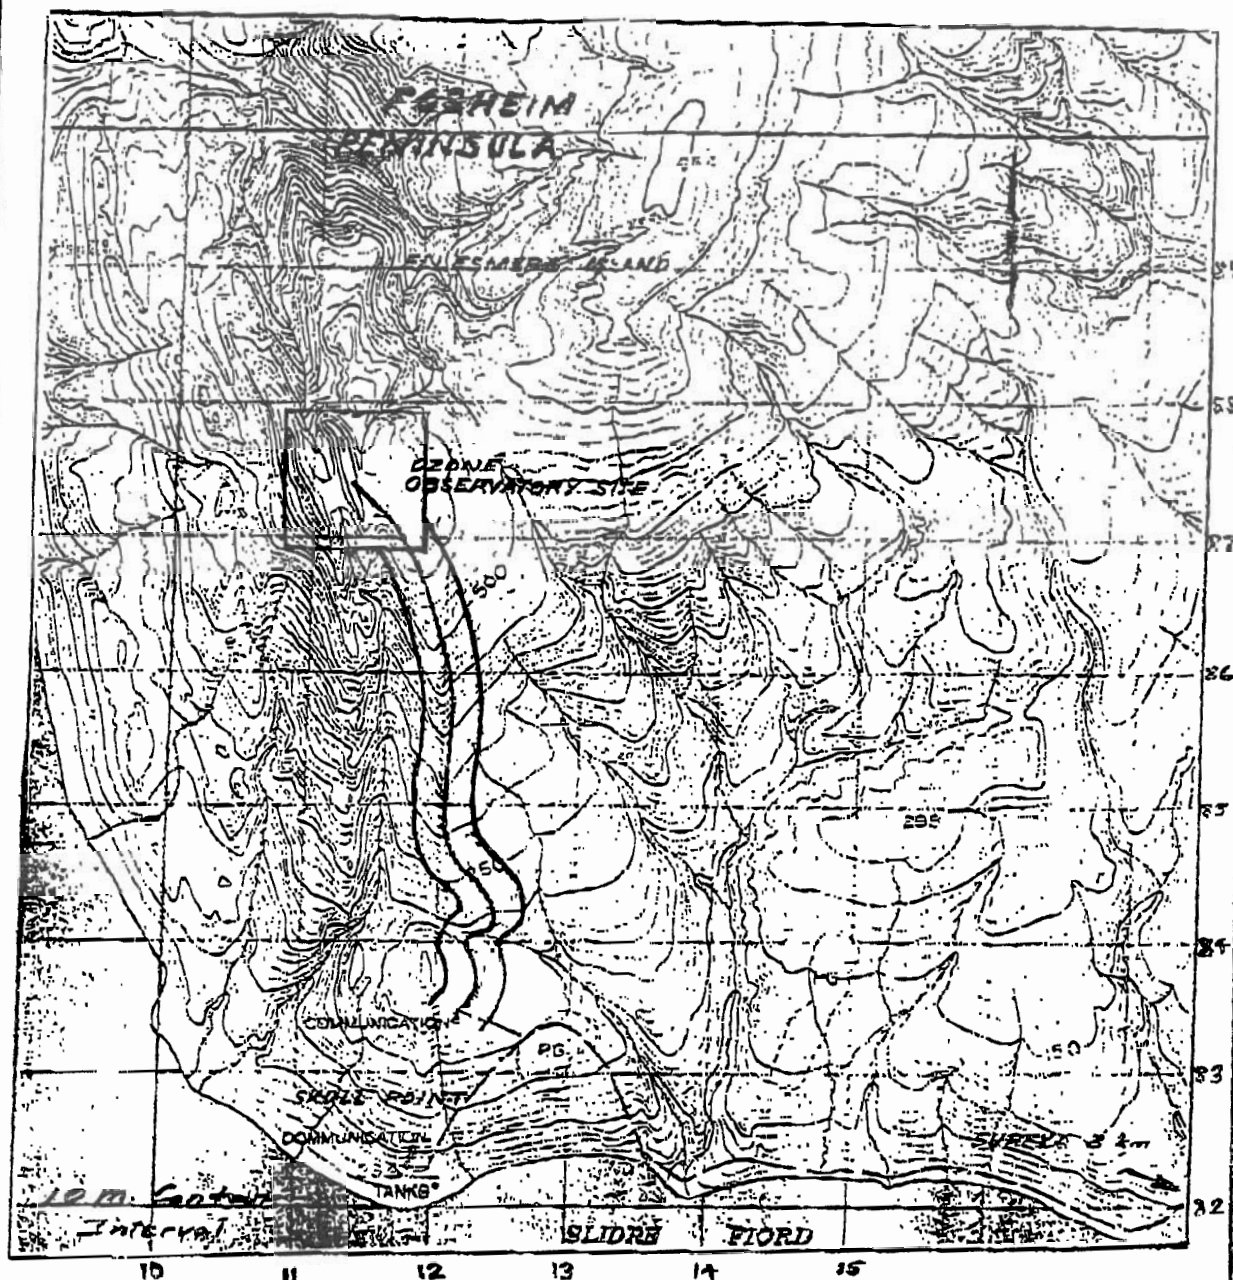

~ Proposed Access Road Alignment (as built)
with Observatory operation boundaries

 Public Works Canada Travaux publics Canada	Drawing title: Titre du dessin: Figure 4	designed by: conçu par:	date:
	scale: échelle: 1:50,000	drawn by: G. Gaudreault dessiné par: 1704 16 191	reviewed by: examiné par:
	date:	revisions:	project no.: no. du projet:
			sheet no.: feuille no.: