


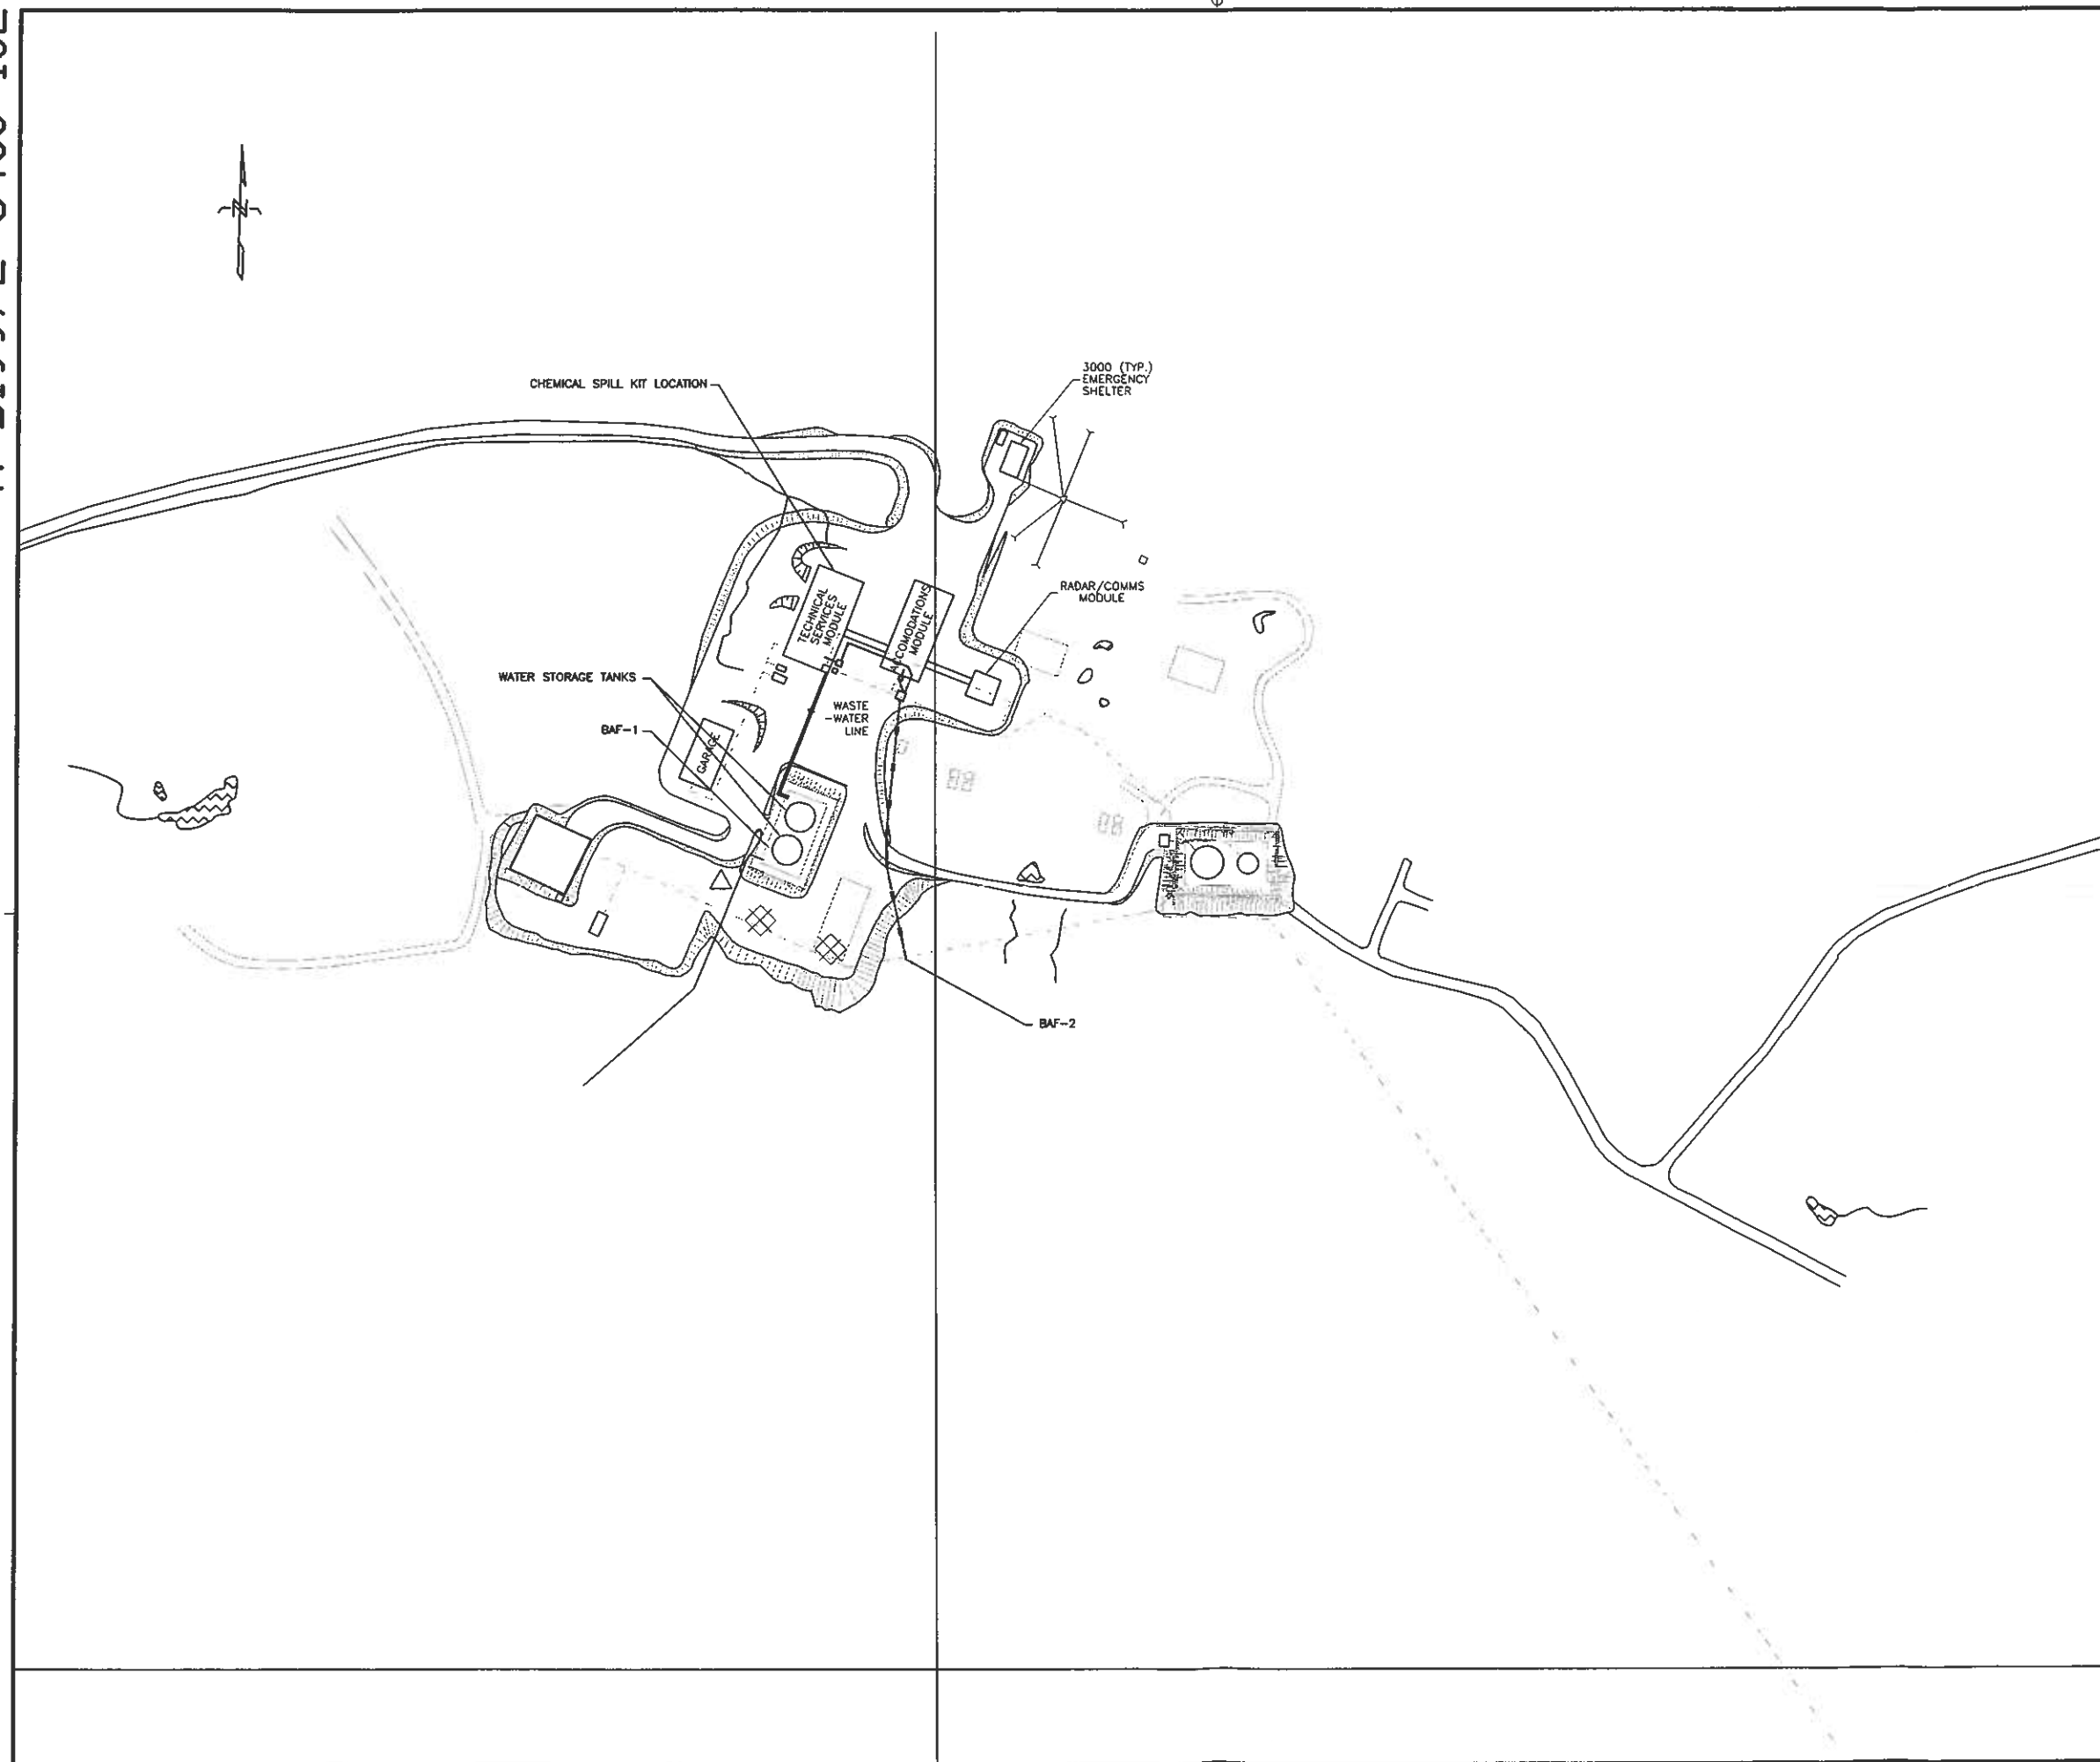

		National Défense Defence nationale	
NORTH WARNING SYSTEM OFFICE Bureau du système d'alerte du Nord			
LOCATION 			
		100-176 LAURIER AVE. WEST DETAMAK, NUNAVUT TEL: (813) 234-8000 FAX: (813) 234-8000	
NOTES:			
LEGEND: WATER/LAKE			
REDUCED DRAWING FOR INFORMATION ONLY SCALE IS REPRESENTATIVE OF FULL SIZE DRAWING.			
1	25 MAR 08	REVISED AS PER B3-66040	F.P.
1	04 MAR 05	AS-BUILT AS PER B3-13294	K.R.
No	DATE	REVISION	DRN APPR
SITE RECORD DRAWING			
20 0 20 40 60 80 metres 1 : 1000			
PROJECT - PROJET CM-66431 LONG RANGE RADAR SITE			
BAF-3			
BREVOORT TRADE - MÉTIER		NUNAVUT DATE 12 JUL 02	
SUBJECT - SUJET SUMMIT SITE PLAN			
PRODUCTION DESIGNED ÉTUDE DRAWN DESSIN CHECKED VÉRIFIÉ COORDINATION		CONCURRENCE - ASSENTIMENT FIRE MARSHAL K.R. T.R. INVSQ ENGINEERING OFFICER INVSQ FACILITIES ENGINEER	
DVG. NO. - DESSIN NO. H-B199/2-8400-102			
Canada			