


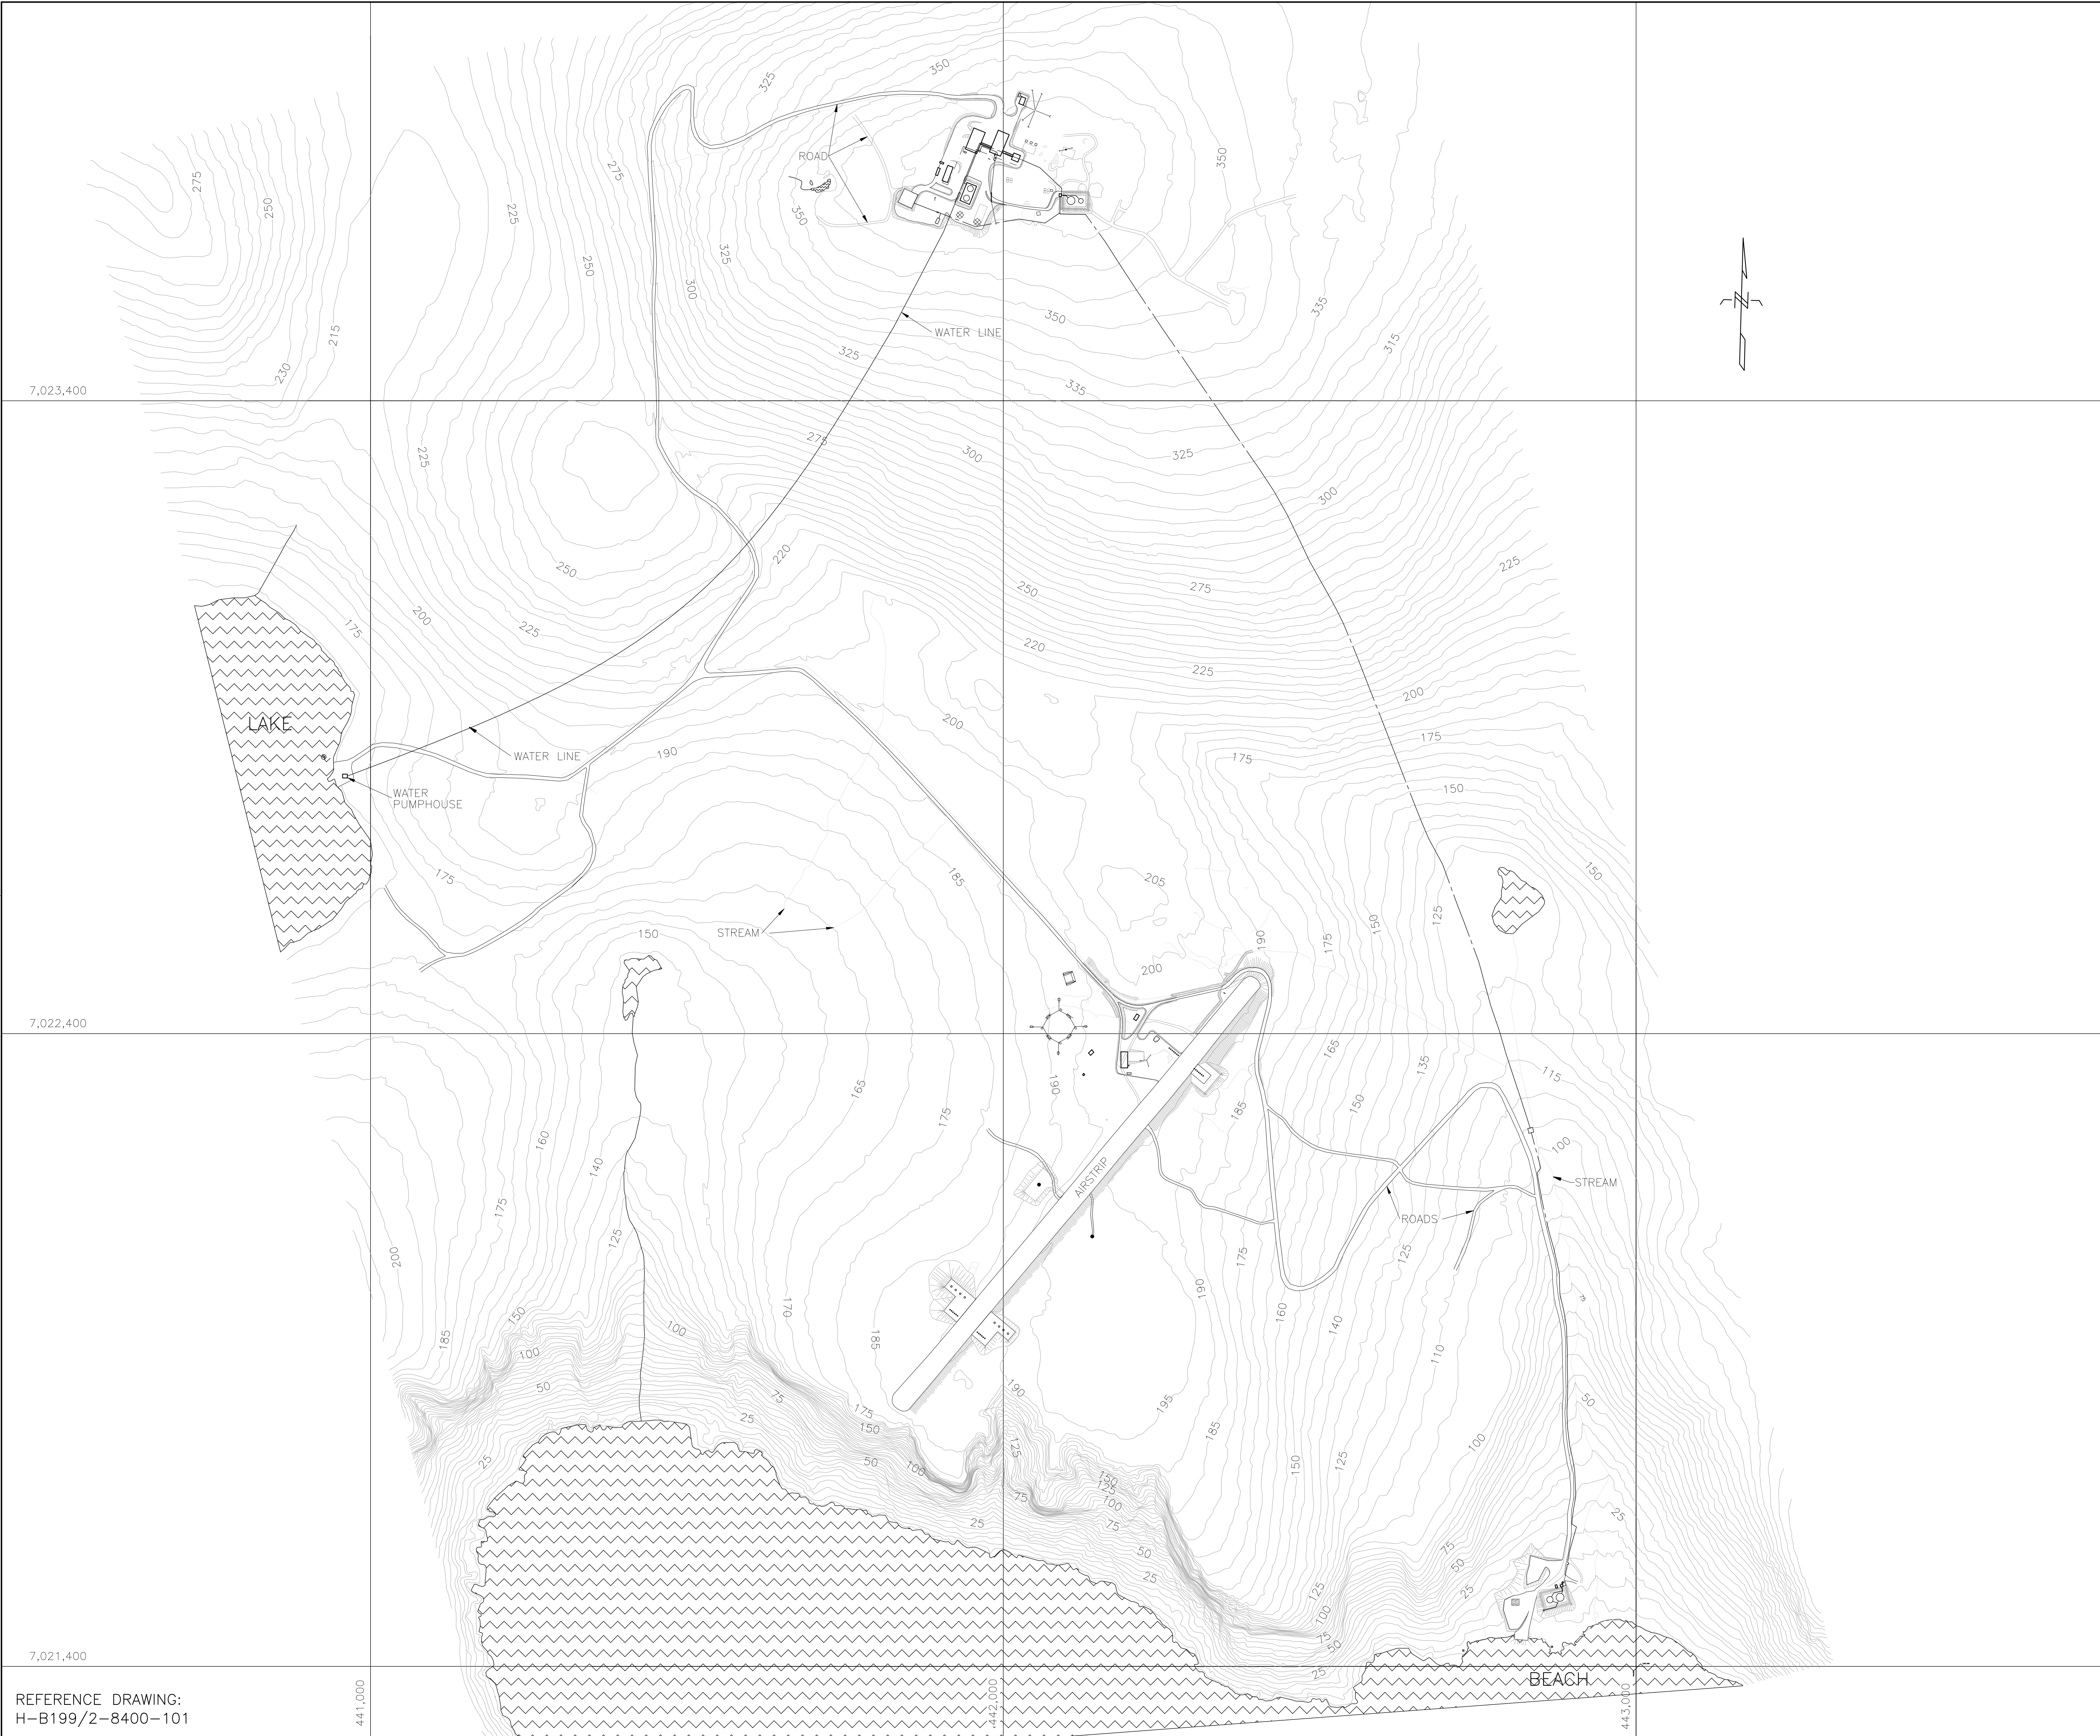

National
Defence

Défense
nationale

NORTH WARNING SYSTEM OFFICE
Bureau du système d'alerte du Nord

LOCATION

100-170 LAURIER AVE. WEST
OTTAWA, ONTARIO K1P 5V6
TEL.: (613) 234-9033
FAX: (613) 234-3888

NOTES:

1. NASITTUQ HAS CARE CUSTODY OF ENTIRE PARCEL.

2. WIND DATA IS NOT AVAILABLE FOR PREPARATION OF WIND ROSE. PREVAILING WINDS ARE EXPECTED TO BE FROM THE NORTH.

3. CONTOURS ARE IN FEET.

4. RUNWAY LIGHTS ARE REMOVED. AIRSTRIp IS USED ONLY IN THE SUMMER AND ONLY IN DAY.

LEGEND:

WATER

WATER LINE

P.O.L.

GRAVEL ROADWAY

REDUCED DRAWING FOR
INFORMATION ONLY

SCALE IS REPRESENTATIVE
OF FULL SIZE DRAWING.

1	30 OCT 09	RELEASE FOR NUNAVUT W.B.	M.J.	
No.	DATE	REVISION	REVISION	DRN. APPR.
SITE RECORD DRAWING				
80000000000000000000metres mètres SCALE - ÉCHELLE 1 : 4000				
PROJECT - PROJET				
LONG RANGE RADAR SITE				
BAF-3				
BREVOORT		NUNAVUT		
TRADE - MÉTIER		SITING		DATE 30 OCT 09
SUBJECT - SUJET				
TOPOGRAPHIC SITE MAP				
PRODUCTION		CONCURRENCE - ASSENTIMENT		
DESIGNED ÉTUDIÉ	W.W.	FIRE MARSHAL	PRÉVOT DU SERVICE DES INCENDIES	
DRAWN DESSINÉ	M.J.			
CHECKED VÉRIFIÉ	B.T.	NWSO ENGINEERING OFFICER	OFFICIER DU GÉNIE BSAN	
COORDINATION		NWSO FACILITIES ENGINEER	GÉNIE DES INSTALLATIONS BSAN	
DWG. NO. - DESSIN NO. SK-17				
Canada				