


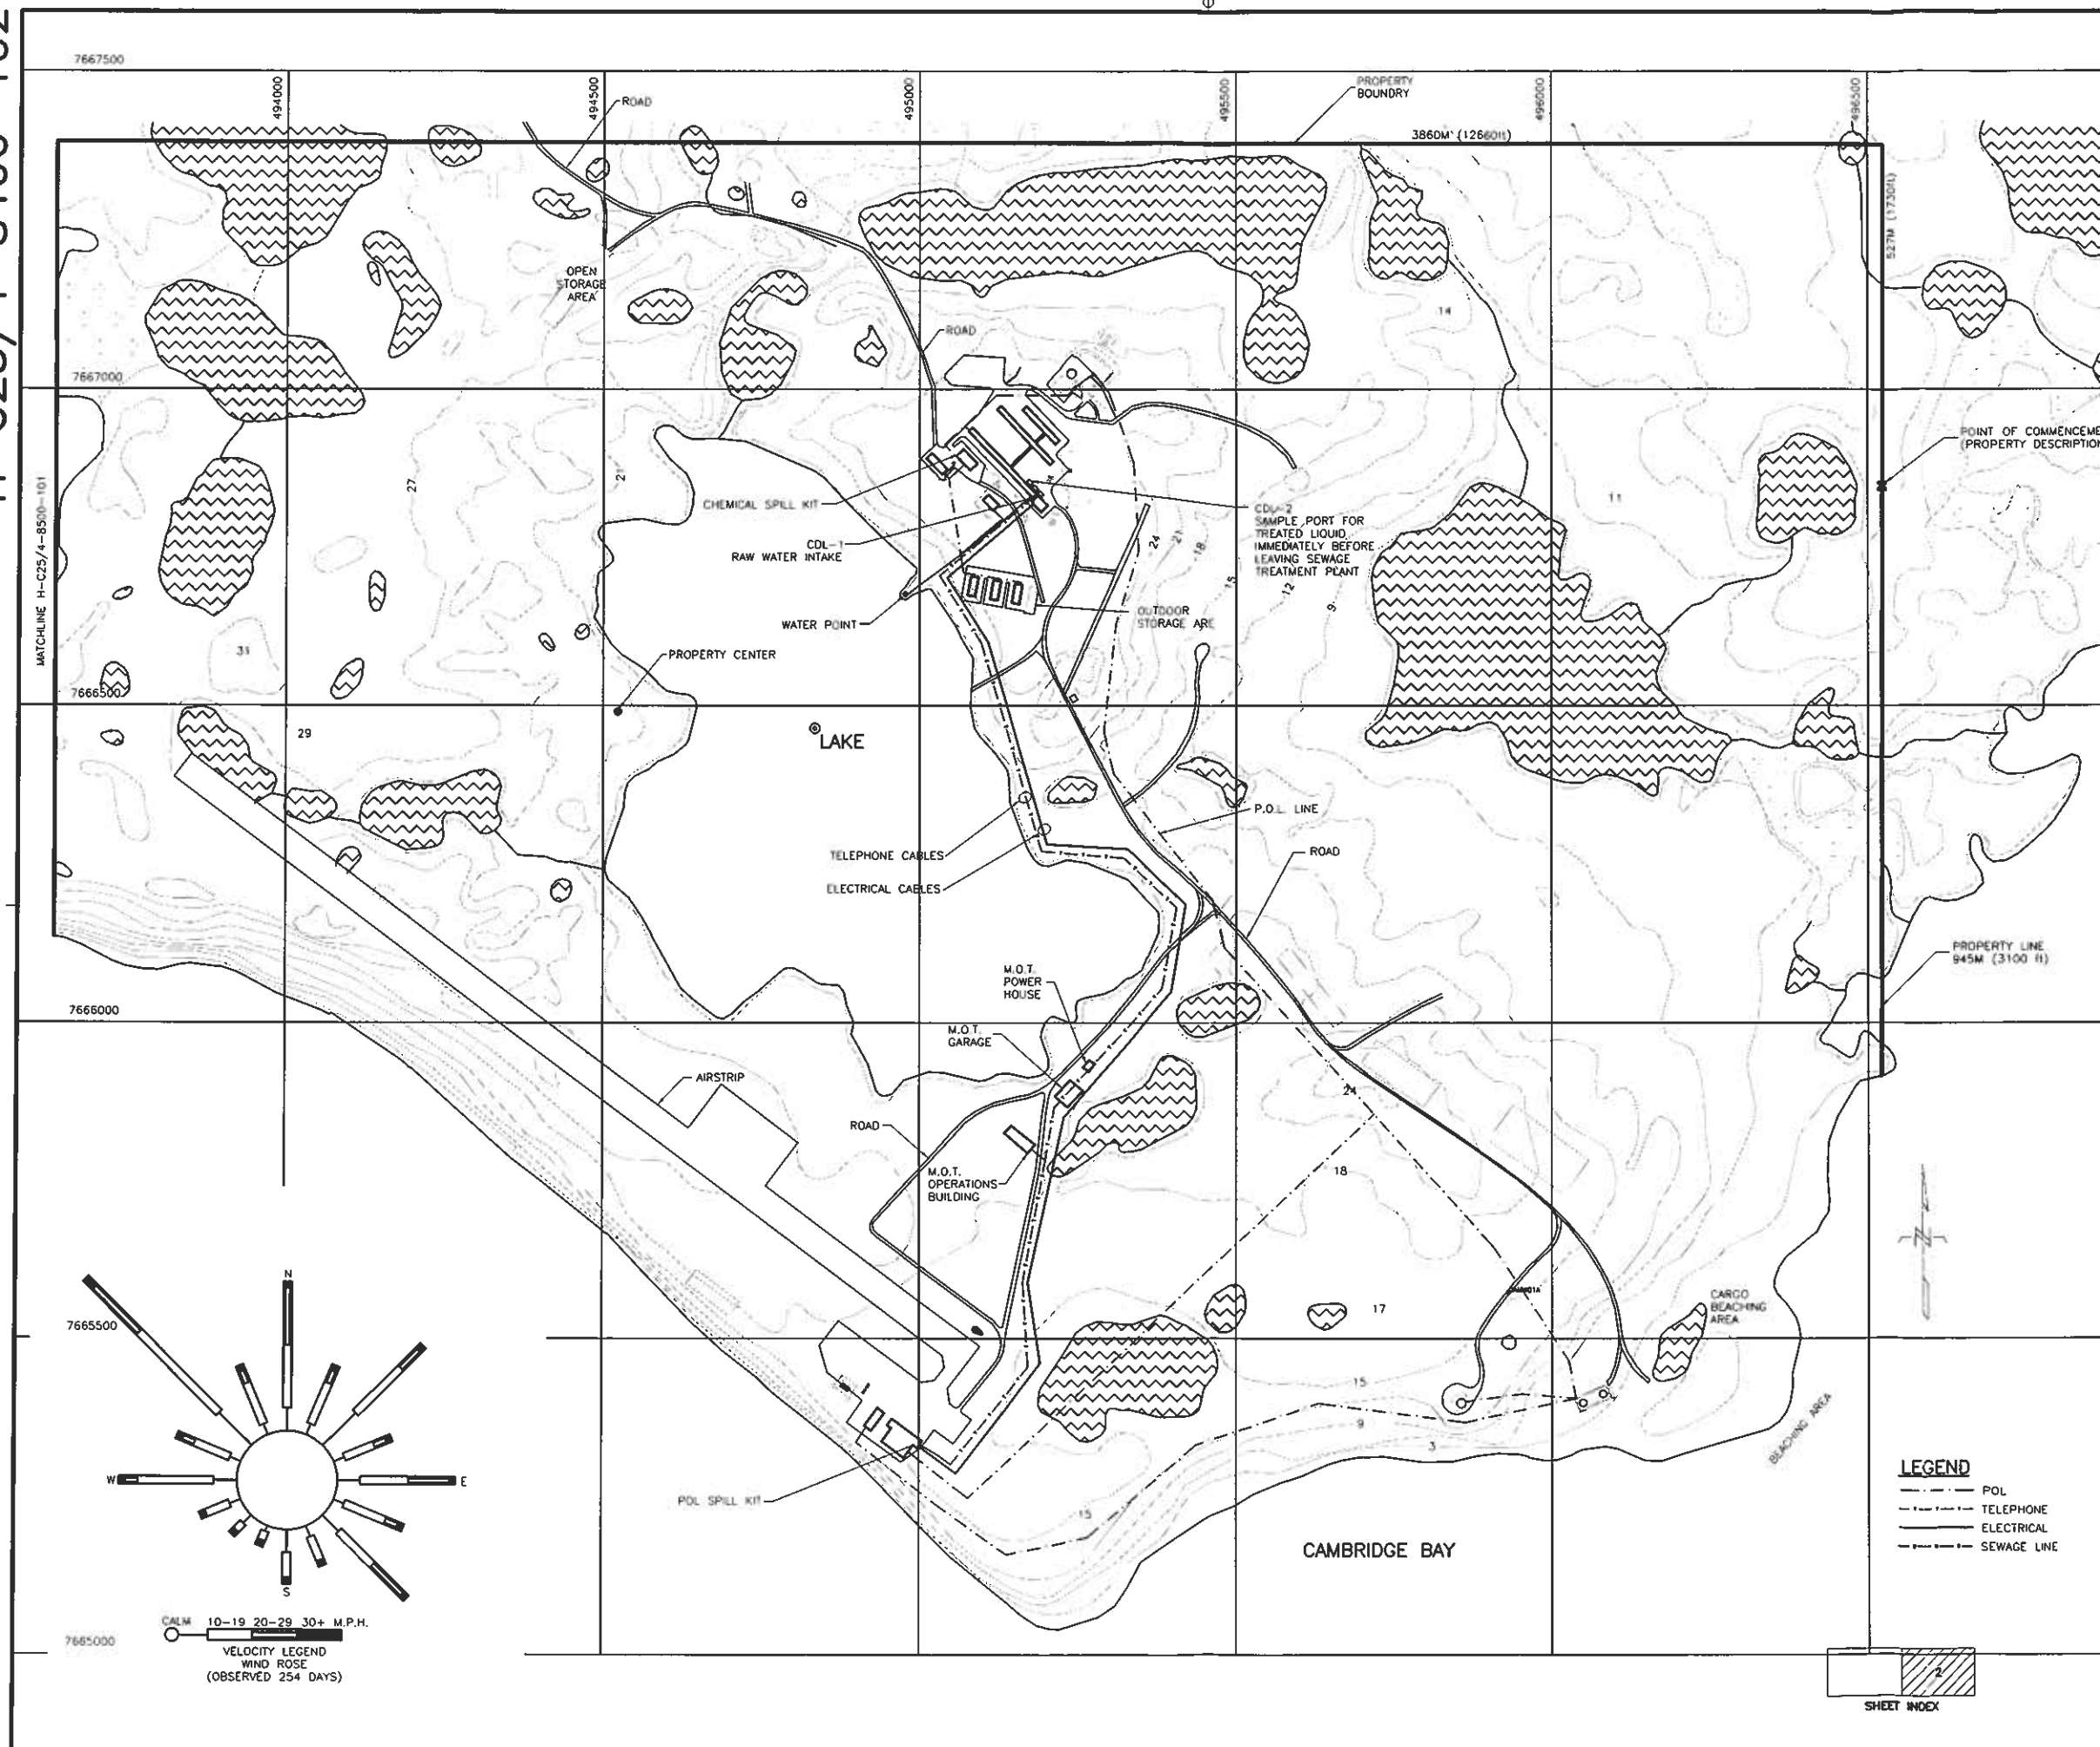

		National Défense Défense nationale	
NORTH WARNING SYSTEM OFFICE Bureau du système d'alerte du Nord			
LOCATION			
NASITTUQ		100-170 LAURIER AVE WEST OTTAWA, ONTARIO K1P 6V5 TEL: (613) 234-9033 FAX: (613) 234-3088	
NOTES: 1. THIS MAP WAS PREPARED BY PHOTOGRAMMETRIC METHODS FROM SHORAN CONTROLLED VERTICAL PHOTOGRAPHY HAVING A SCALE OF 1:40,000. 2. RELATIVE HORIZONTAL ACCURACY OF THE MAP $\pm 0.3048m$ IN 30.48m ($\pm 1ft$ IN 100ft.). 3. RELATIVE ACCURACY OF FORM LINES 3.048m (10ft.). 4. VERTICAL DATUM = MEAN SEA LEVEL. 5. CONTOURS ARE IN METERS. 6. PRESENTLY THERE ARE NO KNOWN GRAVEL SOURCES WITHIN THE PLOT BOUNDARY OF CAM-M L.R.R. SITE.			
LEGEND: SWAMP WATER/LAKE			
REDUCED DRAWING FOR INFORMATION ONLY SCALE IS REPRESENTATIVE OF FULL SIZE DRAWING.			
1	13 JUN 06	REV AS PER REDLINES	F.P.
DATE	REVISION	REVISION	DRN, APPR
SITE RECORD DRAWING			
80 0 80 160 240 320 metres SCALE - ÉCHELLE 1:4000			
PROJECT - PROJET CM-66431 LONG RANGE RADAR SITE CAM-M			
CAMBRIDGE BAY TRADE - MÉTIER		NUNAVUT DATE 19 MAR 02	
SUBJECT - SUJET SITING			
SITE PLAN			
PRODUCTION		CONCURRENCE - ASSÉNTIMENT	
DESIGNED ÉTUDE	FIRE MARSHAL	PRÉVOT DU SERVICE DES INCENDIES	
DRAWN DESSINÉ	F.P.	OFFICER DU GÉNIE DES BÂTIMENTS	
CHECKED VÉRIFIÉ	T.R.	OFFICER DU GÉNIE DES BÂTIMENTS	
COORDINATION	NWSO FACILITIES ENGINEER	GÉNIE DES BÂTIMENTS	
DWG. NO. - DESSIN N° H-C25/4-8400-102			
Canada			