


SK-01

CAM-M

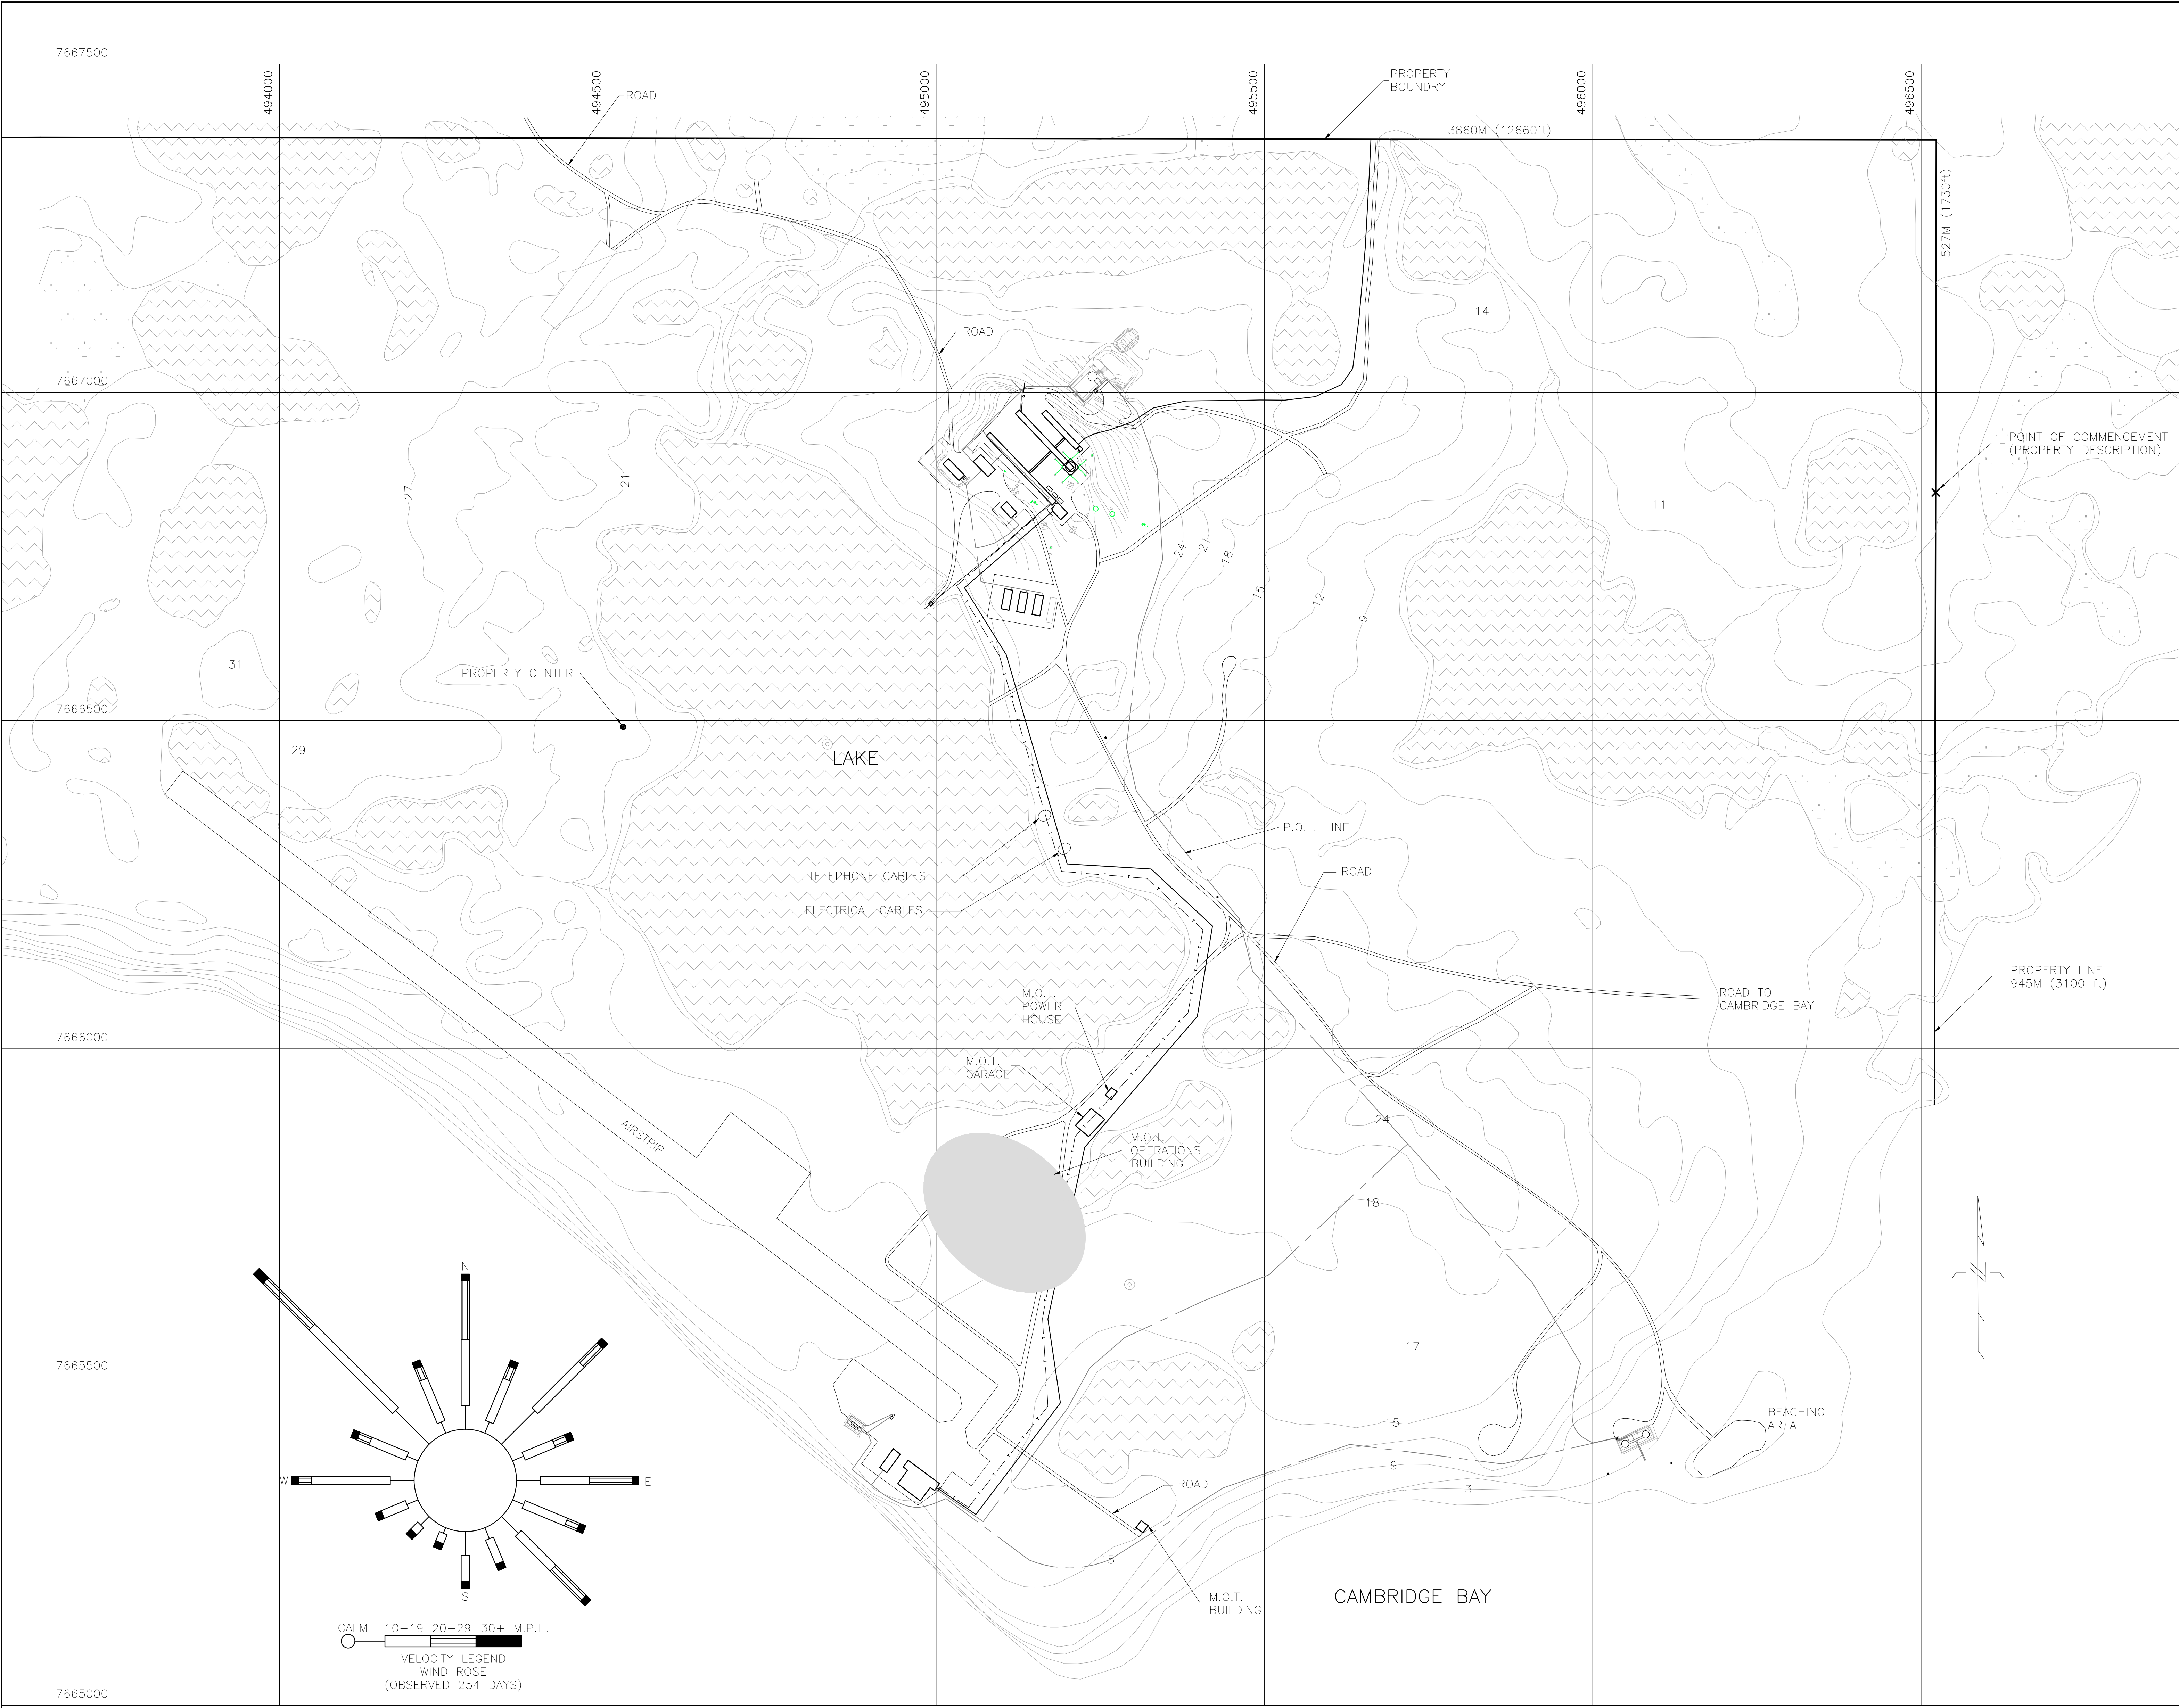

REFERENCE DRAWING:
H-C25/4-8400-102

NORTH WARNING SYSTEM OFFICE
Bureau du système d'alerte du Nord

LOCATION

100-170 LAURIER AVE. WEST
OTTAWA, ONTARIO K1P 5V6
TEL.: (613) 234-9033
FAX: (613) 234-3888

NOTES:

- THIS MAP WAS PREPARED BY PHOTOGRAMMETRIC METHODS FROM SHORAN CONTROLLED VERTICAL PHOTOGRAPHY HAVING A SCALE OF 1:40,000.
- RELATIVE HORIZONTAL ACCURACY OF THE MAP ±0.3048m IN 30.48m (±1ft. IN 100ft.).
- RELATIVE ACCURACY OF FORM LINES 3.048m
- VERTICAL DATUM = MEAN SEA LEVEL.
- CONTOURS ARE IN METERS.
- PRESENTLY THERE ARE NO KNOWN GRAVEL SOURCES WITHIN THE PLOT BOUNDARY OF CAM-M
- THE PENINSULA AND WATER PUMP HOUSE, ARE DRAWN APPROX TO REFLECT ONSITE CONDITION. (NOT SURVEYED)
- APPROXIMATE AREA OF COMMUNITY AIRPORT OPERATIONS

LEGEND:

	SWAMP
	WATER/LAKE
	P.O.L.
	TELEPHONE
	ELECTRICAL
	SEWAGE LINE
	GRAVEL ROADWAY

REDUCED DRAWING FOR INFORMATION ONLY

SCALE IS REPRESENTATIVE OF FULL SIZE DRAWING.

1	30 OCT 09	RELEASE FOR NUNAVUT W.B. M.J.		
No.	DATE	REVISION	REVISION	DRN. APPR.
SITE RECORD DRAWING				
SCALE - ÉCHELLE				
1 : 4000				
PROJECT - PROJET				
LONG RANGE RADAR SITE				
CAM-M				
CAMBRIDGE BAY		NUNAVUT		
TRADE - MÉTIER	SITING	DATE	30 OCT 09	
SUBJECT - SUJET				
TOPOGRAPHIC SITE MAP				
PRODUCTION		CONCURRENCE - ASSENTIMENT		
DESIGNED ÉTUDIÉ	W.W.	FIRE MARSHAL	PRÉVOT DU SERVICE DES INGÉNIEURS	
DRAWN DESSINÉ	M.J.			
CHECKED VÉRIFIÉ	B.T.	NWSO ENGINEERING OFFICER	OFFICIER DU GÉNIE BSAN	
COORDINATION		NWSO FACILITIES ENGINEER	GÉNIE DES INSTALLATIONS BSAN	
DWG. NO. - DESSIN NO. SK-01				