


ΣΕΥΡΕΥΑ



NORTH WARNING SYSTEM OFFICE
Bureau du système d'alerte du Nord

LOCATION

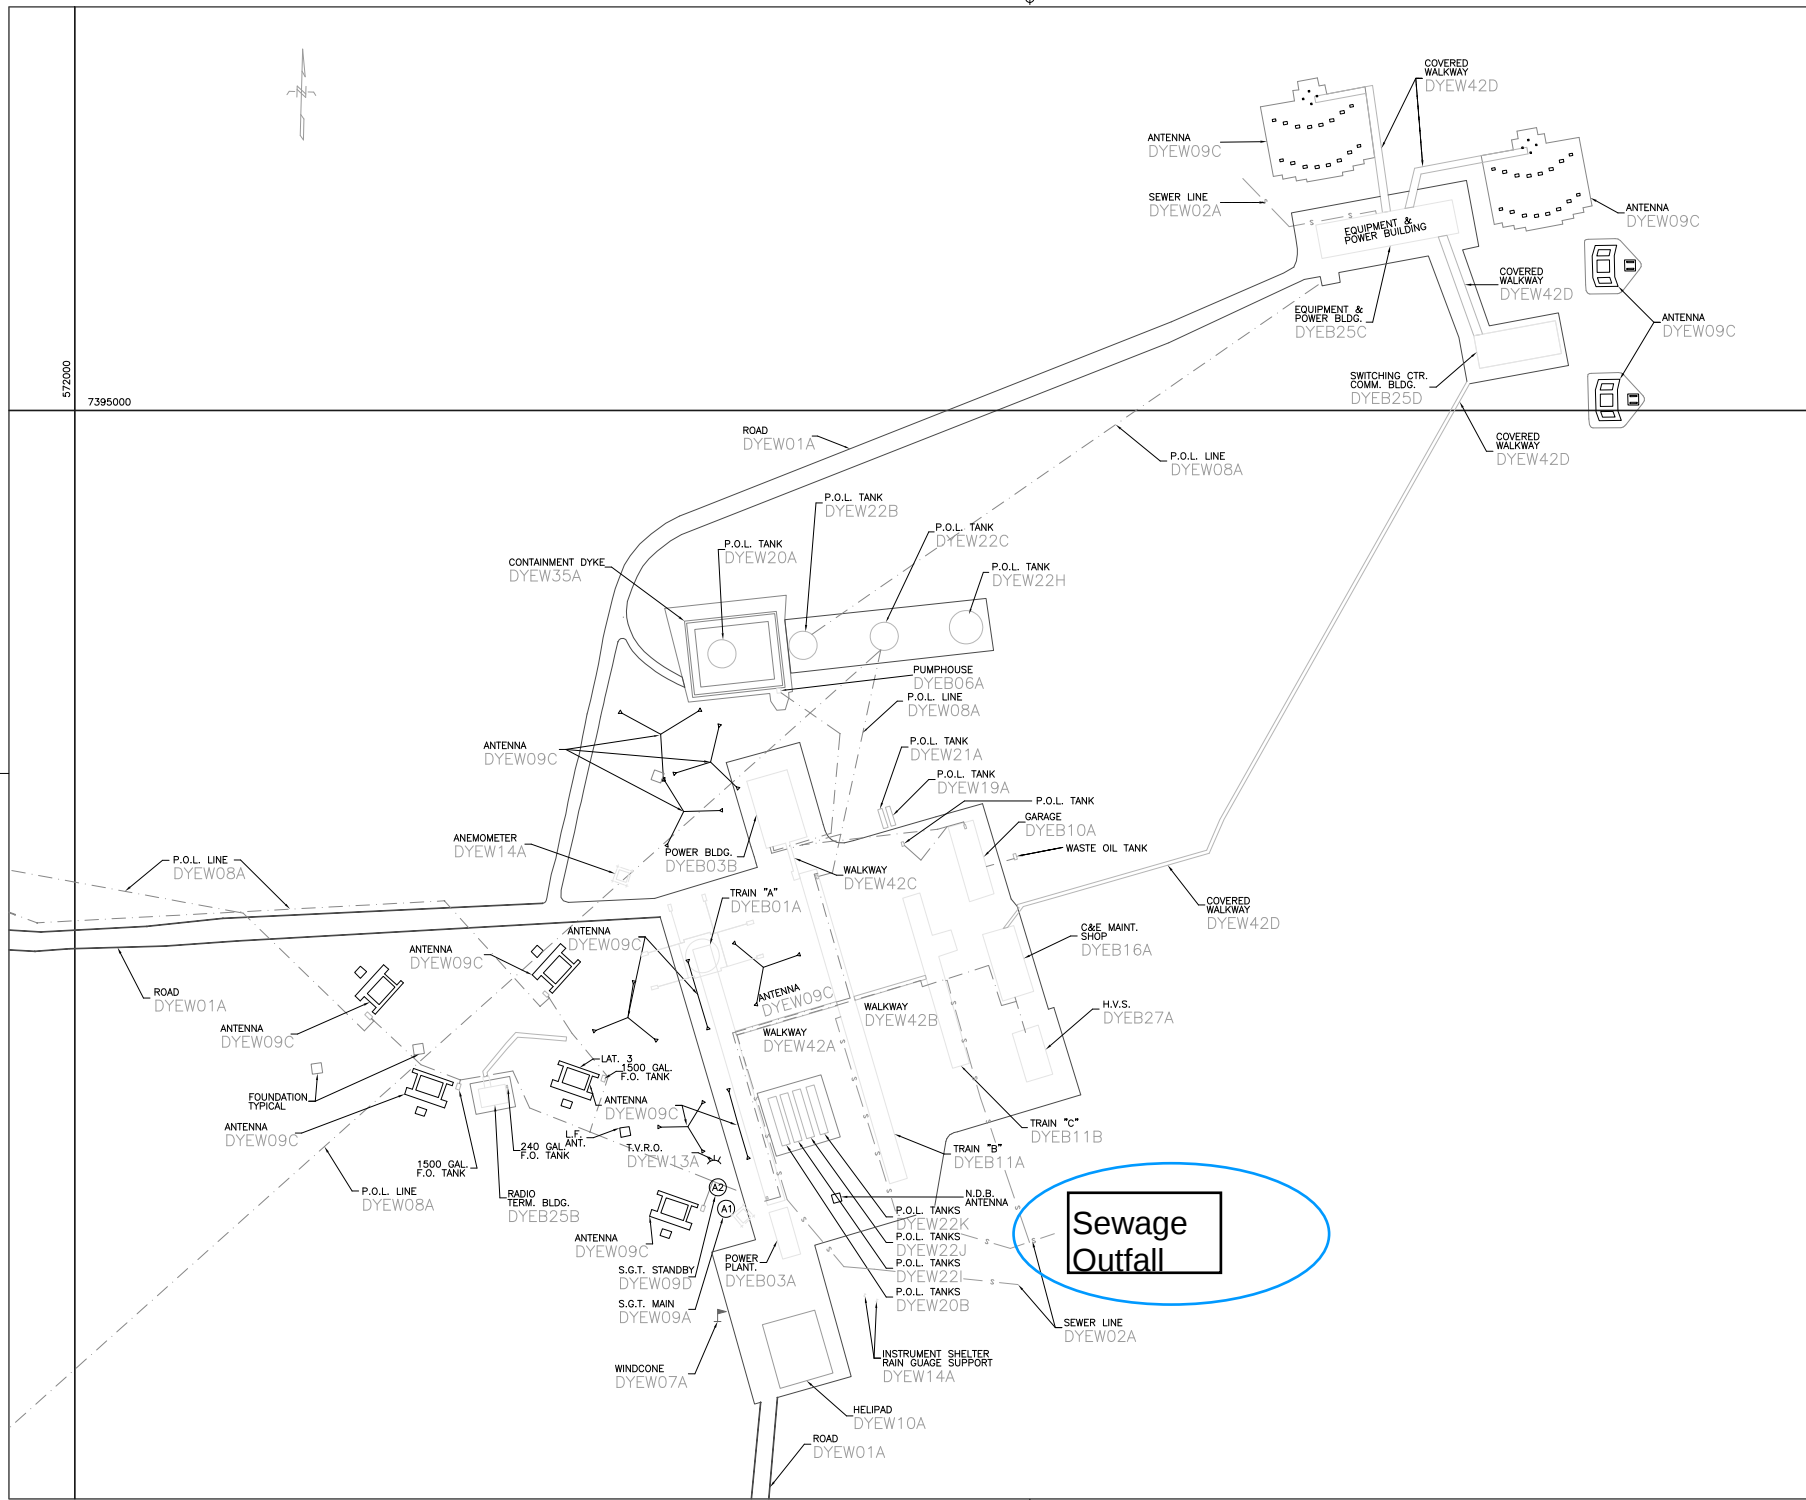


100-170 LAURIER AVE. WEST
OTTAWA, ONTARIO K1P 5V5
TEL.: (613) 234-9033
FAX.: (613) 234-3888

REDUCED DRAWING FOR
INFORMATION ONLY

SCALE IS REPRESENTATIVE
OF FULL SIZE DRAWING.

No.	DATE	REVISION	RÉVISION	DRN.	APPR.

 SITE RECORD DRAWING



SCALE - ÉCHELLE

1 : 1000

PROJECT - PROJET

CM-66431

LONG RANGE RADAR SITE

DYE-M

CAPE DYER

NUNAVUT

TRADE - MÉTIER	SITING
----------------	--------

DATE
03 APR 02

SUBJECT – SUJET

SUMMIT
LOCID PLAN

PRODUCTION		CONCURRENCE - ASSESSMENT	
DESIGNED ÉTUDE		FIRE MARSHAL	PRÉVOT DU SERVICE DES INCENDIES
DRAWN DESSINÉ	K.R.	NWSO ENGINEERING OFFICER	OFFICIER DU GENIE BSAN
CHECKED VÉRIFIÉ	T.R.	NWSO FACILITIES ENGINEER	GENIE DES INSTALLATIONS BSAN
COORDINATION			

DWG. NO. - DESSIN NO.
H-C75/2-8400-107

Canada