


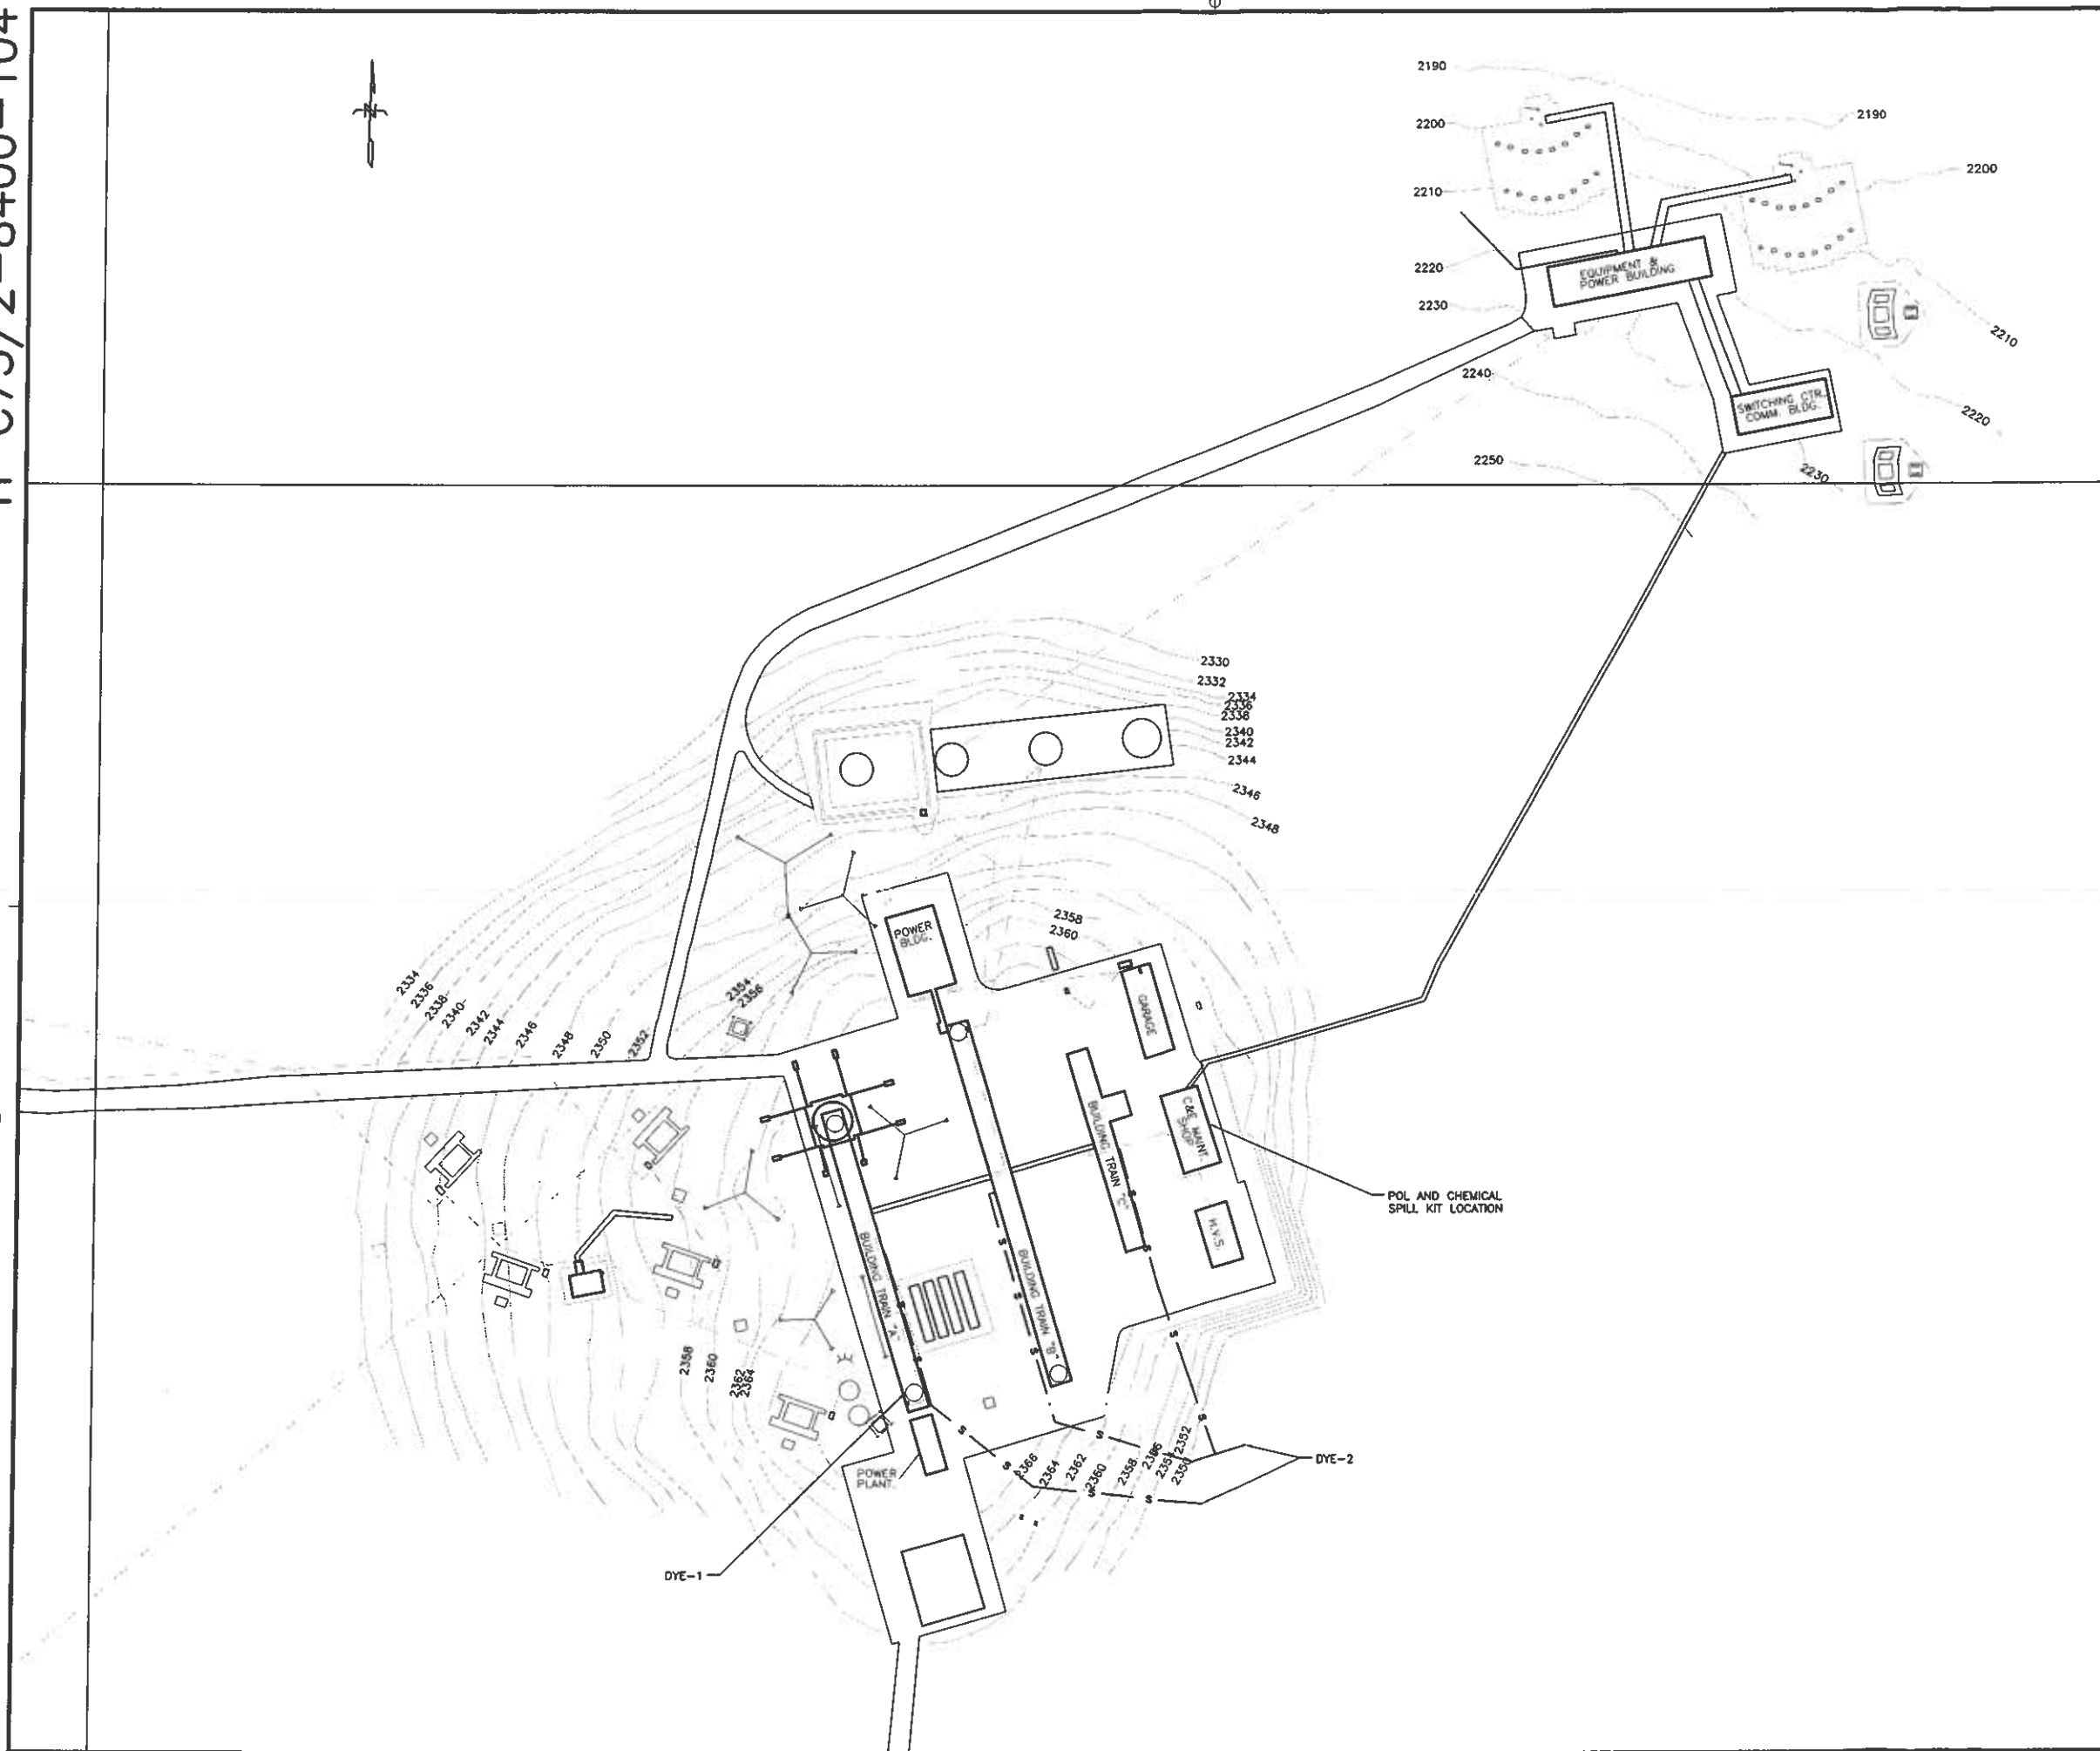

		National Défense		Défense nationale	
NORTH WARNING SYSTEM OFFICE Bureau du système d'alerte du Nord					
LOCATION 					
		100-110 LAURENCE AVE. WEST OTTAWA, ONTARIO K1P 6K5 TEL: (613) 234-9500 FAX: (613) 234-9500			
NOTES: 1. CONTOURS ARE IN FEET.					
REDUCED DRAWING FOR INFORMATION ONLY SCALE IS REPRESENTATIVE OF FULL SIZE DRAWING.					
22 SEPT 04		REVISED AS PER NQ-12374		K.R.	
DATE	REVISION	REVISION	DRN	APPR	
SITE RECORD DRAWING					
20 0 20 40 60 80 metres mètres					
SCALE - ÉCHELLE 1 : 1000					
PROJECT - PROJET CM-66431 LONG RANGE RADAR SITE					
DYE-M					
CAPE DYER		NUNAVUT		DATE 03 APR 02	
TRADE - MÉTIER		SITING			
SUBJECT - SUJET		SUMMIT AREA PLAN			
PRODUCTION		CONCURRENCE - ASSISENMENT			
DESIGNED ÉTUDE	FIRE MARSHAL	FIRE DU SERVICE DES INCENDIES			
DRAWN DESSINÉ	K.R.				
CHECKED VÉRIFIÉ	T.R.	OFFICER DU GÉNIE BSAN			
COORDINATION	INWSD FACILITIES ENGINEER	GENIE DES INSTALLATIONS BSAN			
DWG. NO. - DESSIN NO. H-C75/2-8400-104					
Canada					