



SOW REF: 16.F.1.b

## **25.40 DYE-M, CAPE DYER**

### **25.40.1 LOCATION/TERRAIN/TOPOGRAPHY**

Latitude: 66° 39' 56.94" N

Longitude: 61° 21' 19.76" W

Elevation: 725 m

Location: This Long Range Radar (LRR) site is located at the extreme eastern edge of a mountainous peninsula at Cape Dyer on Baffin Island. DYE-M is located 460 km NNE of Iqaluit. The host LSS for DYE-M is LSS-I, Iqaluit. Flight time from the LSS is 2 hours, 40 minutes by helicopter under normal conditions. A helipad is located on-site, as well as an abandoned airstrip.

Terrain: The terrain is rugged and boulder strewn with very little soil, consisting of mostly silt. Vegetation on the upper site is sparse, consisting of grass, wildflowers, mosses, and lichen. Vegetation at the lower site is more abundant consisting of wildflowers, creeping willows, and sedges. Several small ice fields exist within five miles of the site.

Topography: The mountainous terrain and the sheer cliffs, some over 610 m high, along the coastline are the most prominent features of the site.

### **25.40.2 CLIMATE**

No average temperature and precipitation information is available from Environment Canada for this site.

Precipitation:	Annual Average:	708 mm
	Snowfall:	602 cm
	Rainfall:	106 mm

### **25.40.3 SITE POPULATION**

This LRR was transitioned to “unattended” status on 31 October 1995.

### **25.40.4 LAND USE**

There are no commercial operations within the vicinity of DYE-M. Hunters from Qikiqtarijuaq (formerly Broughton Island) may hunt arctic fox, walrus, and seal. The site is located in the Nunavut Settlement Area in the Baffin administrative region. DND has been transferred the management, charge, and direction of the property by DIAND for the life of the NWS.

There are existing heritage sites recorded in the DYE-M site area. A relatively recent Inuit camp containing two rings, one cache, and one shelter was located north of the bulk fuel storage tank and

**UNCONTROLLED WHEN PRINTED**



SOW REF: 16.F.1.b

beach landing facilities. Approximately 800 m north of this site, another complex of ten rings was observed. Another historic site associated with construction of the base was observed 1.5 km north of the beach landing. It consists of an access ramp and three building foundations.

South of the bulk fuel storage area is a historic grave site relating to a French whaling expedition of the 1930's. Further removed to the south are three houses, probably Thule in origin. Two have been seriously disturbed by natural erosion and by bulldozing activity. The southernmost site appears to be recent in age, likely dating to post construction of the DEW Line station itself. Features at this site consisted of 11 structure foundations, airplane debris, three tent rings, and six caches.

## 25.40.5 WILDLIFE

Caribou are occasionally seen at the lower site on the plateau. Arctic foxes, and more infrequently wolves, can be found in the region and near the site. Periodically polar bears are encountered at both camps, particularly during the start of the open water season when they are forced ashore by the break-up of the land-fast ice. Cape Dyer is a major denning area for polar bears on south eastern Baffin Island.

The coastal waters are important habitat to walrus, seals, and many species of whales and porpoises. During the fall and early winter, bowhead whales migrate southward along the east coast of Baffin Island to the Cumberland Sound region. Also during this time, there is a migration of narwhals south along the east coast of Baffin Island to their overwintering areas in the Davis Strait and west Greenland. Bearded seal, harp seal, ringed seal, narwhal, and killer whale can be found in the coastal water of Davis Strait as well.

The cliff terrain that DYE-M is situated on is the preferred habitat for several raptor species including peregrine falcon, gyrfalcon, and snowy owl. The Canadian Wildlife Service (CWS) has recognized western Baffin Bay as a key migratory bird habitat site. This area also contains many seabirds including black-legged kittiwake, thick-billed murre, and black guillemot. Colonies of Sabine's gull can be found south and west of the site.

Table 25.40-1 shows the wildlife that can be found on or within the vicinity of DYE-M.

**Table 25.40-1 Wildlife Species Encountered at or within range of DYE-M and their classification under SARA, COSEWIC, and Territorial Regulations**

Species Common Name	Species Binomial Nomenclature	Time frame of Occurrence	SARA Status <sup>1</sup>	SARA Schedule <sup>2</sup>	COSEWIC Designation <sup>3</sup>
<b>TERRESTRIAL MAMMALS</b>					
Arctic Fox	<i>Vulpes lagopus</i>	Annual	---	---	---
Arctic Hare	<i>Lepus arcticus</i>	Annual	---	---	---
Caribou, Barren Ground subspecies	<i>Rangifer tarandus groenlandicus</i>	Annual	---	---	---
Grey Wolf	<i>Canis lupus</i>	Annual	---	---	---
Red Fox	<i>Vulpes vulpes</i>	Annual	---	---	---
Wolverine	<i>Gulo gulo</i>	Annual	---	---	Special Concern
<b>MARINE MAMMALS</b>					
Atlantic Walrus (Northwest Atlantic population)	<i>Odobenus rosmarus</i>	Seasonally	Extirpated	1	Non-Active

UNCONTROLLED WHEN PRINTED



UNCLASSIFIED

SOW REF: 16.F.1.b

Species Common Name	Species Binomial Nomenclature	Time frame of Occurrence	SARA Status <sup>1</sup>	SARA Schedule <sup>2</sup>	COSEWIC Designation <sup>3</sup>
Bowhead Whale (Eastern Arctic Population)	<i>Balaena mysticetus</i>	Annual	Endangered	2	Non-Active
Bowhead Whale (Eastern Canada-West Greenland Population)	<i>Balaena mysticetus</i>	Annual	---	---	Special Concern
Habour Seal	<i>Phoca vitulina concolor</i>	Seasonally	---	---	Not at Risk
Killer Whale	<i>Orcinus orca</i>	Seasonally	---	---	Special Concern
Norwhal Whale	<i>Monodon monoceros</i>	Seasonally	---	---	Special Concern
Polar Bear	<i>Ursus maritimus</i>	Annual	Special Concern	1	Special Concern
Ringed Seal	<i>Phoca hispida</i>	Seasonally	---	---	Not at Risk
<b>BIRDS</b>					
American Golden Plover	<i>Pluvialis dominica</i>	Summer	---	---	---
American Pipit	<i>Anthus rubescens</i>	Summer	---	---	---
Arctic Tern	<i>Sterna paradisaea</i>	Summer	---	---	---
Baird's Sandpiper	<i>Calidris bairdii</i>	Summer	---	---	---
Common Eider	<i>Somateria mollissima</i>	Summer	---	---	---
Common Loon	<i>Gavia immer</i>	Summer	---	---	Not at Risk
Common Raven	<i>Corvus corax</i>	Annual	---	---	---
Common Redpoll	<i>Acanthis flammea</i>	Summer	---	---	---
Common Ringed Plover	<i>Charadrius hiaticula</i>	Summer	---	---	---
Glaucous Gull	<i>Larus hyperboreus</i>	Summer	---	---	---
Gyrfalcon	<i>Falco rusticolus</i>	Annual	---	---	Not at Risk
Hoary Redpoll	<i>Acanthis hornemanni</i>	Annual	---	---	---
Horned Lark	<i>Eremophila alpestris</i>	Summer	---	---	---
Iceland Gull	<i>Larus glaucooides</i>	Summer	---	---	---
King Eider	<i>Somateria spectabilis</i>	Summer	---	---	---
Lapland Longspur	<i>Calcarius lapponicus</i>	Summer	---	---	---
Long-Tailed Duck	<i>Clangula hyemalis</i>	Summer	---	---	---
Long-Tailed Jaeger	<i>Stercorarius longicaudus</i>	Summer	---	---	---
Northern Wheatear	<i>Oenanthe oenanthe</i>	Summer	---	---	---
Parasitic Jaeger	<i>Stercorarius parasiticus</i>	Summer	---	---	---
Peregrine Falcon, Tundrius subspecies	<i>Falco peregrinustundrius</i>	Annual	Special Concern	3	Non-Active
Pomarine Jaeger	<i>Stercorarius pomarinus</i>	Summer	---	---	---
Red-Breasted Merganser	<i>Mergus serrator</i>	Summer	---	---	---
Red-Necked Phalarope	<i>Phalaropus lobatus</i>	Summer	---	---	---
Red-Throated Loon	<i>Gavia stellata</i>	Summer	---	---	---
Rock Ptarmigan	<i>Lagopus muta</i>	Winter	---	---	---
Rough-Legged Hawk	<i>Buteo lagopus</i>	Summer	---	---	Not at Risk
Sandhill Crane	<i>Grus canadensis</i>	Summer	---	---	---
Semipalmated Plover	<i>Charadrius semipalmatus</i>	Summer	---	---	---
Snow Bunting	<i>Plectrophenax nivalis</i>	Summer	---	---	---
Snow Goose	<i>Chen caerulescens</i>	Summer	---	---	---
Snowy Owl	<i>Bubo scandiacus</i>	Annual	---	---	Not at Risk
White Rumped Sandpiper	<i>Calidris fuscicollis</i>	Summer	---	---	---
<b>FISH</b>					
Atlantic Cod (Arctic Marine Population)	<i>Gadus morhua</i>	Annual	---	---	Data Deficient

UNCONTROLLED WHEN PRINTED



SOW REF: 16.F.1.b

**Notes:**

1 = SARA Status. The federal Species At Risk Act (SARA) classifies species as extinct, extirpated, endangered, threatened, or special concern.

2 = The SARA Registry currently classifies species at risk in Schedules: 1, 2 and 3. Schedule 1, as defined in the Act, is the official list of wildlife for species at risk that are protected. The species are classified as either: extirpated, endangered, threatened or of special concern. The species listed in Schedules 2 and 3 are not protected under SARA. Species that are listed in schedules 2 and 3 are monitored and their designation is subject to re-assessment.

3 = The Committee on the Status of Endangered Wildlife in Canada (COSEWIC) is a committee of experts that assesses and designates which wildlife species are in some danger of disappearing from Canada. COSEWIC designations are based on status reports. These status reports are comprehensive technical reports that compile and analyze the best available information on a wildlife species' status in Canada and indicates the threats to that wildlife species. COSEWIC classifies species as extinct, extirpated, endangered, threatened, or special concern.

4 = Under Nunavut's Wildlife Act, a List of Species at Risk can be established. No species have been listed yet

5 = --- means there is no classification.

**25.40.6 WATER SUPPLY**

Water is trucked from a nearby lake or from the melt water stream between the upper and lower sites during the summer months as required.

**25.40.7 SEWAGE DISPOSAL**

Sewage is piped from the holding tank system to the sewage sumps.

**25.40.8 WASTE DISPOSAL**

Domestic waste is collected on site and then flown to LSS-Q where it is disposed of in the Iqaluit community landfill. The City of Iqaluit authorized the disposal of non-hazardous waste from the North Warning System Radar sites in the city landfill.

**25.40.9 ELECTRICAL POWER**

Power is generated at this site through three generators, which have the capacity to be synchronized together. Total capacity can vary depending on the site load and the number of DEGs online. This range can vary from 175 kW to 525kW.

**25.40.10 FIRE PROTECTION**

Components: The fire protection system consists of:

- Fire Alarm & Detection System;
- CO<sub>2</sub> Fire Suppression Systems;
- FM-200 Fire Suppression System; and
- Portable Fire Extinguisher.

Description: The Fire Alarm Control Panel (FACP) for the main detection system (GE quick start) is located in the dining area.

If the FACP fire alarm is activated, the system will:

**UNCONTROLLED WHEN PRINTED**



SOW REF: 16.F.1.b

- a. activate the fire doors in the activated zone;
- b. set off the alarm bells and horns throughout the site;
- c. activate the station siren to notify personnel outside; and
- d. send a signal to notify the NWSCC.

The Pyrene CO2 system is located in the C&E and the Power Plant area.

If a single detector from the Pyrene System is activated, the system will:

- a. set off the alarm bells and horns in that area;
- b. send a signal to the main FACP, which activates the main fire alarm panel and will set off the alarm bells and horns throughout the site; and
- c. send a signal to notify the NWSCC.

If a second device in the C&E area is activated, the following will occur:

- a. the FACP will initiate shutdown of the exhaust fans and radar;
- b. the FACP will initiate the discharge of CO2 into the zone where alarm initiated from;
- c. the FACP will activate the discharge strobes above the entrance way to the fire zone;
- d. the discharge pressure switch will activate; and
- e. send a signal to notify the NWSCC.

If a second device in the Power Plant on the site is activated, the following will occur:

- a. the FACP will initiate the shutdown of the exhaust fan & power;
- b. the FACP will initiate the generator shut down;
- c. the FACP will initiate CO2 discharge into the power plant;
- d. the FACP will initiate the discharge strobes above the entrance way to the fire zone;
- e. the discharge pressure switch will activate; and
- f. send a signal to notify the NWSCC.

The FM-200 Suppression System is located in the Communications Room (Comms Room), and is made up of two 60 lbs cylinders with 48 lbs of agent. The system is supervised by the GE Quick Start Fire Alarm Panel.

If a single device in the Comms Room is activated, the following will occur:

- a. the FACP will initiate evacuation bell within the Comms Room;
- b. the FACP will send a signal to the GE Quick Start FACP which will activate the sites Fire Alarm System; and
- c. the FACP will send a signal to notify the NWSCC.

If a second device in the Comms room is activated, the following will occur:

- a. the FACP will initiate the discharge sequence; and
- b. the discharge strobes will activate above the entrance way to the Comms Rooms.

The Kitchen Range Guard System is located in the dining area, and is made up of one cylinder containing 11.3 L (2.5 Gal) of agent. The system is supervised by the GE Quick Start Fire Alarm Panel.

**UNCONTROLLED WHEN PRINTED**



SOW REF: 16.F.1.b

If the system is activated by either the release of a fusible link in the canopy which will flood the grills and canopy with agent, or by a manual pull station located on the canopy, the main FACP will:

- a. will be signaled;
- b. will set off the alarm bells and horns; and
- c. send a signal to notify the NWSCC.

**25.40.11 KITS**

**Table 25.40-2 DYE-M Kits and Locations**

KIT	LOCATION
Fire Fighting Equipment	"A" & "B" Train Receiving Room, Garage
Safety Boards	"A" Train Mod 29 (C&E) & "A" Train Mod 49 (Old Cummins Plant, Power House)
Disaster/Survival	"C" Train
POL Spill	C&E Maintenance Shop
Chemical/PCB/Asbestos Spill	C" Train
First Aid Supplies	"A" Train, Mod 39

**Table 25.40-3 DYE-M Fuel Spill Kit**

CAT I.D.	QTY.	ITEM	PART NUMBER
1067553	C/W	<b>POL SPILL CLEANUP KIT No. 1</b>	<b>CL006</b>
1021477	20 BG	ABSORBENT, MATERIAL 50 QT. BAG	48210
1021572	10 RL	ABSORBENT, MATERIAL, 3/8" X 36" X 144 FT	OB150
1044124	150BG	ABSORBENT, MATERIAL 50 QT. BAG	48230
1021664	1 CS	ABSORBENT, SHEET, 200 SH/CS, 17"X19"X3/8"THK	OB100
1059485	8 EA	BOOM, OIL 40 FT. TOTAL LG.	48225
1062419	2 EA	PITCHFORK	R41645
1018094	1 BX	PLASTIC BAG 100 BAGS/BOX	35-50-3B
1008712	4 RL	PLASTIC POLY 6 MIL, 1000 SQ.METERS	VISQUEENCLEAR
1021141	3 EA	HALF MASK, DISPOSABLE TYPE	GT-9999-3005-7
1009276	1 RL	ROPE, POLYPROPYLENE 600 FT.	MIL-R-24049
1013919	20 PR	RUBBER GLOVES, LINED	GL4513 (M)
1061292	2 PR	SAFETY GOGGLES	6367
1062475	2 EA	SHOVEL, ROUND MOUTH	GGG-S-326
1022135	1 EA	SLIPTANK, PORTABLE 100 GAL.	TANK100
1003058	2 EA	SALVAGE DRUMS 85 GAL.	PS-26368

UNCONTROLLED WHEN PRINTED



UNCLASSIFIED

SOW REF: 16.F.1.b

Table 25.40-4 DYE-M Chemical Spill Kit

CAT I.D.	QTY.	ITEM	PART NUMBER
<b>1067552</b>	<b>C/W</b>	<b>CHEMICAL SPILL KIT</b>	<b>CL007</b>
1023947	4 PR	COVERALLS, W/ HOOD & BOOT COVERS	SEA PA5228
1012151	4 PR	GLOVES, CHEMICAL RESISTANT	111E220
1063898	1 BX	RAGS, COTTON, 50 LB.	31-25
1062334	4	SIGN, HAZARDOUS CHEMICAL	70852
1022625	4	RESPIRATOR, HALF-FACE	655X013
1022622	12	CARTRIDGE FILTERS, VAPOUR	655F155

Table 25.40-5 DYE-M Asbestos Response Kit

CAT I.D.	QTY.	ITEM	PART NUMBER
<b>1067551</b>	<b>C/W</b>	<b>ASBESTOS RESPONSE KIT</b>	<b>CL008</b>
1023947	8 PR	COVERALLS, W/ HOOD & BOOT COVERS	SEA PA5228
1063146	2 BG	GLOVEBAG. HORIZONTAL, ZIP-LOCK	10HZ
1050629	1 PG	GLOVEBAG. TEE, ZIP-LOCK	10TZ
1049979	1 PG	GLOVEBAG. HORIZ. W/VALVE ZIP-LOCK	10VLZ
1060069	1 PG	GLOVEBAG. VERTICAL, ZIP-LOCK	10VZ
1063031	1 BG	ADHESIVE, BAKELITE	120-18
1063032	1	CANVAS SHEET 5 FT. X 6 FT.	00
1022622	12	CARTRIDGE FILTERS, VAPOUR	655F155
1060534	2	CAUTION LABELS (BRADY)	85383
1011756	14 RL	DUCT TAPE	290
1057731	2	EXPANSION STRIP 6" X 54 "	0654EX
1012151	10 PR	GLOVES, CHEMICAL RESISTANT	111E220
1013228	1 BX	GLOVES, SURGICAL 100/BOX	431104
1011596	3	PLASTIC PAIL	L-P-65
1008712	2 RL	SHEET, PLASTIC 144" W X 1200" LG.	VISQUEENCLEAR
1066387	1	PRESSURE SPRAYER, 1 GAL	60071
1063898	1	RAG, COTTON	31-25
1022625	4	RESPIRATOR, HALF-FACE	655X013
1009663	1	SHEARS, METAL TIN SNIPS	270-10
1063027	1 SE	SHOULDER STRAP, 30" LG	30SS
1063040	1 SE	SHOULDER STRAP, 60" LG	60SS
1063637	1	DISINFECTANT, 1 GAL	EMP425-1
1019931	3	UTILITY KNIFE	U-3-C
1061205	4	WARNING SIGN (BRADY)	92288
1061986	1	WIRE, FLEXSAW	20FS
1018252	1 PL	WETTING AGENT, SURFACTANT 5 GAL.	CP-225
1062413	6 EA	BAG, PLASTIC. YELLOW	ASBA003
1064301	4	BRUSH, PAINT 4 IN. WIDE	310-100

UNCONTROLLED WHEN PRINTED



SOW REF: 16.F.1.b

**25.40.12 BULK FUEL STORAGE AND DISTRIBUTION**

Fuel is delivered to the site biannually. The ship pumps directly into the beach tanks via a 100 mm diameter fuel transfer line. Bulk fuel technicians transfer fuel annually from the beach tanks to the summit bulk tank DYE W20A using two 13,000 L fuel trucks.

**Table 25.40-6 DYE-M Bulk Fuel Storage**

LOCID	Location	Fuel Usage	Tank Size (L)	Max Fill Volume (L)	Usable Volume (L)
Environment Canada ID # & System Name: EC-00004476, DYE-M Summit					
DYEW22J	Summit	PGS	69,200	65,084	63,427
DYEW22K	Summit	PGS	69,200	65,084	63,427
DYEW21E	Summit	Vehicle Refueller	4,125	3,878	3,770
DYEW20A	Summit	PGS	946,300	890,038	845,653
DYEW20B	Summit	PGS	69,200	65,084	63,427
DYEDAYT1	PGS	Power Plant	1,135	1,067	1,067
DYEDAYT2	PGS	Garage	1,135	1,067	1,067
DYEDAYT3	PGS	Garage	1,135	1,067	1,067
DYEDAYT4	PGS	HVS	1,135	1,067	1,067
DYEDAYT5	PGS	HVS	1,135	1,067	1,067
Environment Canada ID # & System Name: EC-00004477, DYE-M Beach					
DYEW20G	Beach	PGS	91,000	84,631	78,708
DYEW20H	Beach	PGS	91,000	84,631	78,708
DYEW20I	Beach	PGS	91,000	84,631	78,708
DYEW20J	Beach	PGS	91,000	84,631	78,708
DYEW20K	Beach	PGS	91,000	84,631	78,708
DYEW20L	Beach	PGS	91,000	84,631	78,708
DYEW20M	Beach	PGS	91,000	84,631	78,708
DYEW20N	Beach	PGS	91,000	84,631	78,708
DYEW20O	Beach	PGS	91,000	84,631	78,708
DYEW20P	Beach	PGS	91,000	84,631	78,708
DYEW20Q	Beach	PGS	91,000	84,631	78,708
<b>Summit Totals:</b>			<b>1,163,700</b>	<b>1,094,503</b>	<b>1,045,039</b>
<b>Beach Totals:</b>			<b>1,001,000</b>	<b>930,941</b>	<b>865,788</b>
<b>Site Totals:</b>			<b>2,164,700</b>	<b>2,025,444</b>	<b>1,910,827</b>

UNCONTROLLED WHEN PRINTED





SOW REF: 16.F.1.b

**Table 25.40-7 DYE-M Fuel System Components**

COMPONENT	USE	DESCRIPTION
Tanks DYE W20B; DYE W22I; DYE W22J; & DYE W22K	PGS	Single walled, horizontal, steel 69,200L tanks at the Upper site (DEW Line Vintage) contained in a gravel dike with an impermeable liner (1995). Dike volume meets the required code capacity with membrane under the tank.
Tank W20A	Aviation	Field-erected, vertical, single bottom, steel 946,000L Summit tank (1956-1957) contained in a gravel dike with an impermeable liner (1995). The dike volume meets the required code capacity. The membrane in the dike attaches to the perimeter of the tank concrete foundation but does not pass under bottom of tank and does not meet CEPA requirements.
Tanks DYE W20G to DYE W20Q		11 Self-diked, horizontal, steel 91,000L tanks at the beach (2001). All double-walled construction, linked together with header piping and single cat-walk structure.
Pipelines		<p>a. 100 m of 100 mm diameter aboveground piping from sealift connection point to beach tanks</p> <p>b. 80 m of 50 mm diameter aboveground piping from beach tanks to fuel truck connection point</p> <p>c. There is a network of aboveground and underground piping at the upper site. The piping interconnects each of the tanks with each of the buildings, although a majority of it has not been in service since the transition in 1995. Below is a summary of the primary segments:</p> <p>i. 50 mm diameter aboveground and underground piping running from DYE W20A and DYE B06A, along both trains A and B to connect to PGS and Aviation tanks DYE W22J, DYE W22K, and DYE W20B.</p> <p>ii. 50 mm diameter aboveground piping running from DYE W20B to helicopter refueling point at end of Train A.</p> <p>iii. 50 mm diameter aboveground and underground piping running from DYE W20A and DYE B06A, to garage (DYE B10A) and vehicle refueller DYE W21E.</p> <p>iv. 50 mm diameter aboveground and underground piping connecting to various segments listed above, running to cold-soaked and decommissioned buildings DYE B03B, DYE B10A, DYE B27A, and DYE B11B.</p>
Pumphouse		Upper Site Tank Area

Sources Include:

1. Initial Environmental Evaluation of the North Warning System Project, Vols. 1 & 2. Monenco- Eyretechnics Group, 1987(vol. 1), 1989(vol.2).
2. Environmental Cleanup Study of 21 DEW Line Sites in Canada. UMA, June 1991.
3. NWS Environmental Study, Vol. 2: Site Analysis. Royal Roads Military College Environmental Sciences Group (Reimer), June 1991.
4. Nunavut Land Claims Agreement, 1993.
5. NWS Site Record Drawings.
6. Nunavut Wildlife Resource and Habitat Values. Nunami Jacques Whitford Limited. October 2008.

UNCONTROLLED WHEN PRINTED



SOW REF: 16.F.1.b

**Table 25.40-8 DYE-M LOCID Register**

<b>LOCID #</b>	<b>FACILITY NAME</b>
DYE B01A	RADAR/COM - A-TRAIN
DYE B02A	ACCOMMODATION BLDG ARMCO
DYE B02B	ACCOMMODATION BLDG ARMCO
DYE B03A	TECH SERV/POWER BLDG
DYE B03B	TECH SERV/POWER BLDG
DYE B06A	POL PUMPHOUSE - SUMMIT
DYE B09A	AIRSTRIIP TERMINAL BUILDING
DYE B10A	GARAGE
DYE B10B	GARAGE
DYE B11A	B-TRAIN
DYE B11B	C-TRAIN
DYE B13A	WAREHOUSE # 2
DYE B13B	WAREHOUSE # 2
DYE B13C	WAREHOUSE # 3
DYE B13D	WAREHOUSE # 4
DYE B13E	WAREHOUSE # 5
DYE B13F	WAREHOUSE # 6
DYE B14A	HANGAR - LOWER SITE
DYE B15A	TACAN BUILDING - SUMMIT SITE
DYE B16A	LSS FACILITY
DYE B17A	DINING HALL - LOWER SITE
DYE B25B	RADIO TERMINAL BUILDING #17
DYE B25C	RADIO TERMINAL BUILDING - TACAN
DYE B25D	SWITCHING CENTER/COMM. BUILDING
DYE B27A	HEATED VEHICLE STORAGE BLDG. SUMMIT SITE
DYE B27B	HEATED VEHICLE STORAGE BLDG. LOWER SITE
DYE W01A	ROADS
DYE W02A	SANITARY SEWERS/SEWER LINES
DYE W05A	AUXILIARY POWER UNIT
DYE W06A	POWER DIST./CABLE GROUND
DYE W07A	ILLUMINATED WINDCONE(s)
DYE W08A	POL DISTRIBUTION LINES
DYE W09A	SGT PLATFORM/FOUNDATION MAIN
DYE W09C	VARIOUS ANTENNA STRUCTURES
DYE W09D	SGT PLATFORM/FOUNDATION STANDBY
DYE W09X	SGT PLATFORMS/FOUNDATIONS - MAIN & STANDBY
DYE W10A	HELIPAD(S)
DYE W11A	BOLLARDS
DYE W13A	TVRO FOUNDATION/ANTENNA

**UNCONTROLLED WHEN PRINTED**



UNCLASSIFIED

SOW REF: 16.F.1.b

<b>LOCID #</b>	<b>FACILITY NAME</b>
DYE W14A	WEATHER EQUIPMENT
DYE W15A	RUNWAY AREA - APRON
DYE W16A	LIGHTING - AIRFIELD
DYE W19B	POL tank 22 KI (lower)
DYE W20A	AVIATION/JET A-1 TANK
DYE W20B	AVIATION/JET A-1 TANK
DYE W20G	AVIATION/JET A-1 TANK
DYE W20H	AVIATION/JET A-1 TANK
DYE W20I	AVIATION/JET A-1 TANK
DYE W20J	AVIATION/JET A-1 TANK
DYE W20K	AVIATION/JET A-1 TANK
DYE W20L	AVIATION/JET A-1 TANK
DYE W20M	AVIATION/JET A-1 TANK
DYE W20N	AVIATION/JET A-1 TANK
DYE W20O	AVIATION/JET A-1 TANK
DYE W20P	AVIATION/JET A-1 TANK
DYE W20Q	AVIATION/JET A-1 TANK
DYE W20X	AV/JET-A1 TANKS - ALL
DYE W21E	REFUELLER TANK
DYE W21X	REFUELLER TANK - ALL
DYE W22I	PGS/JET-A1 TANK
DYE W22J	PGS/JET-A1 TANK
DYE W22K	PGS/JET-A1 TANK
DYE W22X	PGS/JET-A1 TANKS - ALL
DYE W29A	FIRE PROTECTION SYSTEM
DYE W30A	SECURITY SYSTEM
DYE W31A	GENERAL GROUNDS
DYE W32A	OPEN STORAGE AREA - POL
DYE W32B	OPEN STORAGE AREA - DISPOSAL
DYE W32C	OPEN STORAGE AREA - MISC.
DYE W33A	PIER/BEACH AREA
DYE W35A	CONTAINMENT DYKES
DYE W42A	ELEVATED WALKWAY
DYE W42B	ELEVATED WALKWAY
DYE W42C	ELEVATED WALKWAY
DYE W42D	ELEVATED WALKWAY
DYE W43A	SITE SIGNS AND FLAG POLES

UNCONTROLLED WHEN PRINTED



SOW REF: 16.F.1.b




**DYE-M CAPE DYER**

**UNCONTROLLED WHEN PRINTED**


H - C75/2 - 8400 - 103

DYE - M

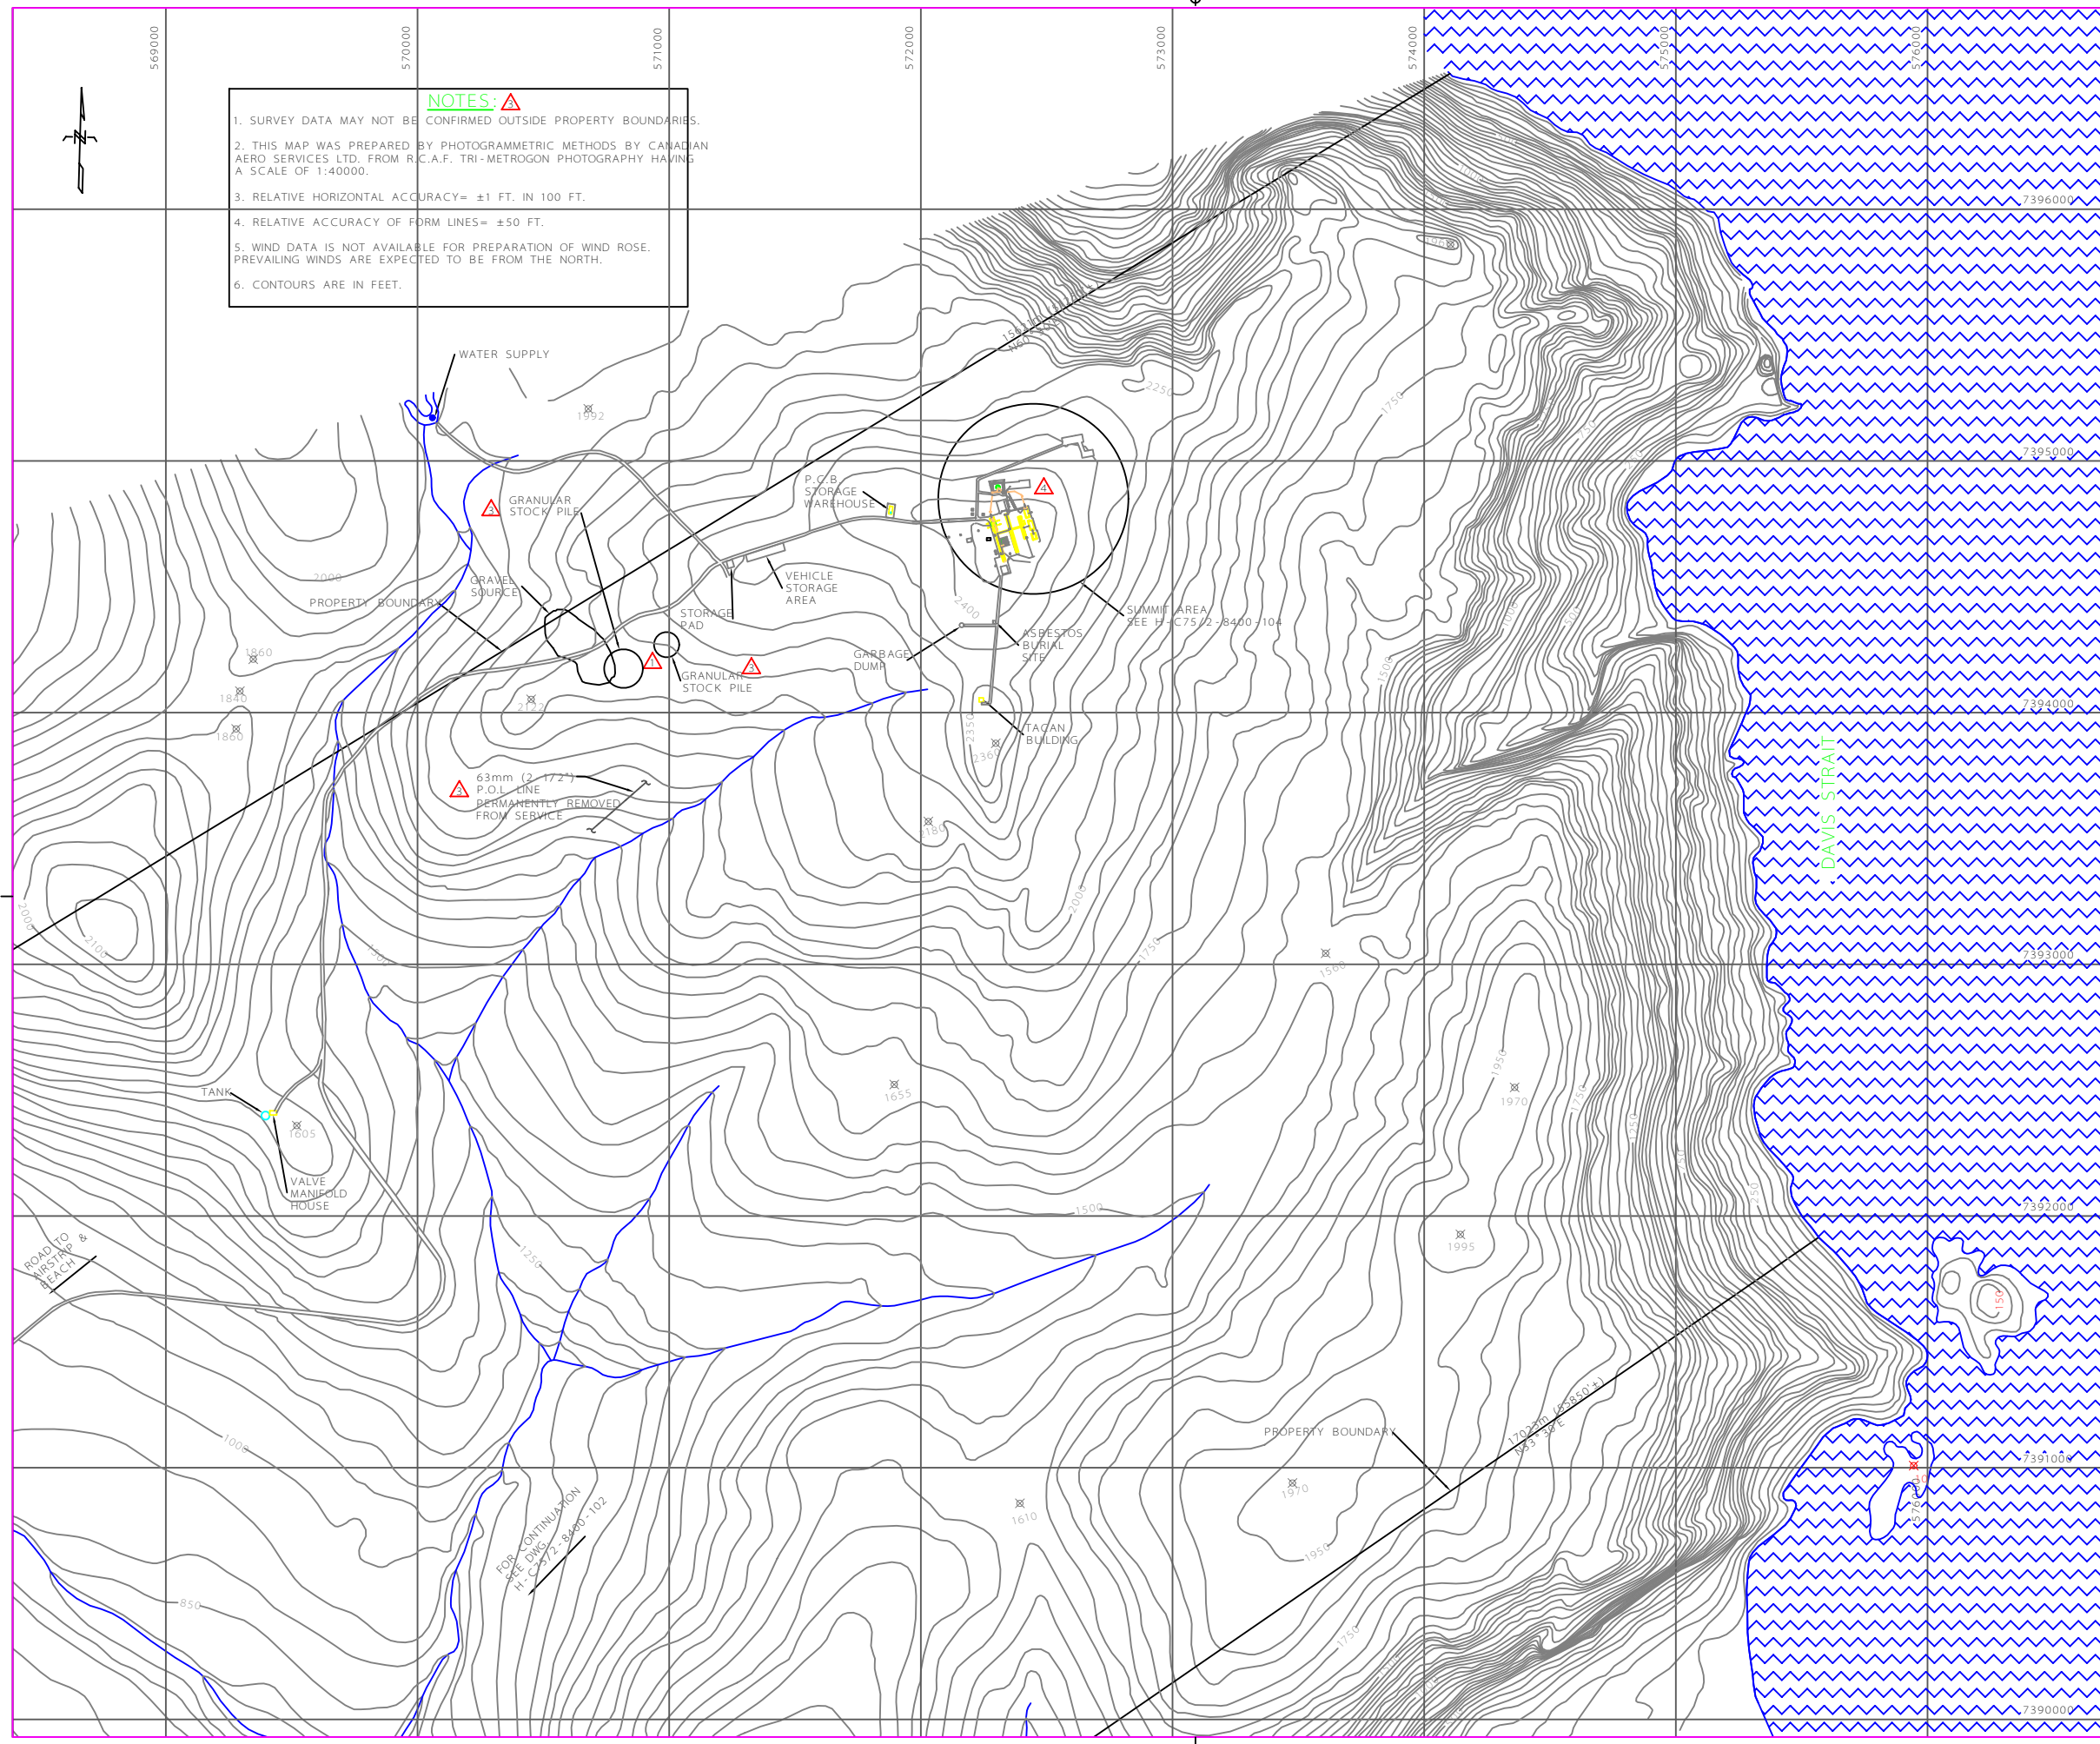

**NOTES:**

1. SURVEY DATA MAY NOT BE CONFIRMED OUTSIDE PROPERTY BOUNDARIES.
2. THIS MAP WAS PREPARED BY PHOTOGRAMMETRIC METHODS BY CANADIAN AERO SERVICES LTD. FROM R.C.A.F. TRI-METROGON PHOTOGRAPHY HAVING A SCALE OF 1:40000.
3. RELATIVE HORIZONTAL ACCURACY = ±1 FT. IN 100 FT.
4. RELATIVE ACCURACY OF FORM LINES = ±50 FT.
5. WIND DATA IS NOT AVAILABLE FOR PREPARATION OF WIND ROSE. PREVAILING WINDS ARE EXPECTED TO BE FROM THE NORTH.
6. CONTOURS ARE IN FEET.

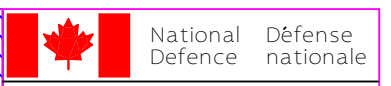

NORTH WARNING SYSTEM OFFICE  
Bureau du système d'alerte du Nord



**NOTES:**

1. NASITTUQ HAS CARE CUSTODY OF ENTIRE PARCEL.

**LEGEND:**

- SWAMP
- WATER/LAKE
- POL LINE
- ROADWAY
- STREAM

NO	DATE	REVISION	REVISION	DRN	APPR
4	22 OCT 11	REV AS PER DM-50915		A.S.	B.M.
3	29 APR 10	REV AS PER REDLINES		J.G.	K.J.
2	13 JUN 08	REV AS PER REDLINES		P.P.	
1	19 DEC 02	REVISED AS PER NQ-20069		K.R.	

SITE RECORD DRAWING



SCALE - ÉCHELLE  
**1 : 10000**

PROJECT - PROJET  
**CM - 66431**

LONG RANGE RADAR SITE  
**DYE - M**

CAPE DYER NUNAVUT  
TRADE - MÉTIER SITING DATE 03 APR 02

SUBJECT - SUJET  
**SITE PLAN**

DESIGNED / ÉTUDE	CONCURRENCE - ASSENTIMENT	PREVOT DU SERVICE DES INCENDIES
DRAWN / DESSINÉ K.R.	FIRE MARSHAL	
CHECKED / VÉRIFIÉ T.R.	NWSO ENGINEERING OFFICER	OFFICIER DU GÉNIE B.SAN
COORDINATION	NWSO FACILITIES ENGINEER	GÉNIE DES INSTALLATIONS B.SAN

DWG. NO. - DESSIN NO.  
**H - C75/2 - 8400 - 103**









H - C75/2 - 8400 - 107

DYE - M



LEGEND:

-  ABOVE GROUND POL LINE
-  UNDERGROUND POL PERMANENTLY REMOVED FROM SERVICE
-  ABOVE GROUND POL LINE PERMANENTLY REMOVED FROM SERVICE
-  SEWER LINE
-  ROADWAY 

4	31 MAY 13	REVISED AS PER RED LINES RETURN BY P.M. ON FEB. 2012	A.S.	N.K.
3	22 OCT 12	REV AS PER DM - 50915	A.S.	B.M.
2	29 APR 10	REV AS PER REDLINES	J.G.	K.R.
1	22 SEPT 04	REVISED AS PER NQ-12374	K.R.	
NO	DATE	REVISION	DRN	APPR

SITE RECORD DRAWING



SCALE - ÉCHELLE  
1 : 1000

PROJECT - PROJET  
CM - 66431


LONG RANGE RADAR SITE  
DYE - M

CAPE DYER NUNAVUT  
TRADE - MÉTIER SITING DATE 03 APR 02

SUBJECT - SUJET  
SUMMIT  
LOCID PLAN


DESIGNED ÉTUDE	FIRE MARSHAL	PRÉVOT DU SERVICE DES INCENDIES
DRAWN DESSINÉ K.R.	CHECKED VÉRIFIÉ T.R.	COORDINATION NWSO FACILITIES ENGINEER
OFFICER DU GÉNIE BSAN		GENIE DES INSTALLATIONS BSAN

DWG. NO. - DESSIN NO.  
H - C75/2 - 8400 - 107

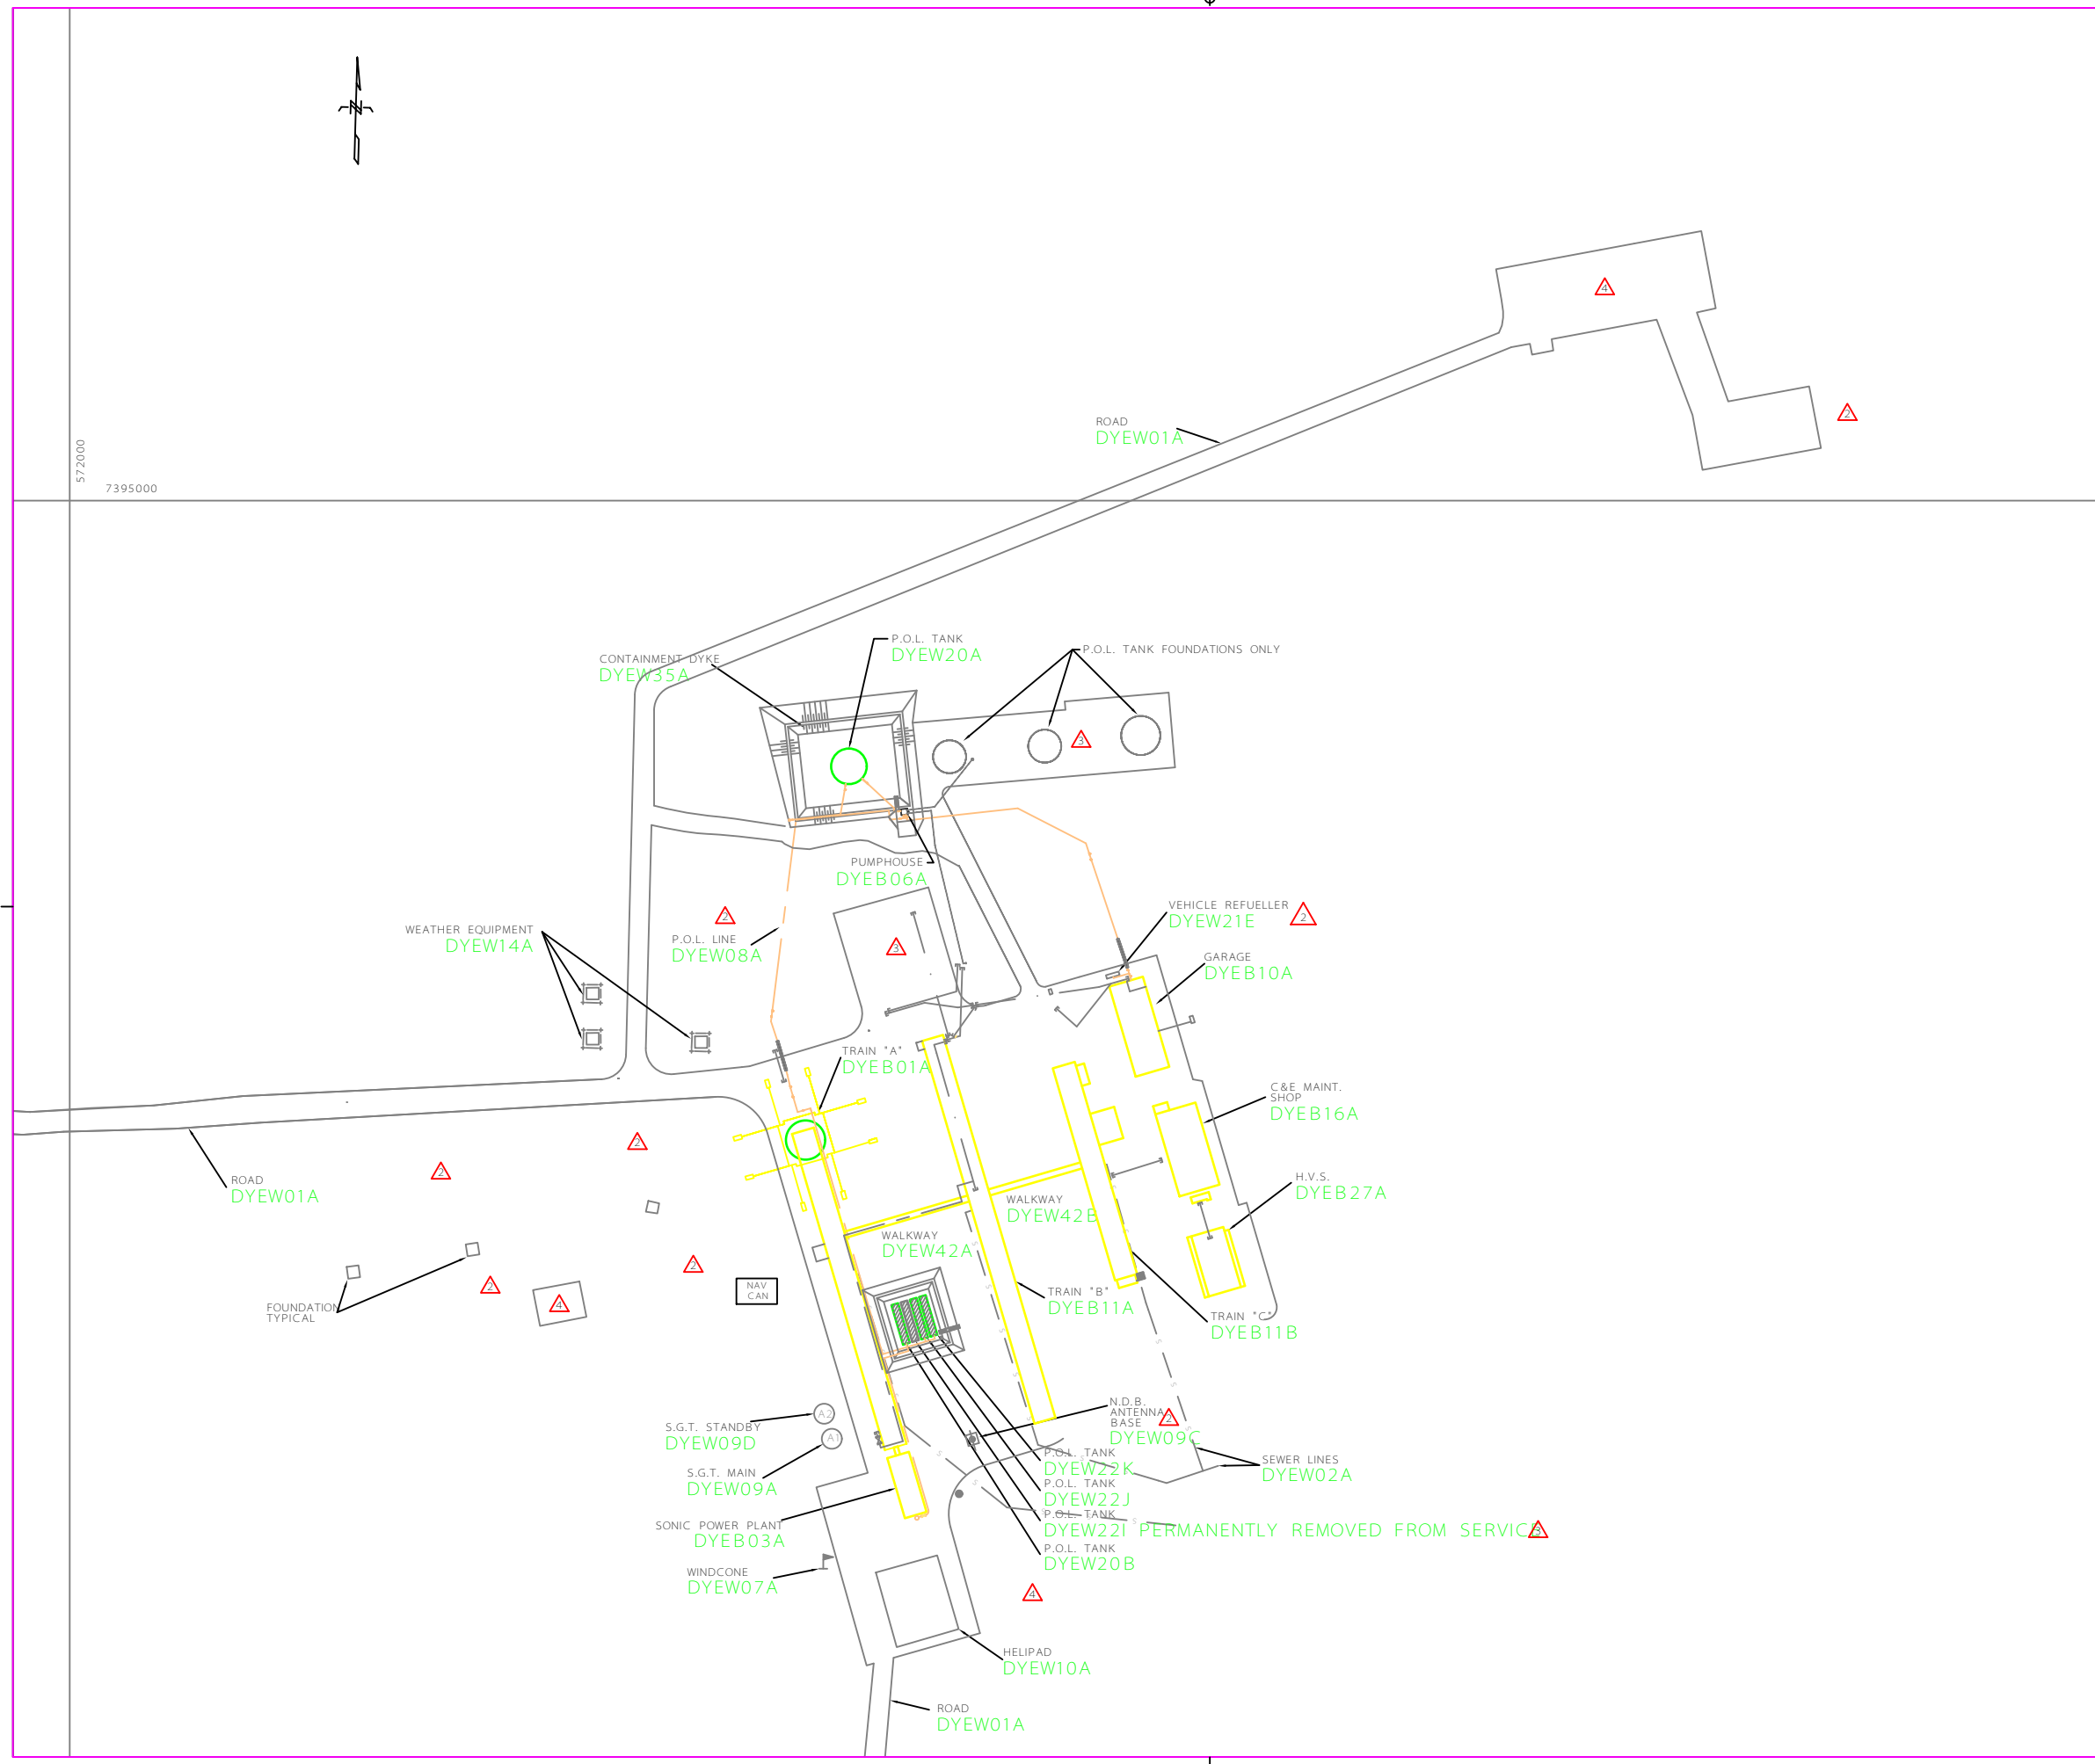

H-C75/2-8400-108

DYE-M

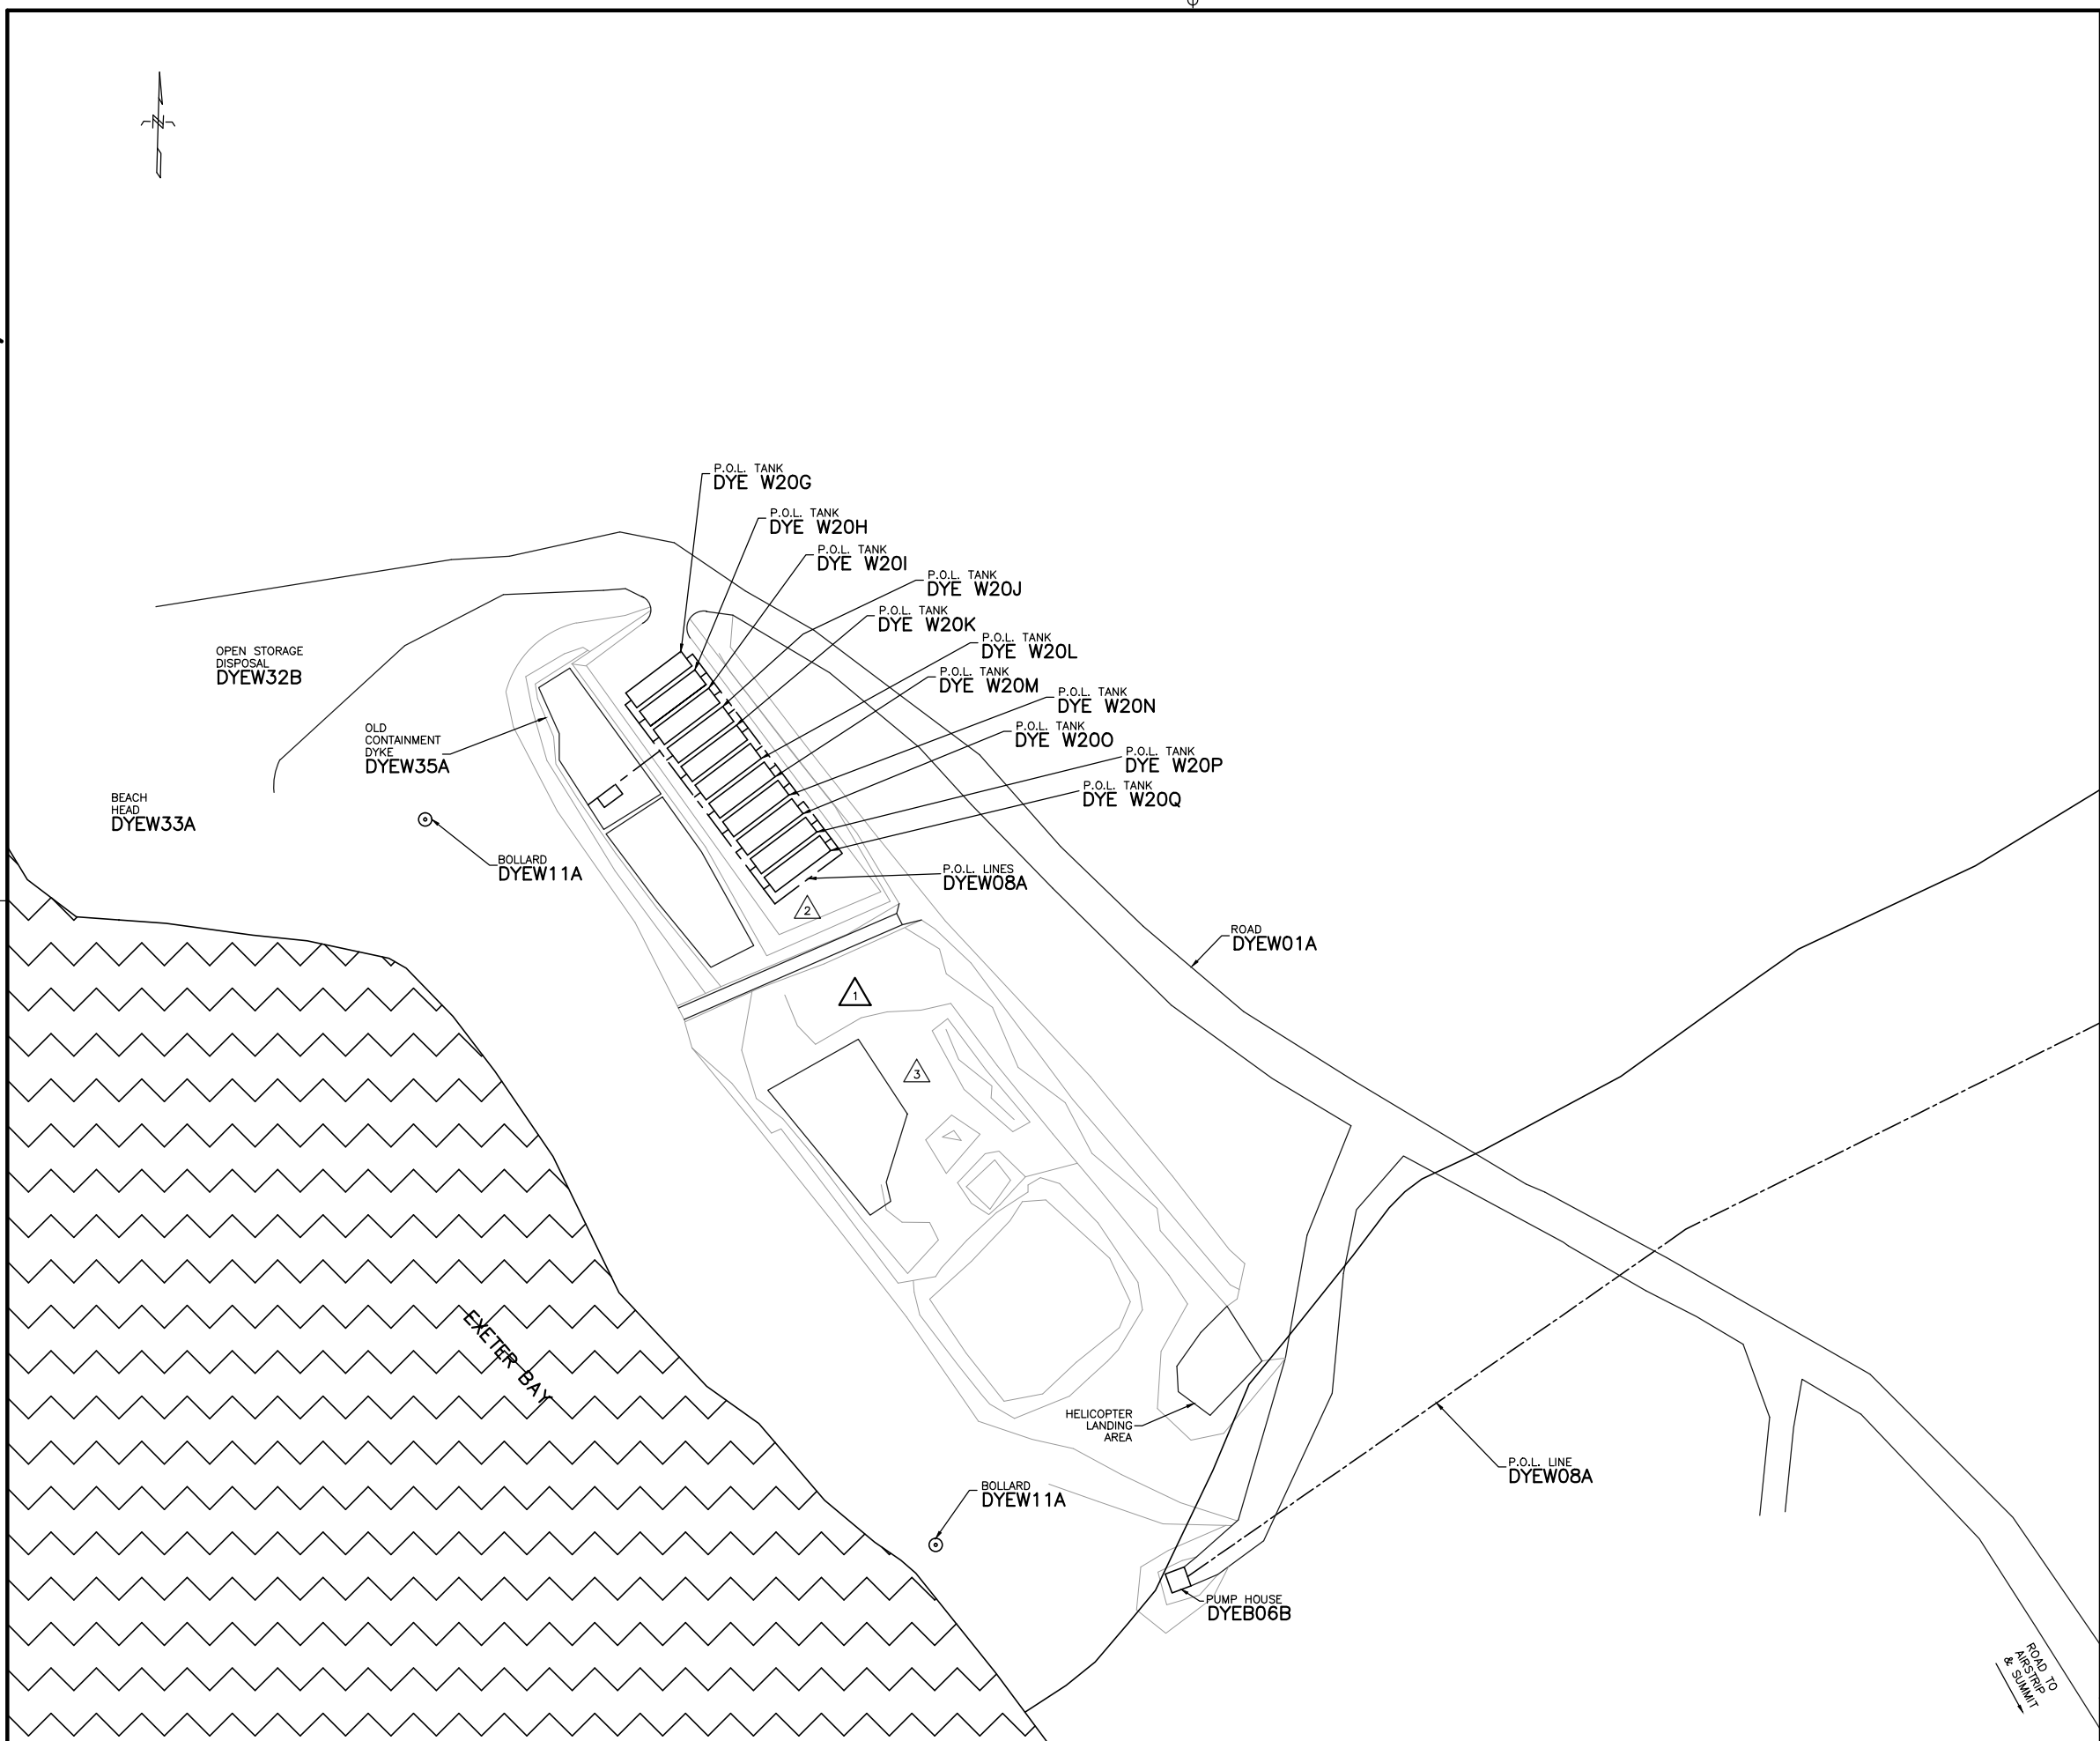

**National Défense nationale**  
 NORTH WARNING SYSTEM OFFICE  
 Bureau du système d'alerte du Nord

LOCATION



**LEGEND:**

- WATER/LAKE
- POL LINE
- ROADWAY
- STREAM

No.	DATE	REVISION	REVISION	DRN.	APPR.
3	29 APR 10	REV AS PER REDLINES		J.G.	K.J.
2	12 NOV 03	REVISED AS PER DM-66019		F.P.	
1	19 DEC 02	REVISED AS PER NQ-20066		K.R.	

SCALE - ÉCHELLE

1:500

PROJECT - PROJET  
**CM-66431**  
 LONG RANGE RADAR SITE  
**DYE-M**

CAPE DYER NUNAVUT  
 TRADE - MÉTIER SITING DATE 03 APR 02

SUBJECT - SUJET  
**BEACH LOCID PLAN**

PRODUCTION		CONCURRENCE - ASSENTIMENT	
DESIGNED ÉTUDIÉ	FIRE MARSHAL	PRÉVOT DU SERVICE DES INCENDIES	
DRAWN DESSINÉ	K.R.	OFFICIER DU GÉNIE BSAN	
CHECKED VÉRIFIÉ	T.R.	NWSO ENGINEERING OFFICER	GÉNIE DES INSTALLATIONS BSAN
COORDINATION		NWSO FACILITIES ENGINEER	

DWG. NO. - DESSIN NO.  
**H-C75/2-8400-108**

