




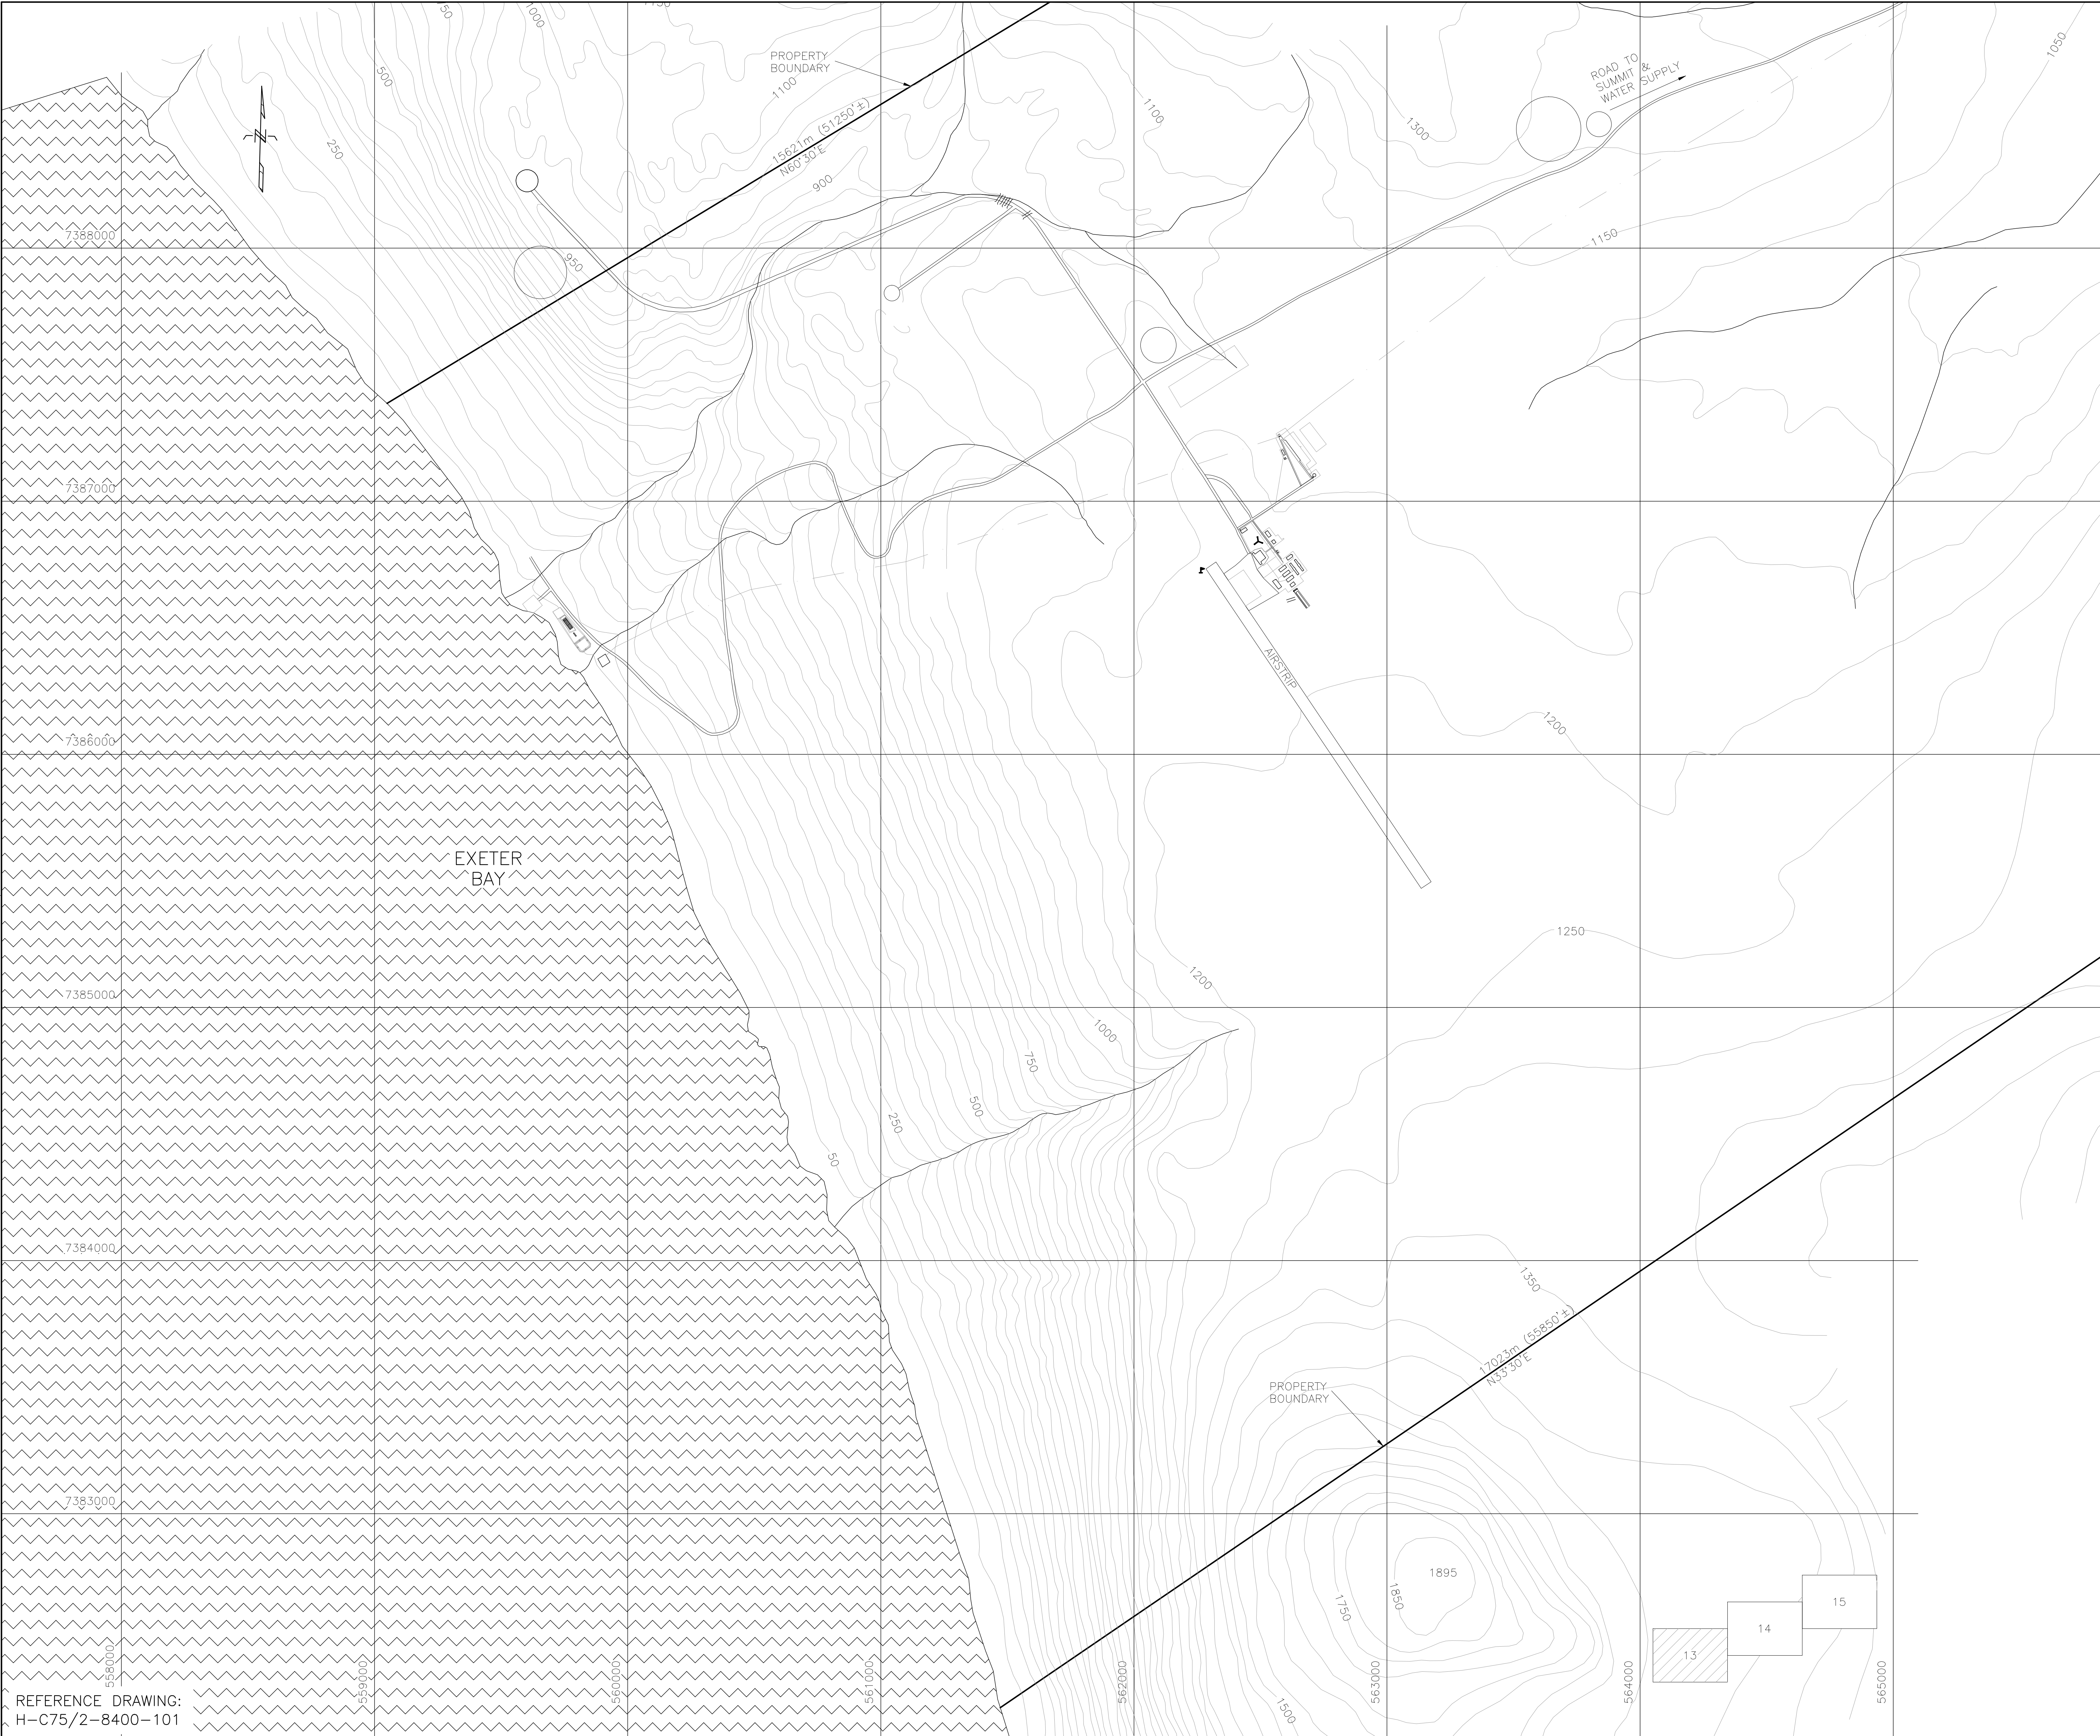


National
Defence

Défense
nationale

NORTH WARNING SYSTEM OFFICE
Bureau du système d'alerte du Nord

LOCATION

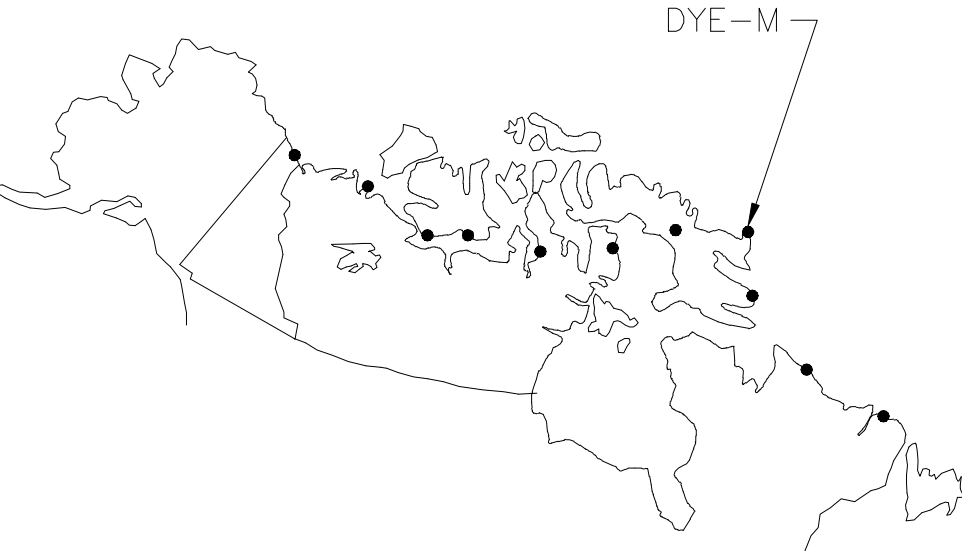



100-170 LAURIER AVE. WEST
OTTAWA, ONTARIO K1P 5V6
TEL.: (613) 234-9033
FAX: (613) 234-3888

NOTES:

1. NASITTUQ HAS CARE CUSTODY OF ENTIRE PARCEL.

2. SURVEY DATA MAY NOT BE CONFIRMED OUTSIDE PROPERTY BOUNDARIES.

3. THIS MAP WAS PREPARED BY PHOTOGRAMMETRIC METHODS BY CANADIAN AERO SERVICES LTD. FROM R.C.A.F. TRI-METROGON PHOTOGRAPHY HAVING A SCALE OF 1:40000.

4. RELATIVE HORIZONTAL ACCURACY = ±1 FT. IN 100 FT.

5. RELATIVE ACCURACY OF FORM LINES = ±50 FT.

6. WIND DATA IS NOT AVAILABLE FOR PREPARATION OF WIND ROSE. PREVAILING WINDS ARE EXPECTED TO BE FROM THE NORTH.

7. CONTOURS ARE IN FEET.

LEGEND:

 SWAMP

 WATER/LAKE

REDUCED DRAWING FOR INFORMATION ONLY

SCALE IS REPRESENTATIVE OF FULL SIZE DRAWING.

1	30 OCT 09	RELEASE FOR NUNAVUT W.B.	M.J.	
No.	DATE	REVISION	RÉVISION	DRN. APPR.
SITE RECORD DRAWING				
2000000 0200400600800 metres mètres				
SCALE - ÉCHELLE				
1 : 10000				
PROJECT - PROJET				
LONG RANGE RADAR SITE				
DYE-M				
CAPE DYER		NUNAVUT		
TRADE - MÉTIER		SITING		DATE 30 OCT 09
SUBJECT - SUJET				
TOPOGRAPHIC SITE MAP				
PRODUCTION		CONCURRENCE - ASSENTMENT		
DESIGNED ÉTUDIÉ	W.W.	FIRE MARSHAL	PRÉVOT DU SERVICE DES INCENDIES	
DRAWN DESSINÉ	M.J.			
CHECKED VÉRIFIÉ	B.T.	NWSO ENGINEERING OFFICER	OFFICIER DU GÉNIE BSAN	
COORDINATION		NWSO FACILITIES ENGINEER	GÉNIE DES INSTALLATIONS BSAN	
DWG. NO. - DESSIN NO. SK-13				

Canada

