


National Défense
Defence nationale

NORTH WARNING SYSTEM OFFICE
Bureau du système d'alerte du Nord

LOCATION

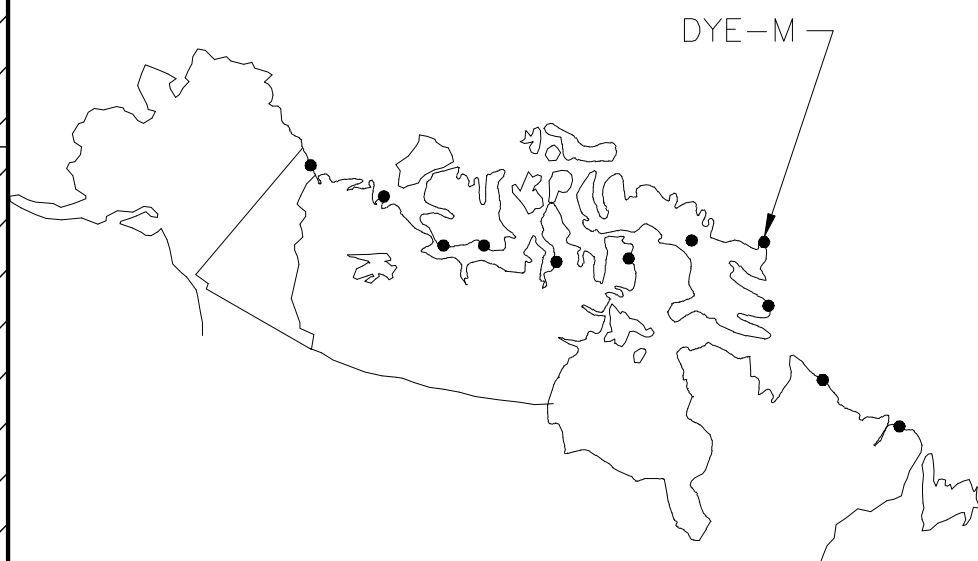


**100-170 LAURIER AVE. WEST
OTTAWA, ONTARIO K1P 5V5
TEL.: (613) 234-9033
FAX.: (613) 234-3888**

NOTES:

1. NASITSIQ HAS CARE CUSTODY OF ENTIRE PARCEL.
2. SURVEY DATA MAY NOT BE CONFIRMED OUTSIDE PROPERTY BOUNDARIES.
3. THIS MAP WAS PREPARED BY PHOTOGRAMMETRIC METHODS BY CANADIAN AERO SERVICES LTD. FROM R.C.A.F. TRI-METROGON PHOTOGRAPHY HAVING A SCALE OF 1:40000.
4. RELATIVE HORIZONTAL ACCURACY = ± 1 FT. IN 100 FT.
5. RELATIVE ACCURACY OF FORM LINES = ± 50 FT.
6. WIND DATA IS NOT AVAILABLE FOR PREPARATION OF WIND ROSE. PREVAILING WINDS ARE EXPECTED TO BE FROM THE NORTH.
7. CONTOURS ARE IN FEET.

LEGEND:

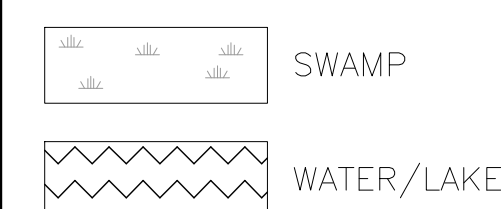

REDUCED DRAWING FOR
INFORMATION ONLY

SCALE IS REPRESENTATIVE
OF FULL SIZE DRAWING.

1	30 OCT 09	RELEASE FOR NUNAVUT W.B.		M.J.	
No.	DATE	REVISION	RÉVISION	DRN.	APPR.

SITE RECORD DRAWING



SCALE - ÉCHELLE

1 : 10000

PROJECT - PROJET

LONG RANGE RADAR SITE

DYE-M

CAPE DYER

TRADE - MÉTIER

CITING

NUNAVU

DATE _____

SUBJECT - SUJET

TOPOGRAPHIC SITE MAP

PRODUCTION		CONCURRENCE — ASSÉNTIMENT	
DESIGNÉ ÉTUDIÉ	W. W.	FIRE MARSHAL	PRÉVOT DU SERVICE DES INCENDIES
DRAWN DESSINÉ	M. J.		
CHECKED VÉRIFIÉ	B. T.	NWISO ENGINEERING OFFICER	OFFICIER DU GENIE BSAN
COORDINATION		NWISO FACILITIES ENGINEER	GENIE DES INSTALLATIONS BSAN
DWG. NO. — DESSIN NO.			
SK-15			

Canada