


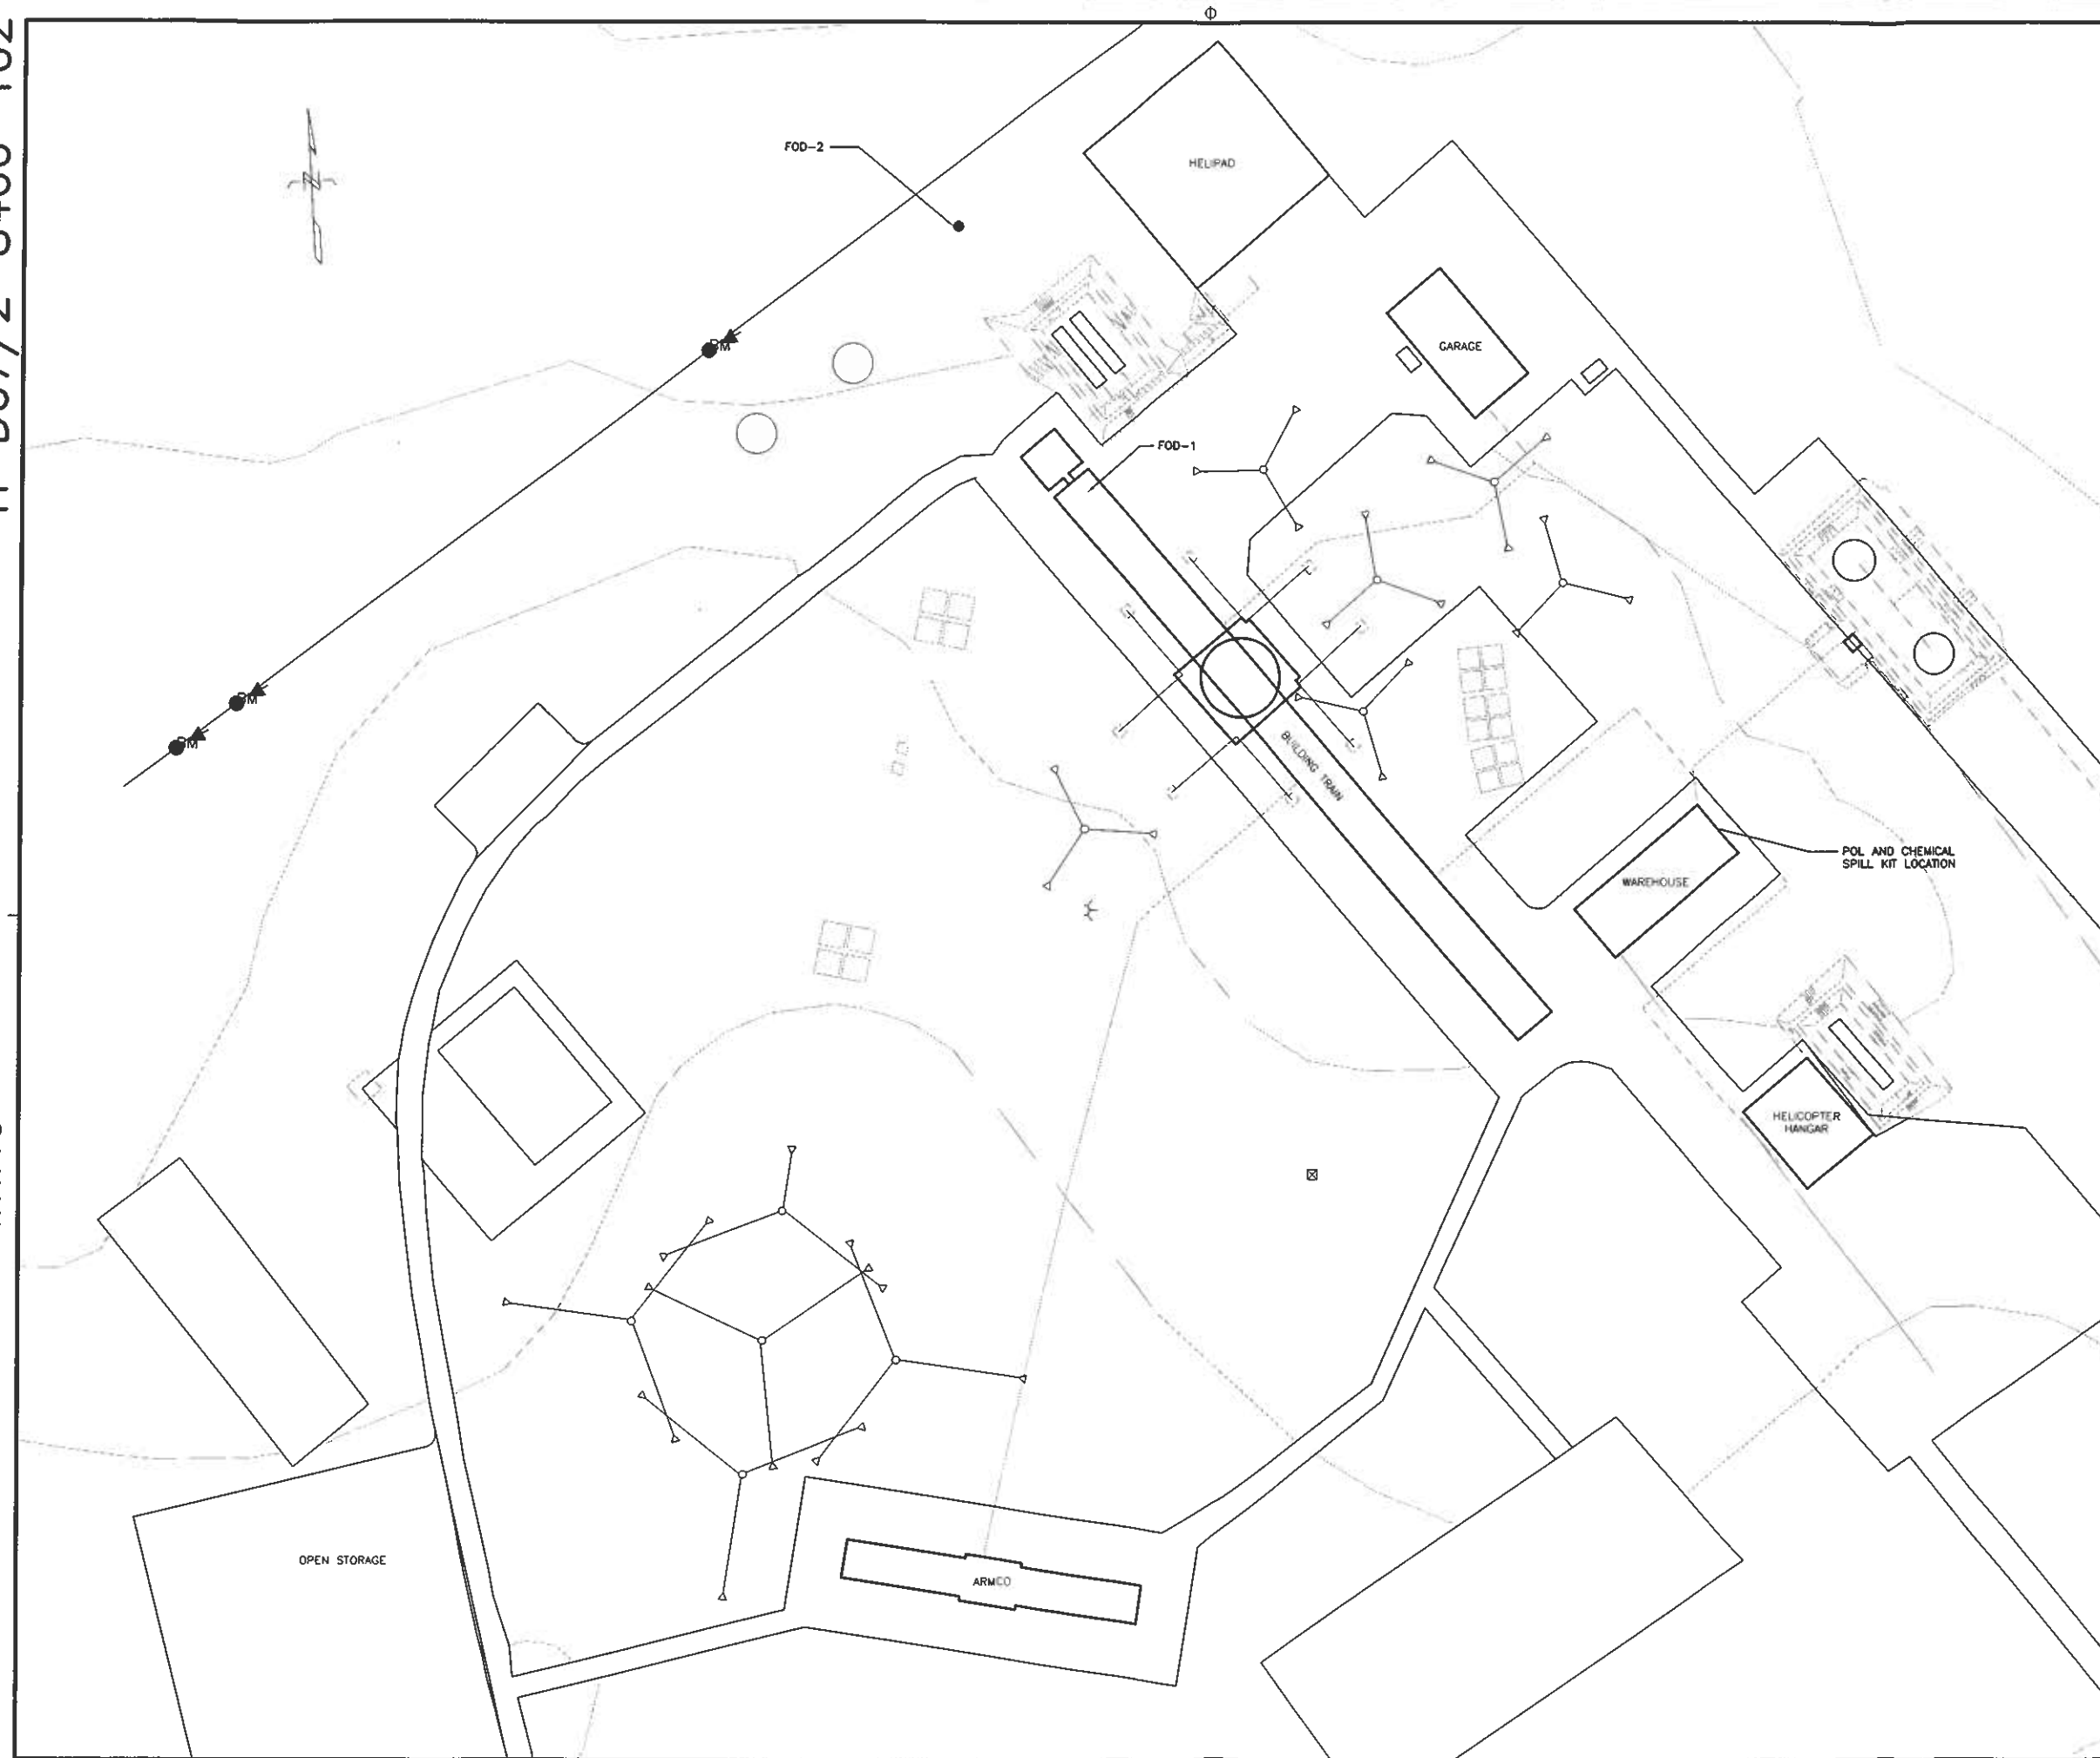

		National Défense		Défense nationale	
NORTH WARNING SYSTEM OFFICE Bureau du système d'alerte du Nord					
LOCATION 					
 100-170 LAURIER AVE. WEST OTTAWA, ONTARIO K1P 5V5 TEL: (81) 294-8032 FAX: (81) 294-3888					
NOTES: 1. CONTOURS ARE IN METERS.					
REDUCED DRAWING FOR INFORMATION ONLY SCALE IS REPRESENTATIVE OF FULL SIZE DRAWING.					
NO.	DATE	REVISION	REVISION	DRN	APPR
SITE RECORD DRAWING					
10 0 10 20 30 40 metres mètres					
SCALE - ÉCHELLE 1:500					
PROJECT - PROJET CM-66431					
LONG RANGE RADAR SITE					
FOX-3					
DEWAR LAKES		NUNAVUT			
TRADE - MÉTIER		SITING		DATE 06 MAR 02	
SUBJECT - SUJET SUMMIT AREA PLAN					
PRODUCTION		CONCURRENCE - ASSÉNTIMENT			
DESIGNED ÉTUDE	FIRE MARSHAL	PRÉVOYÉ DU SERVICE DES INCENDIES			
DRAWN DESSINÉ	F.P.				
CHECKED VÉRIFIÉ	T.R.	OFFICER DU GÉNIE BSAN			
COORDINATION	ENGINEERING OFFICER	GÉNIE DES INSTALLATIONS BSAN			
DWG. NO. - DESSIN NO. H-D67/2-8400-102					
Canada					