



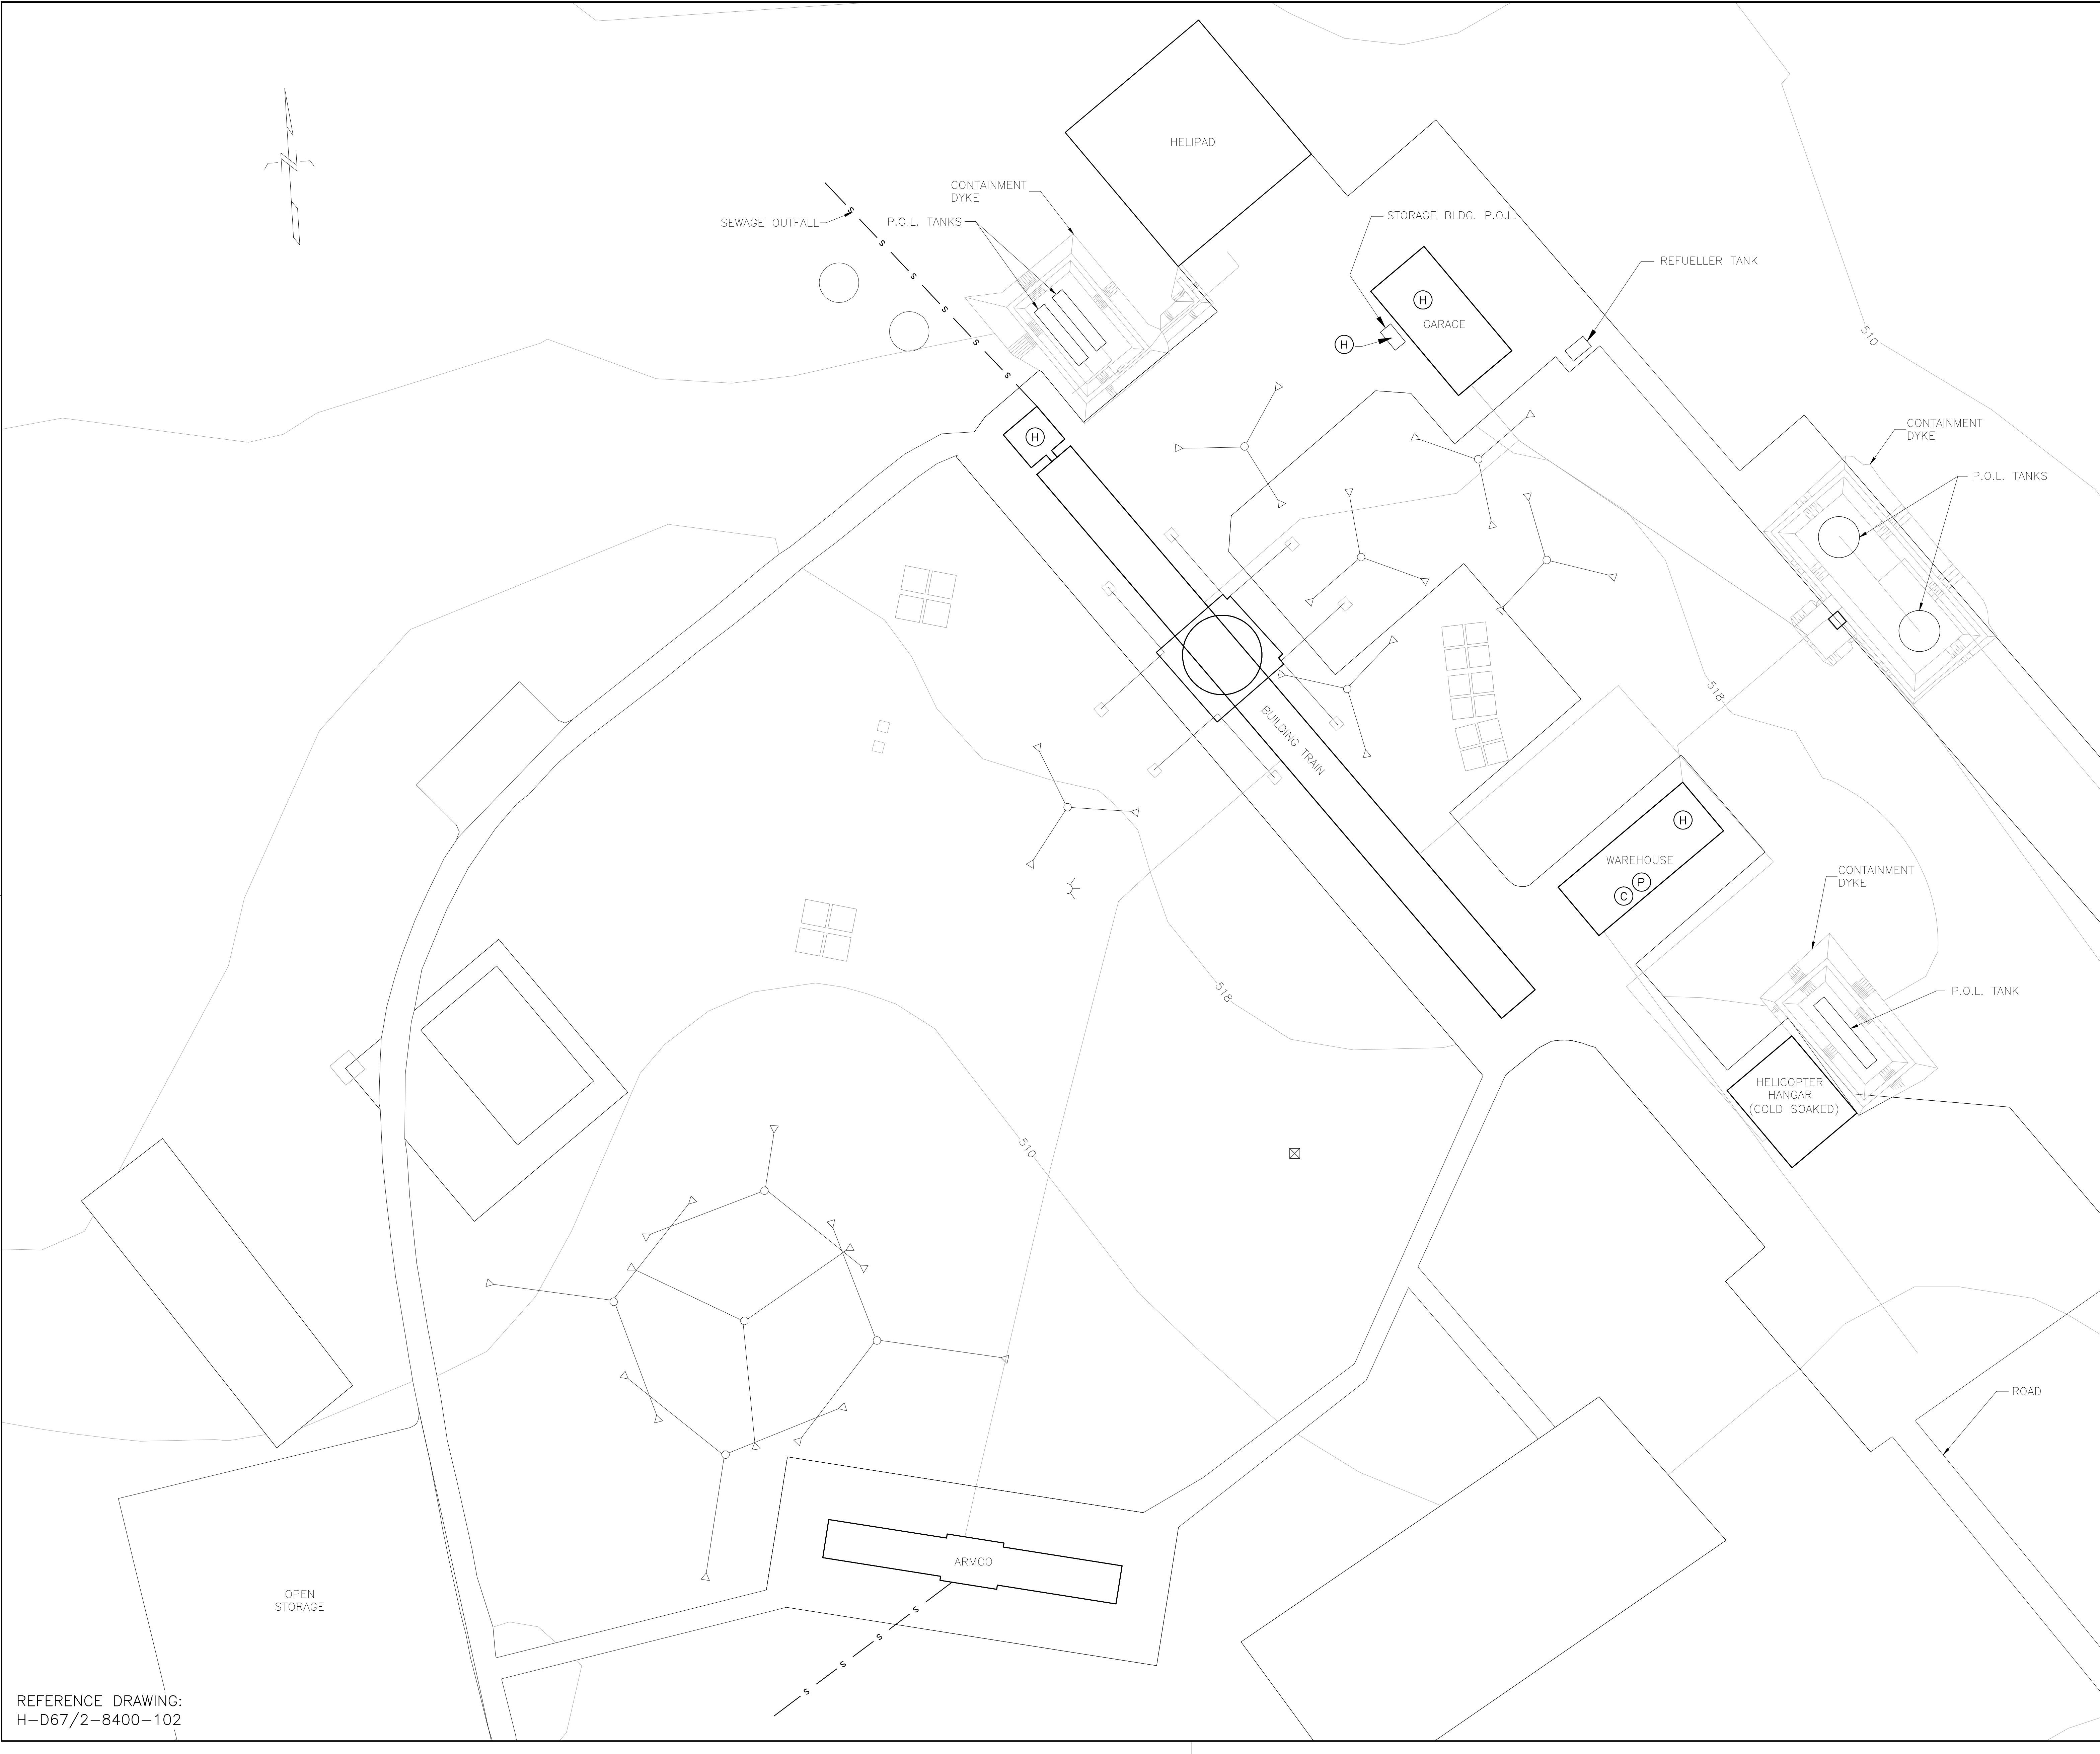

REFERENCE DRAWING:  
H-D67/2-8400-102

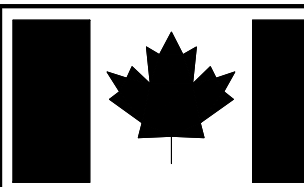

National  
Defence



D fense  
nationale

NORTH WARNING SYSTEM OFFICE  
Bureau du syst me d'alerte du Nord

LOCATION



FOX-3



100-170 LAURIER AVE. WEST  
OTTAWA, ONTARIO K1P 5V6  
TEL.: (613) 234-9033  
FAX: (613) 234-3888

NOTES:

1. CONTOURS ARE IN METERS.

LEGEND:

P.O.L.

s

SEWAGE LINE

C

CHEMICAL SPILL KIT

H

HAZMAT STORAGE AREA

P

P.O.L. SPILL KIT

REDUCED DRAWING FOR  
INFORMATION ONLY

SCALE IS REPRESENTATIVE  
OF FULL SIZE DRAWING.

|     |           |                          |          |      |       |
|-----|-----------|--------------------------|----------|------|-------|
| 1   | 30 OCT 09 | RELEASE FOR NUNAVUT W.B. | M.J.     |      |       |
| No. | DATE      | REVISION                 | R VISION | DRN. | APPR. |

SITE RECORD DRAWING

1000metresmetres

SCALE -  CHELLE

1 : 500

PROJECT - PROJET

LONG RANGE RADAR SITE

FOX-3

DEWAR LAKES

TRADE - M TIER

SITING

NUNAVUT

DATE

30 OCT 09

SUBJECT - SUJET

TOPOGRAPHIC SITE MAP  
SUMMIT AREA  
HAZMAT STORAGE & SPILL KIT LOCATIONS

|                                |                           |                                                       |
|--------------------------------|---------------------------|-------------------------------------------------------|
| PRODUCTION                     | CONCURRENCE - ASSENTIMENT |                                                       |
| DESIGNED<br> TUDI              | W.W.                      | FIRE MARSHAL<br>PR V T DU SERVICE DES<br>ING NIEURS   |
| DRAWN<br>DESSIN                | M.J.                      |                                                       |
| CHECKED<br>V RIFI              | B.T.                      | NWSO ENGINEERING OFFICER<br>OFFICIER DU G NIE<br>BSAN |
| COORDINATION                   | NWSO FACILITIES ENGINEER  | G NIE DES<br>INSTALLATIONS<br>BSAN                    |
| DWG. NO. - DESSIN NO.<br>SK-12 |                           |                                                       |

