


H-H11/2-8400-101

FOX-M

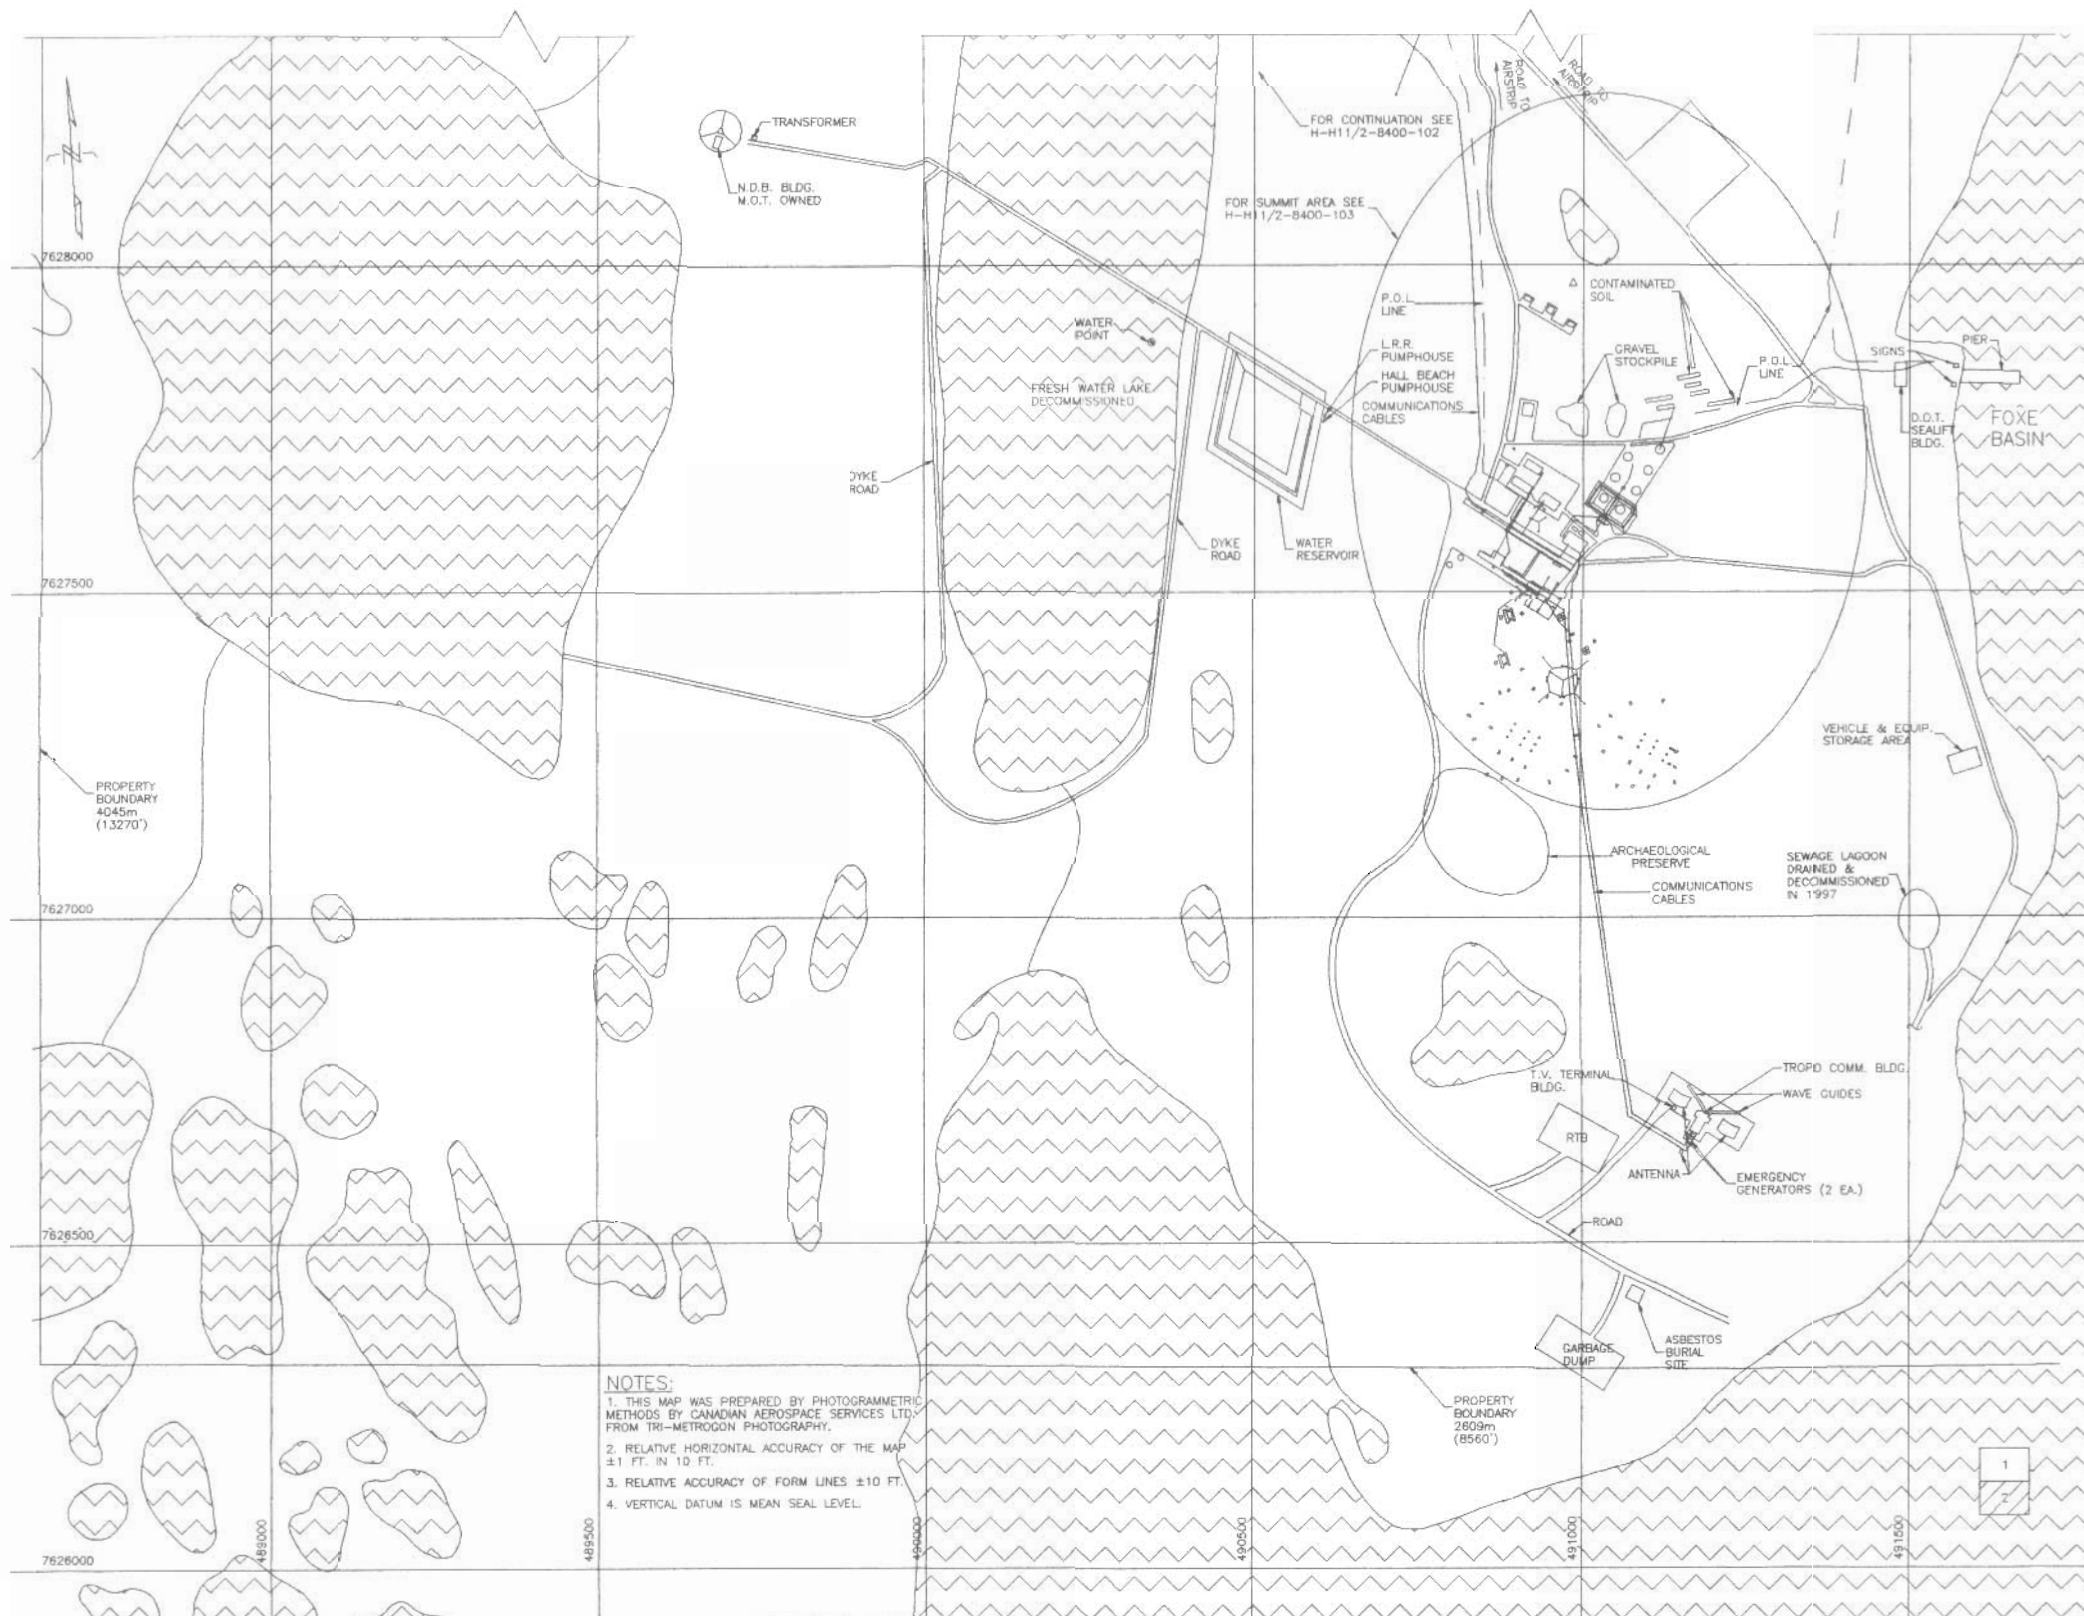

- NOTES:**
1. THIS MAP WAS PREPARED BY PHOTOGRAMMETRIC METHODS BY CANADIAN AEROSPACE SERVICES LTD. FROM TRI-METRODON PHOTOGRAPHY.
 2. RELATIVE HORIZONTAL ACCURACY OF THE MAP ± 1 FT. IN 10 FT.
 3. RELATIVE ACCURACY OF FORM LINES ± 10 FT.
 4. VERTICAL DATUM IS MEAN SEAL LEVEL.



NORTH WARNING SYSTEM OFFICE
Bureau du système d'alerte du Nord



ATCO Frontec
100-170 LAUREN AVENUE, WEST
OTTAWA, ONTARIO K1P 8V8
TEL: (877) 384-6883
FAX: (877) 384-6885

NOTES:

LEGEND:

WATER/LAKE

REDUCED DRAWING FOR
INFORMATION ONLY
SCALE IS REPRESENTATIVE
OF FULL SIZE DRAWING.

No.	DATE	REVISION	REVISION	DRN APPR.

SITE RECORD DRAWING

80 0 80 160 240 320 metres

SCALE - ÉCHELLE

1 : 4000

PROJECT - PROJET
CM-66431

LONG RANGE RADAR SITE

FOX-M

HALL BEACH NUNAVUT

TRADE - MÉTIER SITING DATE 29 APR 02

SUBJECT - SUJET

SITE PLAN

PRODUCTION	CONCURRENCE - ASSESSMENT
DESIGNED ÉTUDE	FIRE MARSHAL
DRAWN DESSIN	K.R.
CHECKED VÉRIFIÉ	T.R.
COORDINATION	INVESTIGATING OFFICER
	OFFICER DU GÉNIE
	GENIE DES INSTALLATIONS
	DWG NO. - DESSIN NO. H-H11/2-8400-101

Canada

W-X□□



ATCO Frontec
100-170 LAURIER AVE. WEST
OTTAWA, ONTARIO K1P 1N5
TEL: (613) 234-6553
FAX: (613) 234-6555

NOTES:

1. CONTOURS ARE IN FEET.

LEGEND:

 WATER/LAKE

REDUCED DRAWING FOR
INFORMATION ONLY

SCALE IS REPRESENTATIVE
OF FULL SIZE DRAWING.

NO.	DATE	REVISION	REVISION	DRN APPR



1 : 1000


PROJECT - PROJECT	CM-66431	LONG RANGE RADAR SITE
-------------------	----------	-----------------------

FOX-M

HALL BEACH	NUNAVUT
TRADE-METIER	DATE 29 APR 02
SITING	
SUBJECT - SUJET	

SUMMIT
AREA PLAN[illegible]

Canada H-111/2-8400-103

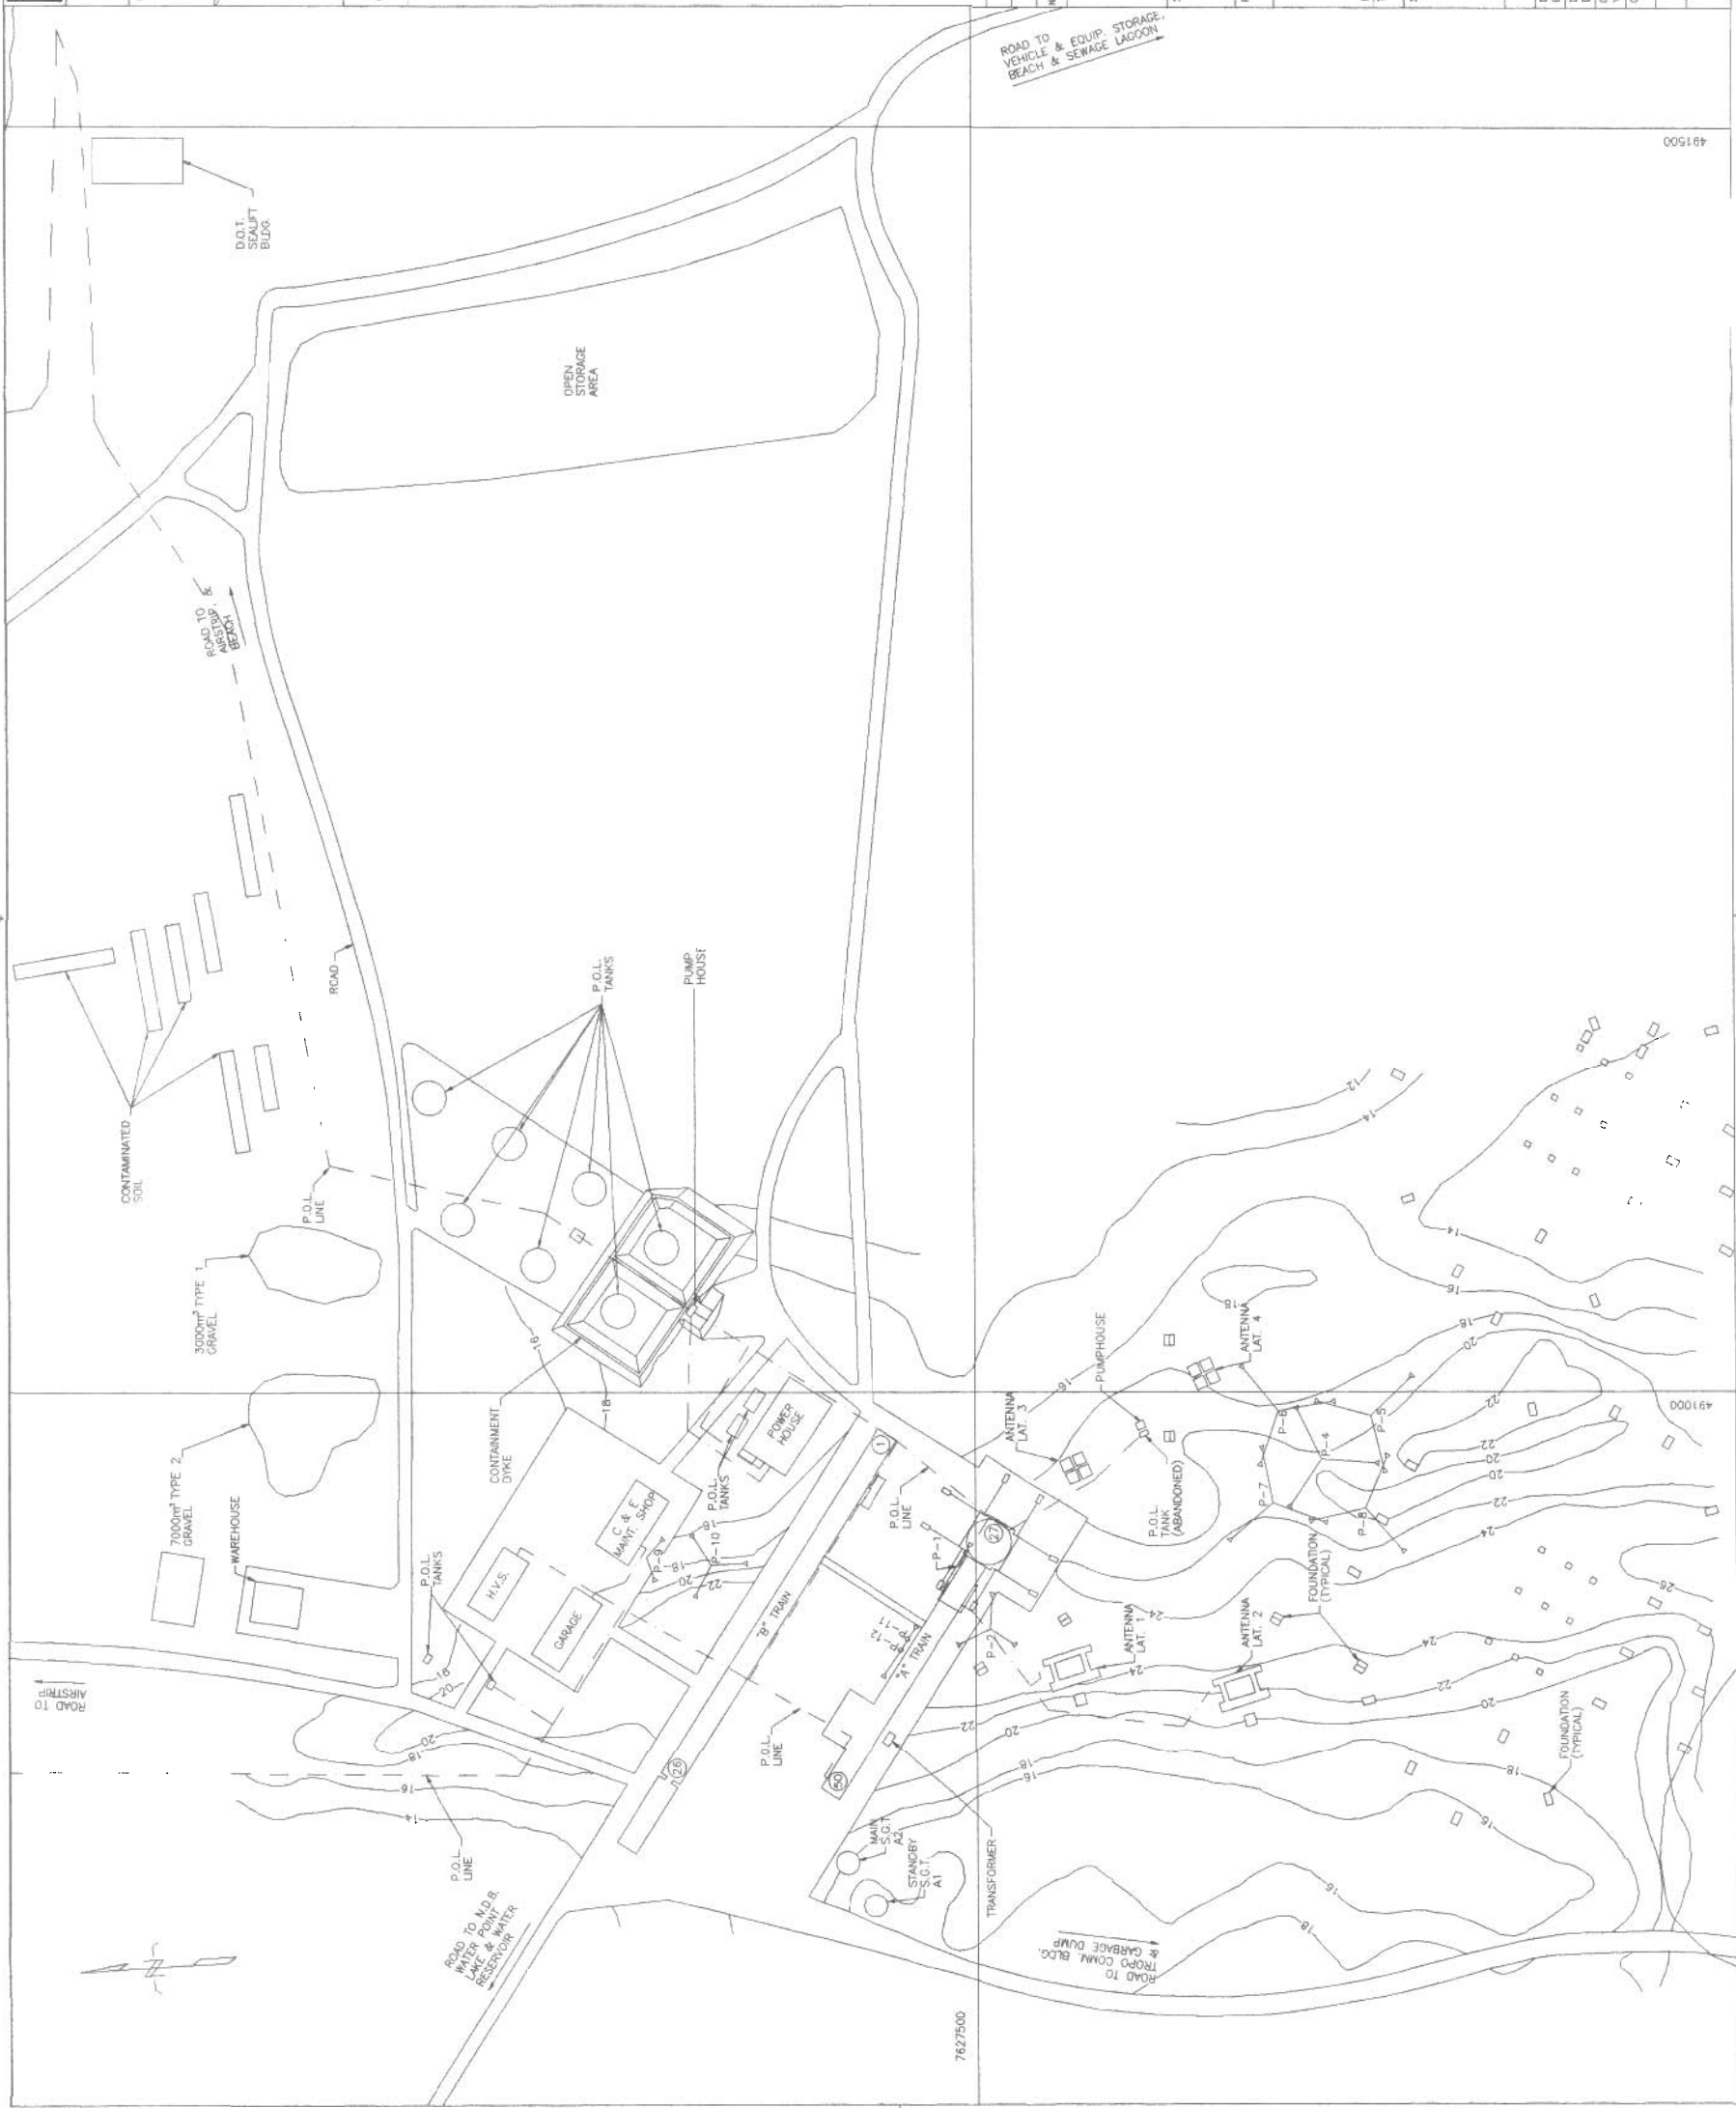

THIS DRAWING DEVELOPED FROM GIS MODEL H-H11/2-9300-102