




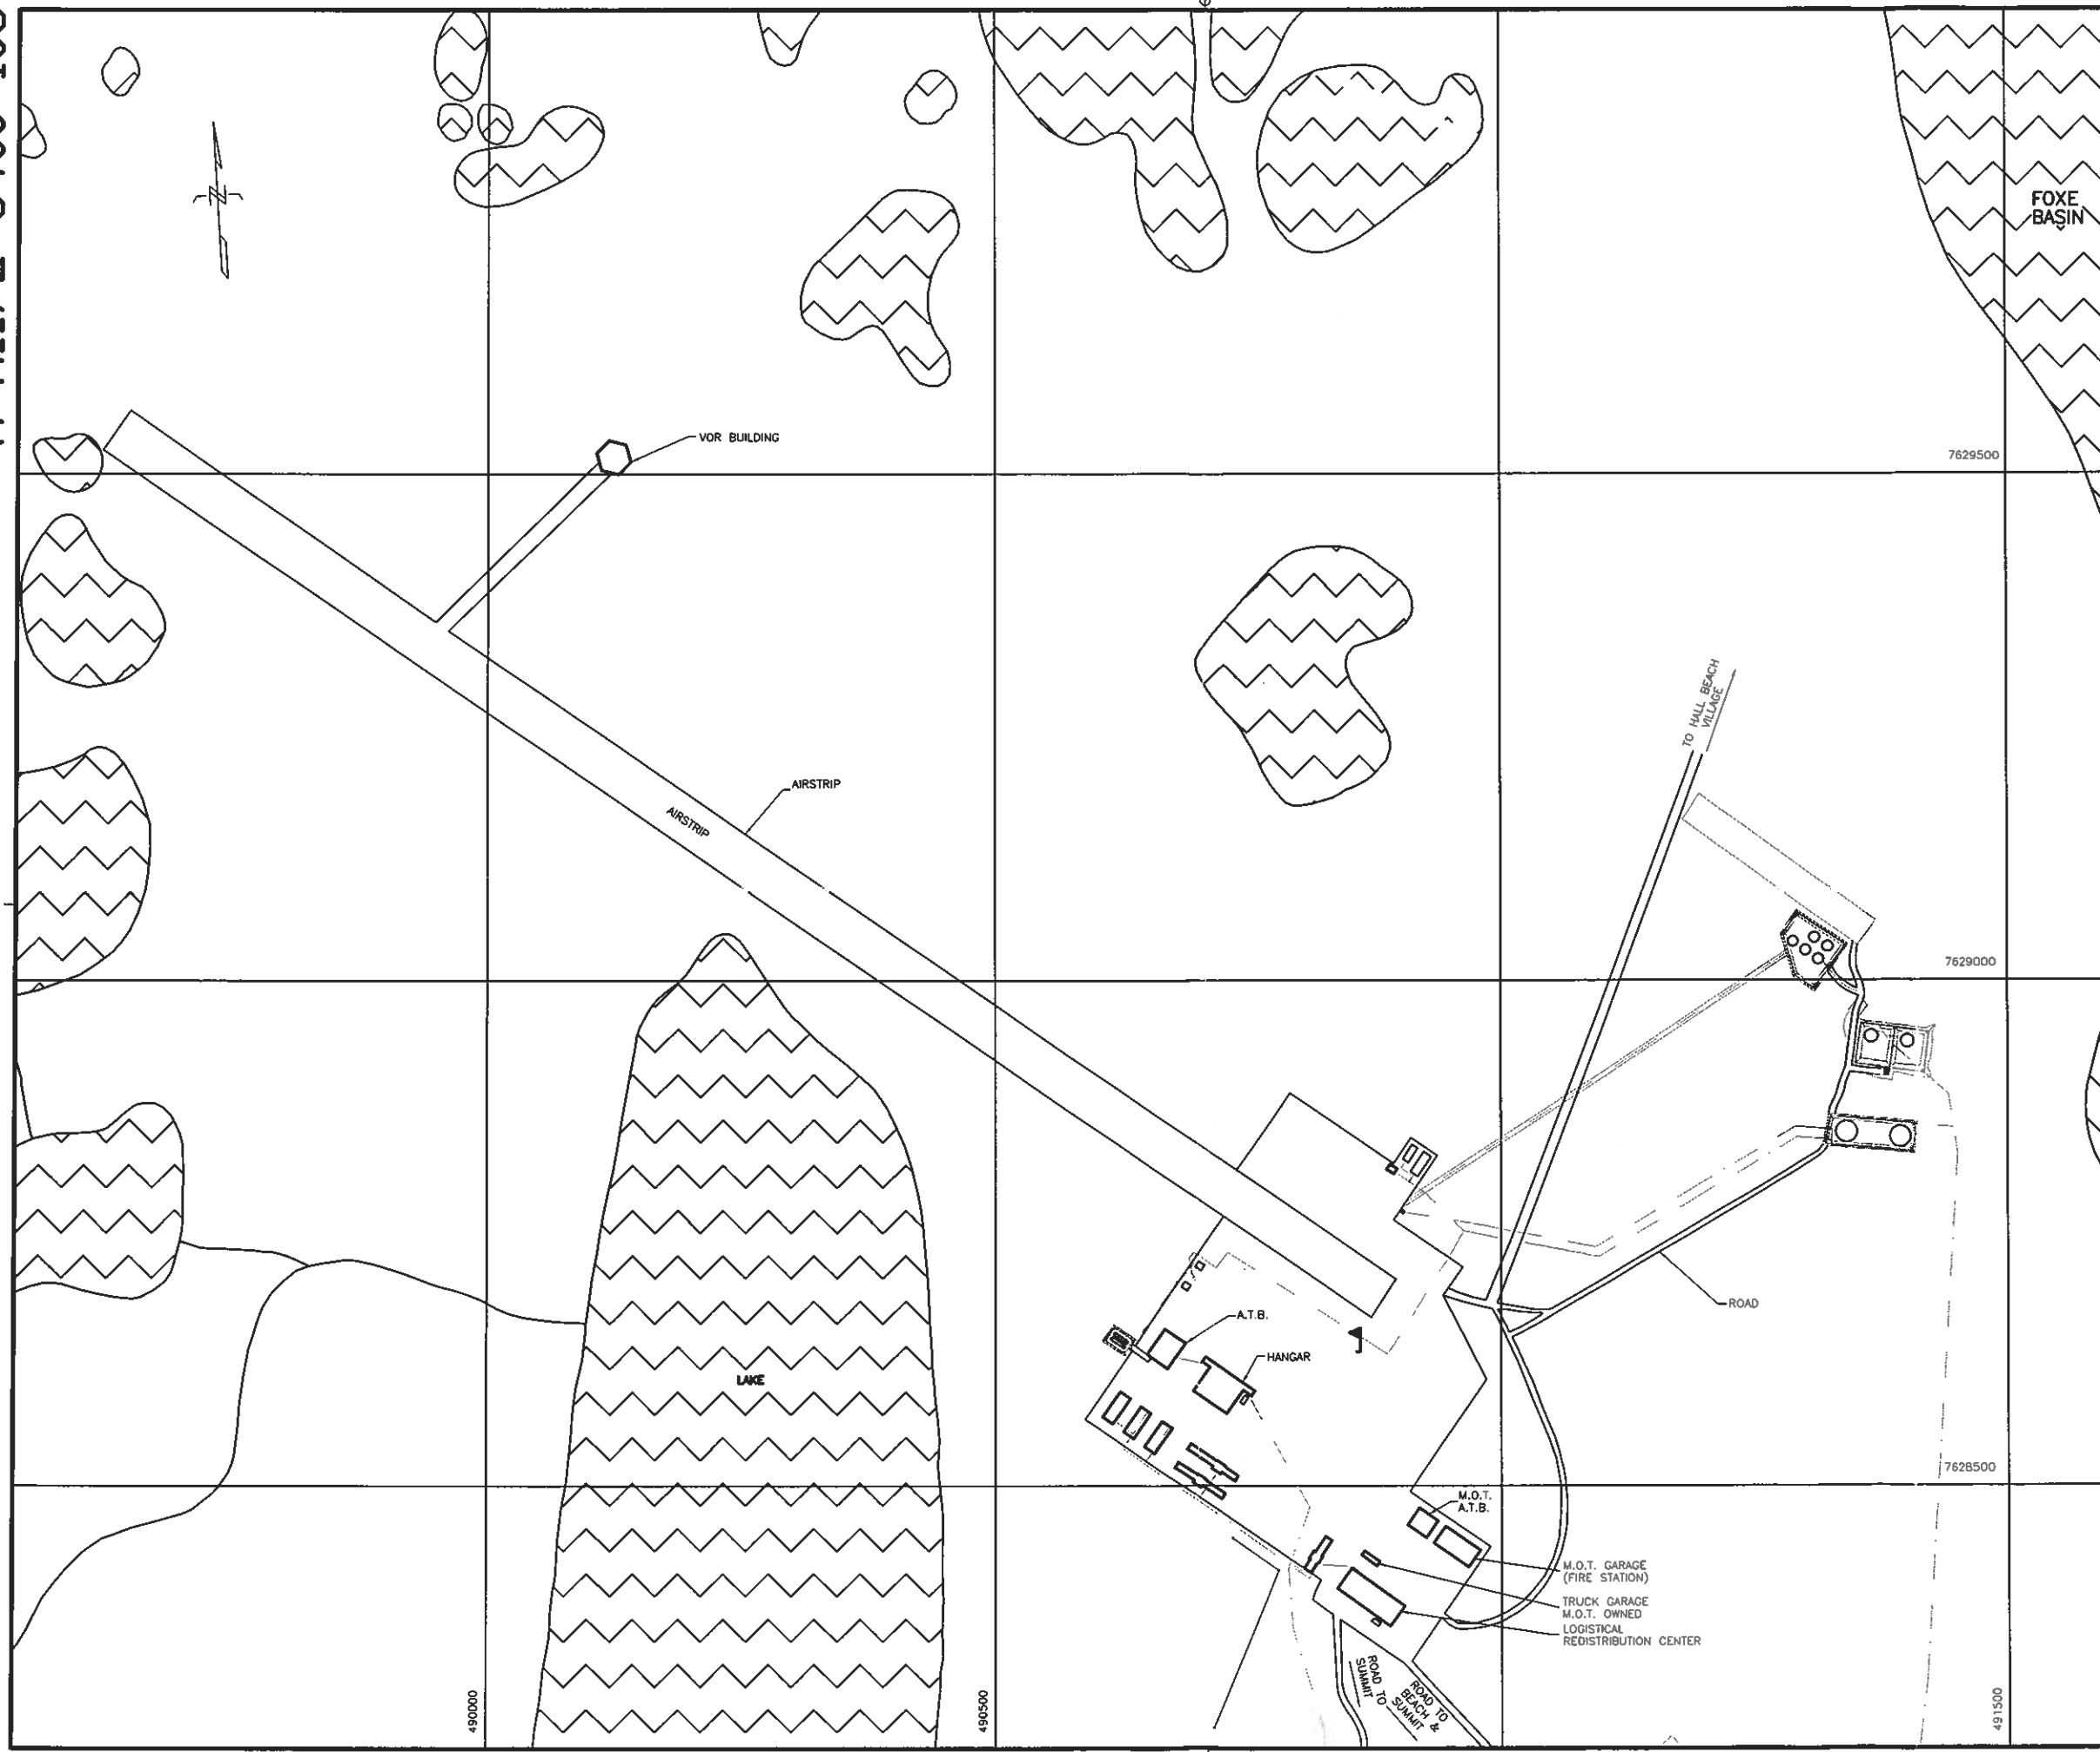

National Défense
Defence nationale

NORTH WARNING SYSTEM OFFICE
Bureau du système d'alerte du Nord

LOCATION



FOX-M

NASITTUQ

100-170 LAURIER AVE WEST
OTTAWA, ONTARIO K1P 5V5
TEL: (613) 234-9003
FAX: (613) 234-2088

NOTES:

LEGEND:

 LAKE

REDUCED DRAWING FOR
INFORMATION ONLY

SCALE IS REPRESENTATIVE
OF FULL SIZE DRAWING.

5	30 MAY 08	REV AS PER ENG. REVIEW	J.G.	
4	15 MAY 08	REV AS PER ENG. REVIEW	J.G.	
3	18 OCT 07	REV AS PER XL-38363	J.G.	
2	13 SEPT 04	AS PER LOCID CORRECTION	K.R.	
1	24 NOV 03	REVISED AS PER REDLINES	F.P.	

No.	DATE	REVISION	REVISION	DRN	APPR
-----	------	----------	----------	-----	------

SITE RECORD DRAWING

50 0 50 100 150 200 metres
SCALE - ÉCHELLE

1 : 2500

PROJECT - PROJET
CM-66431

LONG RANGE RADAR SITE

FOX-M

HALL BEACH
TRADE - MÉTIER
SITING

NUNAVUT
DATE
29 APR 02

SUBJECT - SUJET
AIRSTRI
LOCID PLAN

PRODUCTION	CONCURRENCE - ASSENTIMENT
DESIGNED ÉTUDE K.R.	FIRE MARSHAL PRÉVOT DU SERVICE DES INCENDIES
DRAWN DESSINÉ K.R.	
CHECKED VÉRIFIÉ T.R.	NVSD ENGINEERING OFFICER OFFICIER DU GENIE
COORDINATION	NVSD FACILITIES ENGINEER GENIE DES INSTALLATIONS

DWG. NO. - DESSIN NO.
H-H11/2-8400-106

Canada