


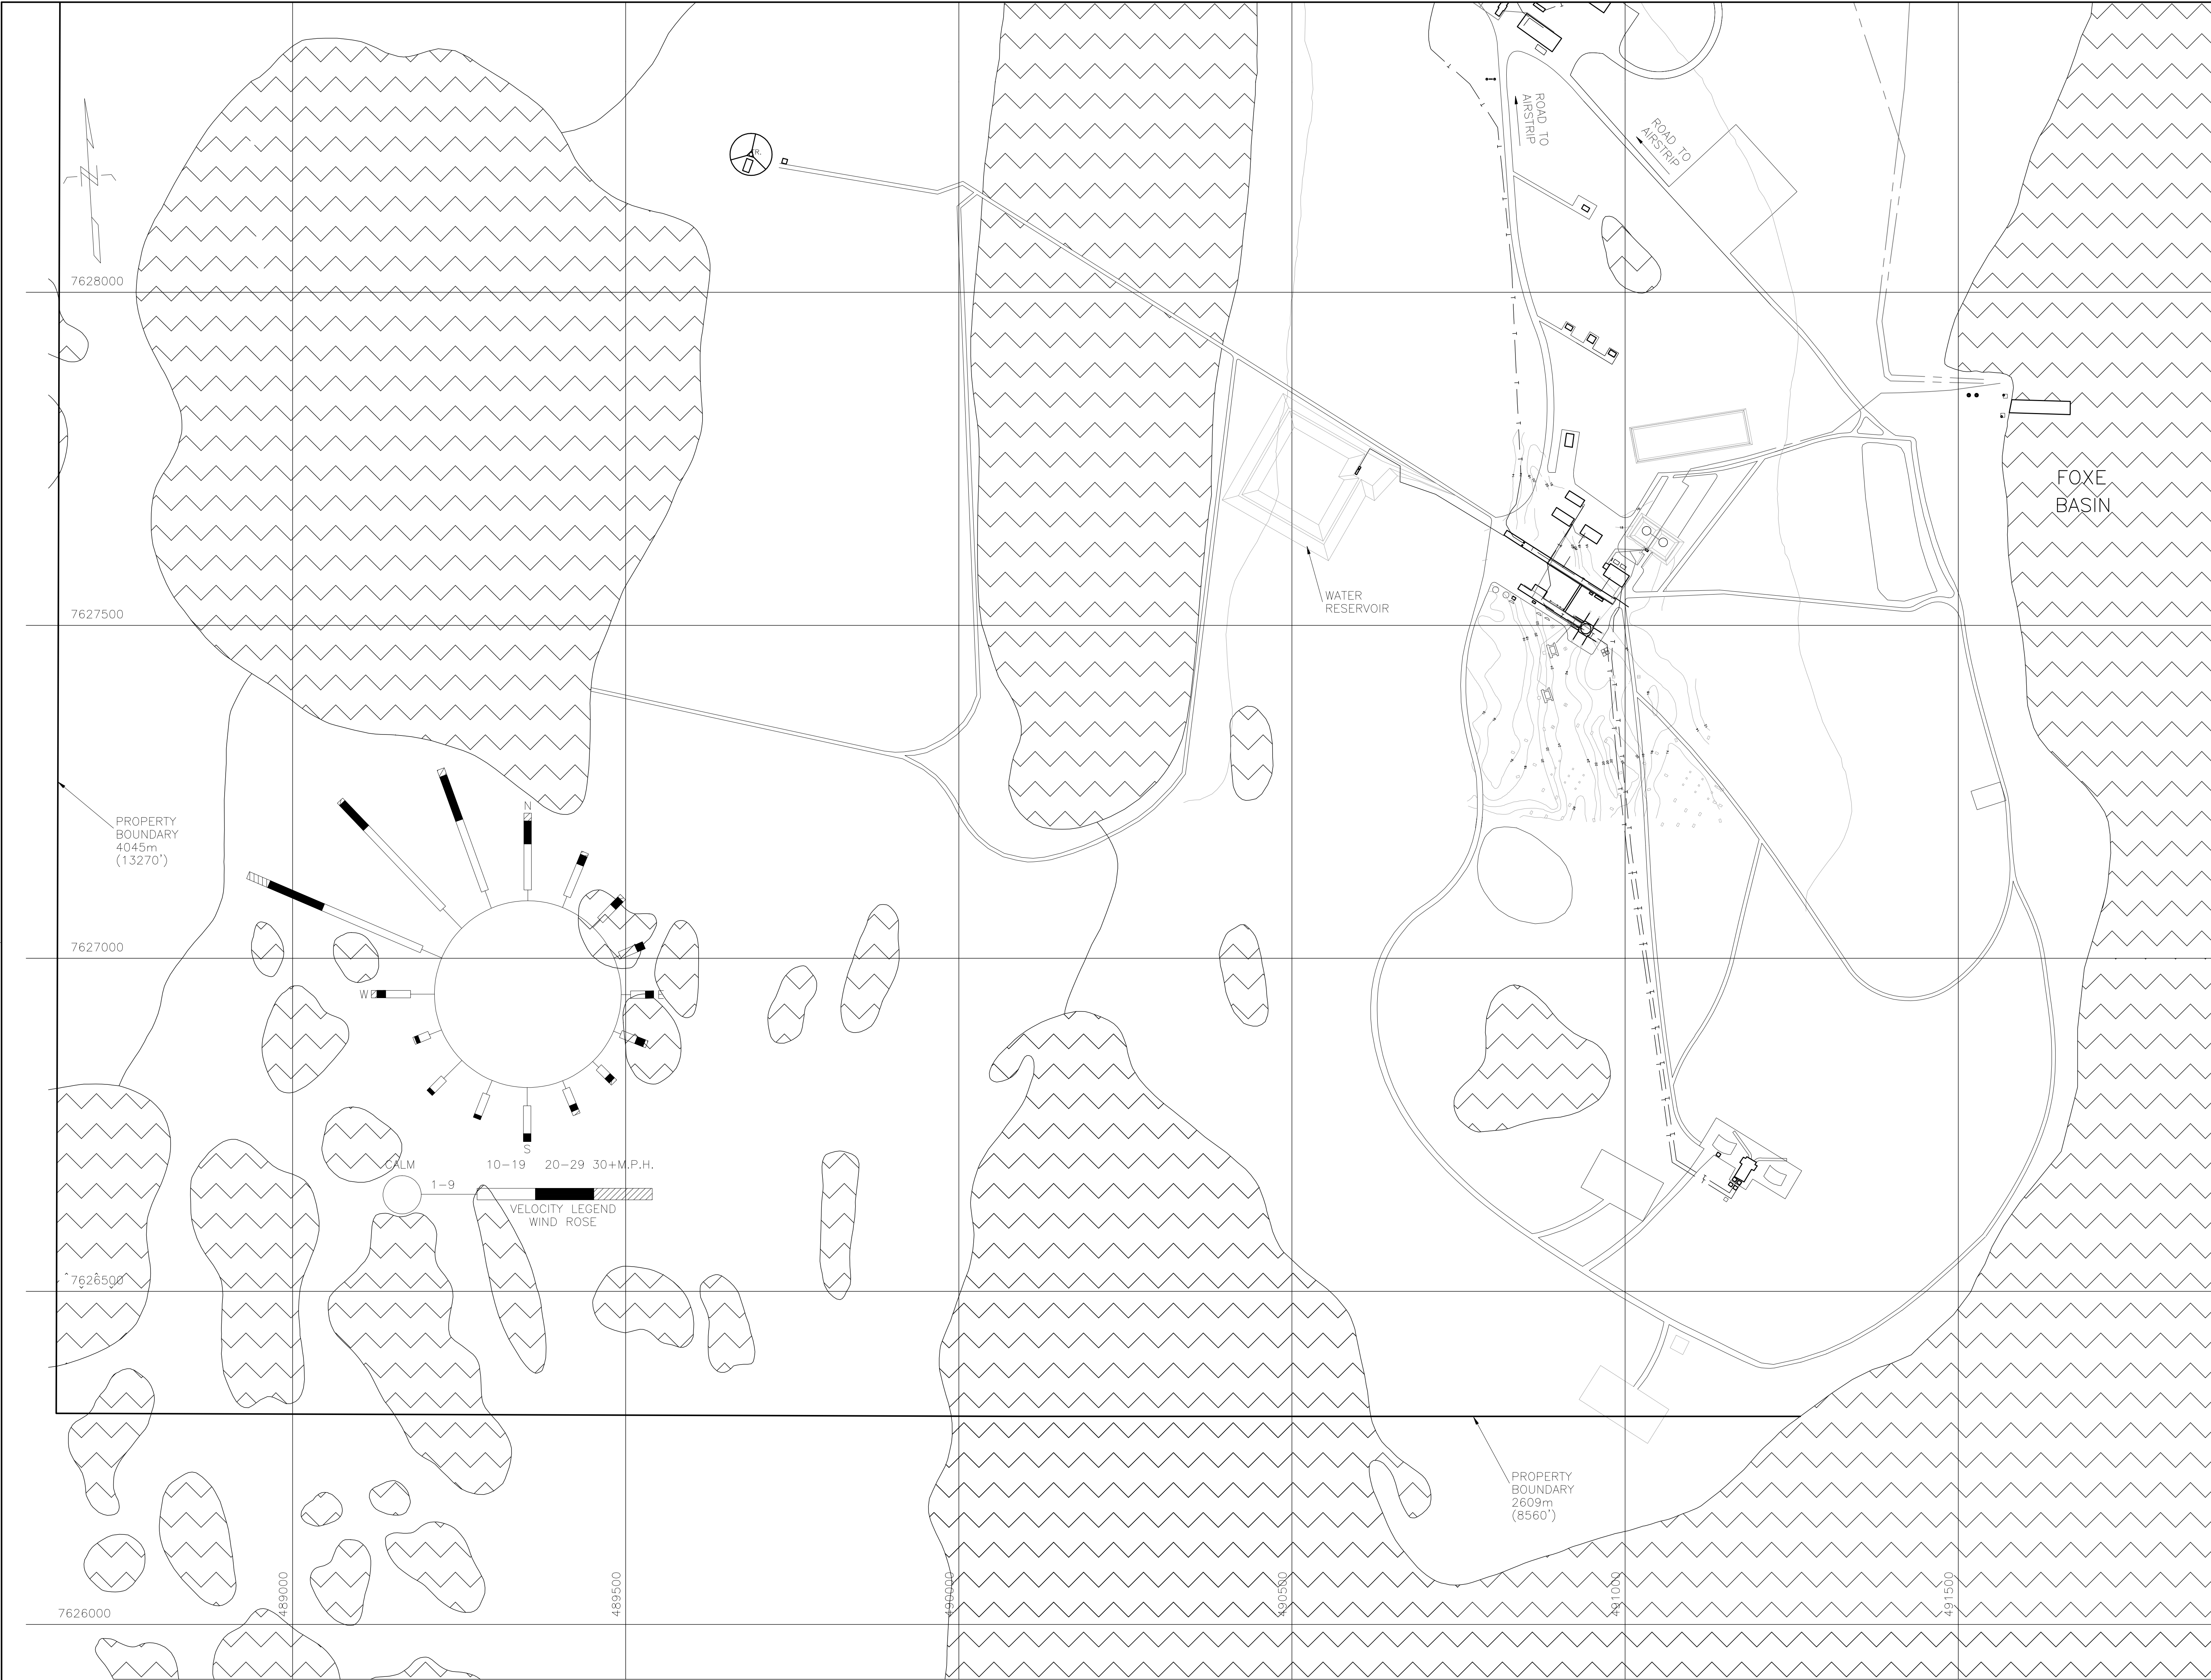

REFERENCE DRAWING:
H-H11/2-8400-101

National
Defence

Défense
nationale

NORTH WARNING SYSTEM OFFICE
Bureau du système d'alerte du Nord

LOCATION

100-170 LAURIER AVE. WEST
OTTAWA, ONTARIO K1P 5V6
TEL.: (613) 234-9033
FAX: (613) 234-3888

NOTES:

1. THIS MAP WAS PREPARED BY PHOTOGRAMMETRIC METHODS BY CANADIAN AEROSPACE SERVICES LTD. FROM TRI-METROGON PHOTOGRAPHY.

2. RELATIVE HORIZONTAL ACCURACY OF THE MAP ±1 FT. IN 10 FT.

3. RELATIVE ACCURACY OF FORM LINES ±10 FT.

4. VERTICAL DATUM IS MEAN SEAL LEVEL.

LEGEND:

WATER/LAKE

P.O.L.

TELEPHONE

WATER LINE

GRAVEL ROADWAY

REDUCED DRAWING FOR
INFORMATION ONLY

SCALE IS REPRESENTATIVE
OF FULL SIZE DRAWING.

1	30 OCT 09	RELEASE FOR NUNAVUT W.B. M.J.		
No.	DATE	REVISION	REVISION	DRN. APPR.
SITE RECORD DRAWING				
80000 0 80 160 240 320 metres mètres SCALE - ÉCHELLE 1 : 4000				
PROJECT - PROJET				
LONG RANGE RADAR SITE				
FOX-M				
HALL BEACH				NUNAVUT
TRADE - MÉTIER		SITING	DATE	30 OCT 09
SUBJECT - SUJET				
TOPOGRAPHIC SITE MAP				
PRODUCTION		CONCURRENCE - ASSENTMENT		
DESIGNED ÉTUDIÉ	W.W.	FIRE MARSHAL	PRÉVÔT DU SERVICE DES INCENDIES	
DRAWN DESSINÉ	M.J.			
CHECKED VÉRIFIÉ	B.T.	NWSO ENGINEERING OFFICER	OFFICIER DU GÉNIE BSAN	
COORDINATION		NWSO FACILITIES ENGINEER	GÉNIE DES INSTALLATIONS BSAN	
DWG. NO. - DESSIN NO. SK-08				

Canada