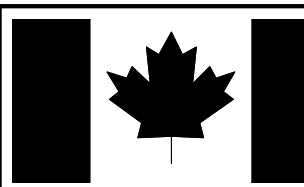


SK-09

FOX-M



REFERENCE DRAWING:
H-H11/2-8400-104



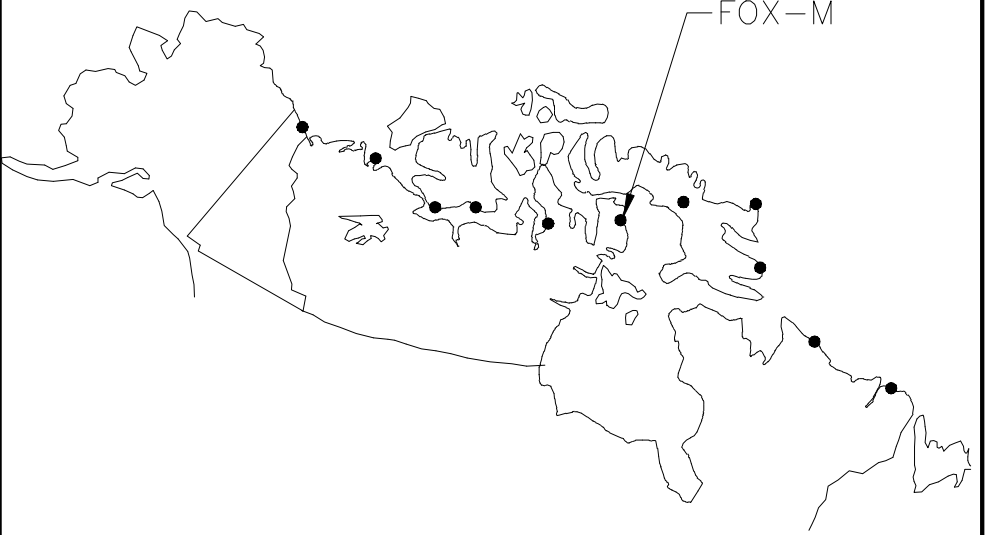
National
Defence



D fense
nationale

NORTH WARNING SYSTEM OFFICE
Bureau du syst me d'alerte du Nord

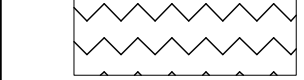
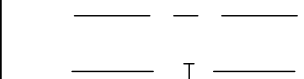
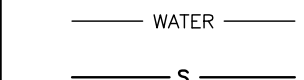
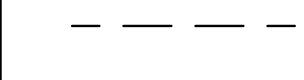
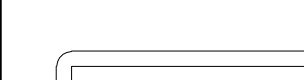
LOCATION





100-170 LAURIER AVE. WEST
OTTAWA, ONTARIO K1P 5V6
TEL.: (613) 234-9033
FAX: (613) 234-3888

NOTES:
1. CONTOURS ARE IN FEET.

LEGEND:
 WATER/LAKE
 P.O.L.
 TELEPHONE
 WATER LINE
 SEWAGE LINE
 ELECTRICAL
 GRAVEL ROADWAY
 HAZMAT STORAGE AREA

REDUCED DRAWING FOR
INFORMATION ONLY

SCALE IS REPRESENTATIVE
OF FULL SIZE DRAWING.

1	30 OCT 09	RELEASE FOR NUNAVUT W.B.	M.J.		
No.	DATE	REVISION	R�VISION	DRN.	APPR.
SITE RECORD DRAWING					
					
SCALE - �CHELLE 1 : 2000					
PROJECT - PROJET LONG RANGE RADAR SITE FOX-M					
HALL BEACH TRADE - M�TIER		SITING		NUNAVUT DATE 30 OCT 09	
SUBJECT - SUJET TOPOGRAPHIC SITE MAP AIRSTRIP AREA HAZMAT STORAGE & SPILL KIT LOCATIONS					
PRODUCTION		CONCURRENCE - ASSENTIMENT			
DESIGNED �TUDI�	W.W.	FIRE MARSHAL		PR�V�T DU SERVICE DES ING�NIEURS	
DRAWN DESSIN�	M.J.				
CHECKED V�RIFI�	B.T.	NWSO ENGINEERING OFFICER		OFFICIER DU G�NIE BSAN	
COORDINATION		NWSO FACILITIES ENGINEER		G�NIE DES INSTALLATIONS BSAN	
DWG. NO. - DESSIN NO. SK-09					
					