


H-S123/1-8400-107

CAM-3



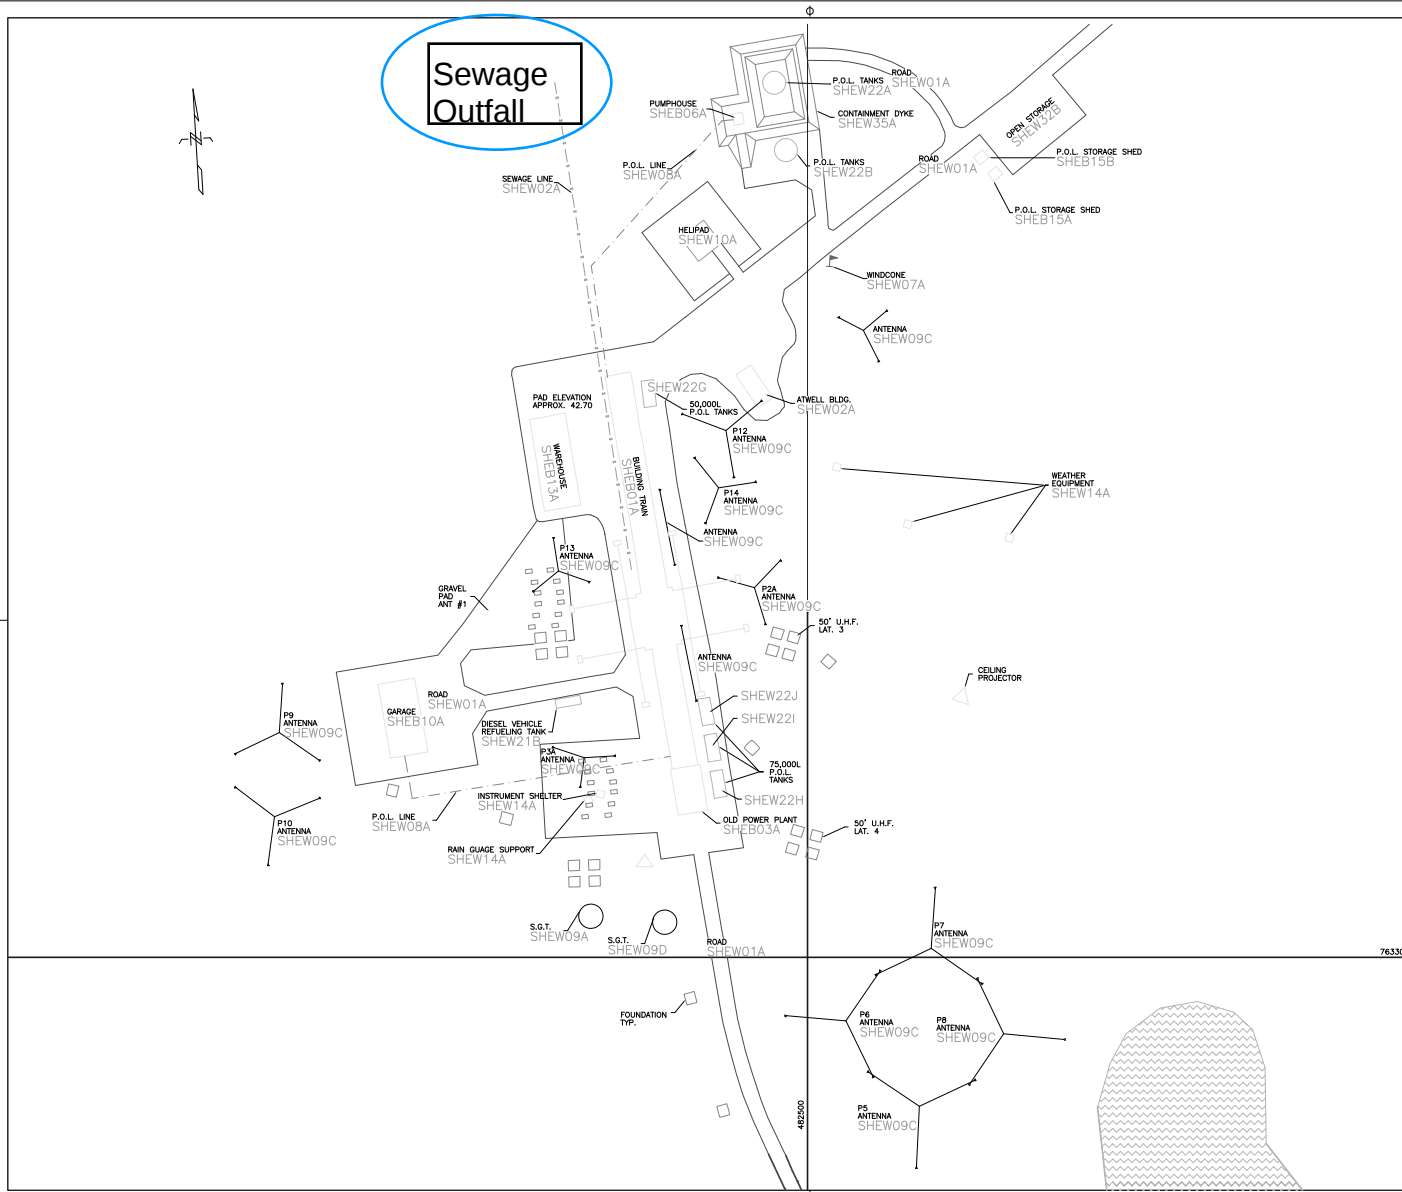

National
Defence

Défense
nationale

NORTH WARNING SYSTEM OFFICE
Bureau du système d'alerte du Nord

LOCATION



ATCO

300-570 LAUREN AVENUE WEST
OTTAWA, ONTARIO K1P 6P5
TEL: (613) 234-3888
FAX: (613) 234-3888

NOTES:

LEGEND:

— WATER

REDUCED DRAWING FOR
INFORMATION ONLY

SCALE IS REPRESENTATIVE
OF FULL SIZE DRAWING.

NO.	DATE	REVISION	REVISION	DRN	APPR.
SITE RECORD DRAWING					

20 0 20 40 60 80 metres
mètres

SCALE - ÉCHELLE

1 : 1000

PROJECT - PROJET

CM-66272

LONG RANGE RADAR SITE

CAM-3

SHEPHERD BAY NUNAVUT

TRADE - MÉTIER

SITING

DATE

21 JAN 02

SUBJECT - SUJET

SUMMIT
LOCID PLAN

PRODUCTION	CONCURRENCE - ASSESSMENT	
DESIGNED ÉTUDE	FIRE MARSHAL	PROJECT BY SERVICES DES INDUSTRIES
DRAWN DRESSINE	K.R.	
CHECKED VÉRIFIÉ	T.R.	OFFICER DU GÉNÉ RAT
COORDINATION	ENGINEER	GENERAL INSTALLATION TEAM
PAC NO - DESIGN NO H-S123/1-8400-107		

Canada