


CAM-3 SITE PLAN DRAWING

H-S123/1-8400-102



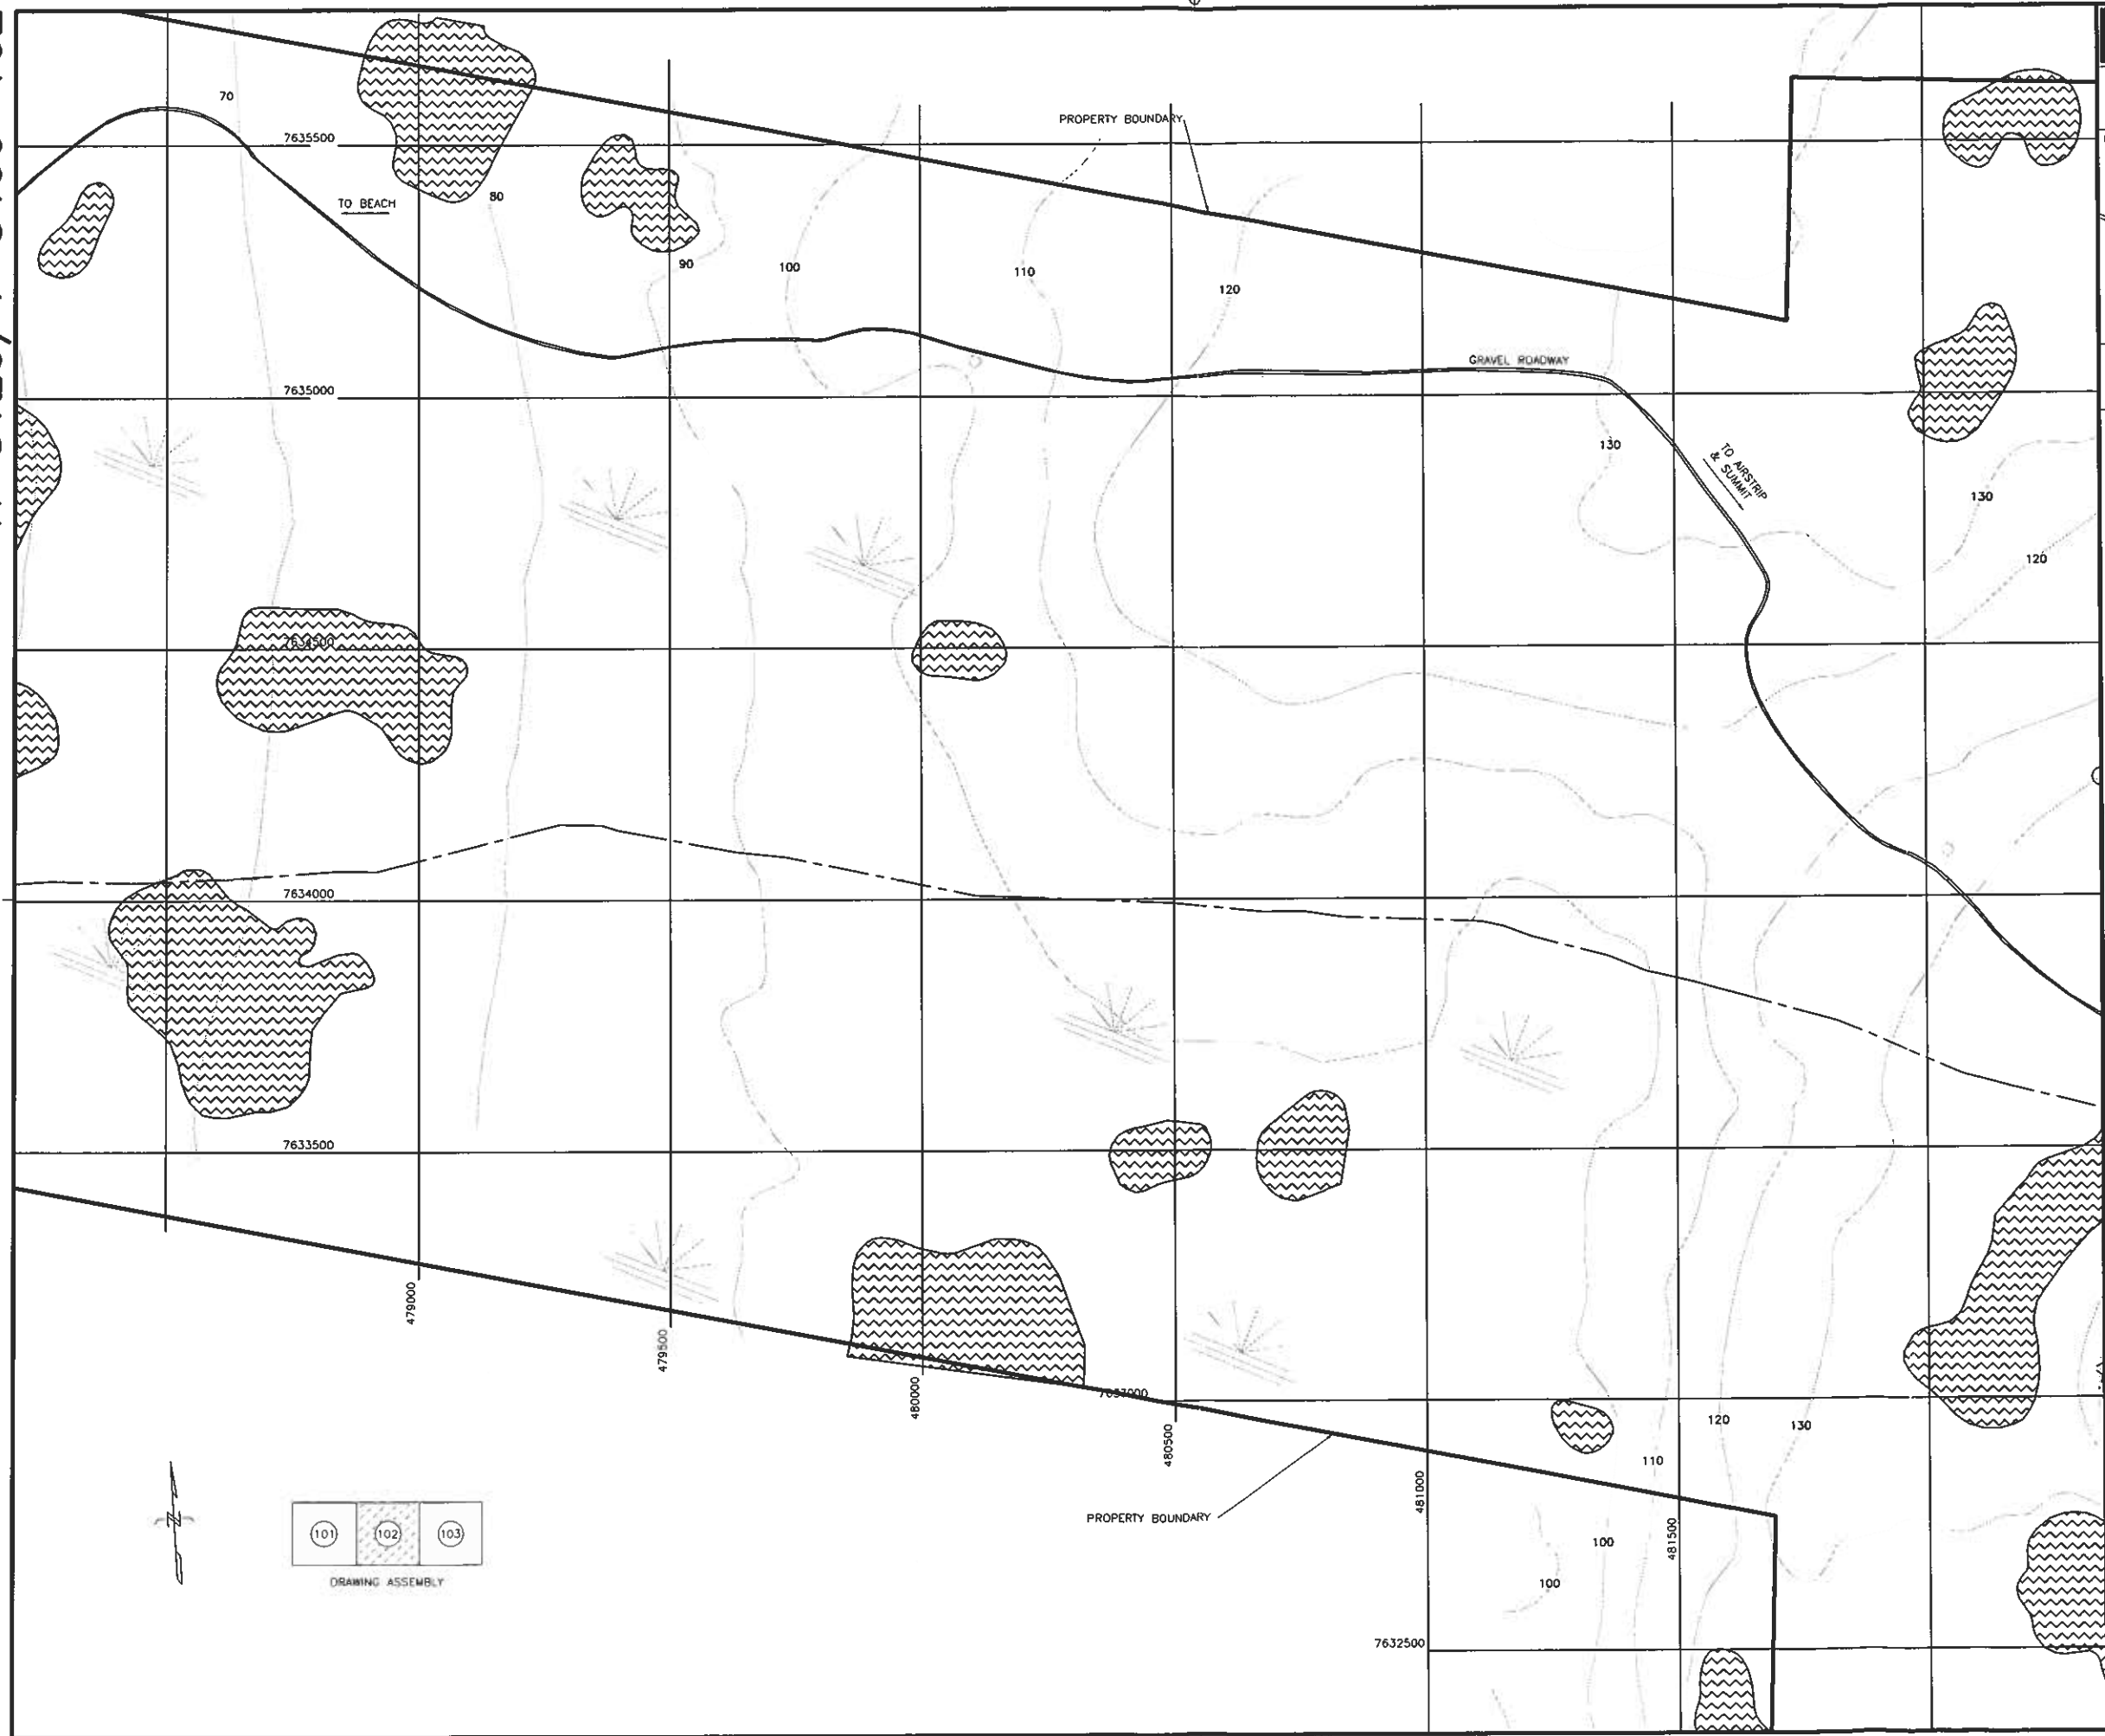

National
Défense

Défense
nationale

NORTH WARNING SYSTEM OFFICE
Bureau du système d'alerte du Nord

LOCATION





100-170 LAURIER AVE. WEST
OTTAWA, ONTARIO K1P 5Y5
TEL (613) 234-9033
FAX (613) 234-3088


NOTES:

1. NASITTUQ HAS CARE CUSTODY OF
ENTIRE PARCEL.

2. CONTOURS ARE IN FEET 

LEGEND:

 WATER

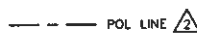 POL LINE 

 APPROXIMATE LOCATION OF
SWAMPY AREAS

 GRAVEL ROADWAY 

NO DATA AVAILABLE FOR CONSTRUCTION OF
WIND ROSE INFORMATION.

REDUCED DRAWING FOR
INFORMATION ONLY

SCALE IS REPRESENTATIVE
OF FULL SIZE DRAWING.

2	31 MAR 07	REV AS PER REDLINES	J.G.
1	13 JUN 06	REV AS PER REDLINES	F.P.
No.	DATE	REVISION	ORIG. APPR.

SITE RECORD DRAWING

100 0 100 200 300 400 metres
mètres

SCALE - ECHELLE

1 : 5000

PROJECT - PROJET

CM-66272

LONG RANGE RADAR SITE

CAM-3

SHEPHERD BAY

TRADE - METIER

SITING

NUNAVUT

DATE

21 JAN 02

SUBJECT - SUJET

SITE PLAN

PRODUCTION	CONCURRENCE - ASSESSMENT	
DESIGNED ETUDIÉ	FIRE MARSHAL	PROVOT DU SERVICE DES INCENDIES
DRAWN DESSINÉ	K.R.	OFFICIER DU GÉNIE BSAN
CHECKED VÉRIFIÉ	T.R.	NWSO ENGINEERING OFFICER
COORDINATION	NWSO FACILITIES ENGINEER	GÉNIE DES INSTALLATIONS BSAN

DWG. NO. - DESSIN NO.
H-S123/1-8400-102

Canada