


GENERAL NOTES :

1) Bridge crossing – As built



PERMIT TO PRACTICE	
QIKIQTAAKUN ENVIRONMENTAL	
Signature 	
Date Dec 13, 2006	
PERMIT NUMBER: P 530	
The Association of Professional Engineers, Geologists and Geophysicists of the NWT / NU	

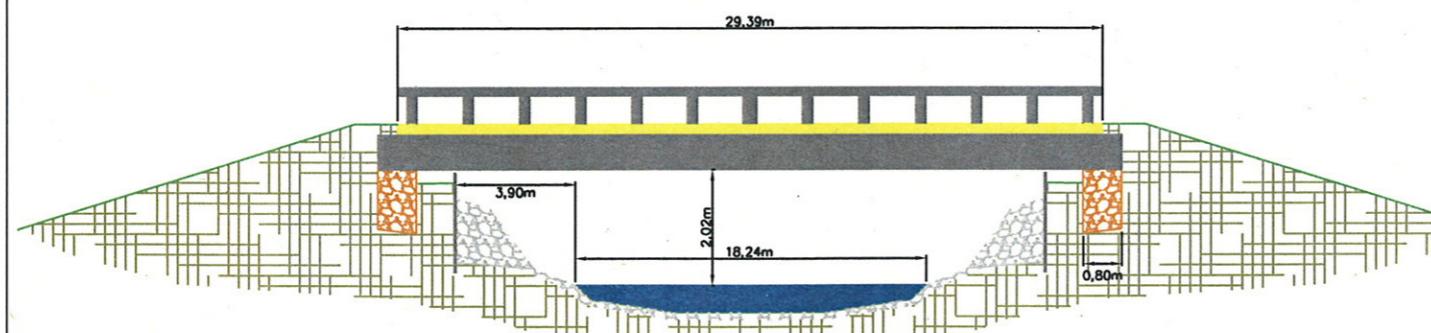

Cross-Section AA

#	DESCRIPTION	BY
REVISIONS		
CAPE CHRISTIAN		
CLYDE RIVER		
BRIDGE - AS BUILT DRAWING		
	SCALE REF DVG CONTRAT	DRAFTER CHECK DVG NUM
		DATE DATE 24/10