


# GENERAL NOTES :

1) River crossing 7A

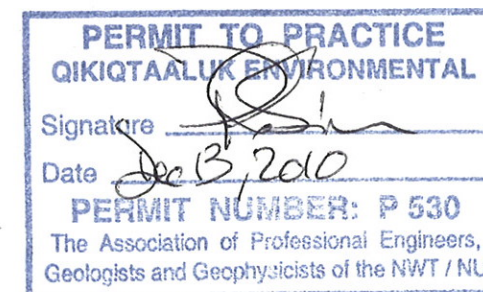

△ Work area 1 - D01 D08	J-P	
#	DESCRIPTION	By DATE
REVISIONS		
CAPE CHRISTIAN CLYDE RIVER		
RIVER CROSSING 7A		
SCALE	DRAWER JPG	DATE 24/10/2010
REF DWG	CHECK	DATE
CONTRAT	DWG NUM	△ 00