
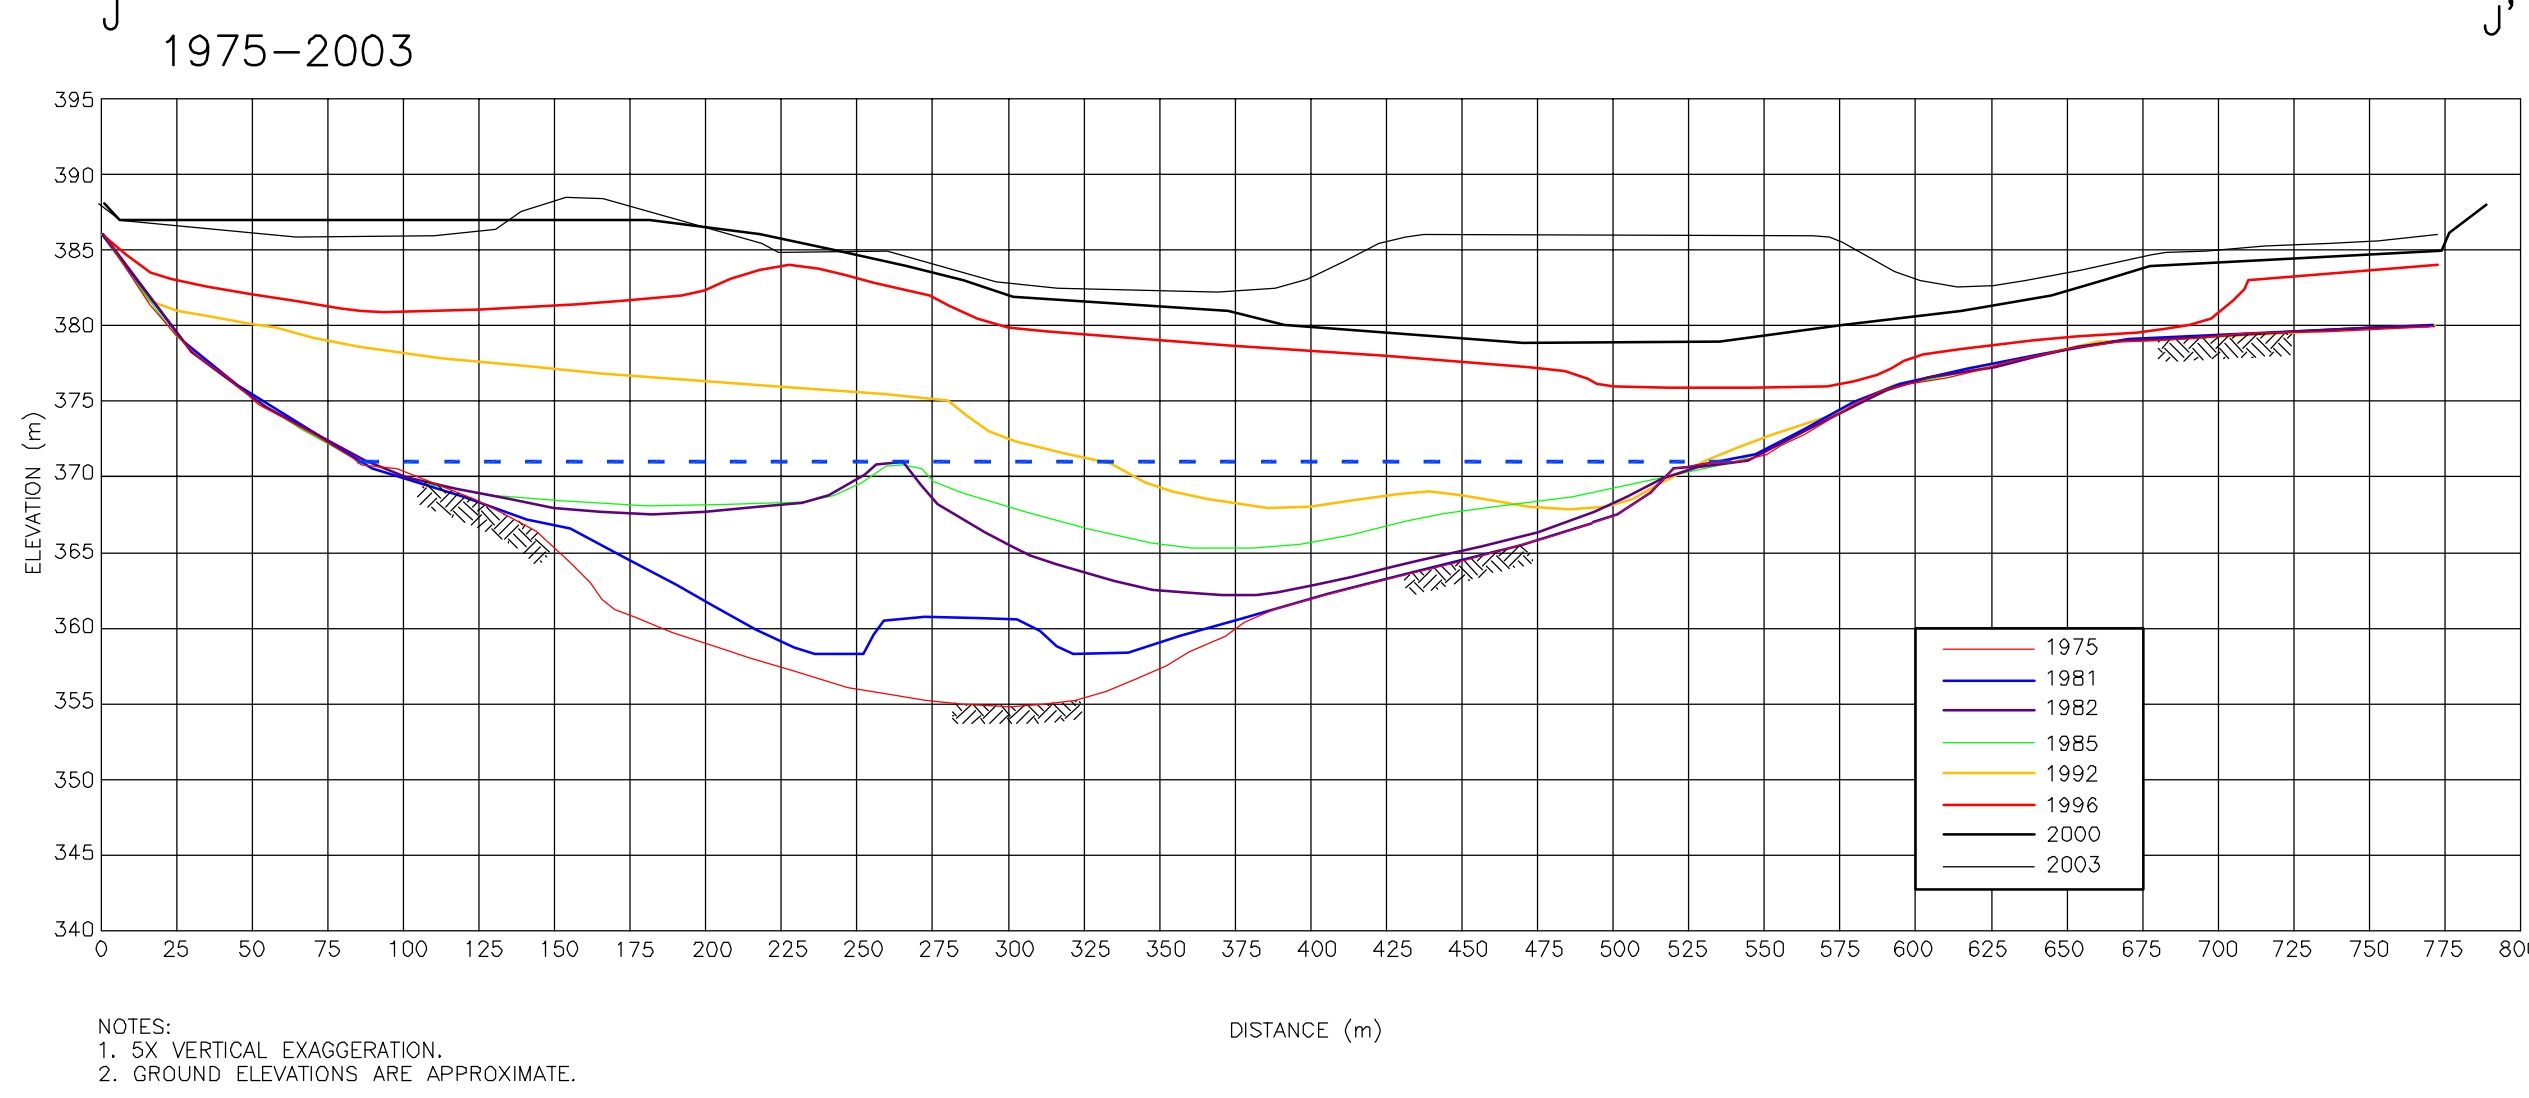
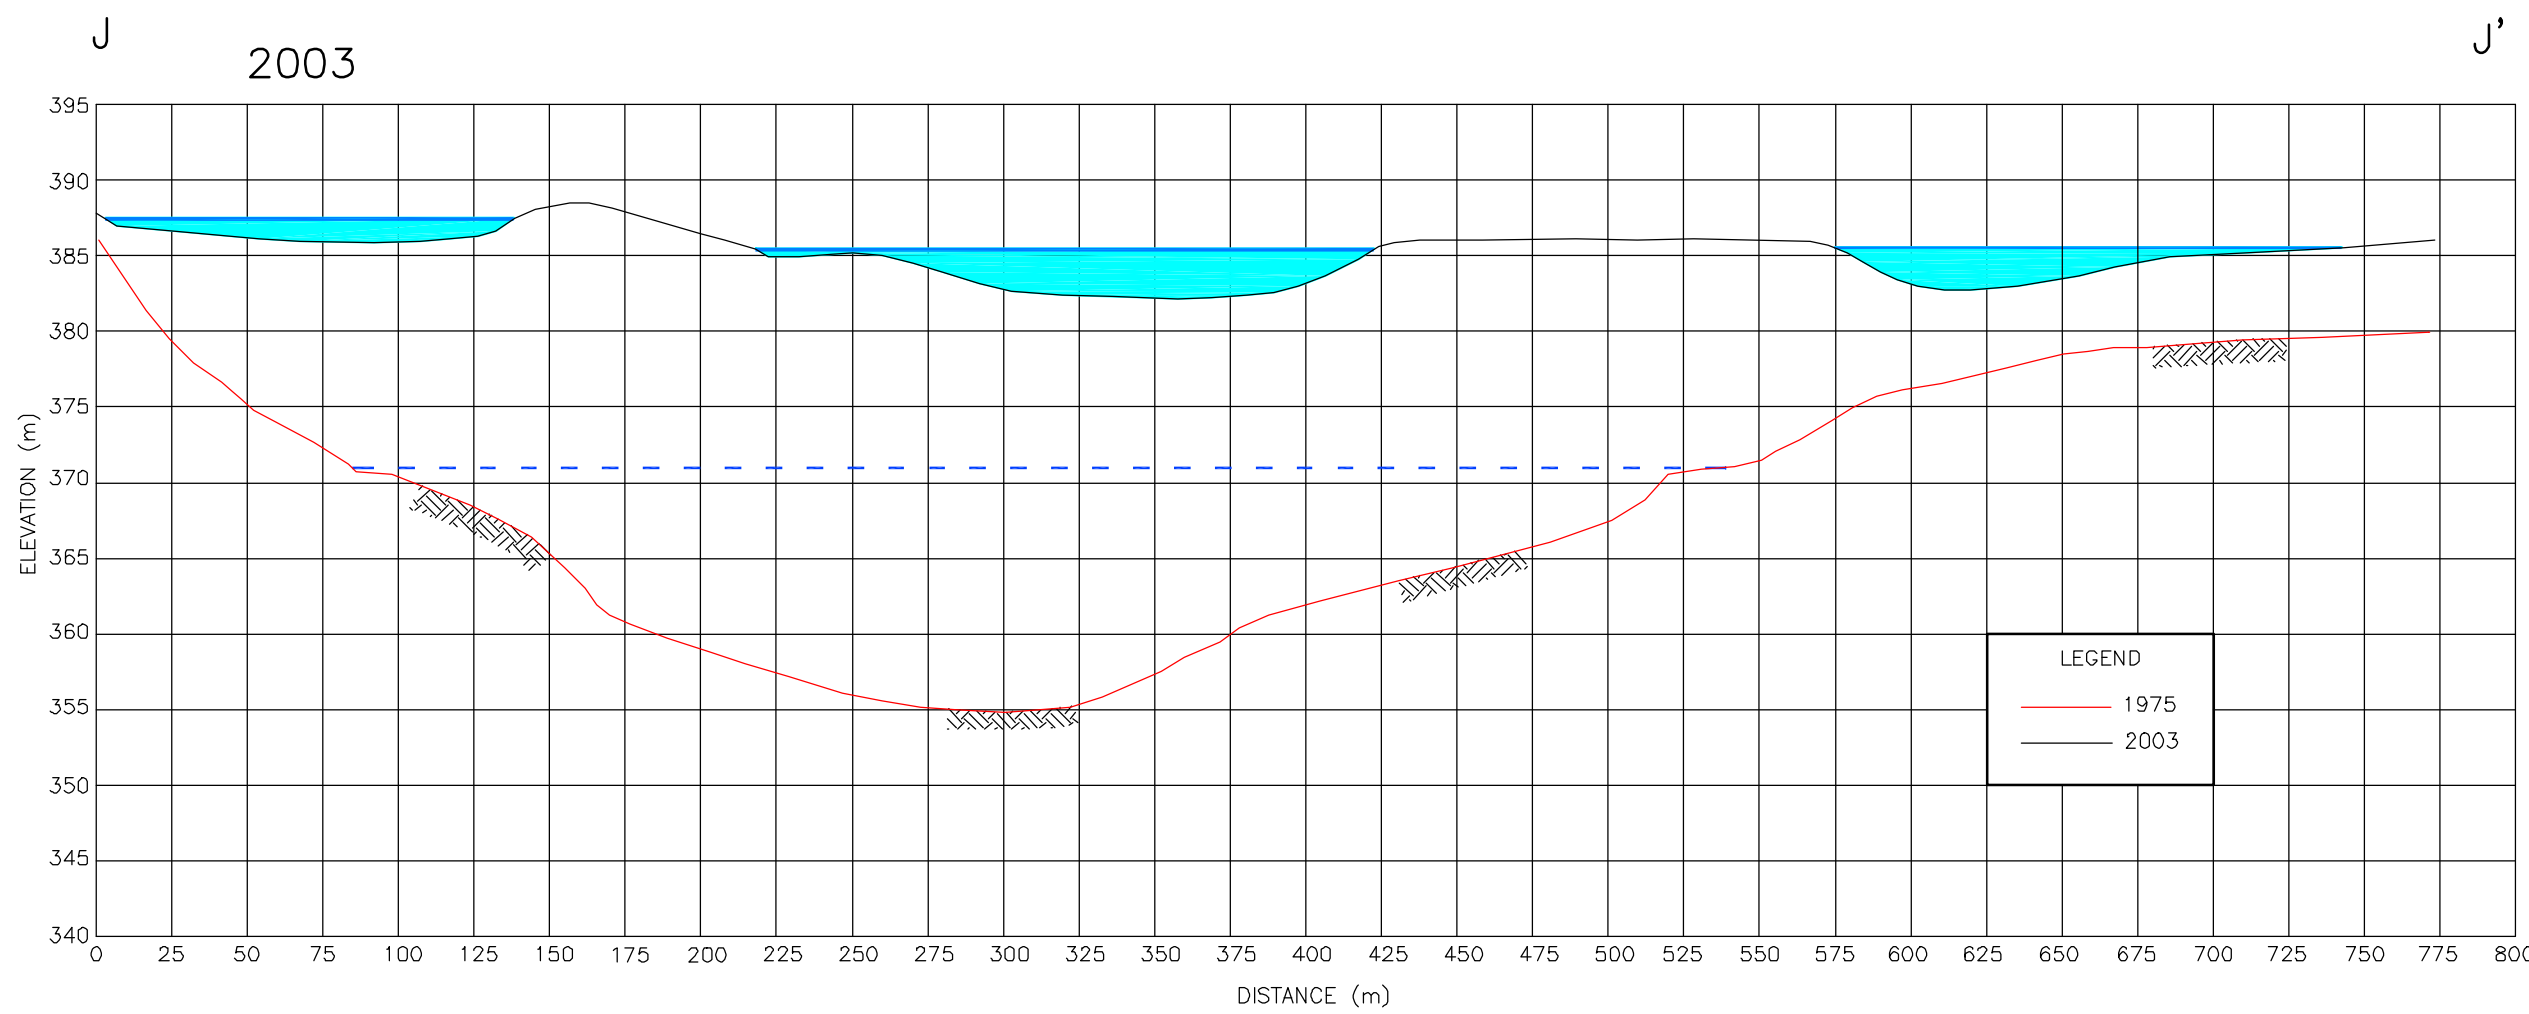
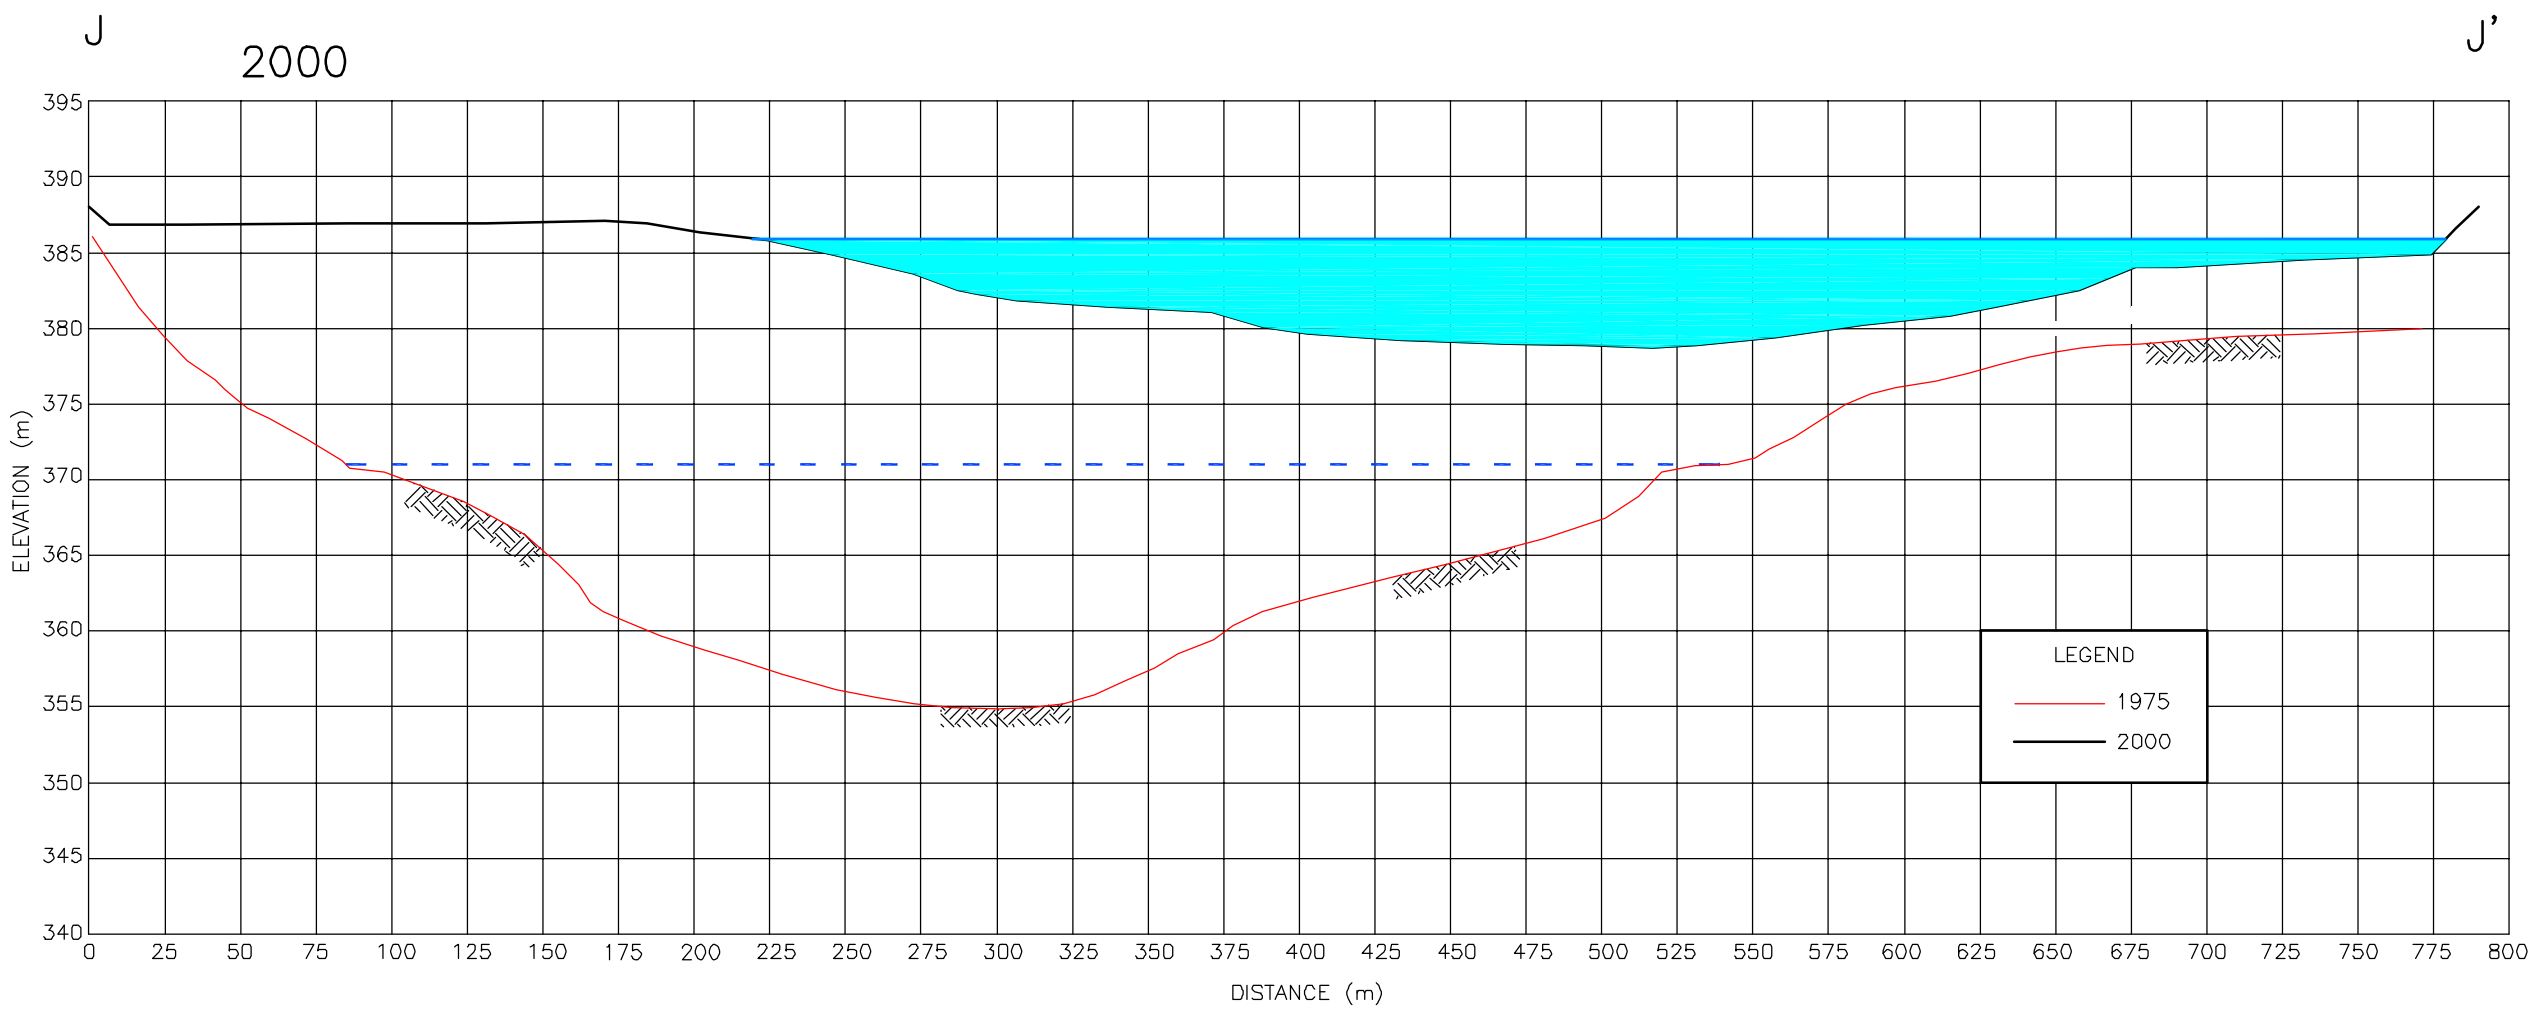
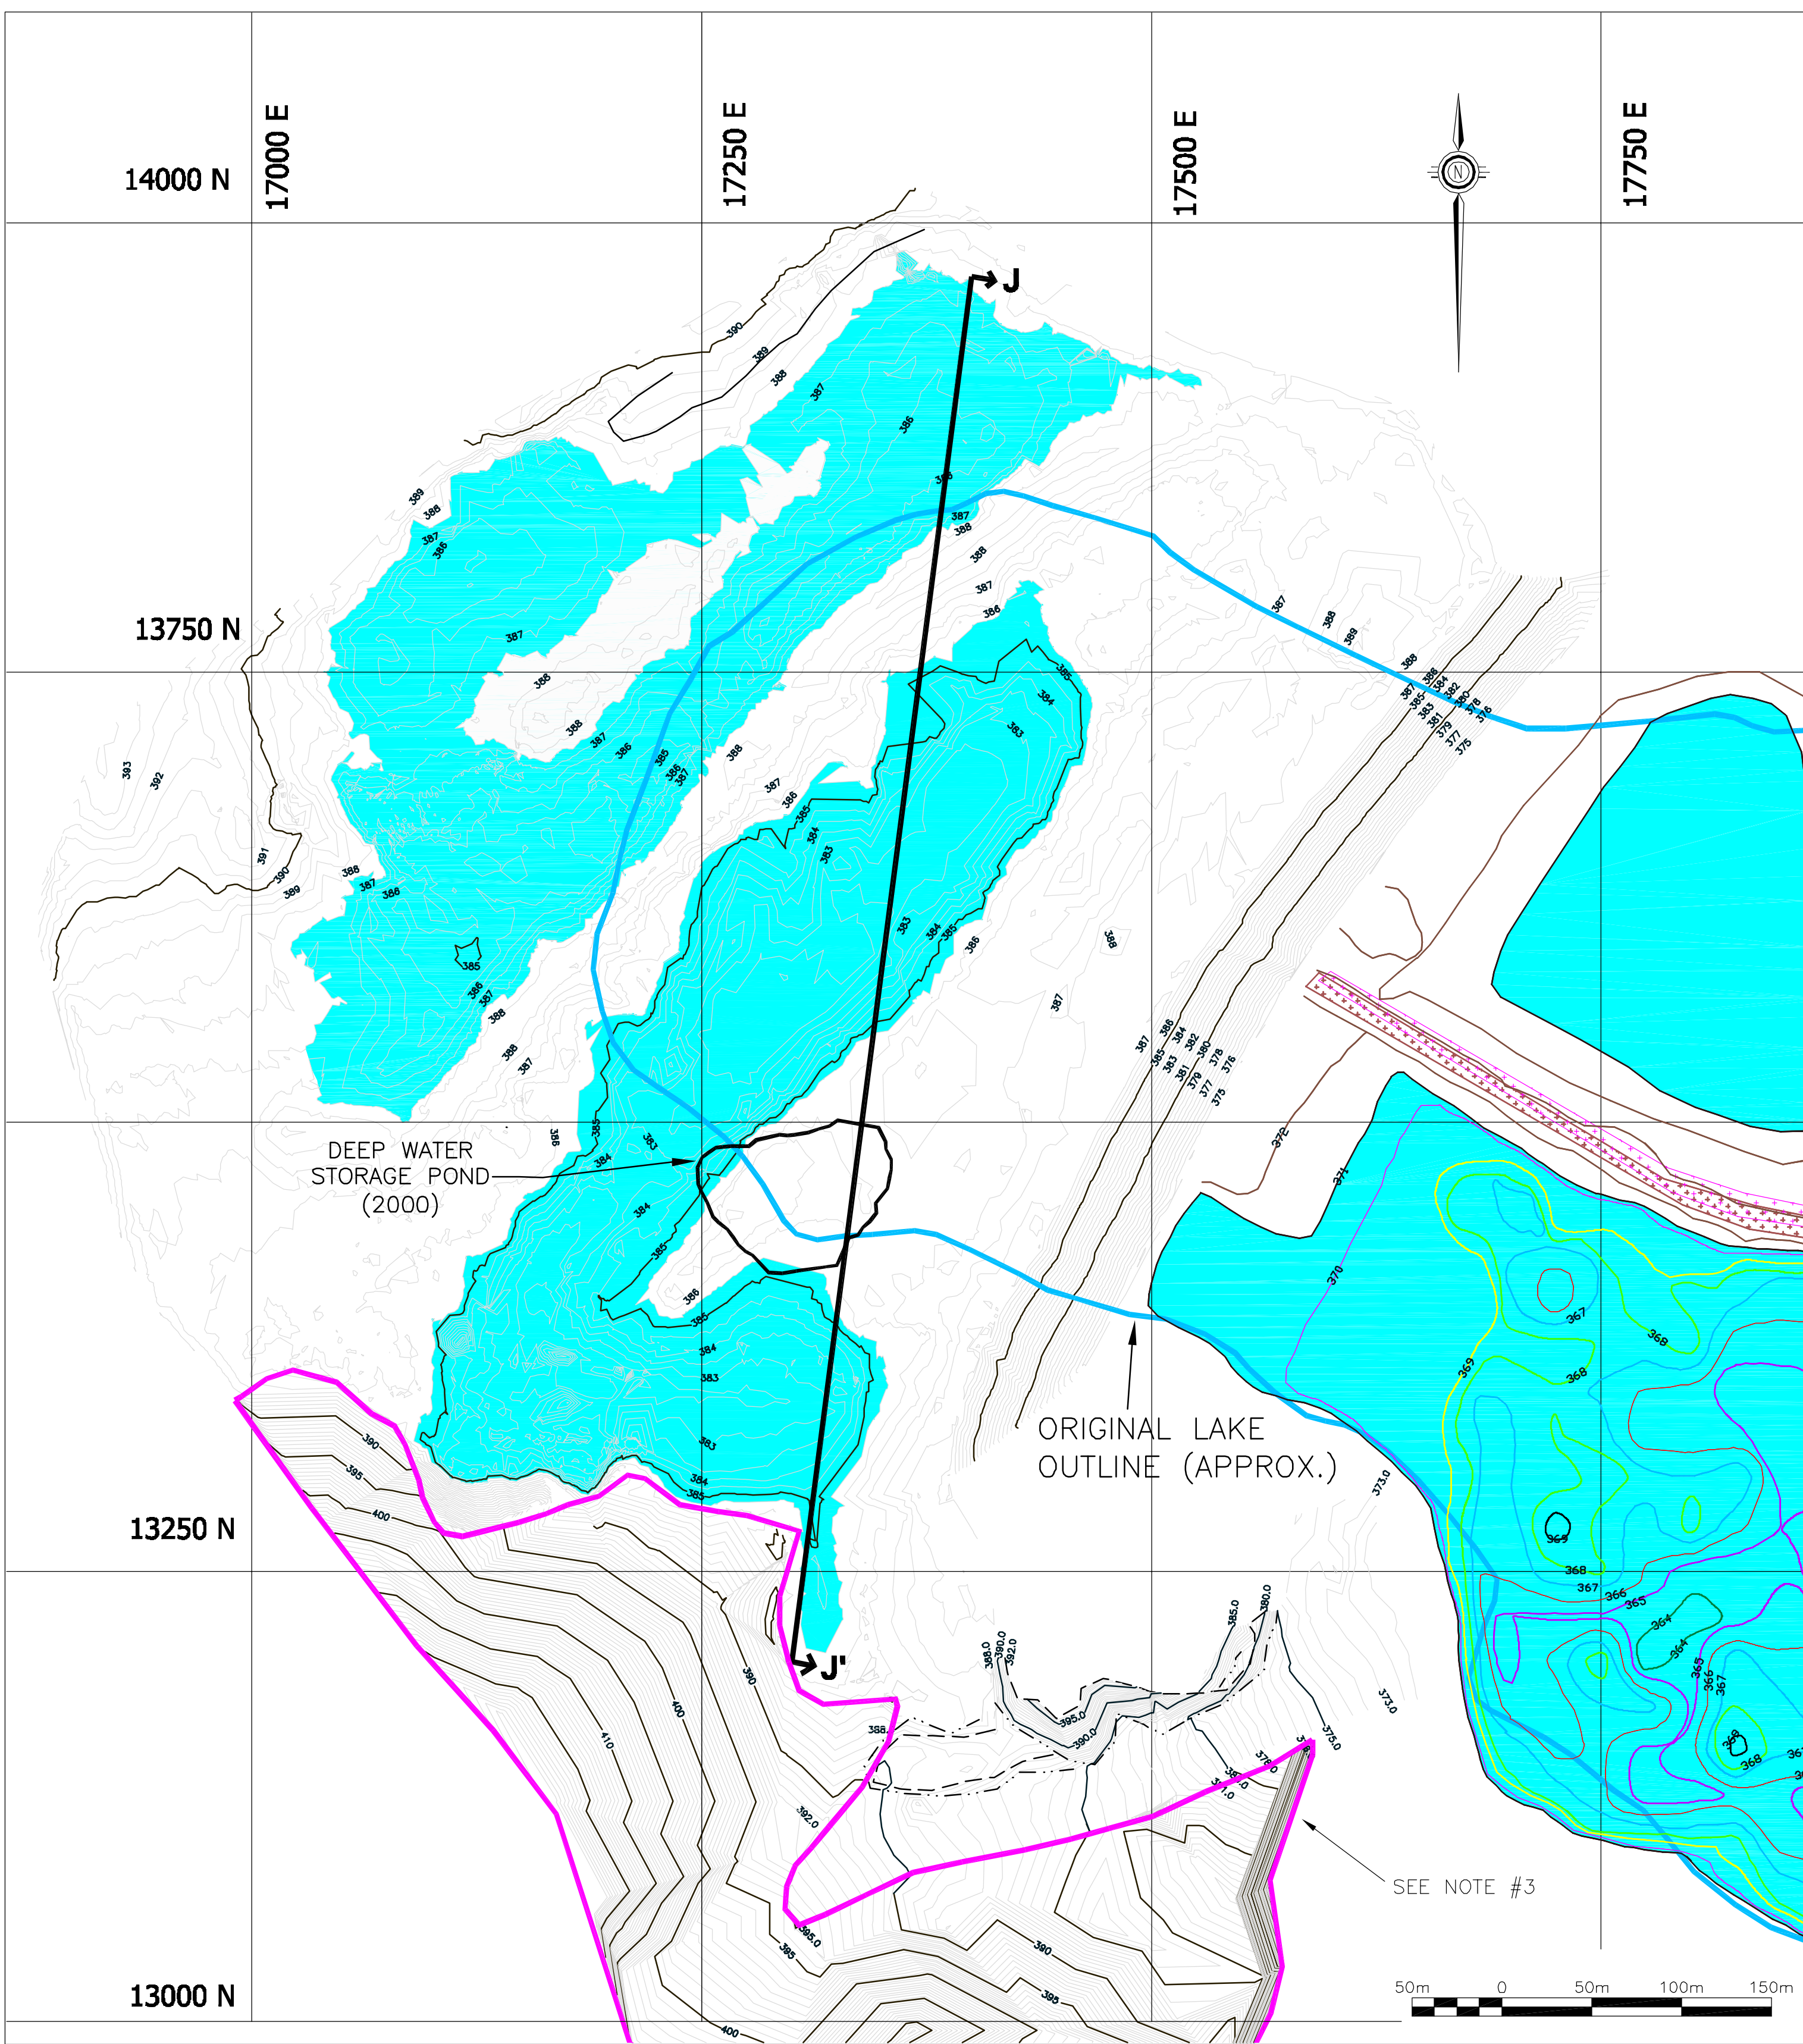
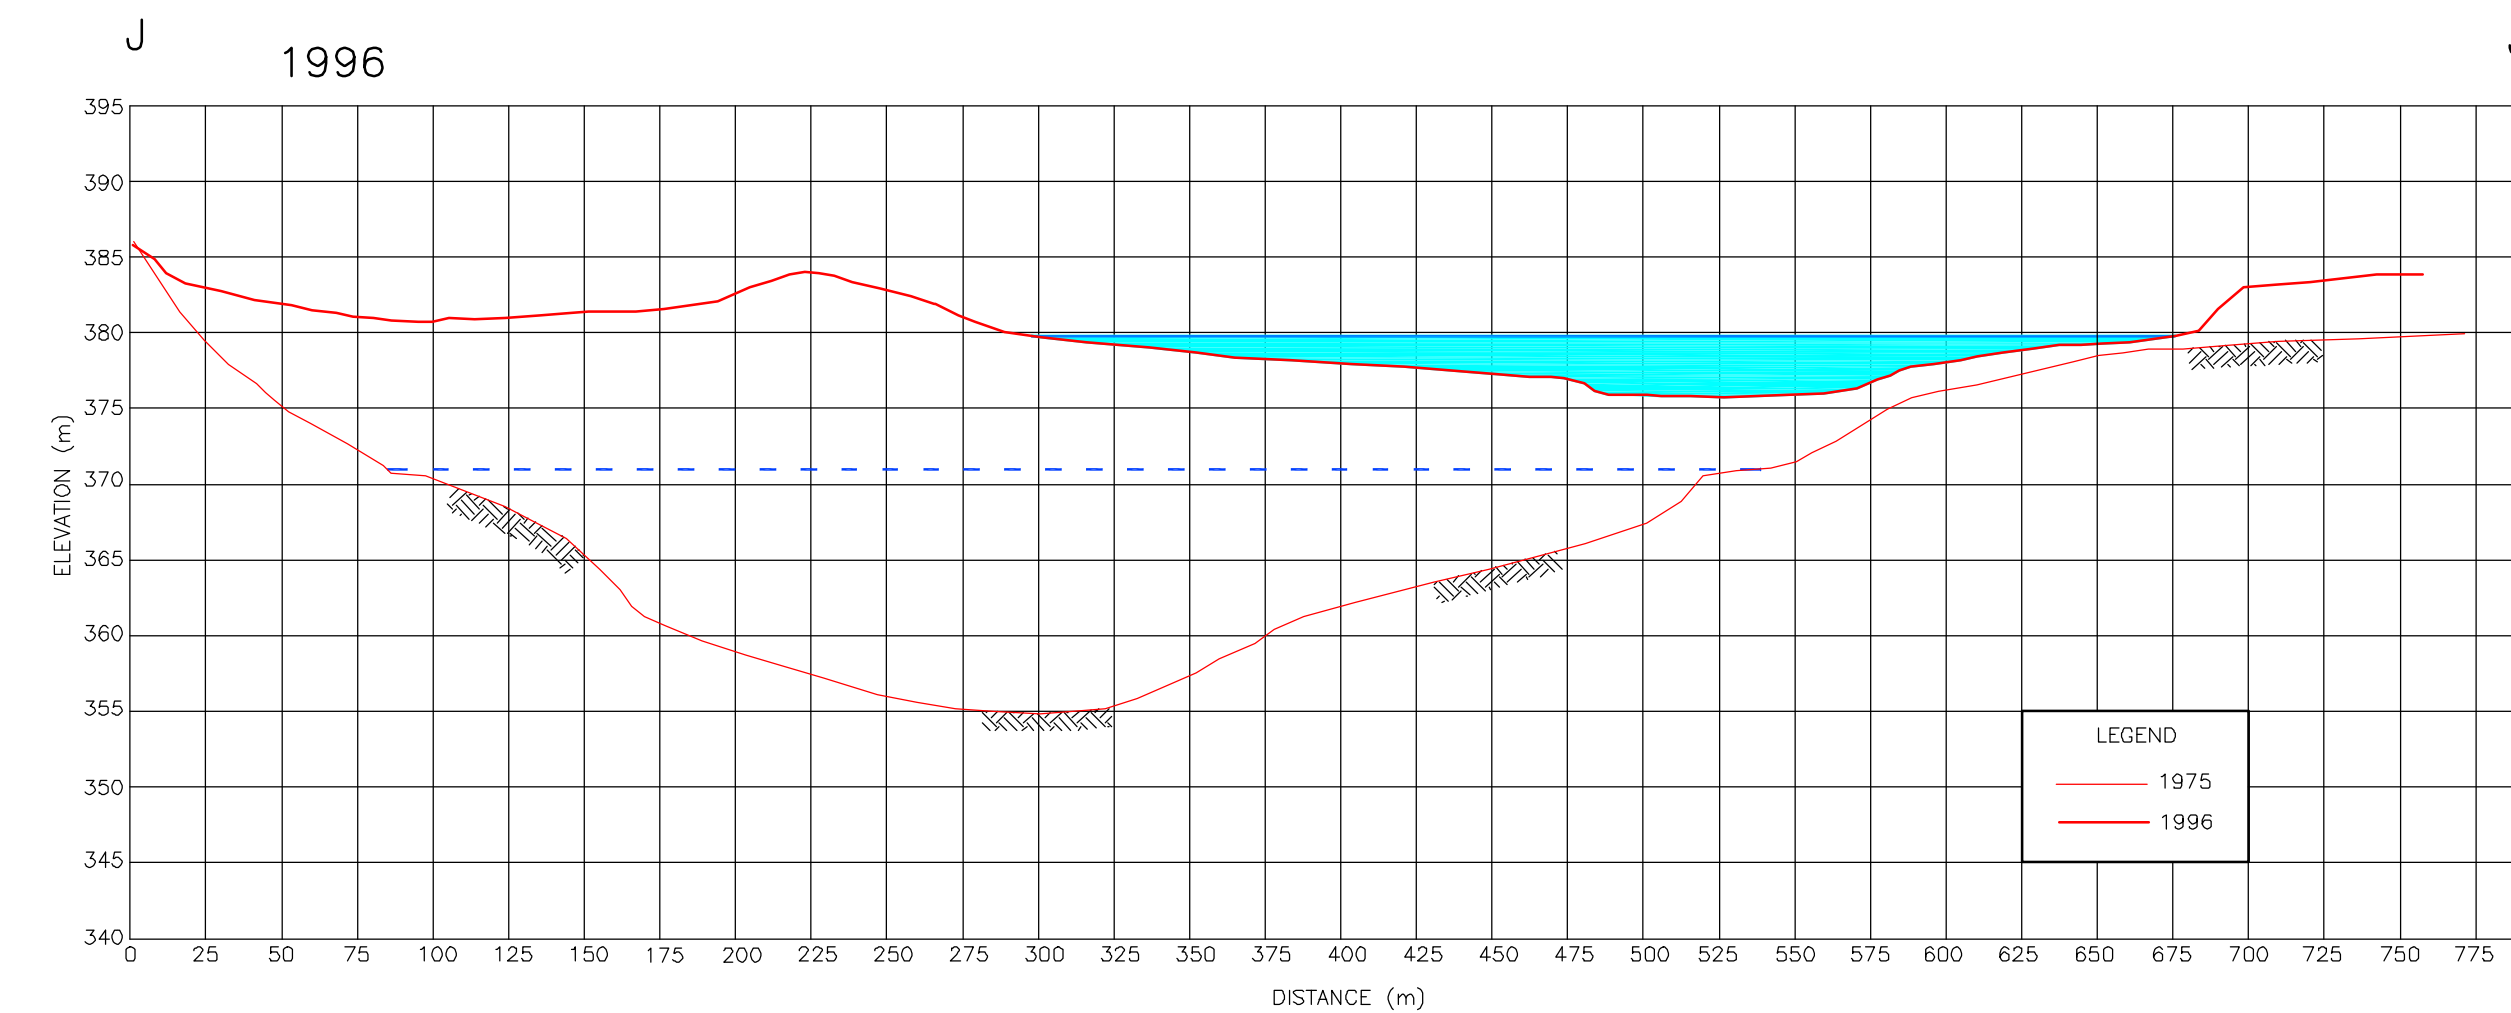
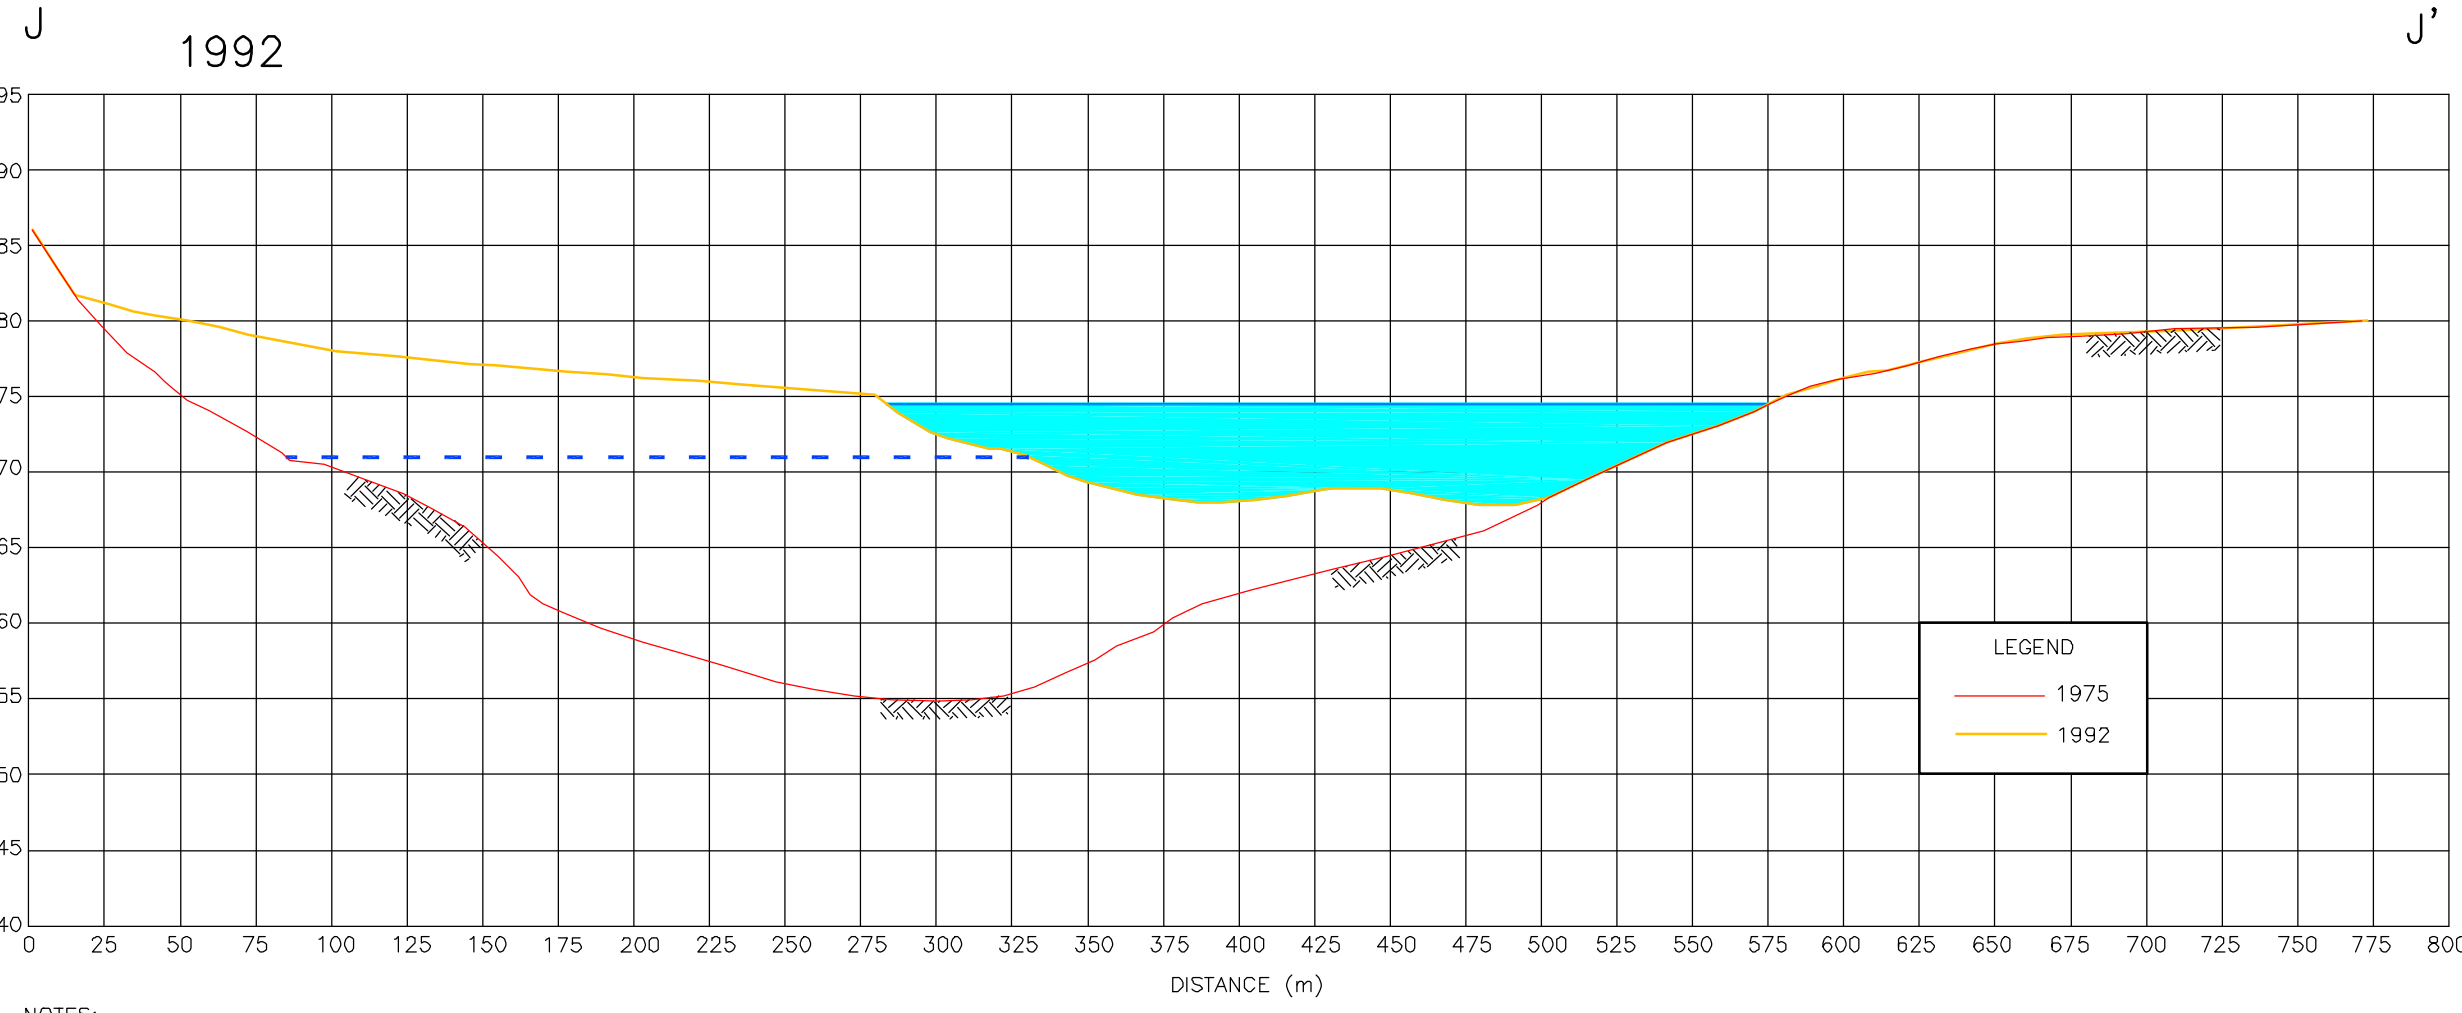
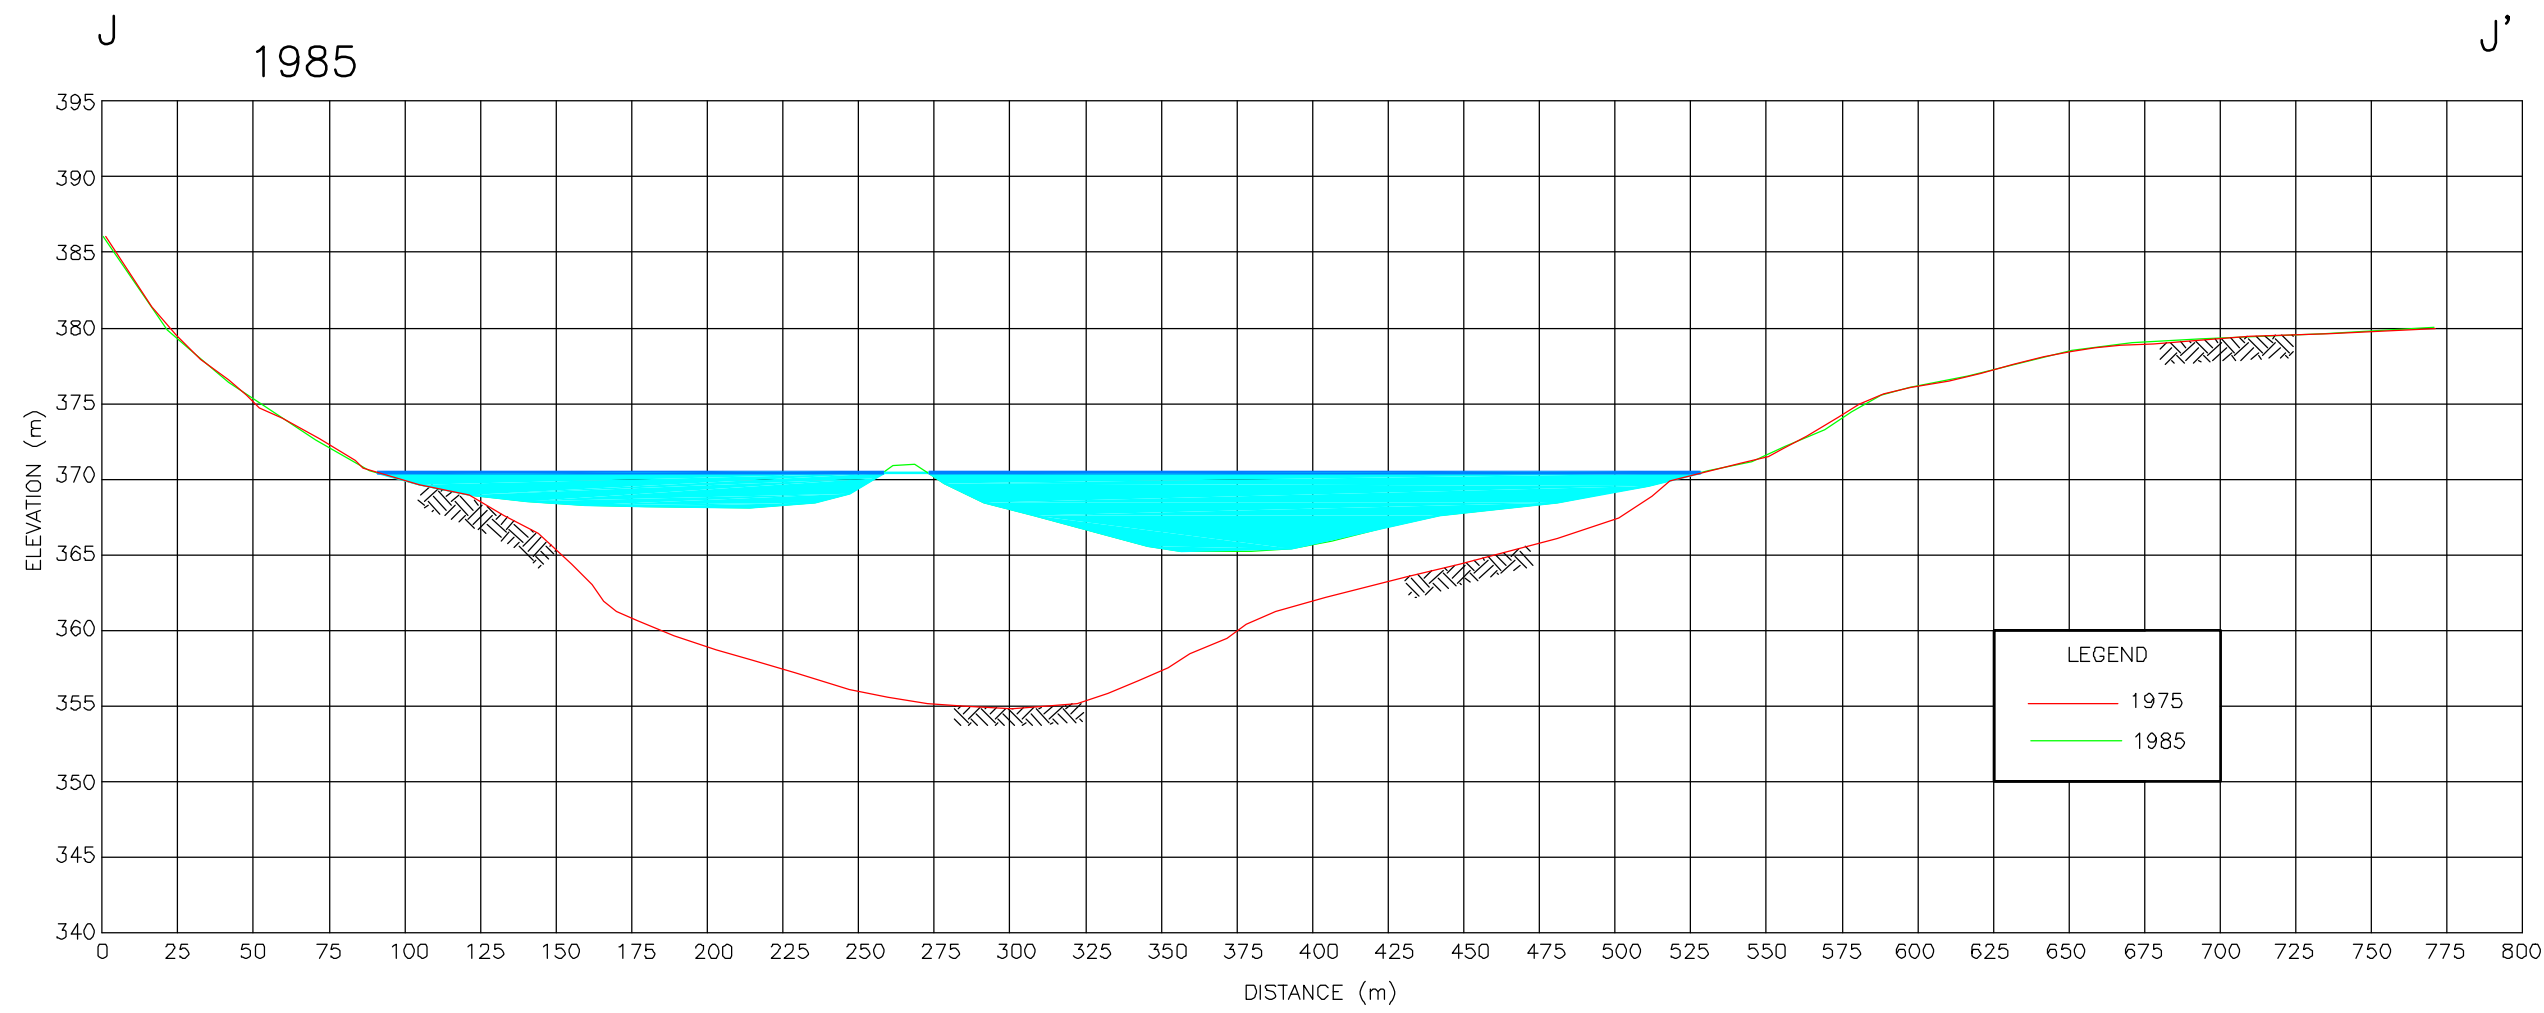
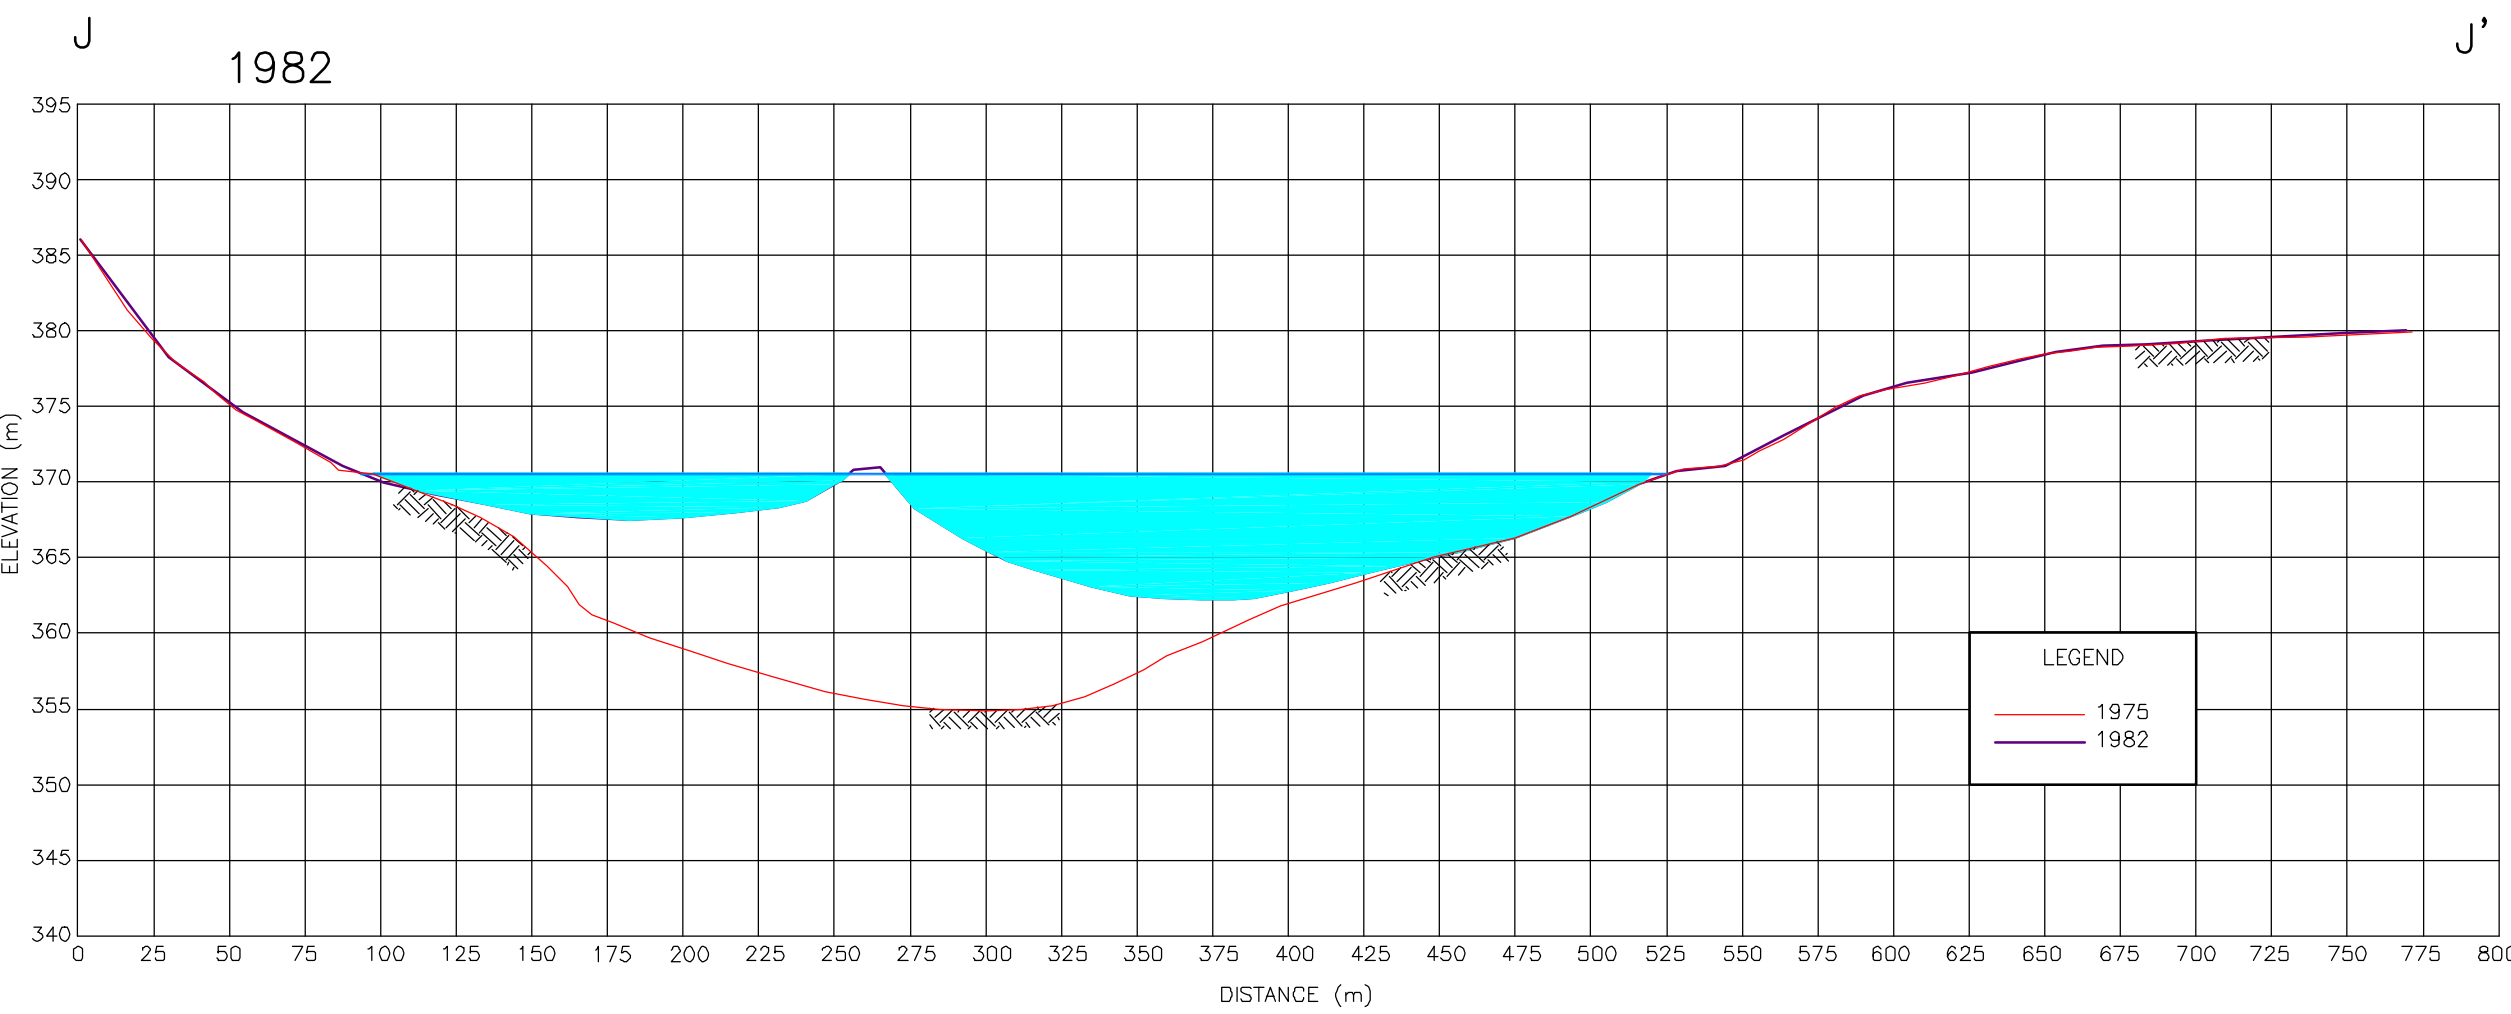
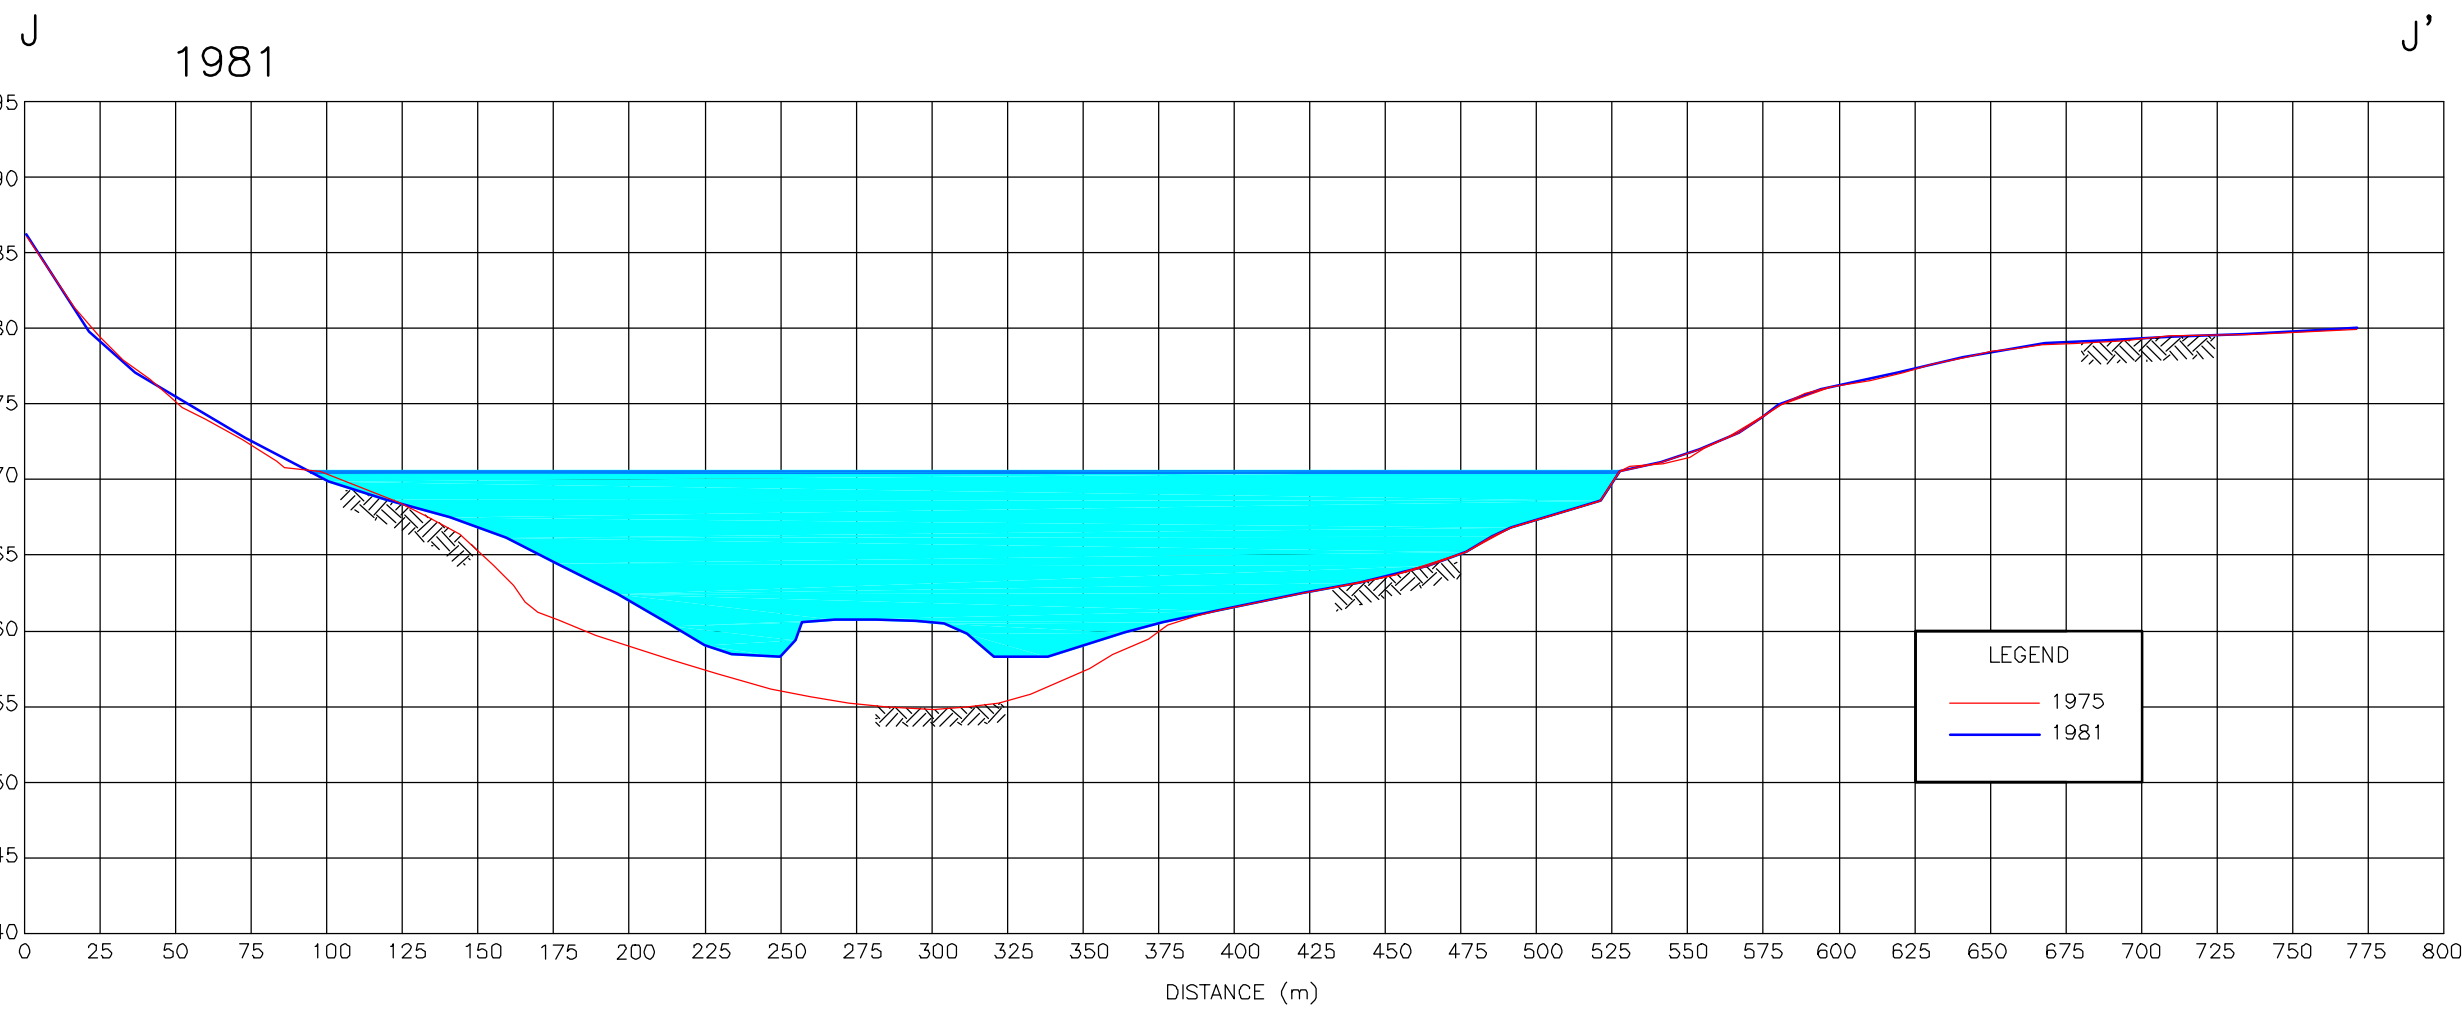


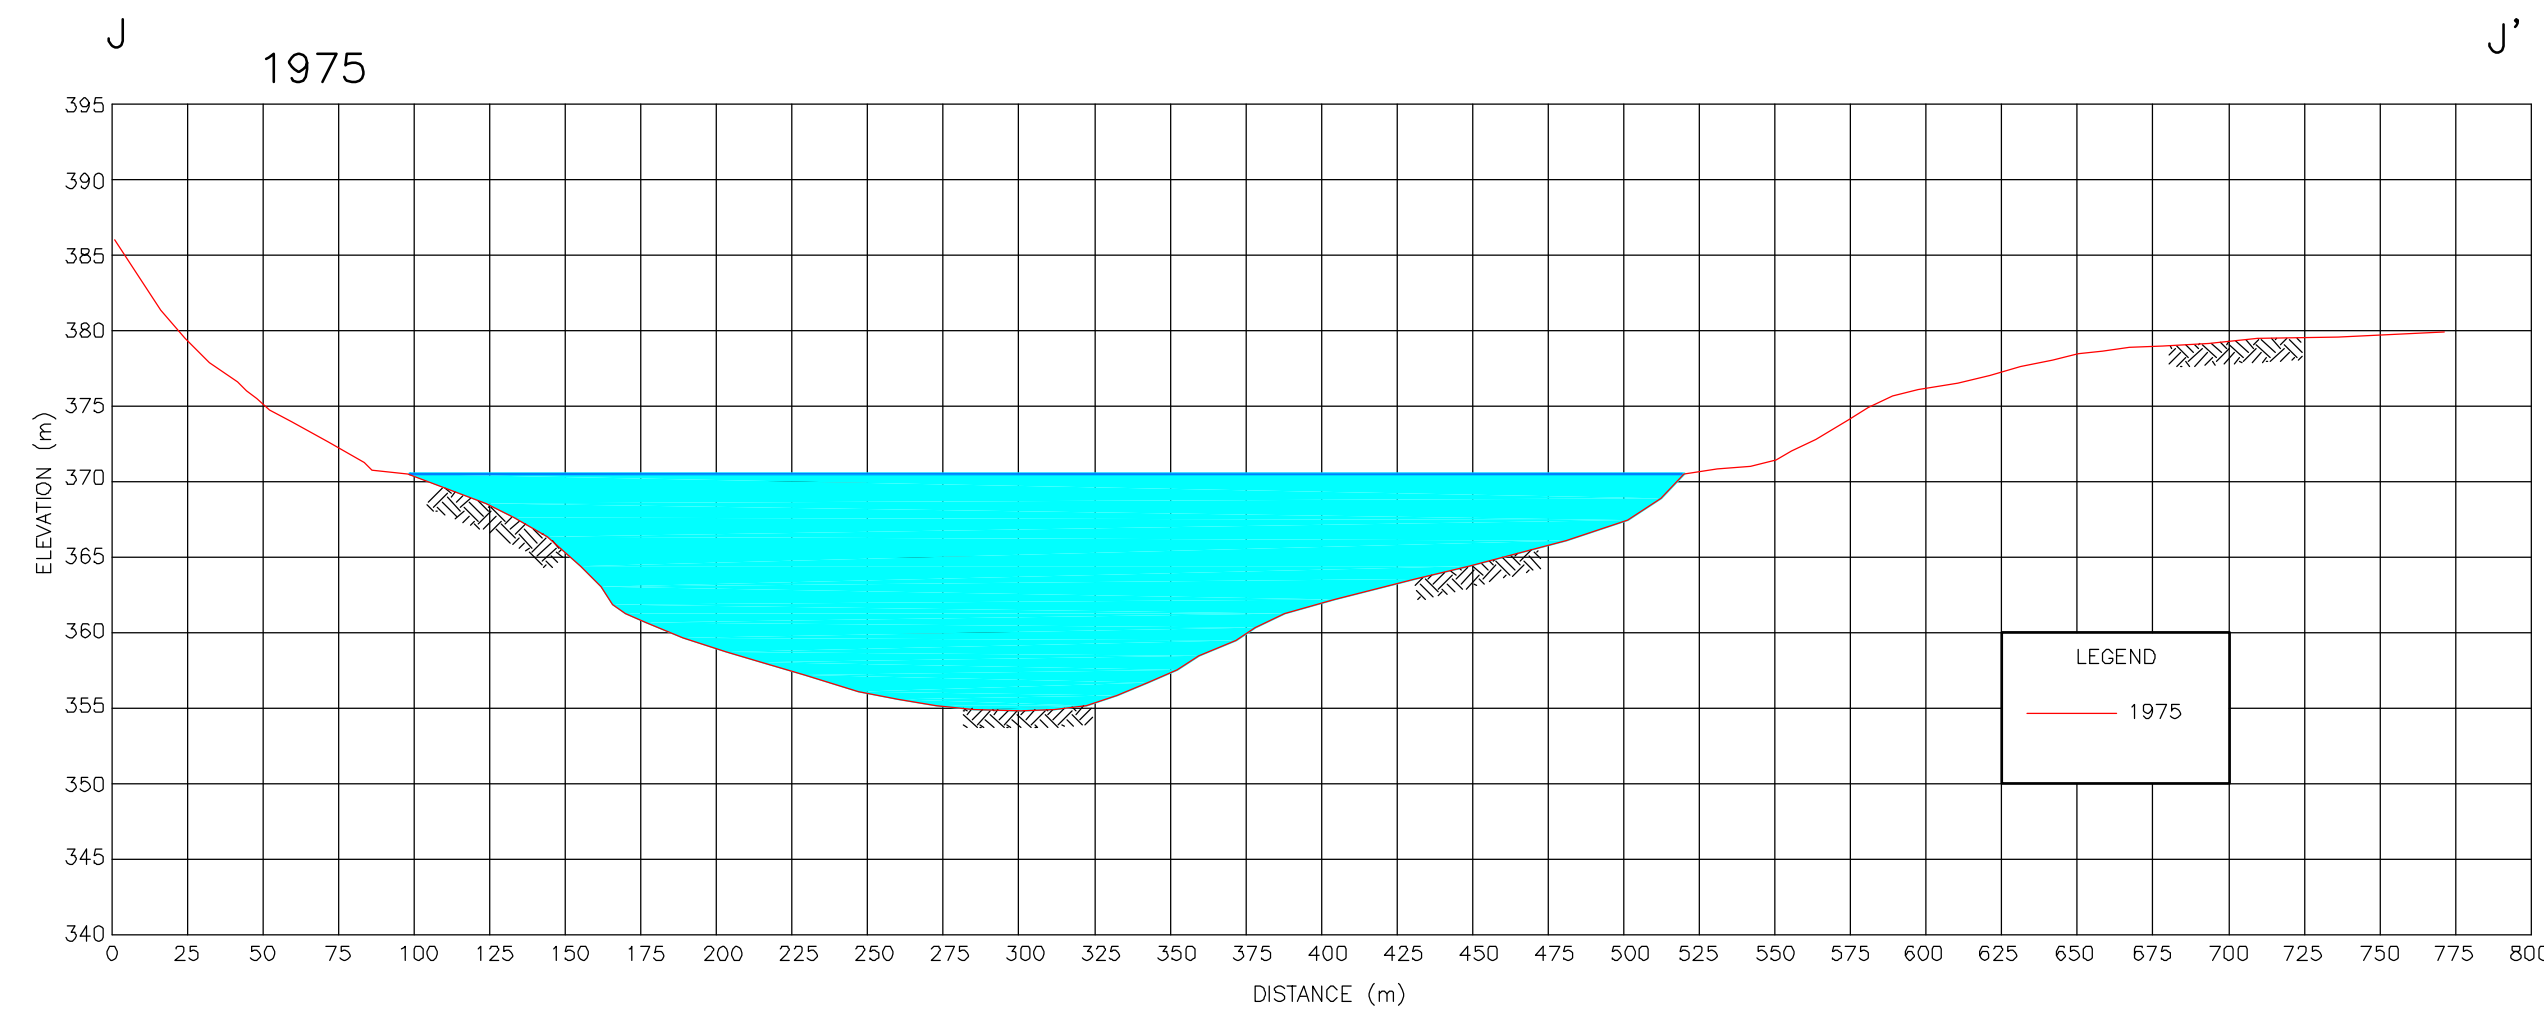

- NOTES:
- 2003 SURFACE CELL TOPOGRAPHY/BATHYMETRY SURVEYED BY S.A.S. SEPTEMBER, 2003.
 - TOPOGRAPHY/BATHYMETRY OF RESERVOIR AND SURFACE CELL FOR ALL OTHER YEARS DERIVED FROM DRAWINGS SUPPLIED BY NANISIVIK MINE.
 - TOPOGRAPHY OF THIS AREA WAS DERIVED BY BGC USING ADDITIONAL DATA SUPPLIED BY NANISIVIK MINE.

CLIENT: NANISIVIK MINE
A DIVISION OF CANZINCO LTD.

LEGEND

— WATER

— — — ORIGINAL WEST TWIN LAKE ELEVATION

— ORIGINAL GROUND ELEVATION

AS A MUTUAL PROTECTION TO OUR CLIENT, THE PUBLIC AND OURSELVES, ALL REPORTS AND DRAWINGS ARE SUBMITTED FOR THE CONSIDERATION AND APPROVAL OF OUR CLIENT FOR A SPECIFIC PROJECT AND FOR INFORMATION FOR USE AND/OR PUBLICATION OF DATA, STRUCTURES, CONCLUSIONS OR ANY OTHER FORM OF INFORMATION OUR REPORTS AND DRAWINGS IS RESERVED PROVIDING OUR WRITTEN APPROVAL.

REV.	DATE	REVISION NOTES	DRAWN	CHECKED	APPROVED

PROJECT	AS SHOWN
TITLE	FEB 2004
DRAWN	CJT
CHECKED	GKC
APPROVED	JWC

PROJECT		
WEST TWIN DISPOSAL AREA CLOSURE PLAN		
TITLE		
HISTORICAL TAILINGS DEPOSITION SURFACE CELL		
PROJECT No.	DATE	REV.
0255-008-09	6	0

BGC ENGINEERING INC.
AN APPLIED EARTH SCIENCES COMPANY
BGC
Calgary, AB Phone: (403) 250-5185