




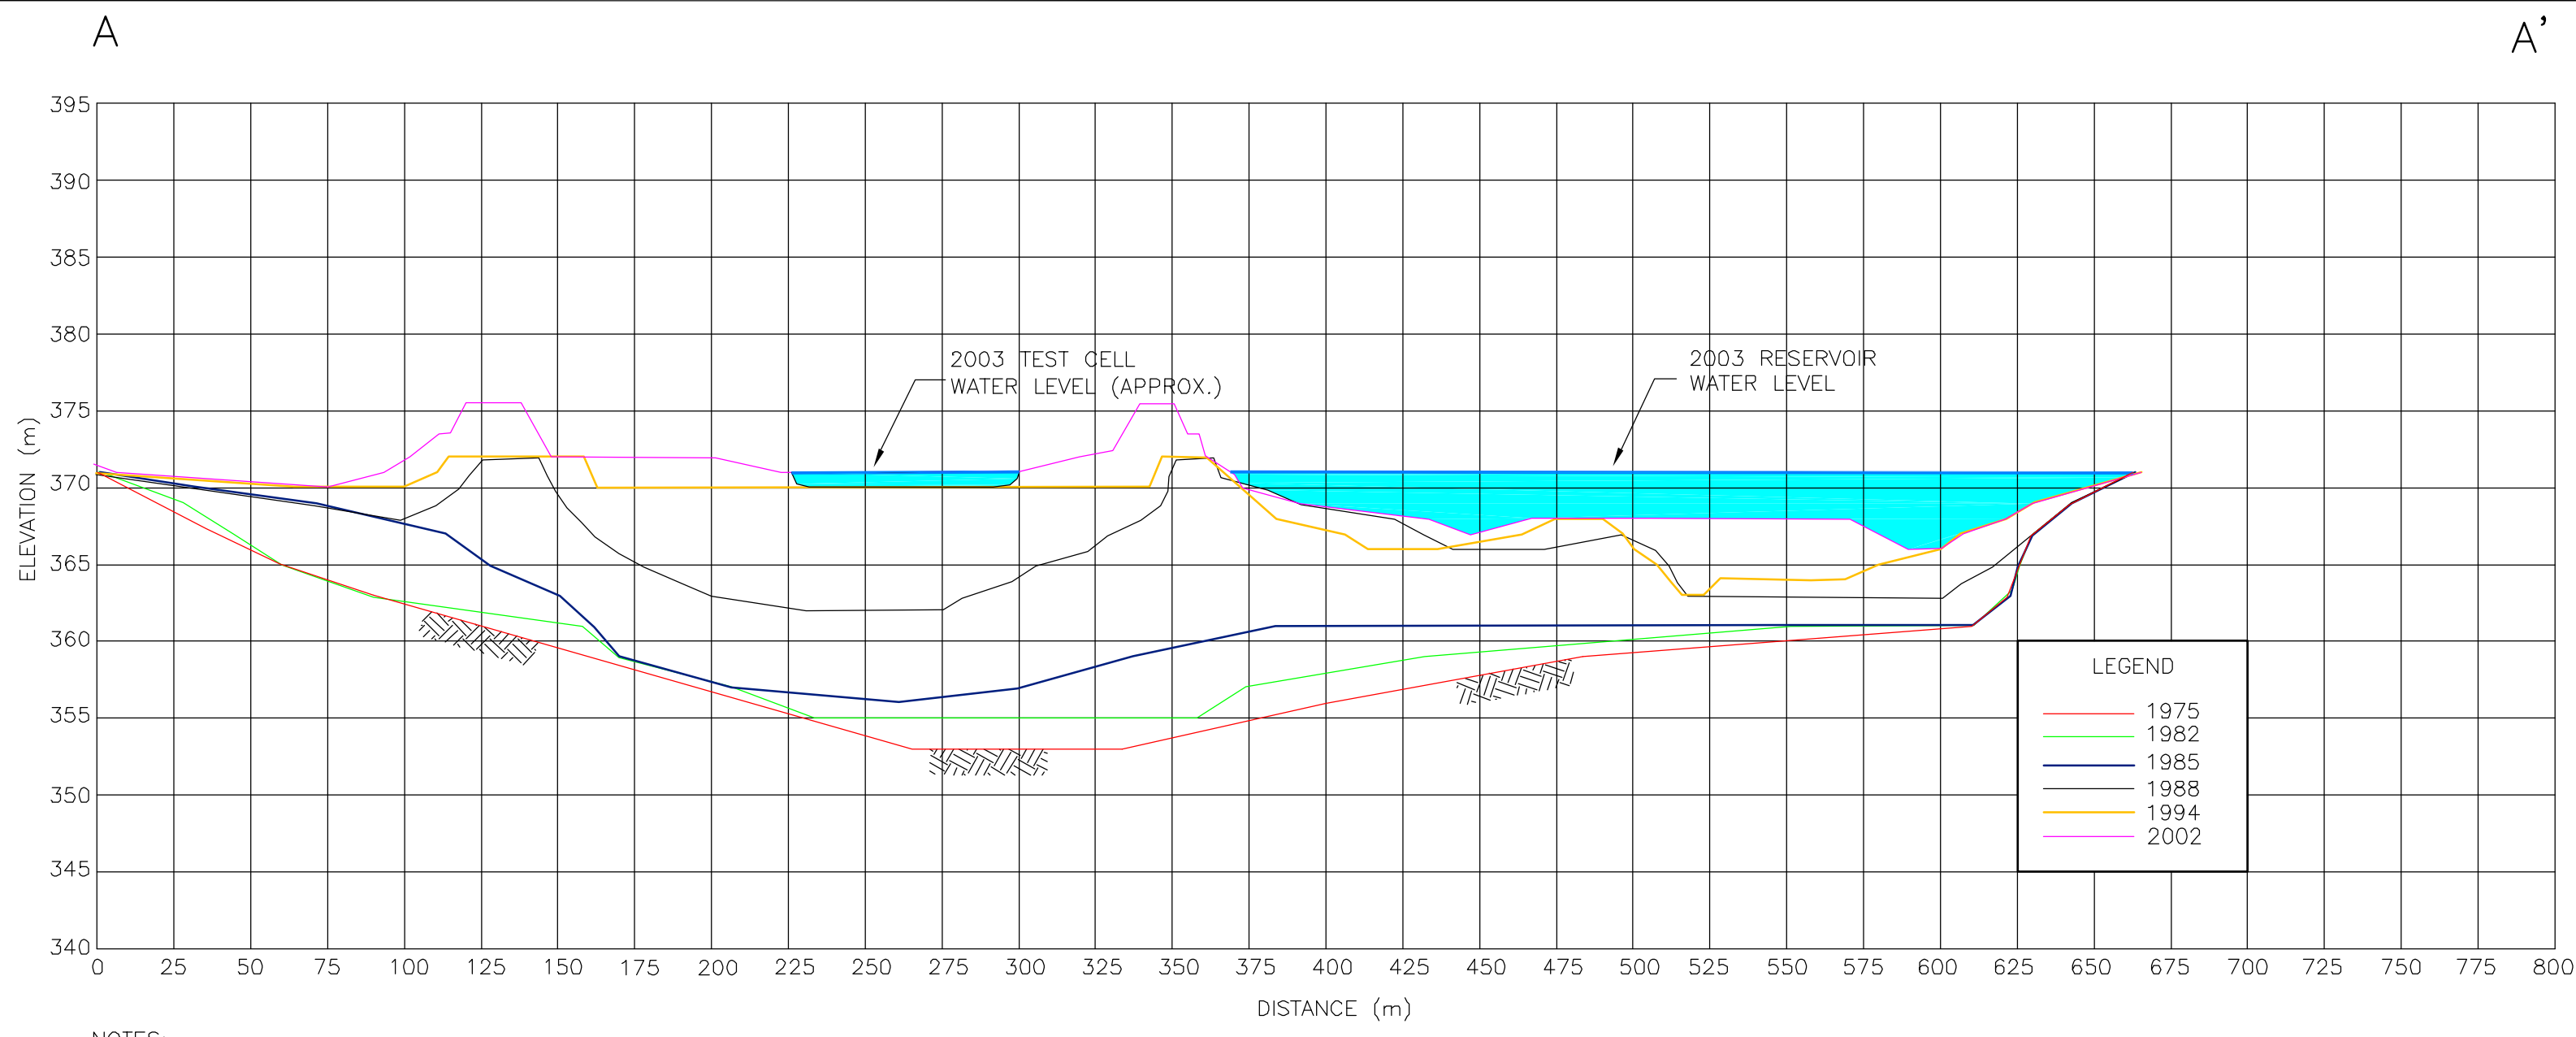


NOTES:  
1. 5X VERTICAL EXAGGERATION.  
2. GROUND ELEVATIONS ARE APPROXIMATE.

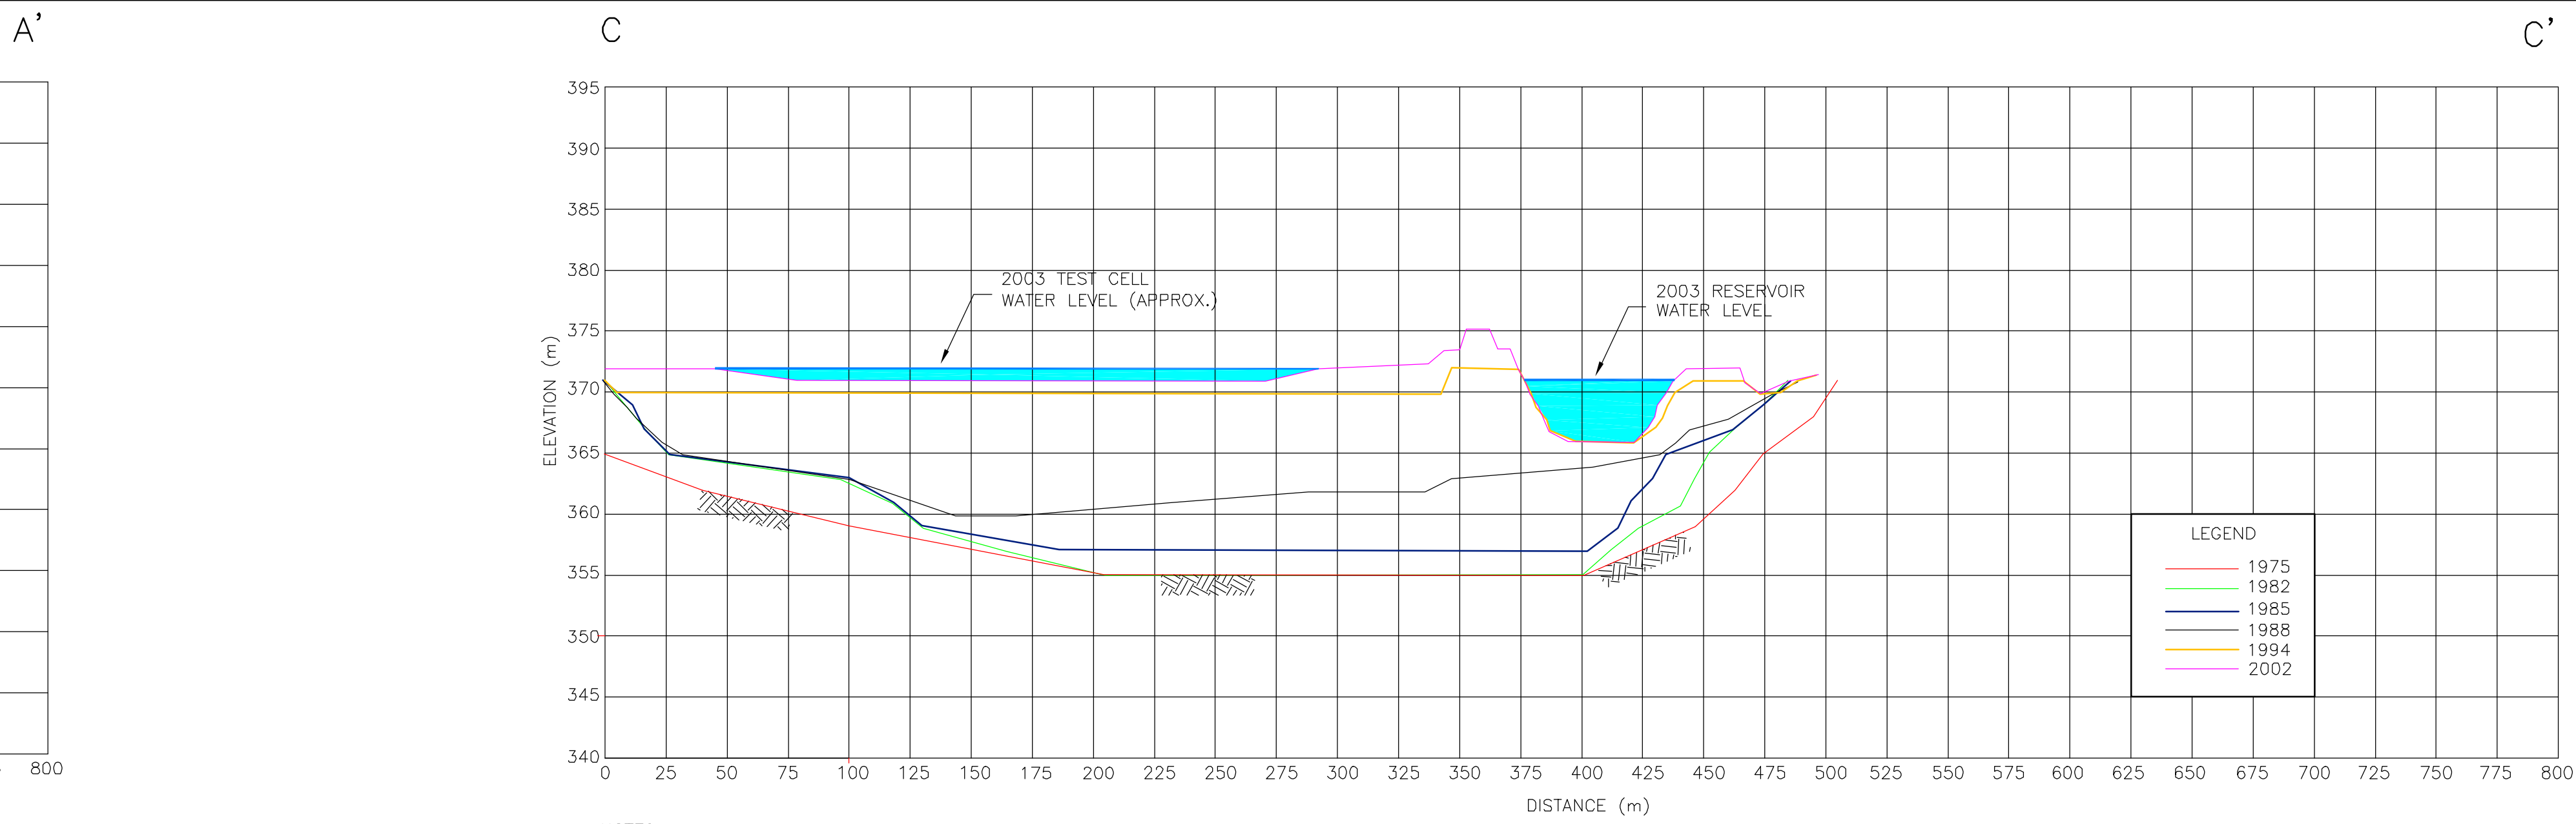


NOTES:  
1. 5X VERTICAL EXAGGERATION.  
2. GROUND ELEVATIONS ARE APPROXIMATE.

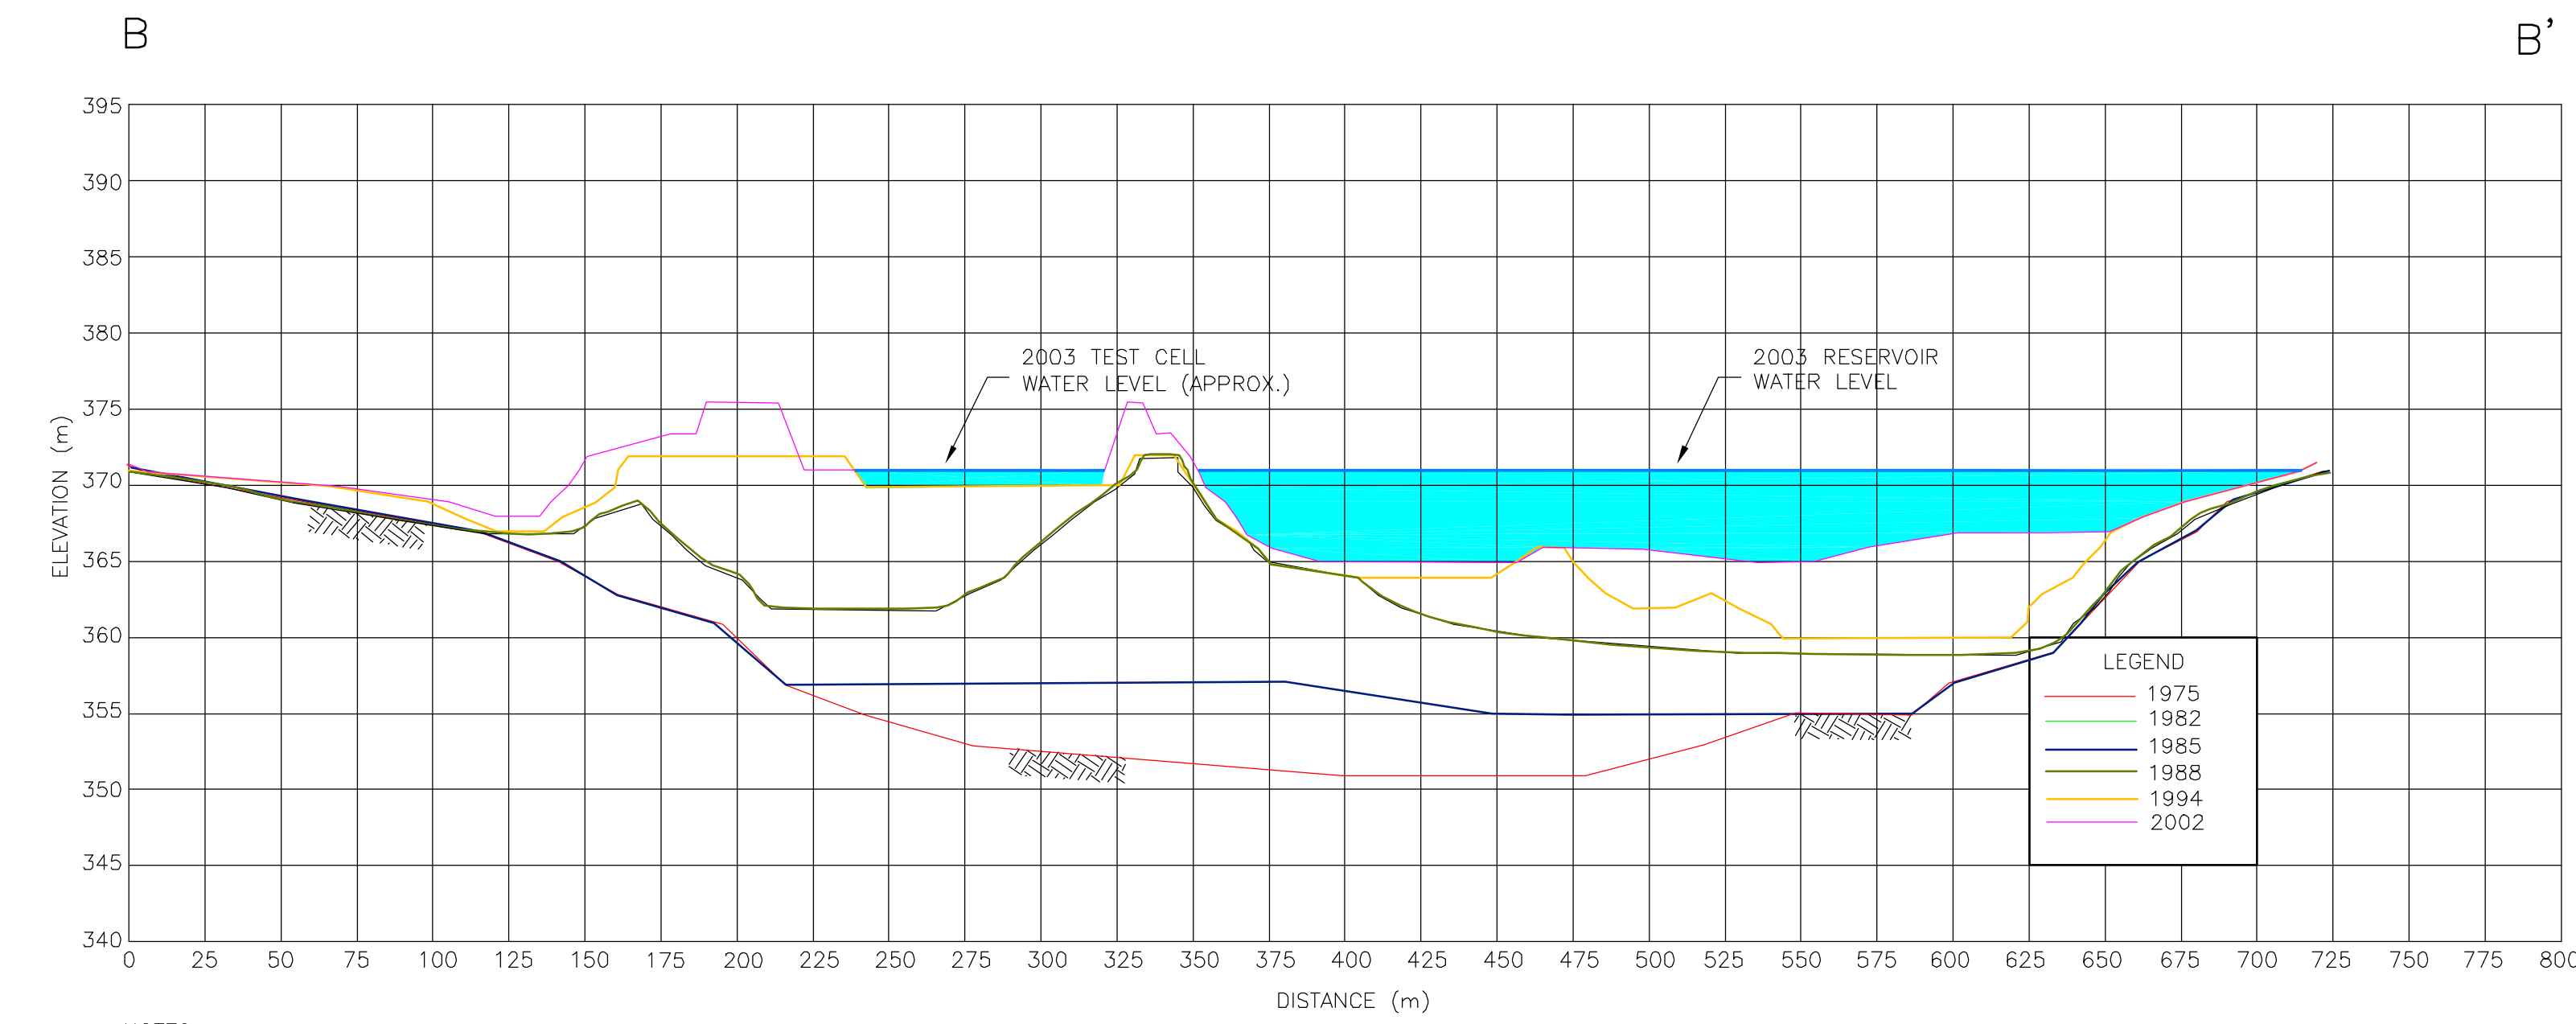

NOTES:  
1. 5X VERTICAL EXAGGERATION.  
2. GROUND ELEVATIONS ARE APPROXIMATE.

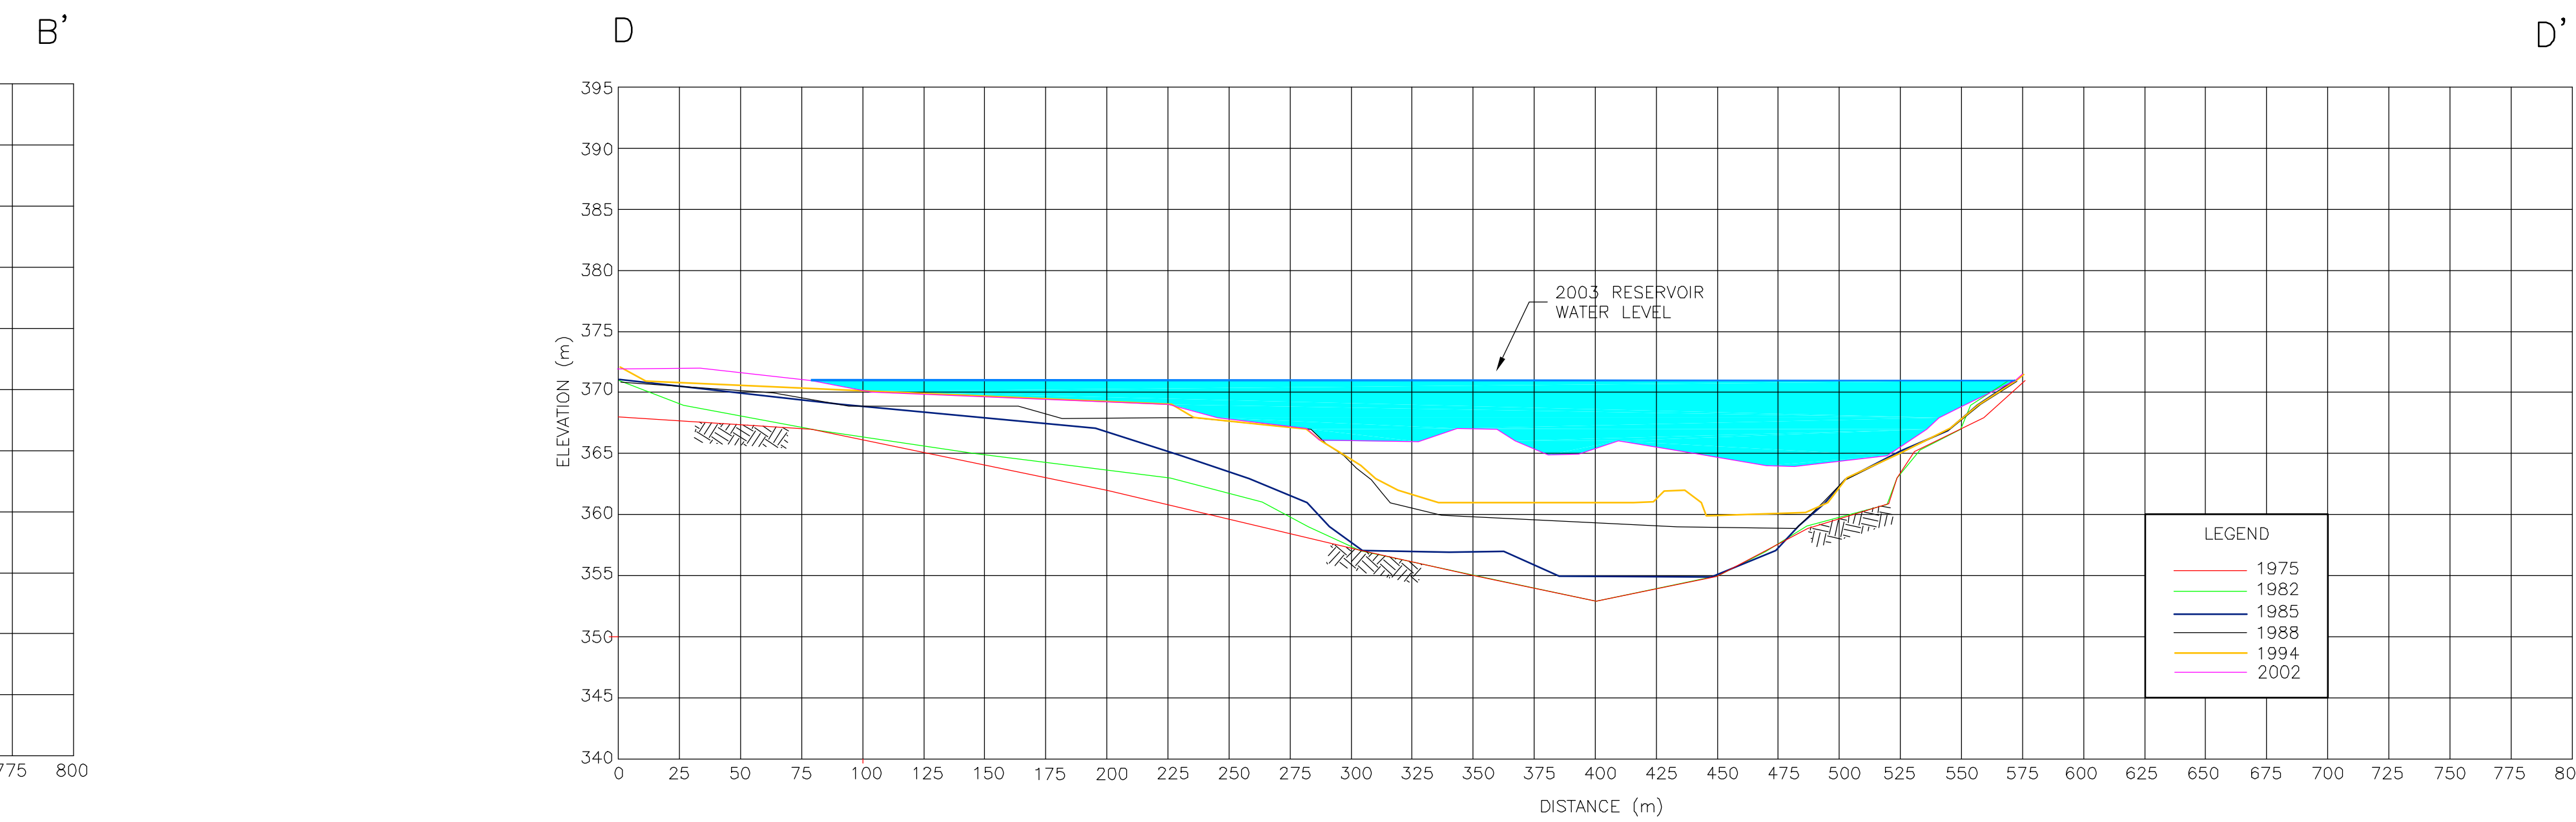

NOTES:  
1. 5X VERTICAL EXAGGERATION.  
2. GROUND ELEVATIONS ARE APPROXIMATE.

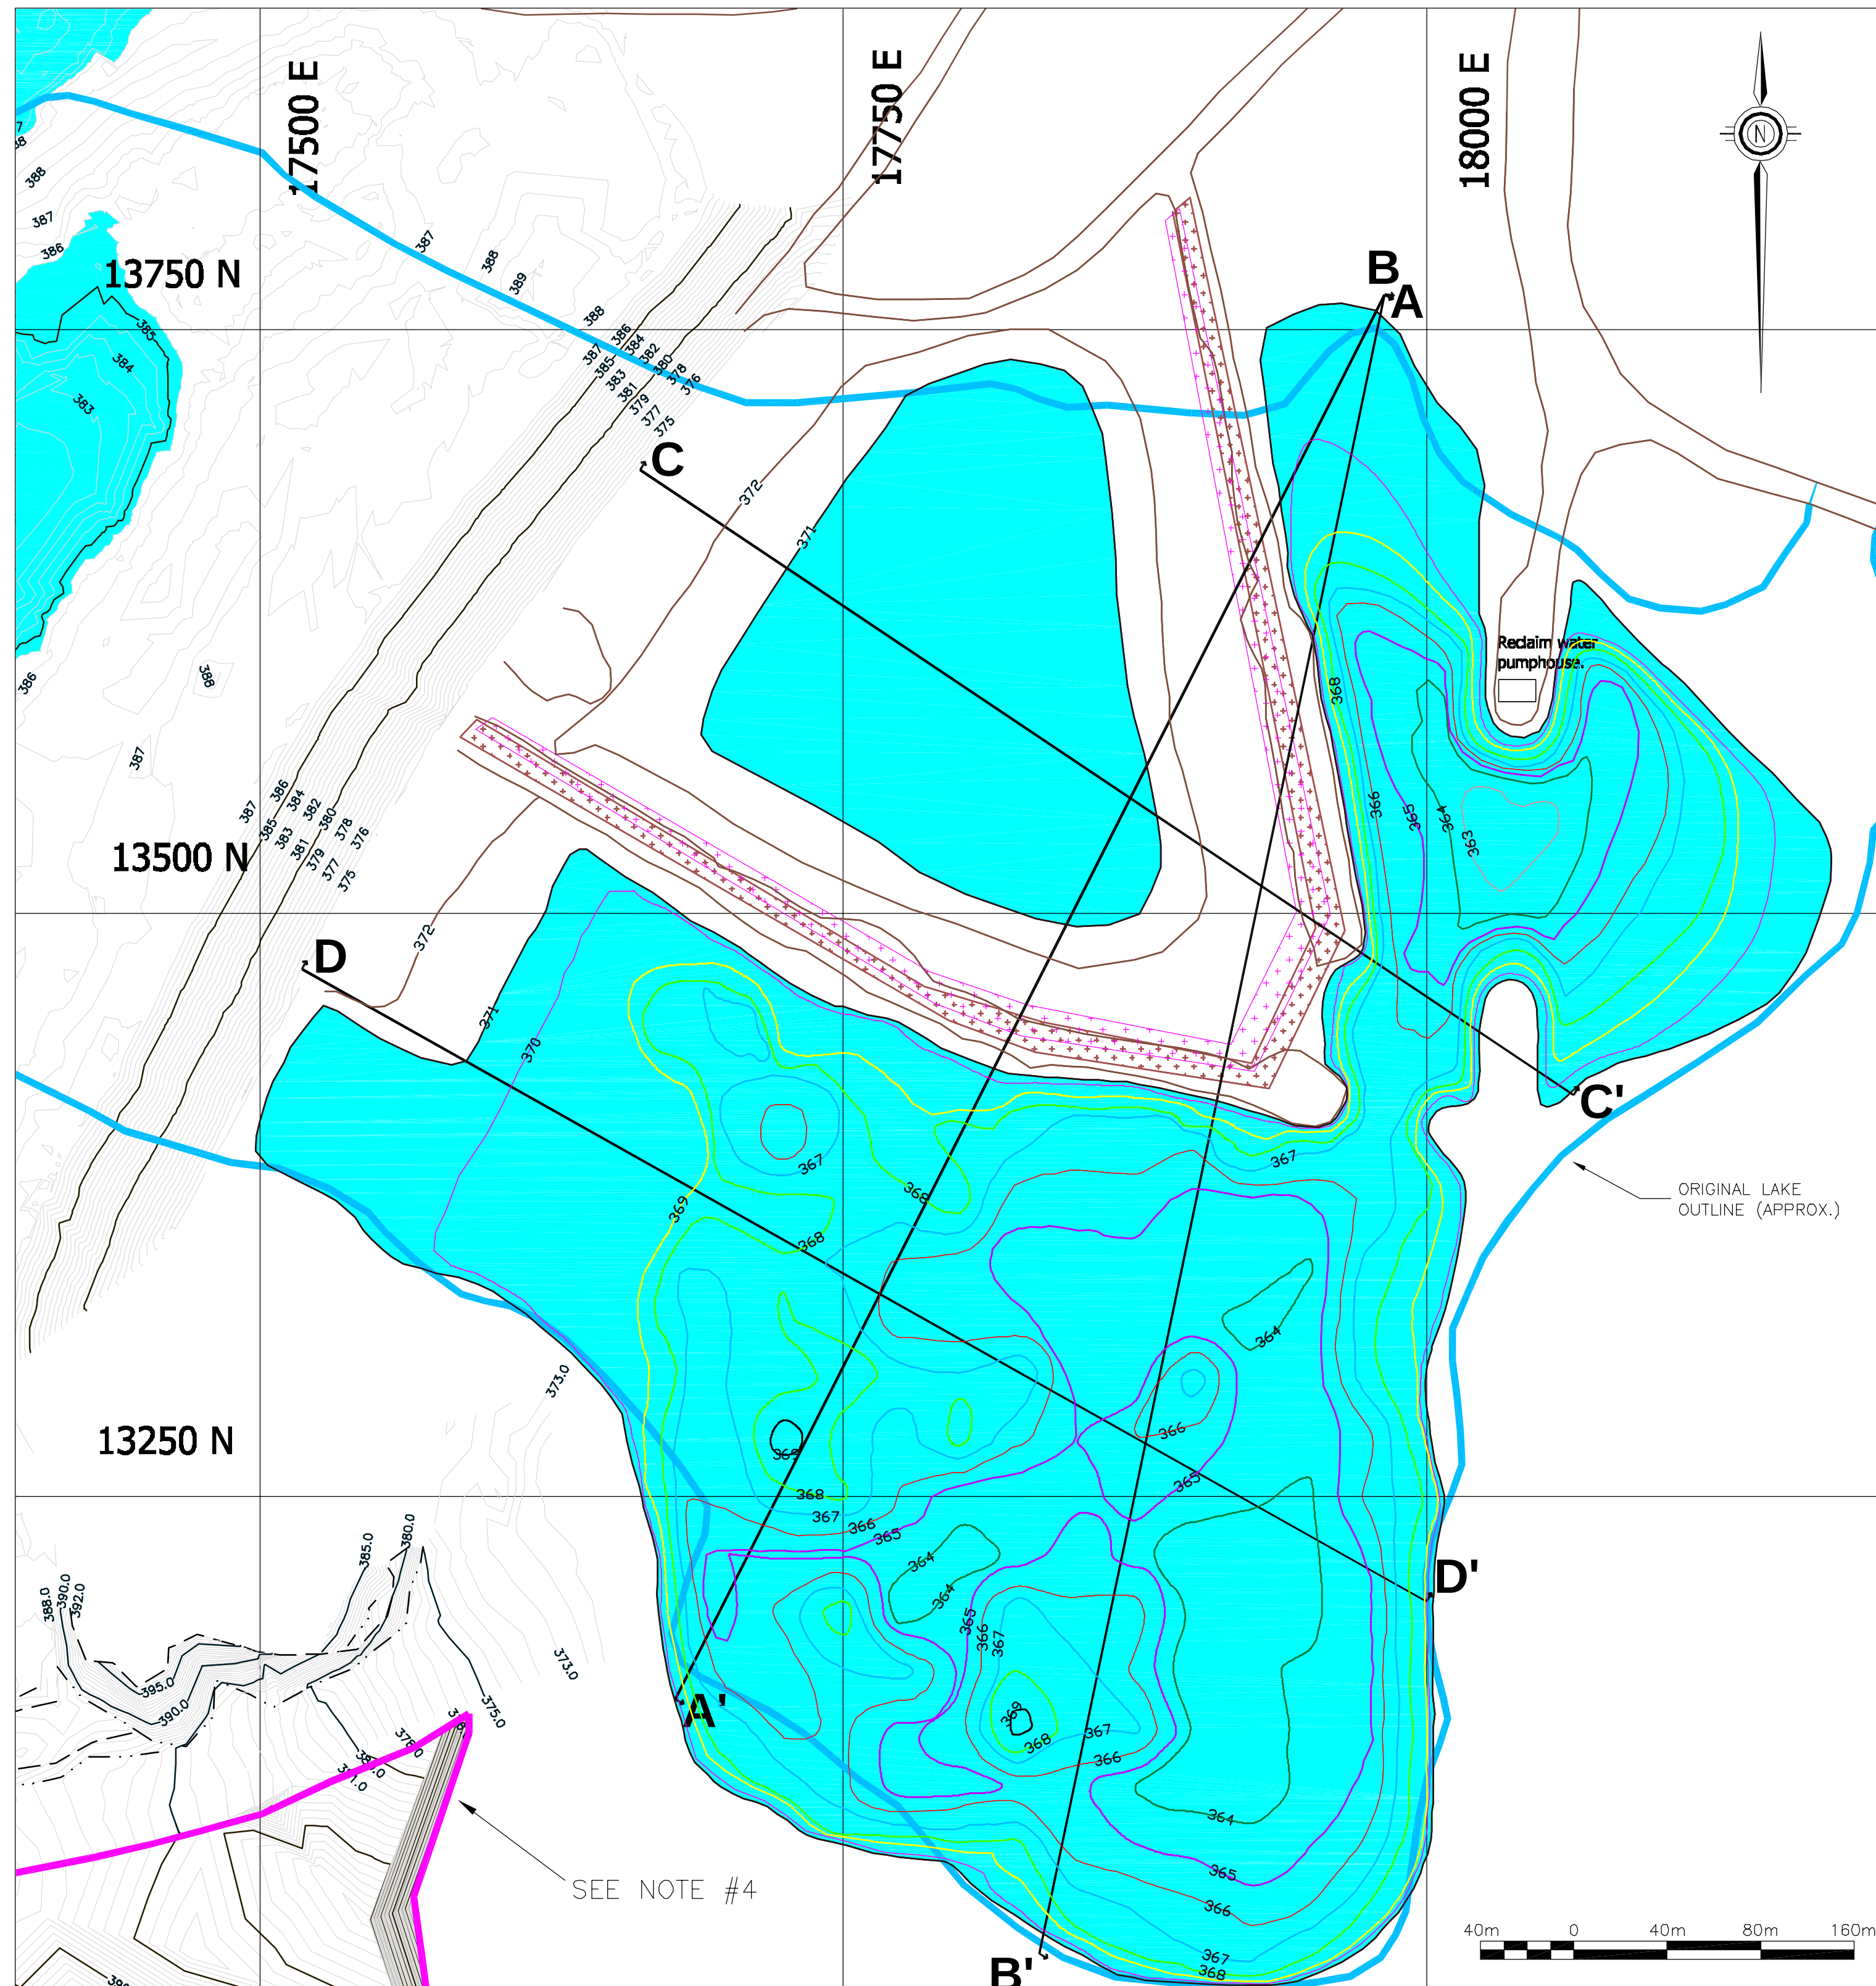

- NOTES:
- 2003 SURFACE CELL TOPOGRAPHY/BATHYMETRY SURVEYED BY S.A.S. SEPTEMBER, 2003.
  - CURRENT BATHYMETRY OF RESERVOIR AND TEST CELL FROM DRAWING New Final Bath V14.dwg SUPPLIED BY NANISIVIK MINE.
  - TOPOGRAPHY/BATHYMETRY OF RESERVOIR AND SURFACE CELL FOR ALL OTHER YEARS DERIVED FROM DRAWINGS SUPPLIED BY NANISIVIK MINE.
  - TOPOGRAPHY OF THIS AREA WAS DERIVED BY BGC USING ADDITIONAL DATA SUPPLIED BY NANISIVIK MINE.

CLIENT: NANISIVIK MINE  
A DIVISION OF CANZINCO LTD.

LEGEND

- WATER
- ORIGINAL GROUND ELEVATION

NOTES:

1. 2003 SURFACE CELL TOPOGRAPHY/BATHYMETRY SURVEYED BY S.A.S. SEPTEMBER, 2003.

2. CURRENT BATHYMETRY OF RESERVOIR AND TEST CELL FROM DRAWING New Final Bath V14.dwg SUPPLIED BY NANISIVIK MINE.

3. TOPOGRAPHY/BATHYMETRY OF RESERVOIR AND SURFACE CELL FOR ALL OTHER YEARS DERIVED FROM DRAWINGS SUPPLIED BY NANISIVIK MINE.

4. TOPOGRAPHY OF THIS AREA WAS DERIVED BY BGC USING ADDITIONAL DATA SUPPLIED BY NANISIVIK MINE.

| REV. | DATE | REVISION | NOTES | DRAWN | CHECKED | APPROVED |
|------|------|----------|-------|-------|---------|----------|
|      |      |          |       |       |         |          |

| PROJECT  | AS SHOWN |
|----------|----------|
| TITLE    | FEB 2004 |
| ISSUED   | CJT      |
| DESIGNED | GKC      |
| CHECKED  | JWC      |
| APPROVED | JWC      |

| PROJECT     | WEST TWIN DISPOSAL AREA CLOSURE PLAN                   |          |   |      |   |
|-------------|--------------------------------------------------------|----------|---|------|---|
| TITLE       | HISTORICAL TAILINGS DEPOSITION RESERVOIR AND TEST CELL |          |   |      |   |
| PROJECT No. | 0255-008-09                                            | DWG. No. | 7 | REV. | 0 |

**BGC ENGINEERING INC.**  
AN APPLIED EARTH SCIENCES COMPANY  
Calgary, AB Phone: (403) 250 5185