


PLOT DATE: March 04, 2004
FILENAME: T:\Projects\2003\03-1118-049 (BR, Nanisivik)\-DA-BGC Supplemental\031118049DA23.DWG




Downstream Side Of Weir Plate Showing Valves

EXISTING POLISHING POND OUTLET

FIGURE 23

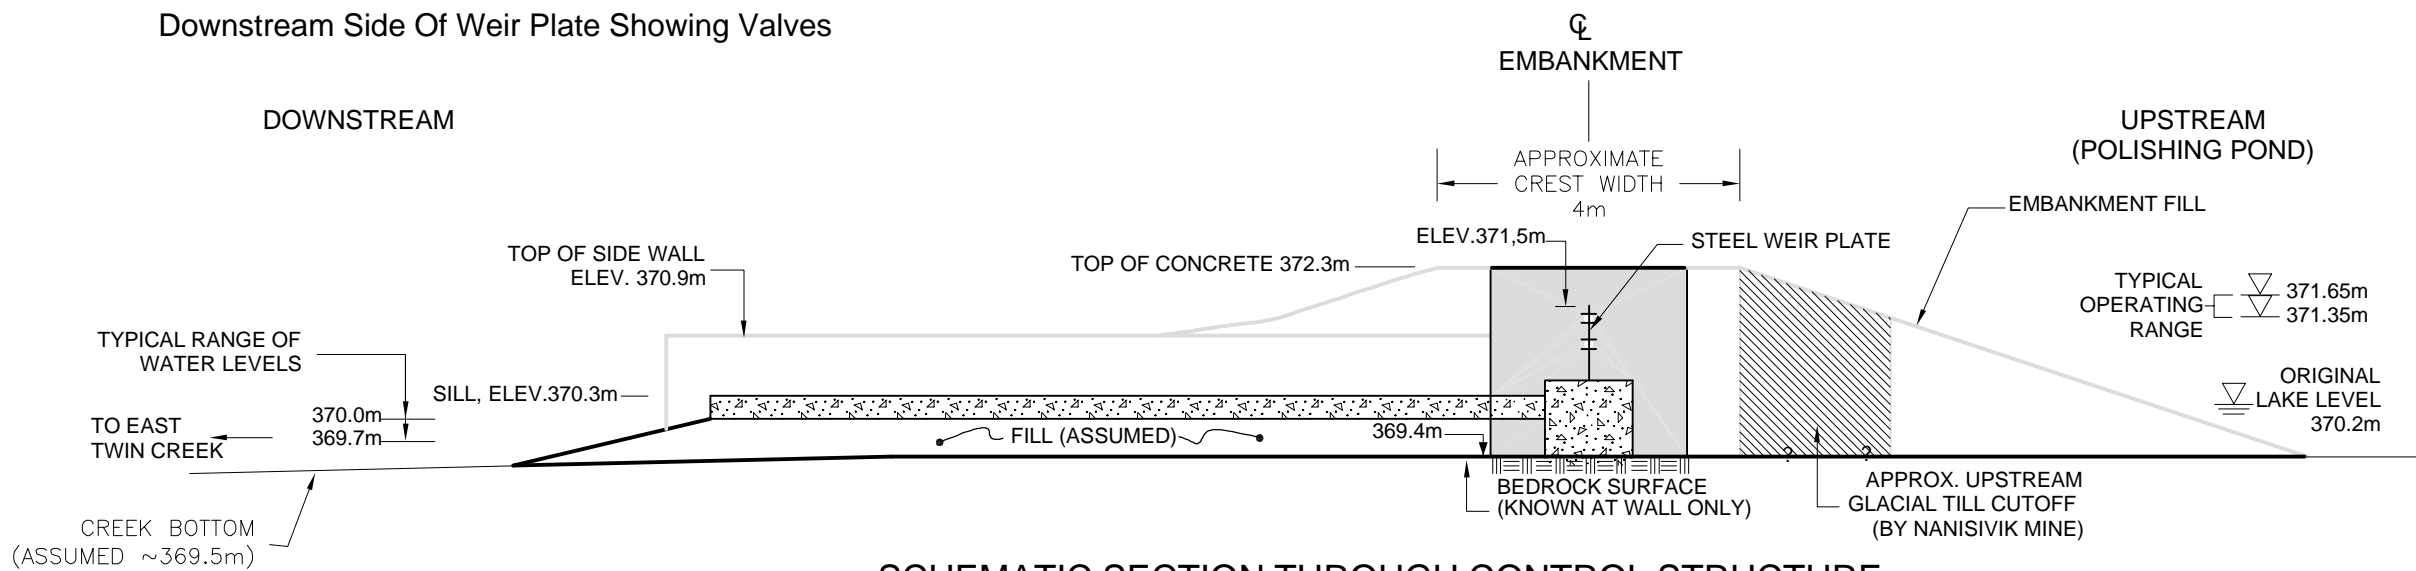

SCHEMATIC SECTION THROUGH CONTROL STRUCTURE
POLISHING POND OUTLET

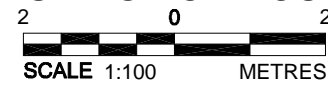

NOTE:
THIS DRAWING WAS PREPARED USING THE ORIGINAL AS-BUILT DRAWING (KILBORN 1977), NANISIVIK MINE AS-BUILT DRAWING (GLACIAL TILL CUTOFF), AND SITE OBSERVATIONS/PHOTOGRAPHS.



Control Structure Outfall



Upstream Side Of Control Structure

DATE: MARCH, 2004
PROJECT: 03-1118-049



CAD: TDR
CHK: DGR