

APPENDIX 11

RECORD of CONTAMINATED SOILS EXCAVATED AND DISPOSAL LOCATIONS IN THE MINE

TABLE 1
POLARIS MINE - CONTAMINATED SOILS EXCAVATED
TO DECEMBER 31, 2004

¹ Contaminated Soil Locations	DRP Forecast Volumes To Be Excavated (m ³ in-situ volume)		⁴ Estimated Volumes Excavated To Date (m ³ in-situ volume)		Estimated Volumes Excavated During 2004 (m ³ in-situ volume)		³ Total Volumes Excavated (m ³ in-situ volume)	
	Hydrocarbons	Metals	Hydrocarbons	Metals	Hydrocarbons	Metals	Hydrocarbons	Metals
North Portal Pb Ore Stockpile Area	-	TBA	-	11,352	-	-	-	11,352
Fuel Bladder Storage Area	12,000	-	12,513	-	-	-	12,513	-
Old Crusher	-	TBA	-	1,079	-	-	-	1,079
Tails Thickener/ Tailings Lines	TBA	3,000	-	2,183	-	-	-	2,183
CRF Plant	100	-	40	-	-	-	40	-
Exploration Dump & Stockpile Area		TBA	-	11,028	-	10,607	-	21,635
Firehall Training Area	2,000		1,465	-	11,747	5,048	13,212	5,048
Concentrate Storage Shed Area	Note 2	Note 2	-	24,314	1,731	26,869	1,731	51,183
Barge Area	20,000	85,000	28,314	-	48,164	31,985	76,478	31,985
Dock Cells			12,210		3,519	8,481	15,729	8,481
Shoreline				44,645	-	(9,666)	-	34,979
Foldaway Buildings	2,000	-	628	110	15,946	161	16,574	271
Incinerator Area							4,390	6,110
Accommodation Building	500	-	-	-	1,800	-	1,800	-
Quonset Huts	TBA	-	-	-	-	-	-	-
Snow Dumps		3,500		1,641	-	14,000	-	15,641
Lube Storage / Tank Farm Area	-	-			3,150	-	3,150	-
June 2002 Fuel Spill	Note 3	-	-	-	580	-	580	-
Miscellaneous	-		-	-	628	110	628	110
TOTALS	36,600	91,500	55,170	96,352	87,265	87,595	146,825	190,057
TOTAL CONTAMINANTS	128,100		151,522		174,860		336,882	

Notes:

Note 1 - Some area boundaries have changed from the 2003 4th Quarter report as volumes presented are based on surveyed data which has changed the definition of some of the areas.

Note 2 - DRP estimated metals contaminated soils in the Concentrate Storage Area and the Barge area together as one quantity.

Note 3 - this fuel spill occurred after the DRP was issued so there was not estimate for it.

Note 4 - Total volumes are based on surveys of remediated areas.

Abbreviations:

DRP - Decommissioning and Reclamation Plan

TBA - Areas identified in the DRP as being contaminated but no estimate of volumes were made as investigations were not completed.

TABLE 2
POLARIS MINE - CONTAMINATED SOILS HANDLING TO DECEMBER 31, 2004


HYDROCARBON CONTAMINATED SOILS		METALS CONTAMINATED SOILS		TOTALS CONTAMINATED SOILS (M ³)		
LRDQL	MINE	LRDQL	MINE	LRDQL	MINE	TOTAL
0	146,844	80,324	109,774	80,324	256,618	336,942


NOTES:


Hydrocarbon Soils include Co-contaminated (Metals & Hydrocarbons)


LRDQL - refers to Little Red Dog Quarry Landfill


MINE - refers to the underground working of the mine

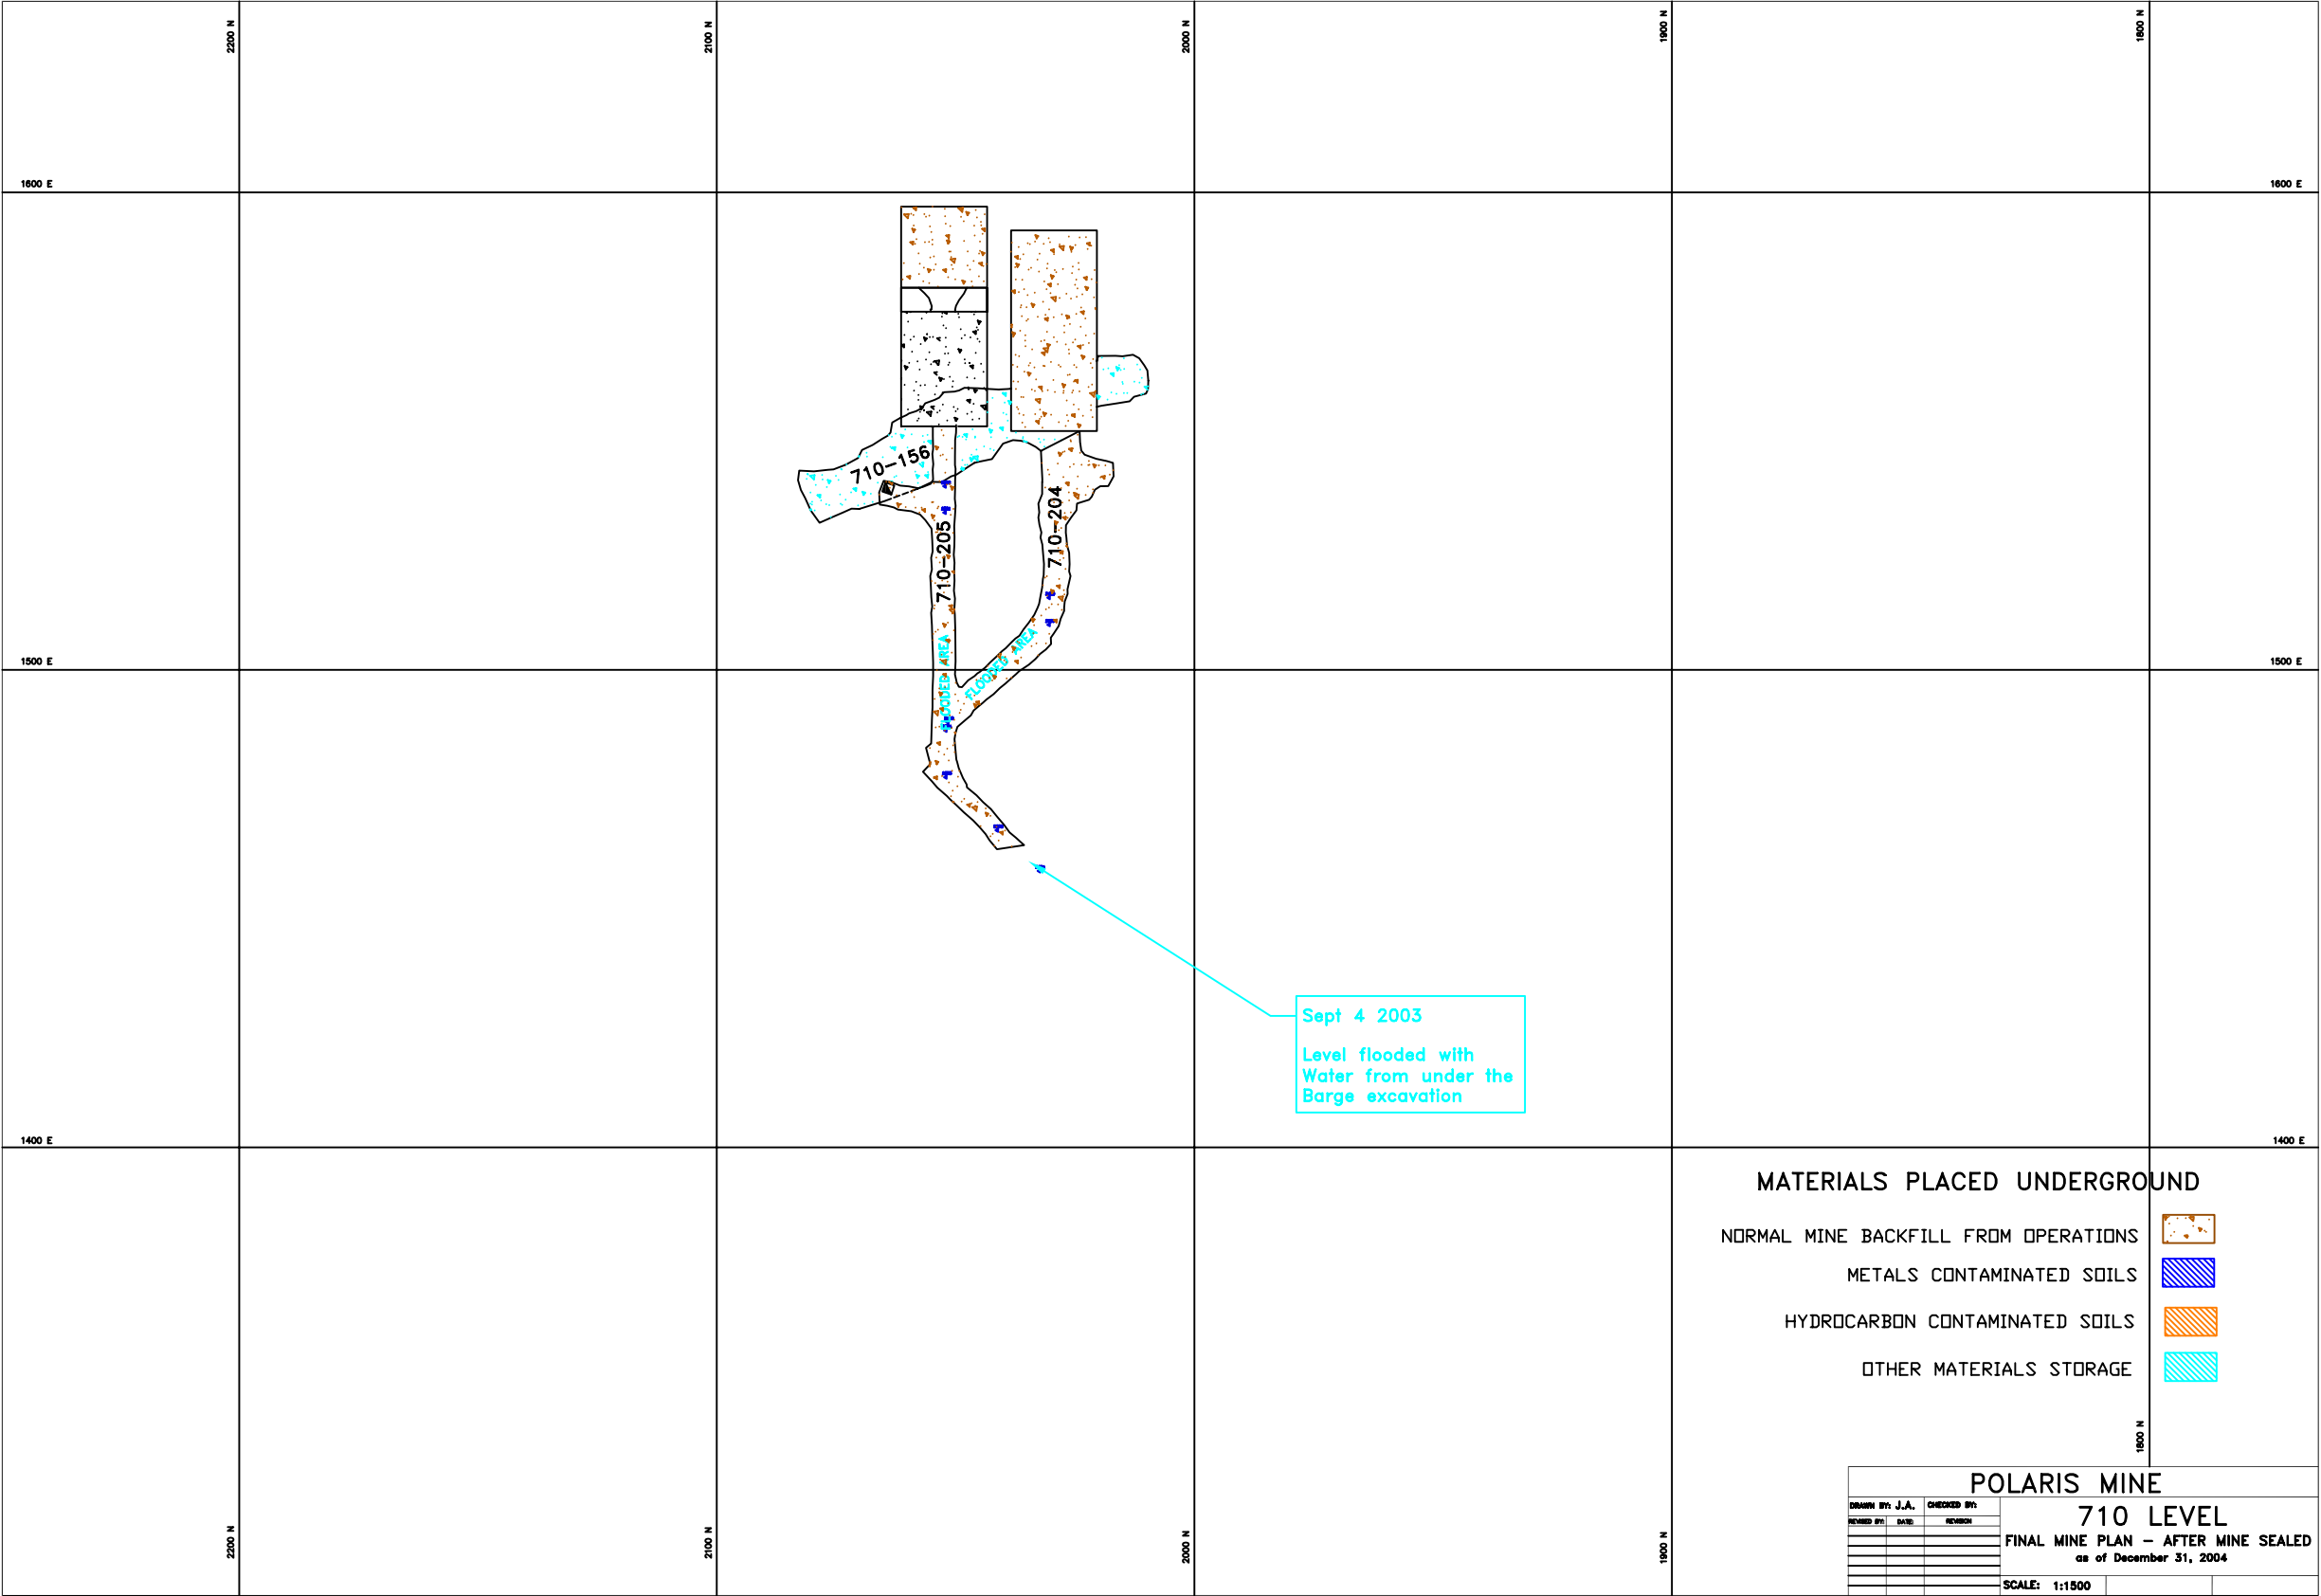


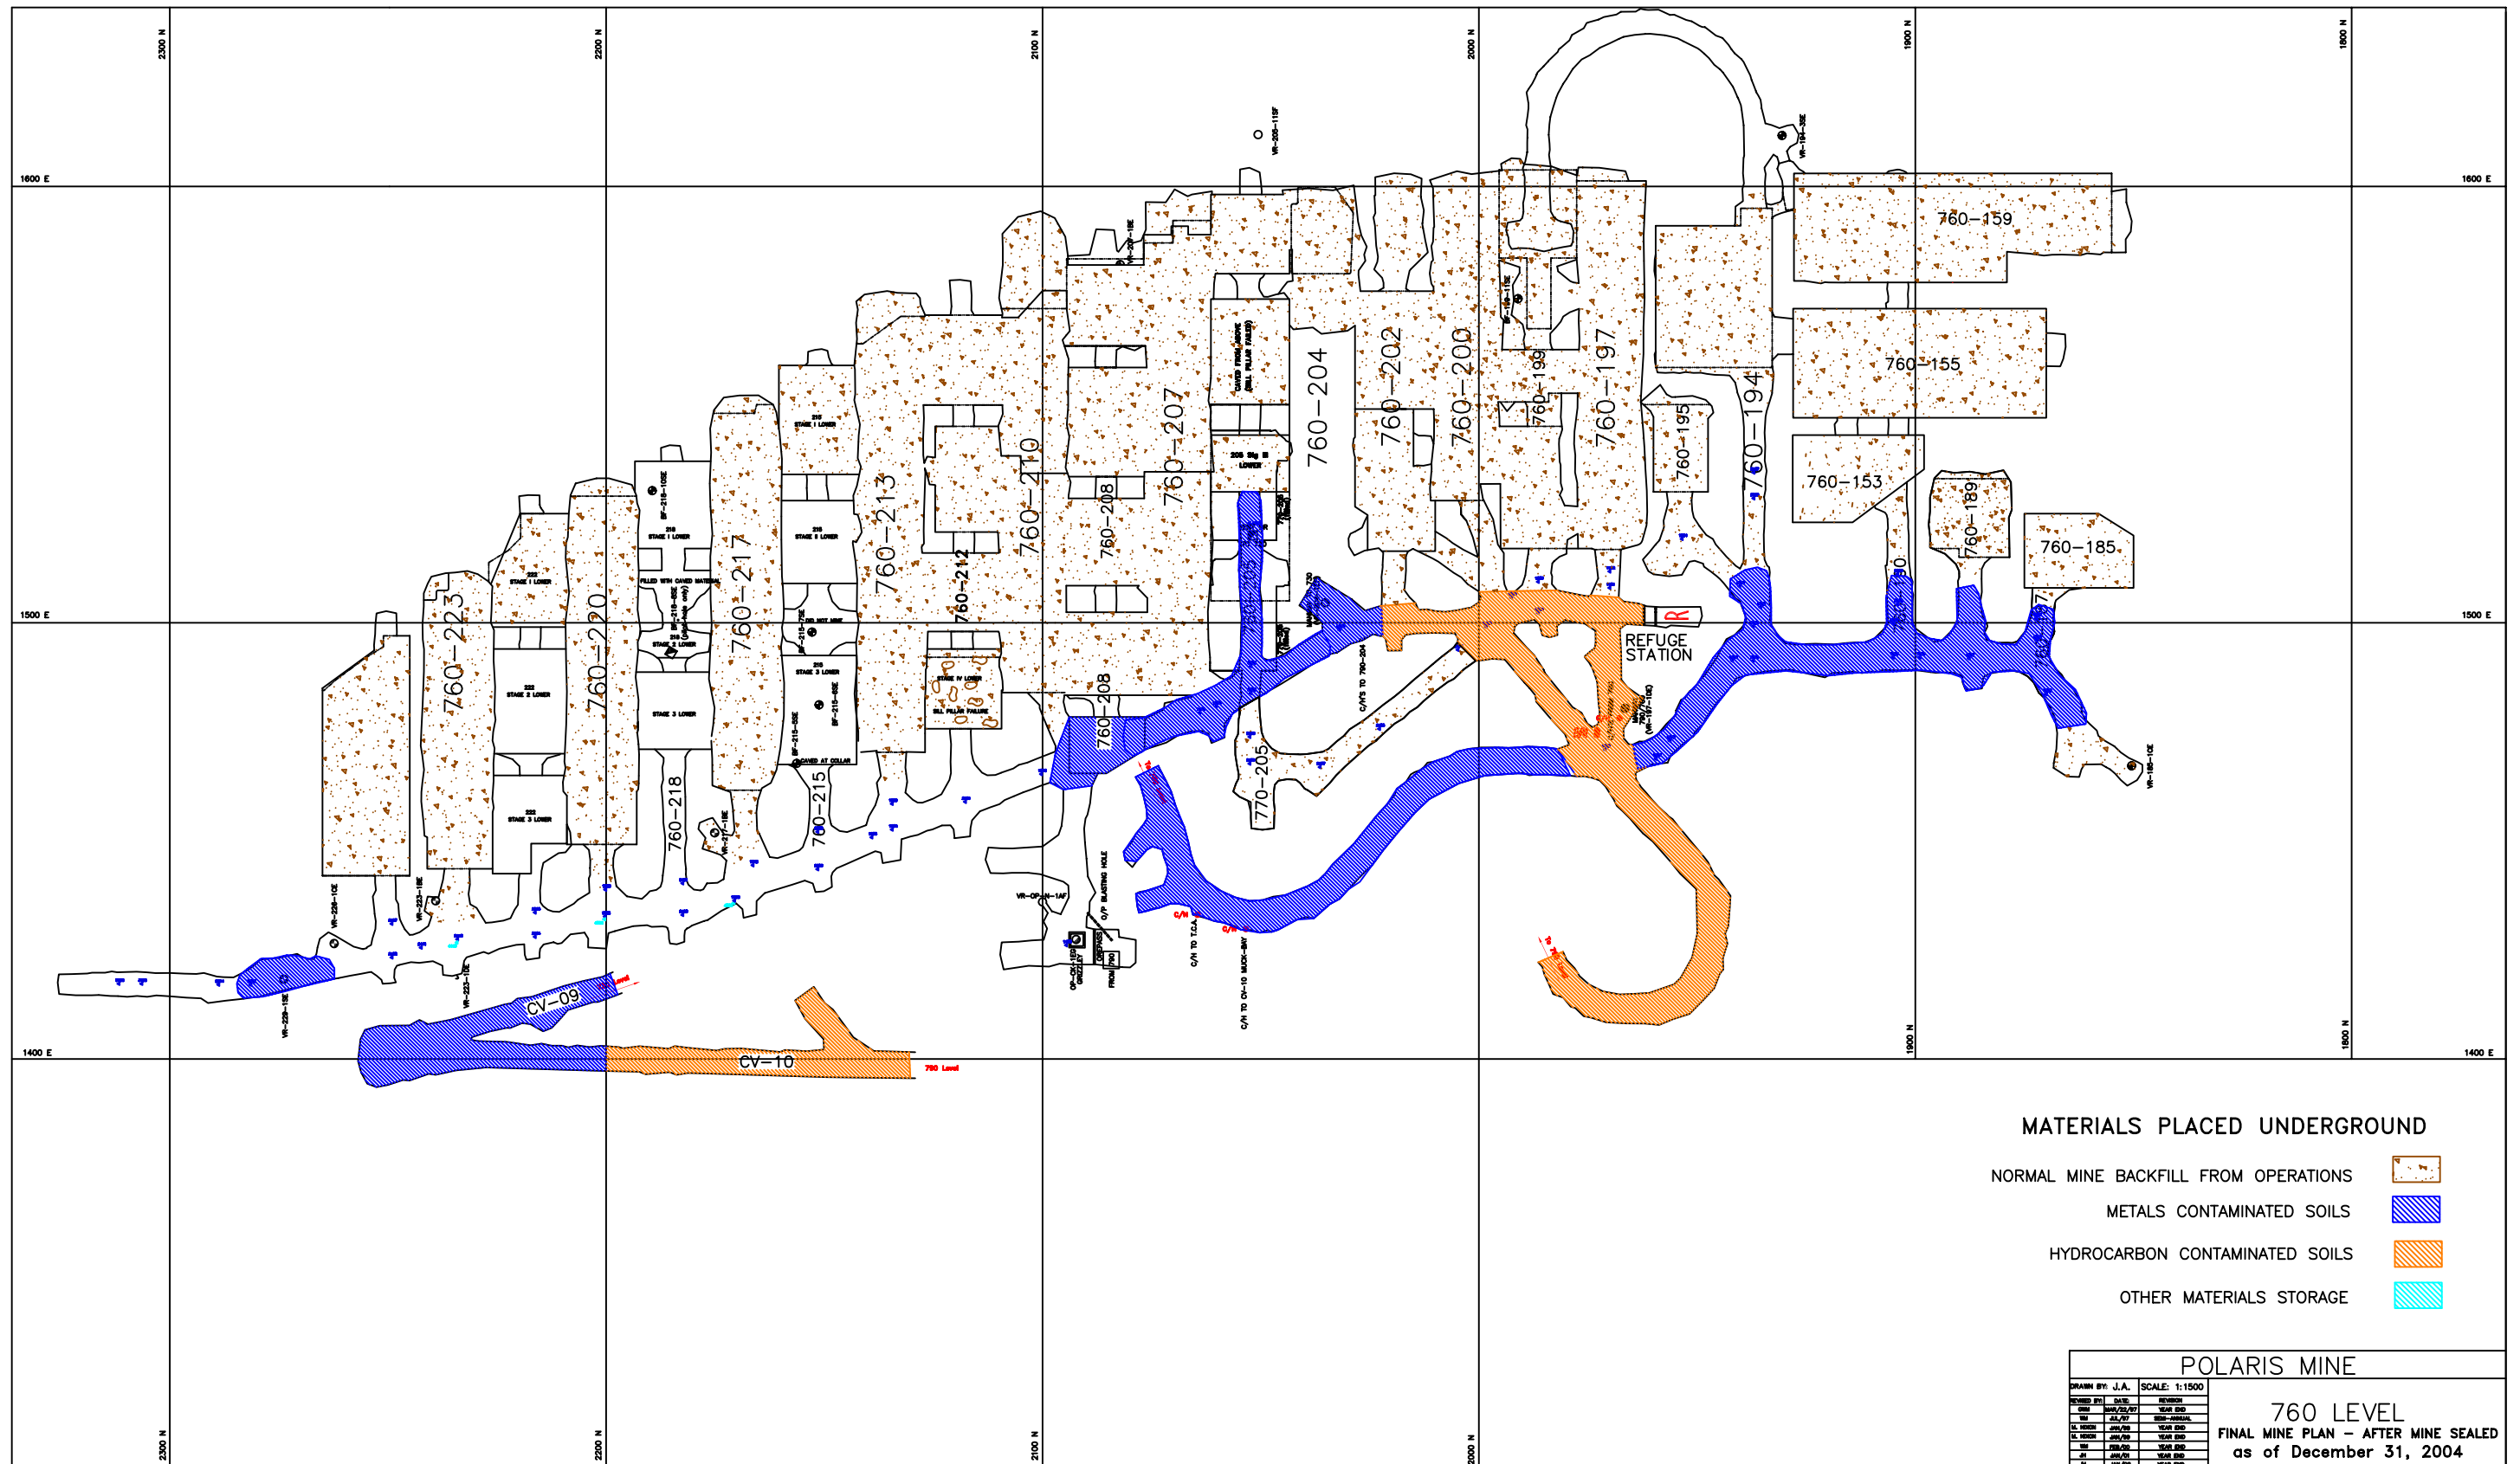

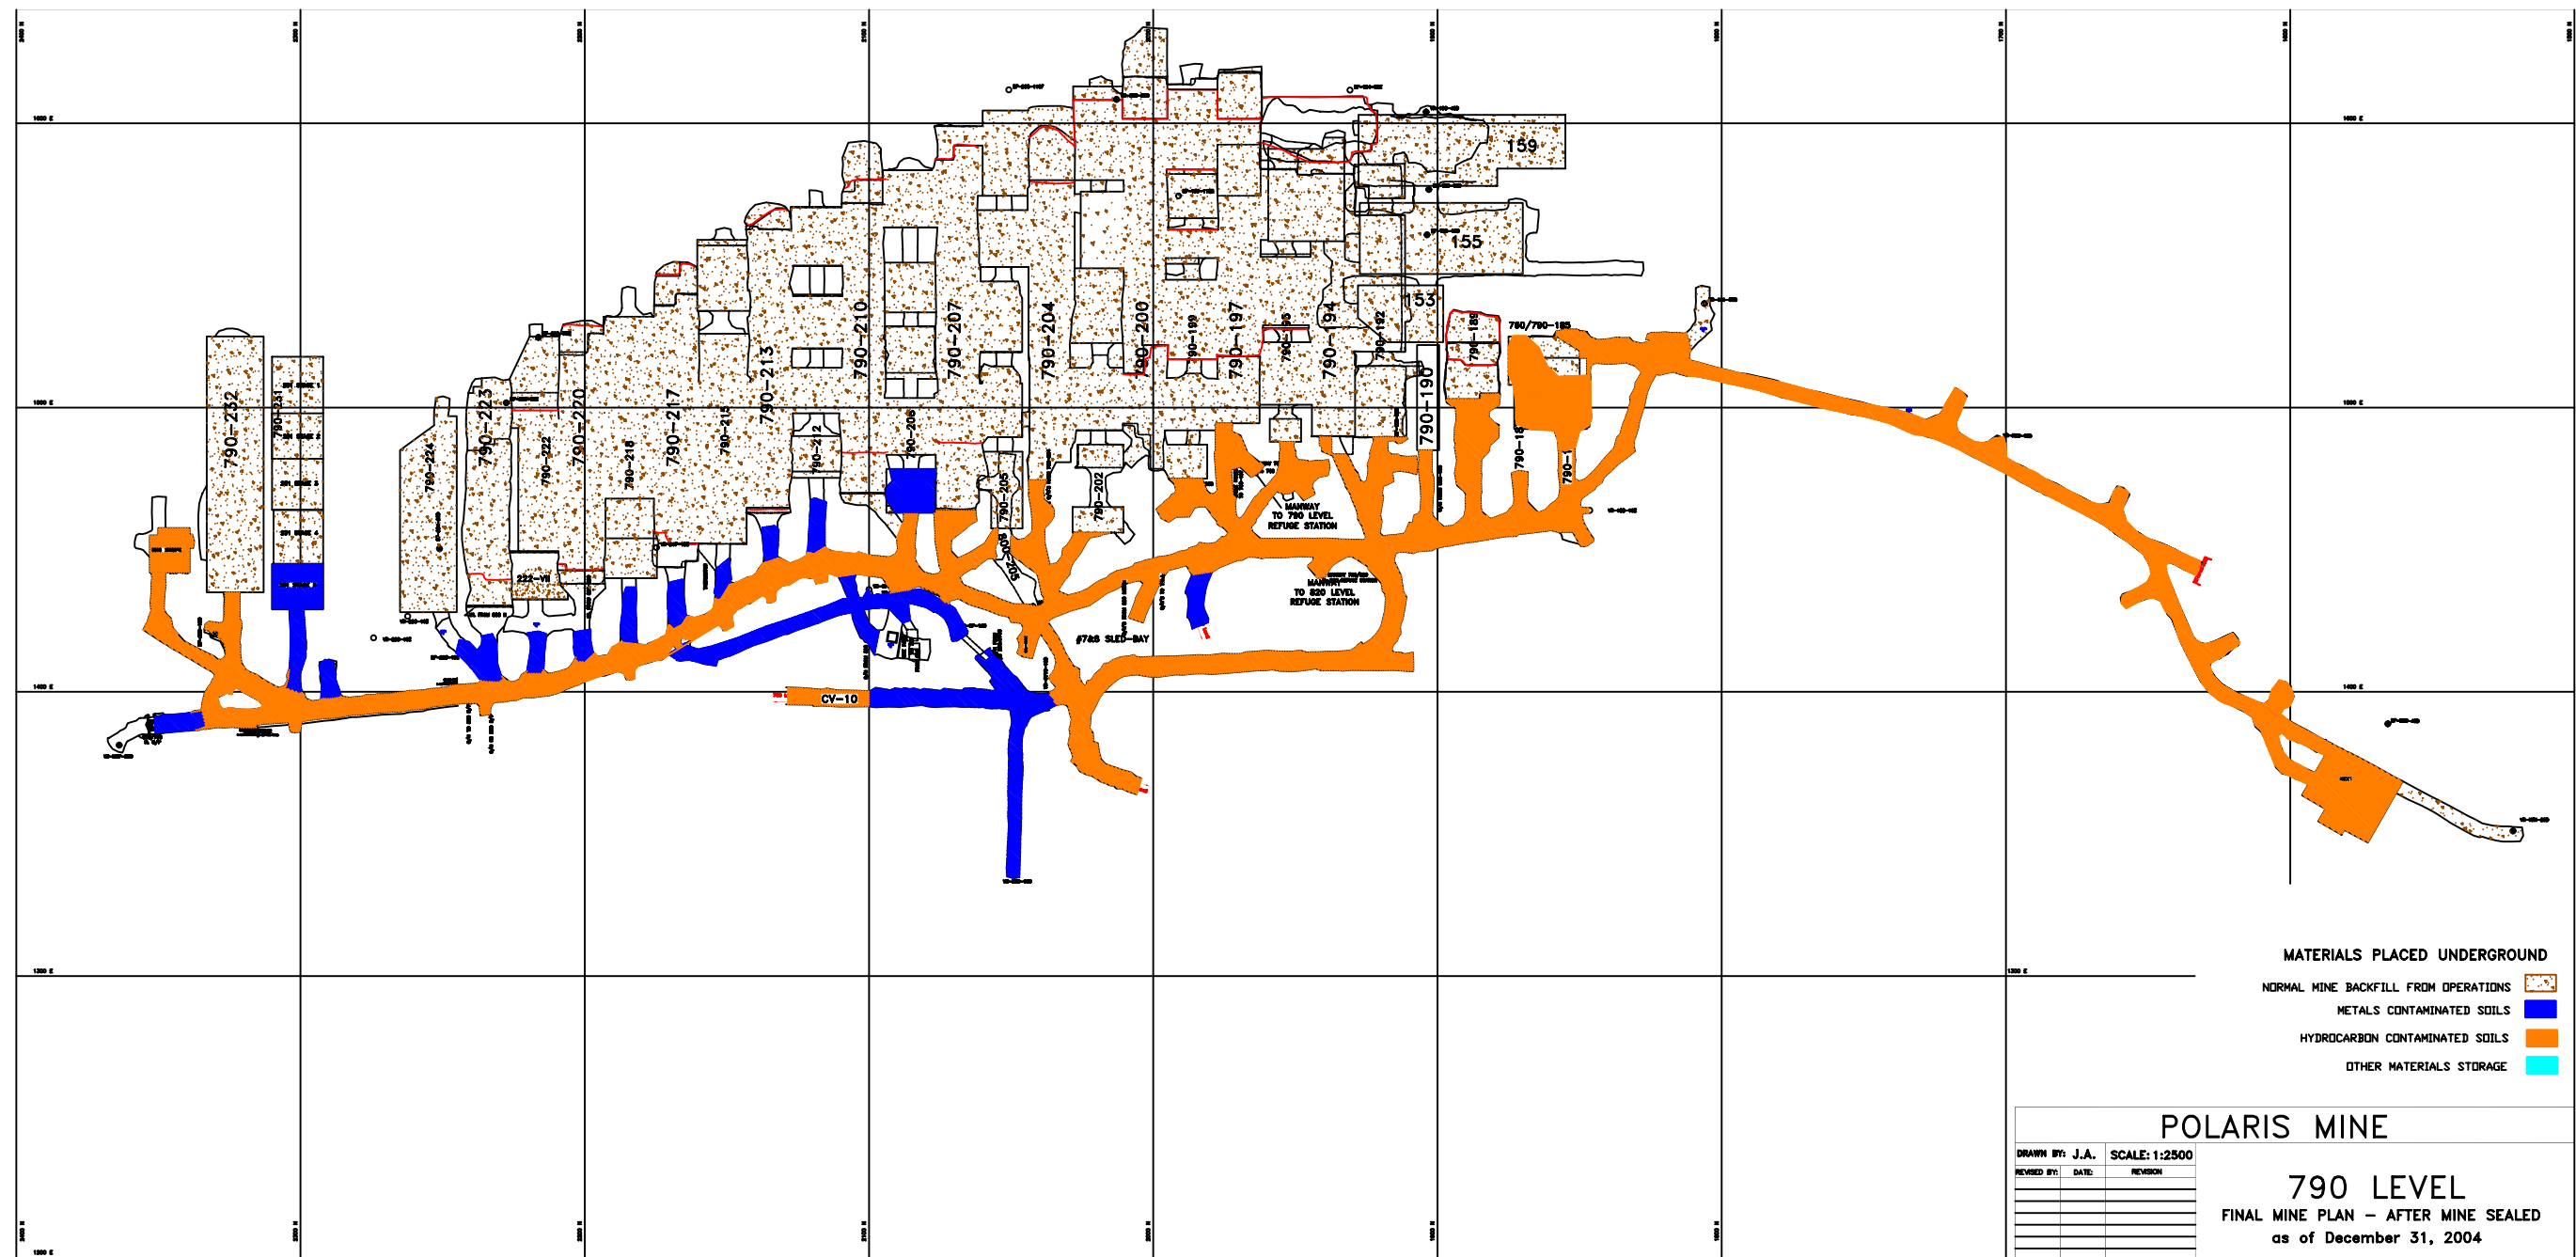


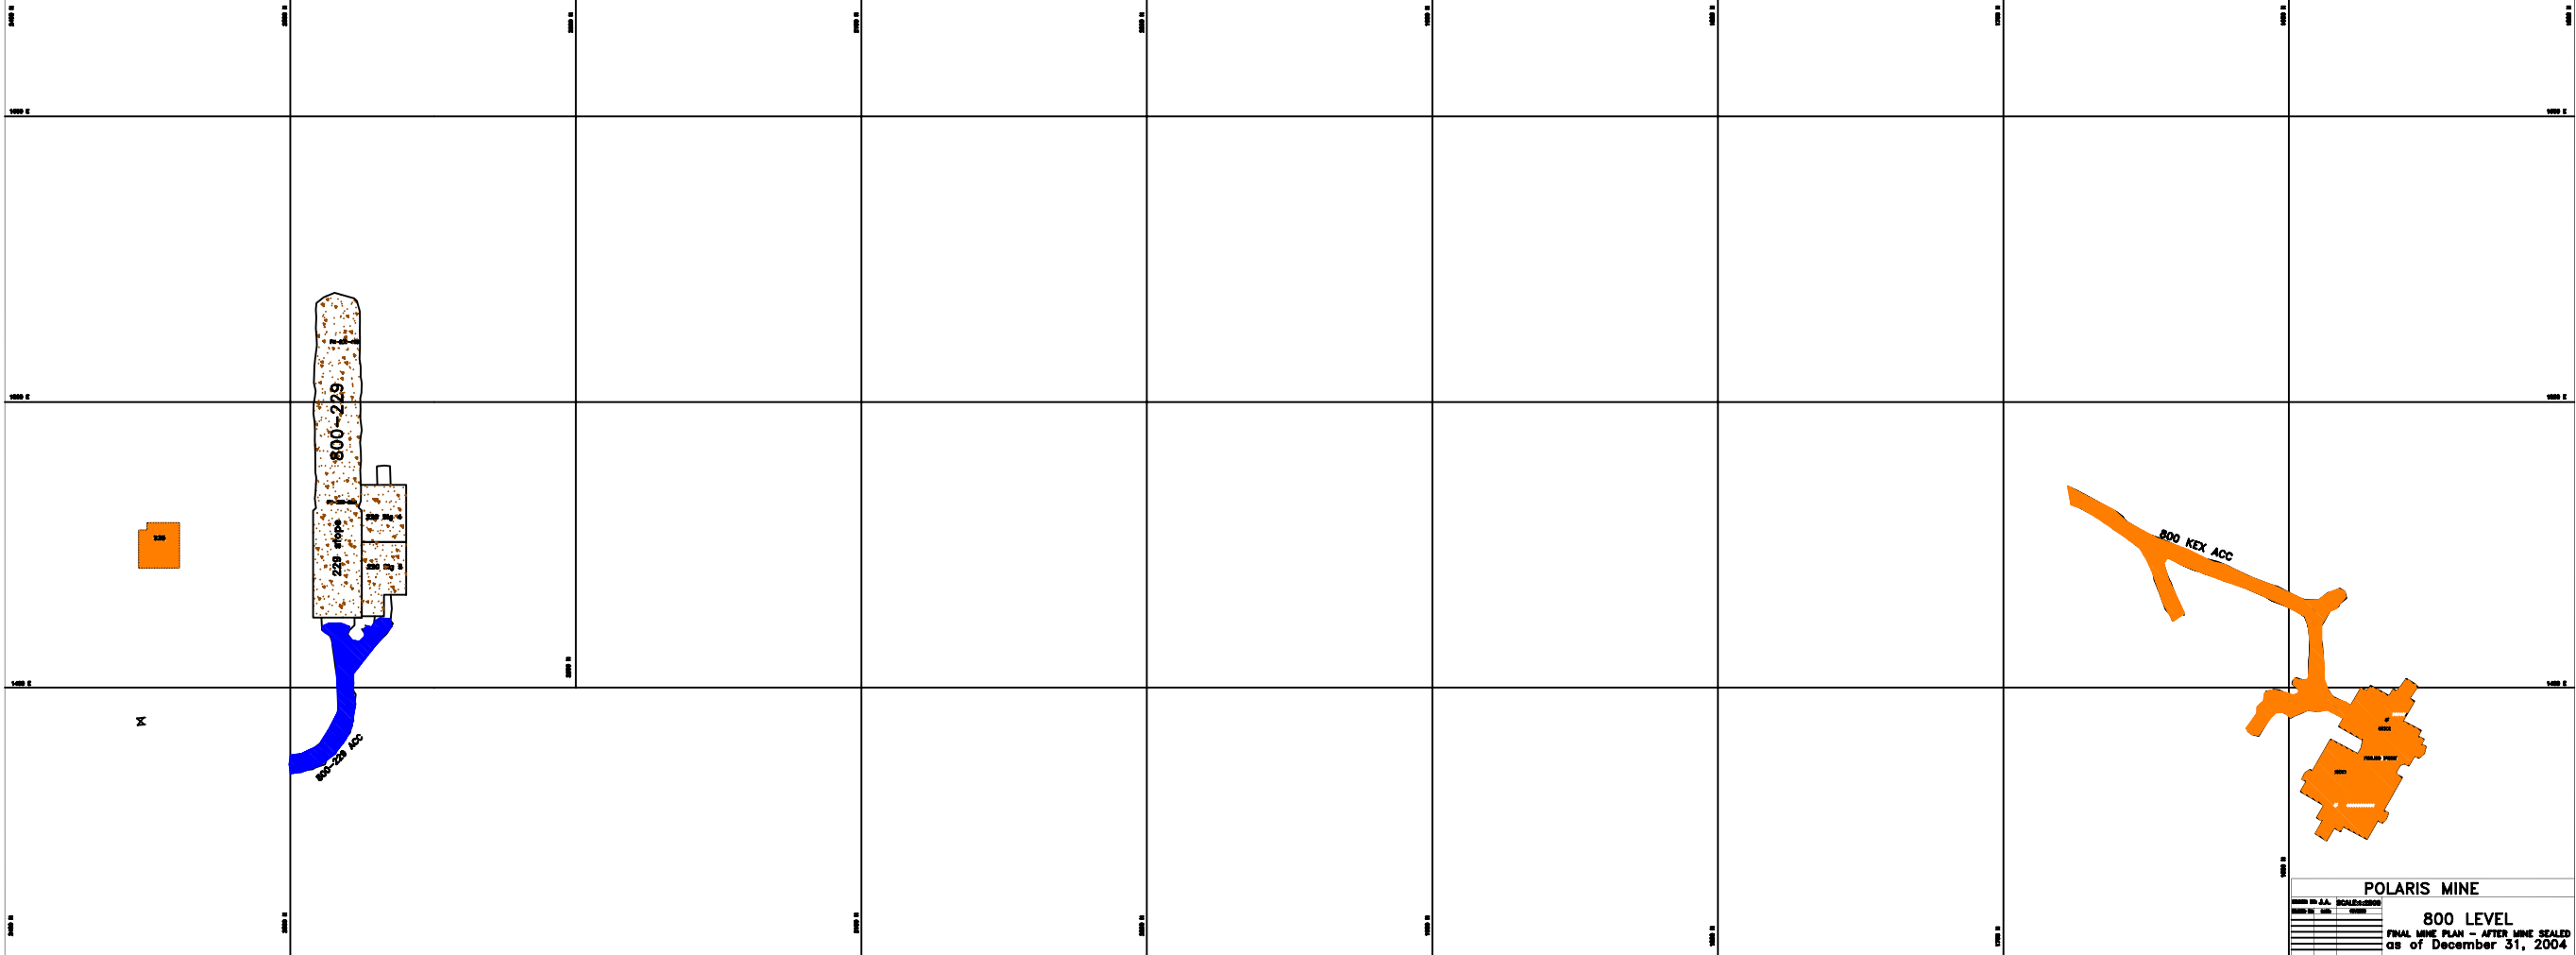


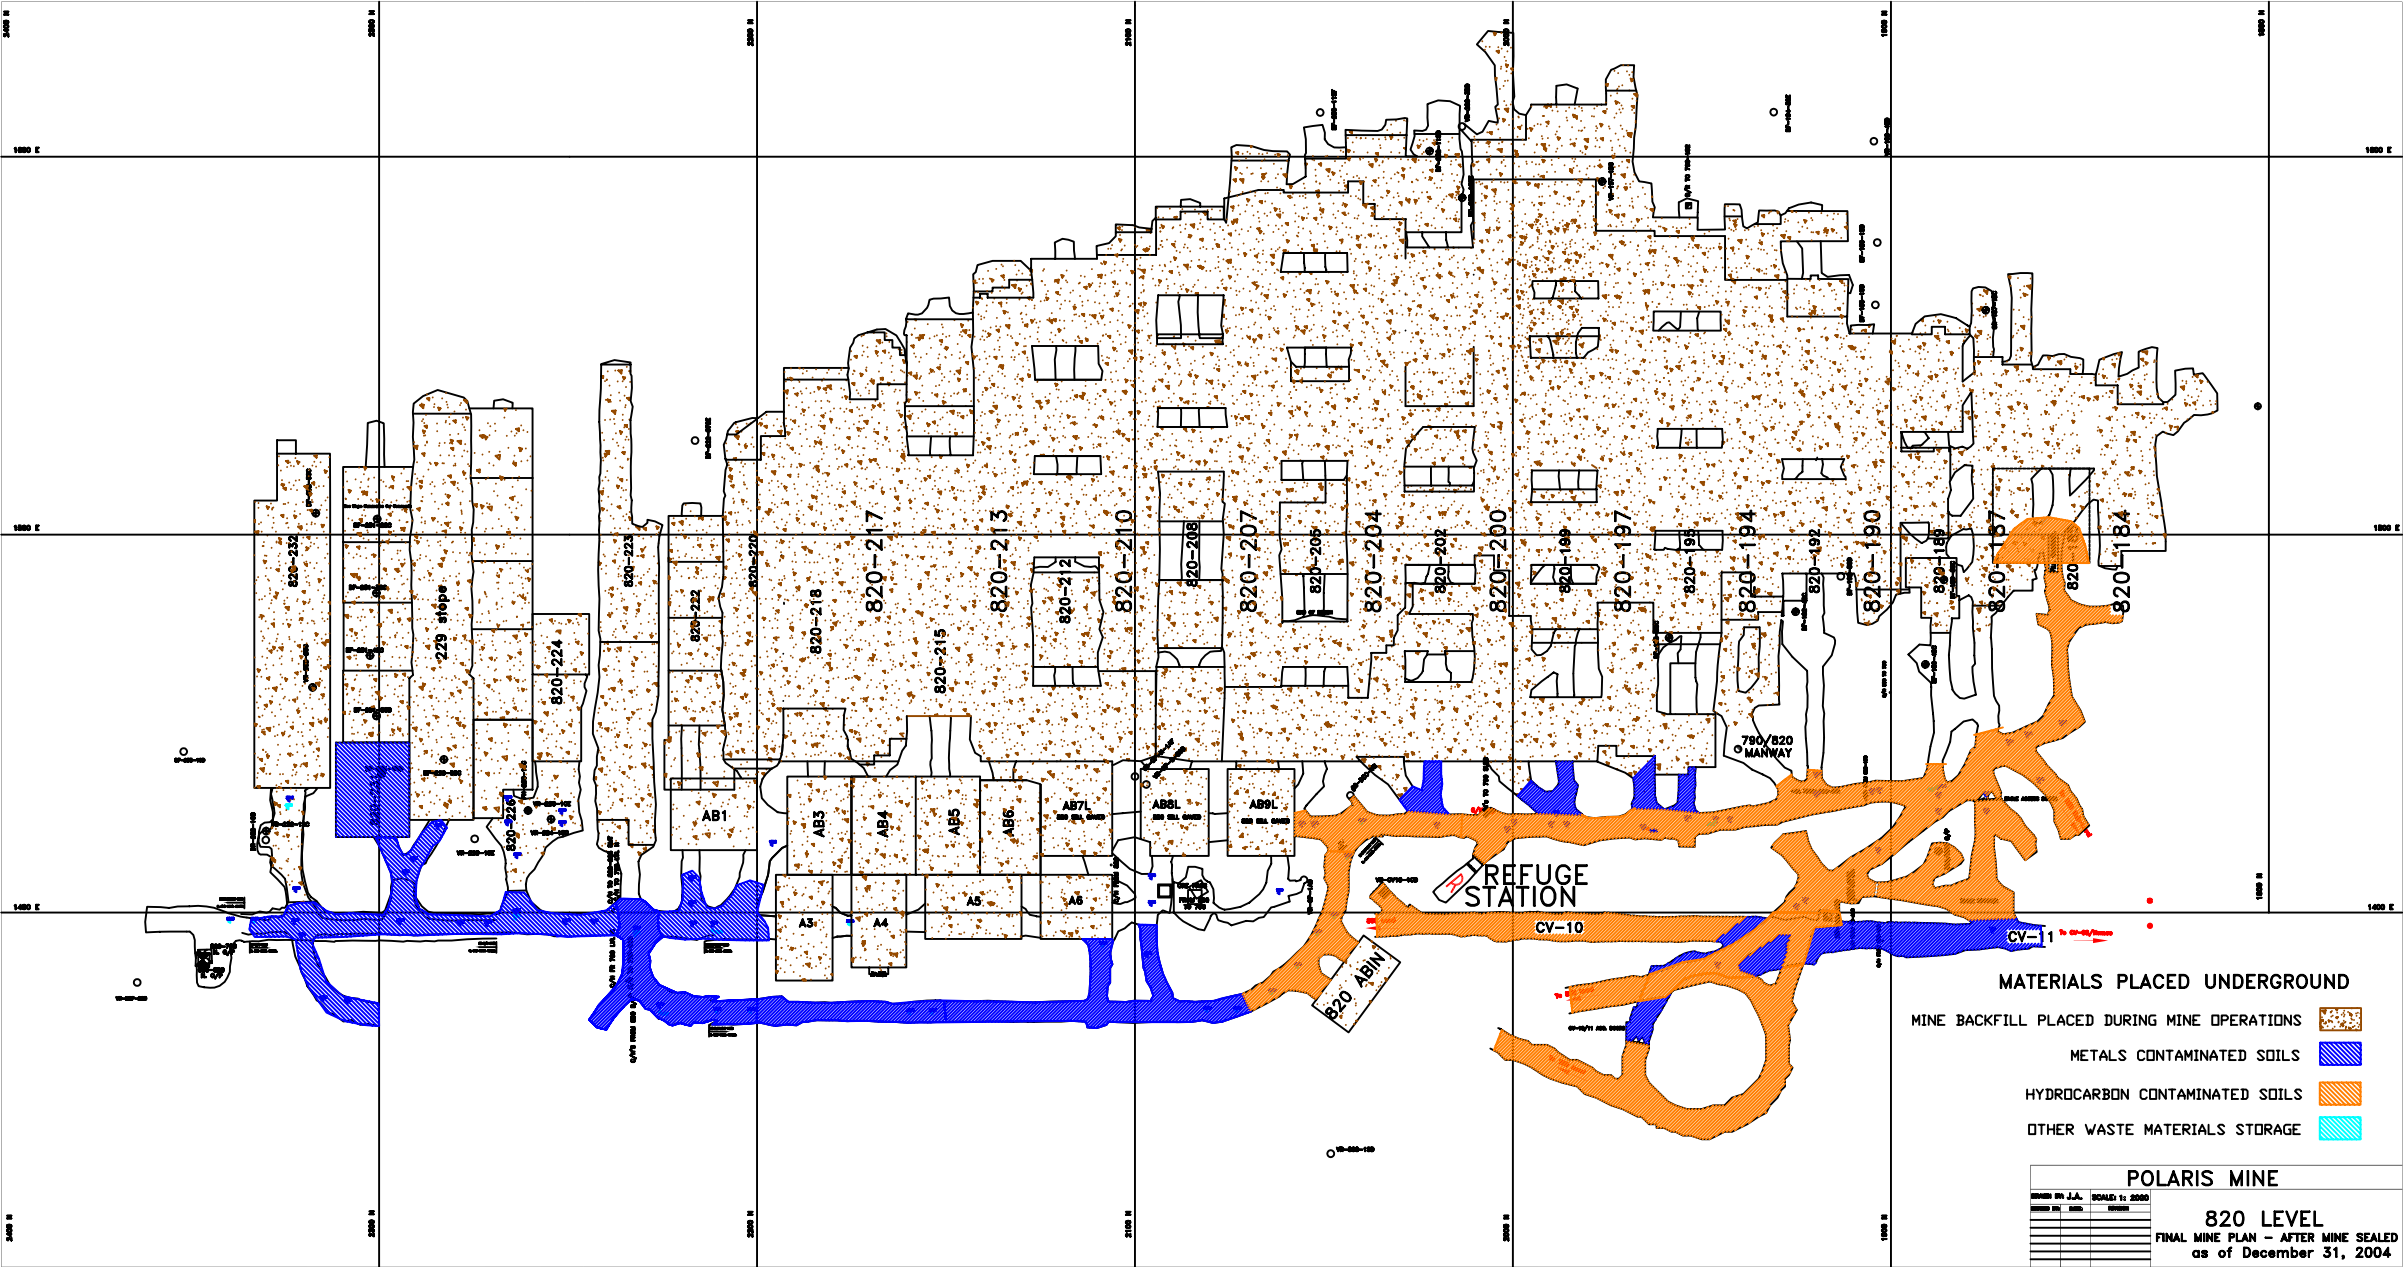

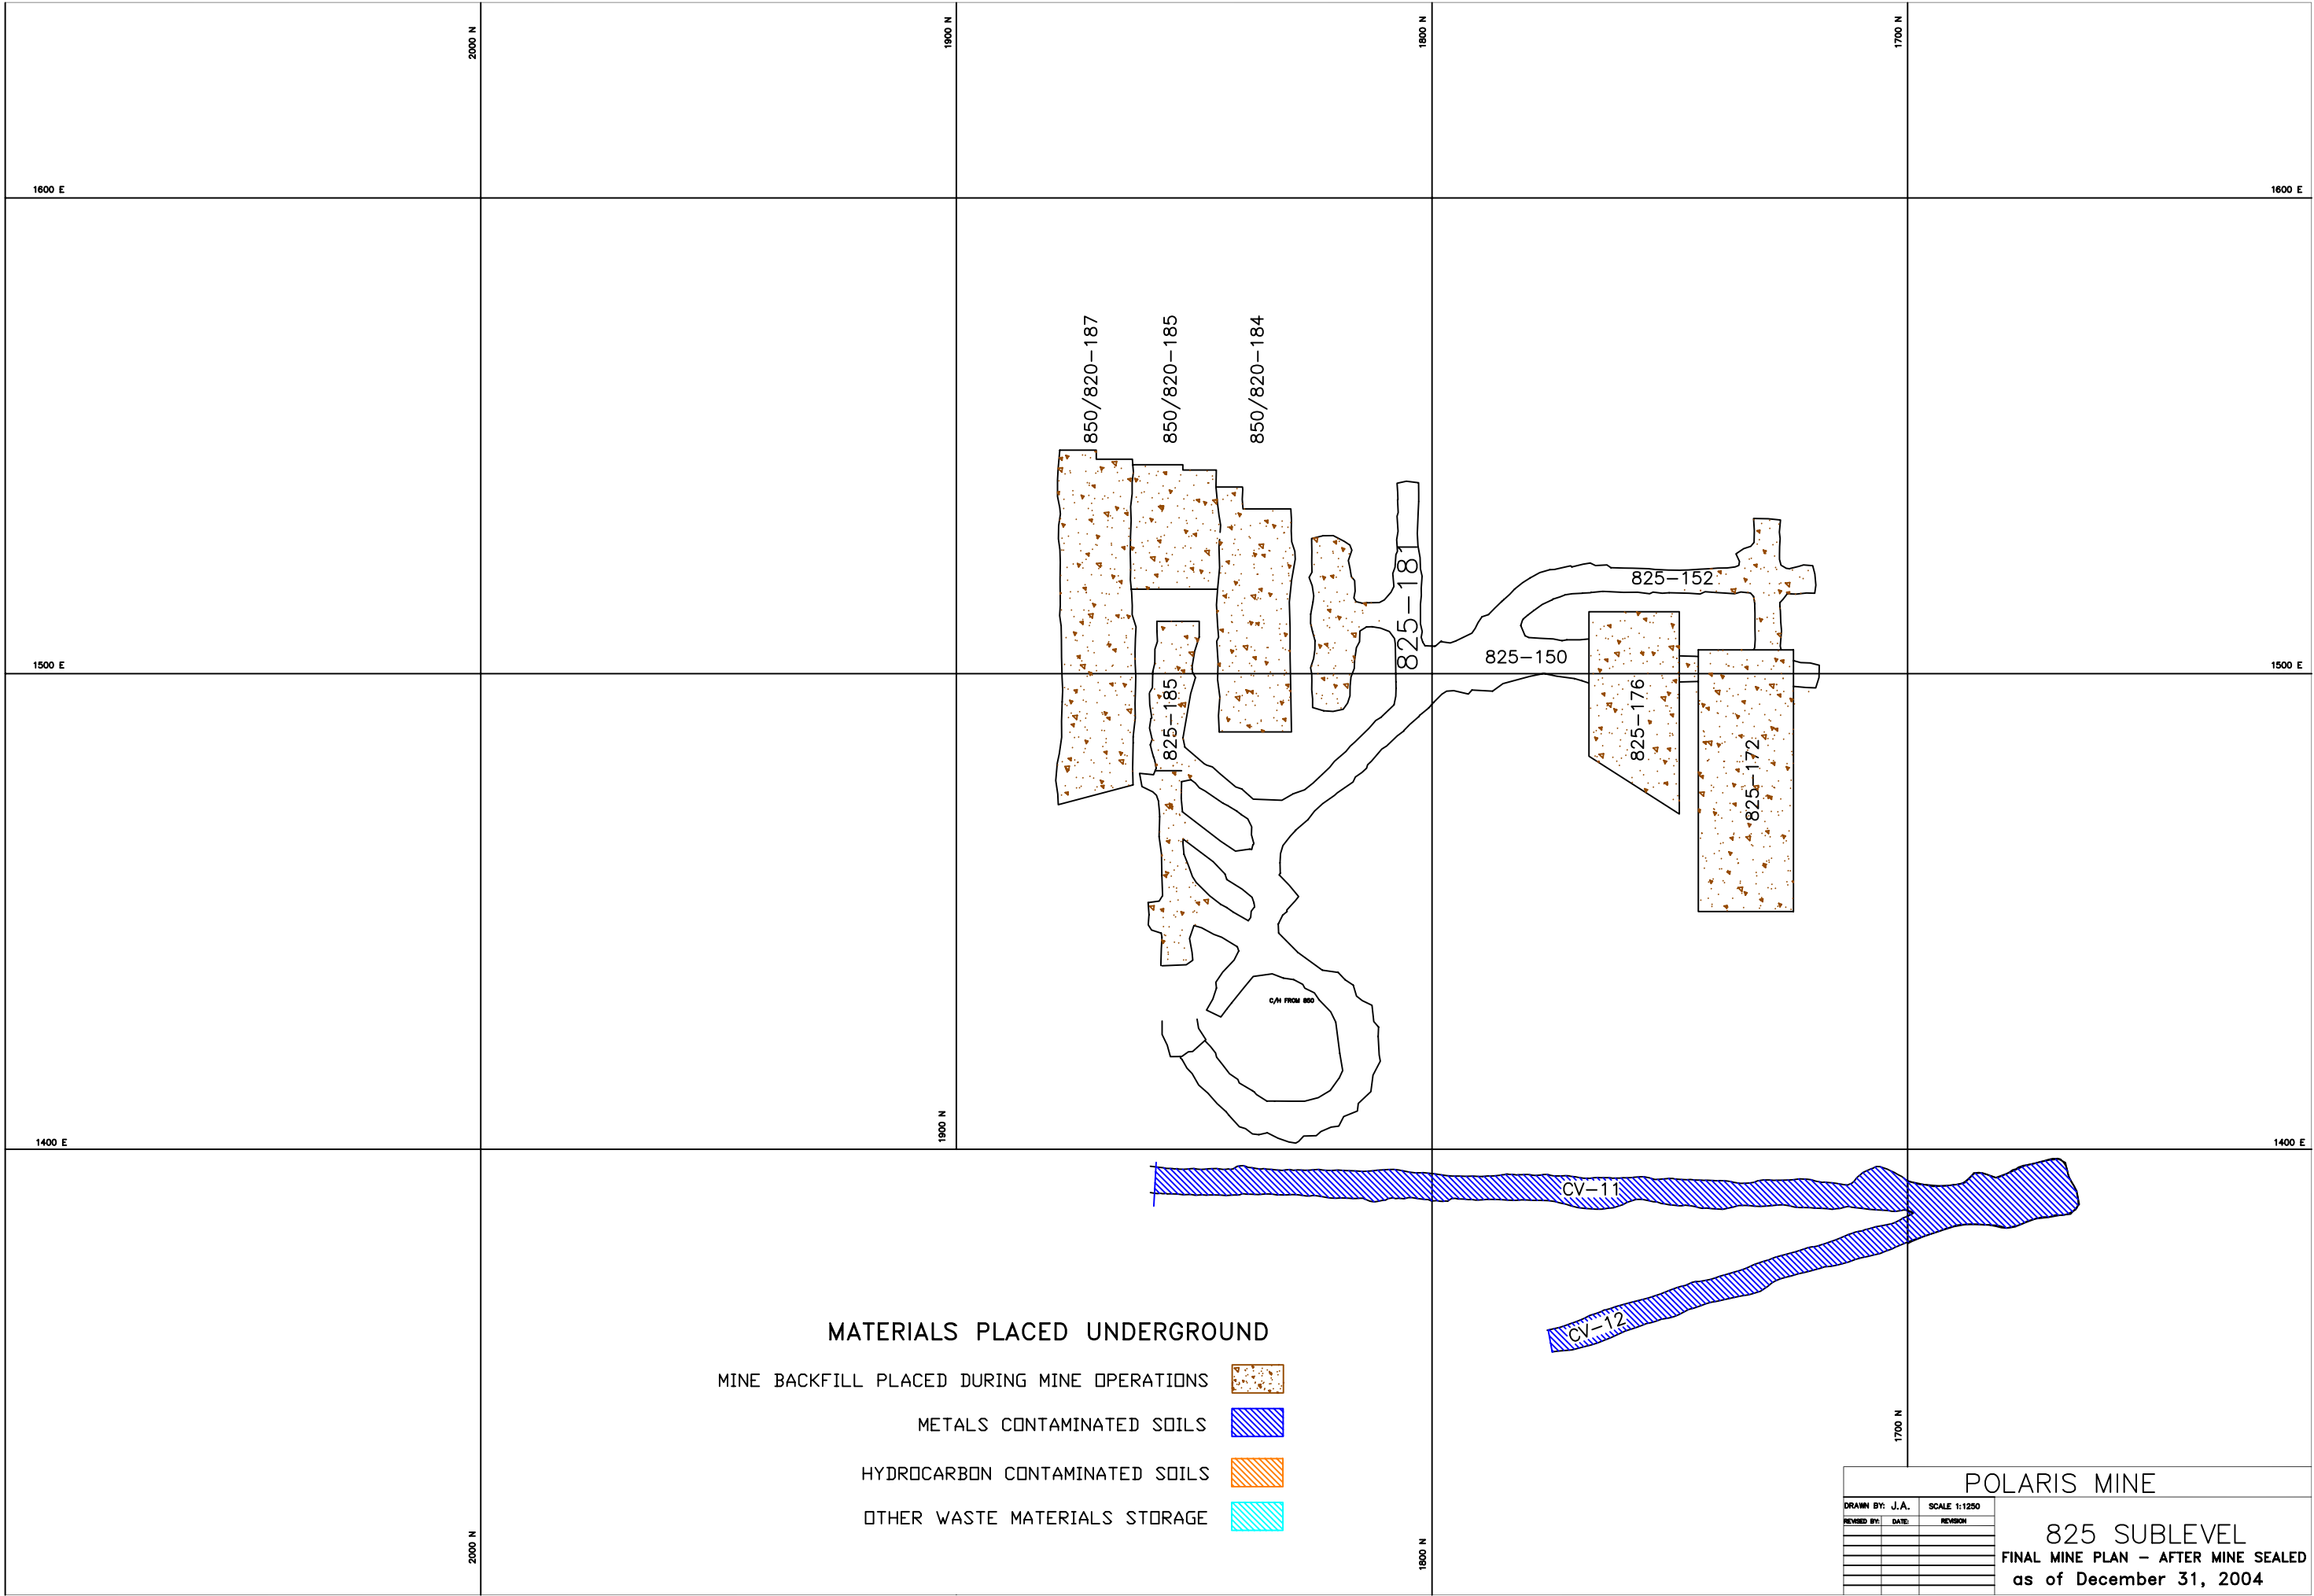



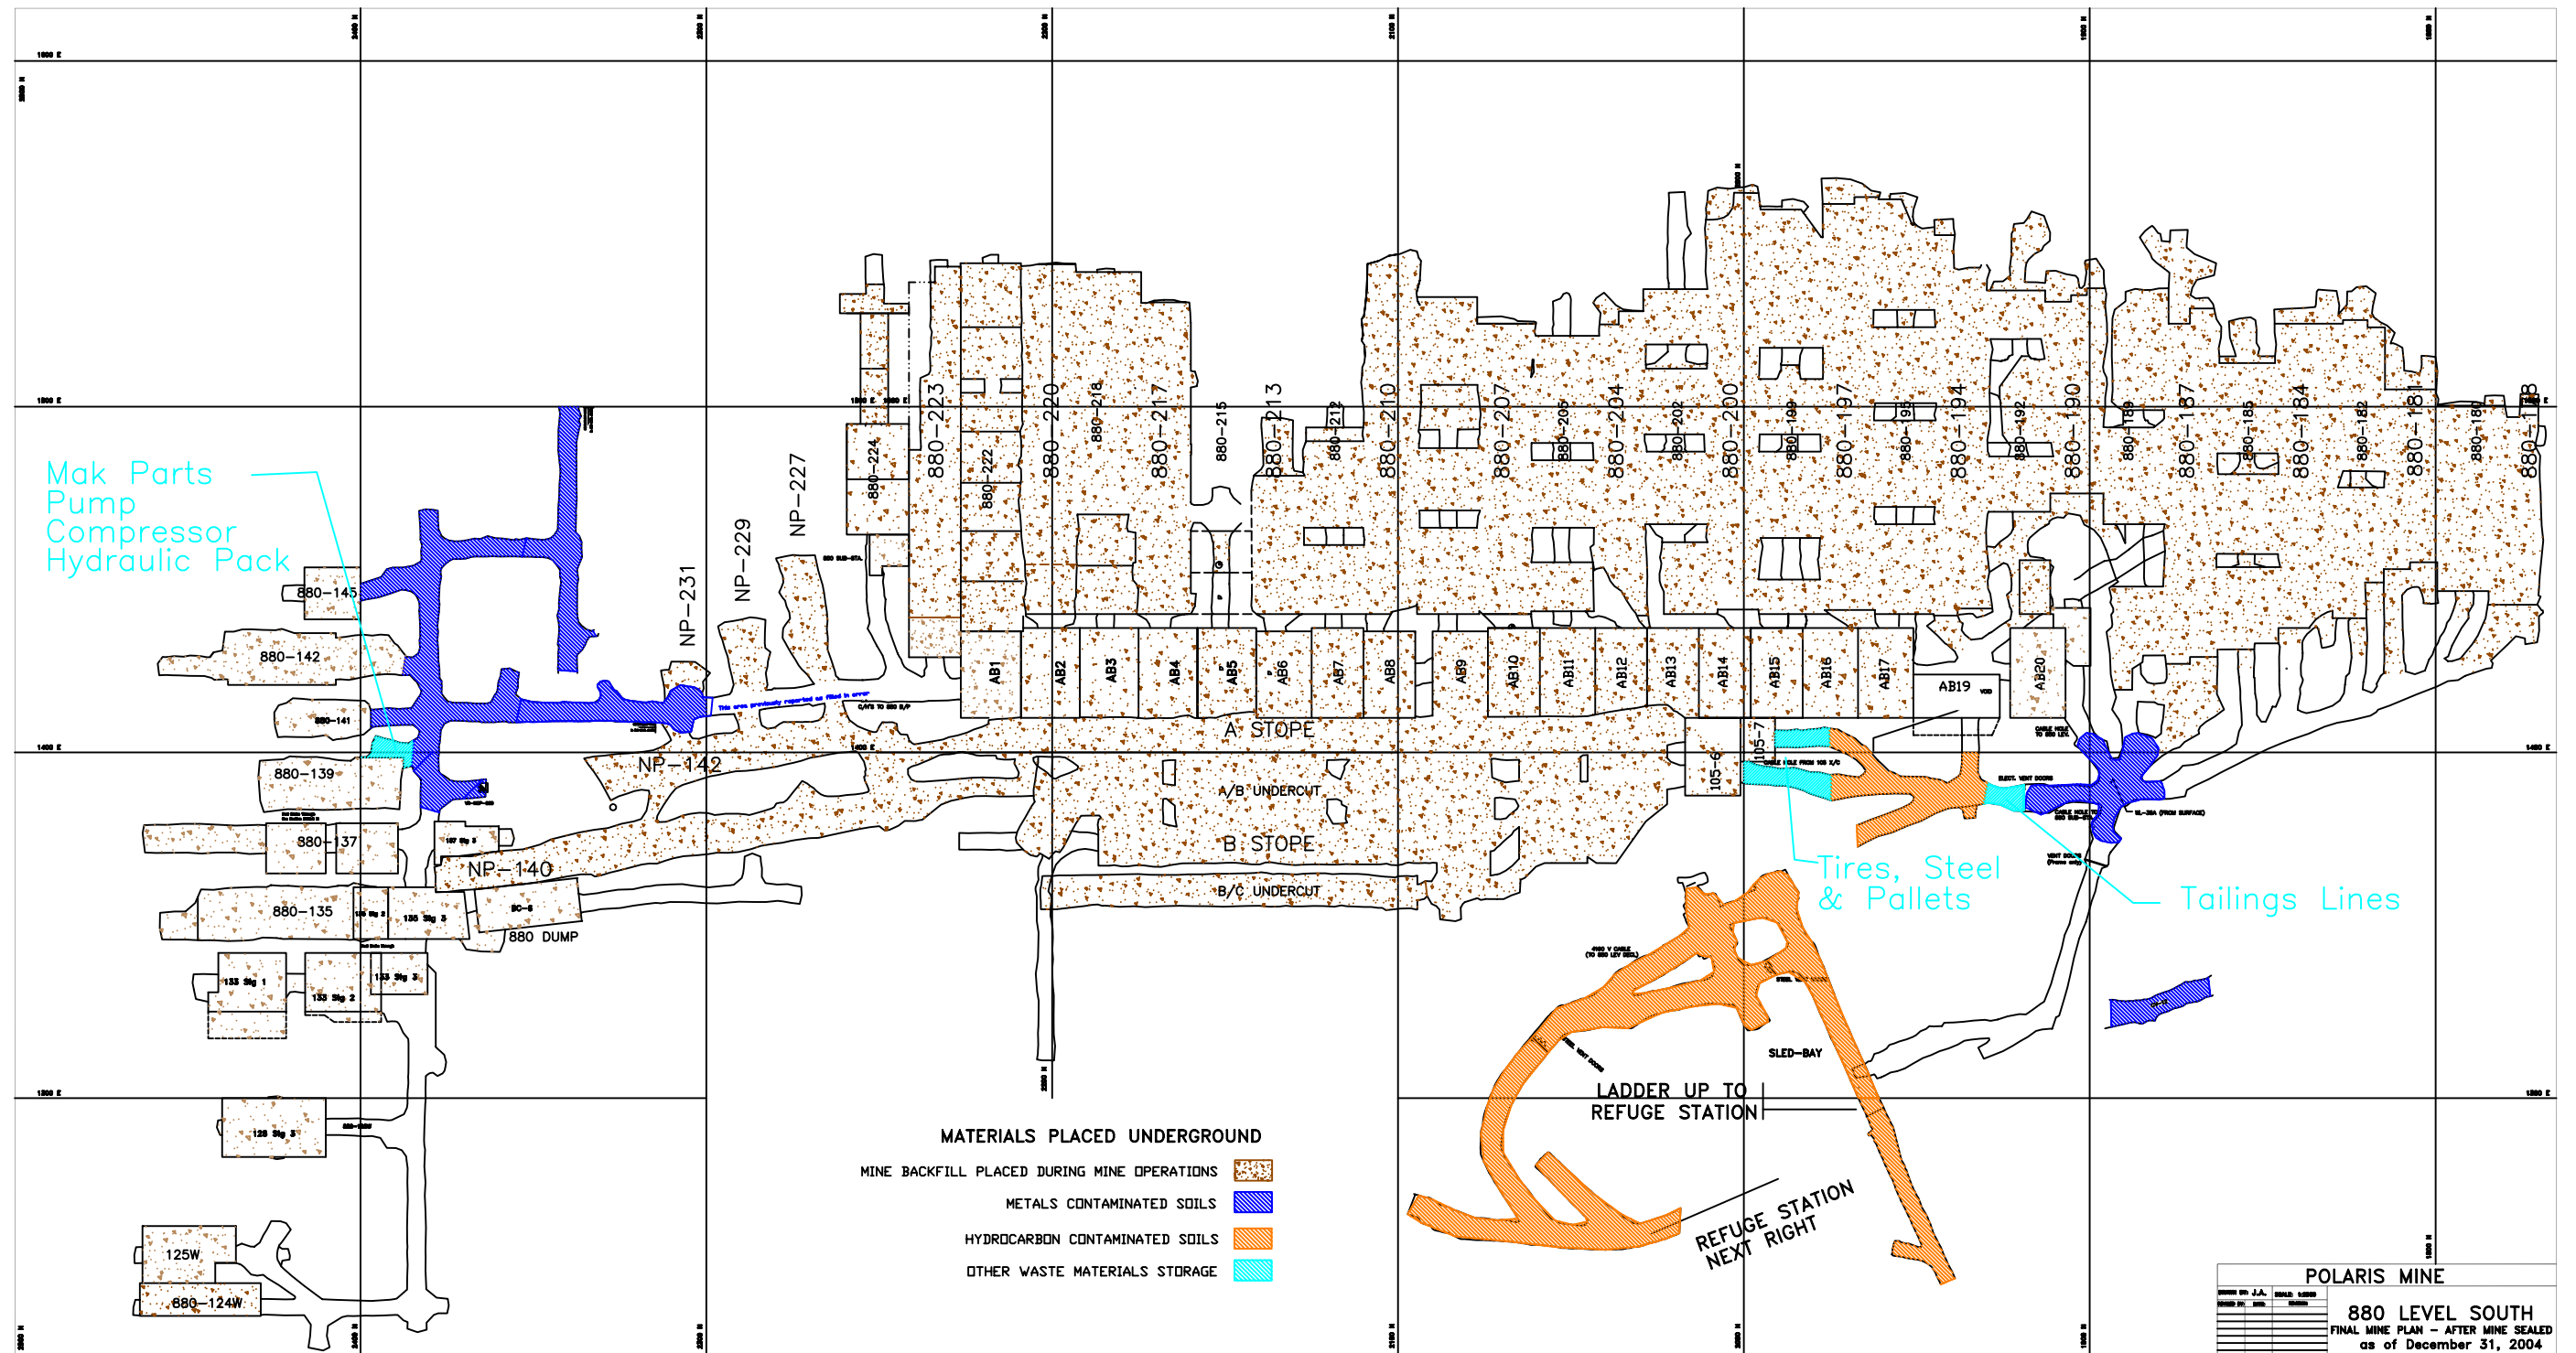

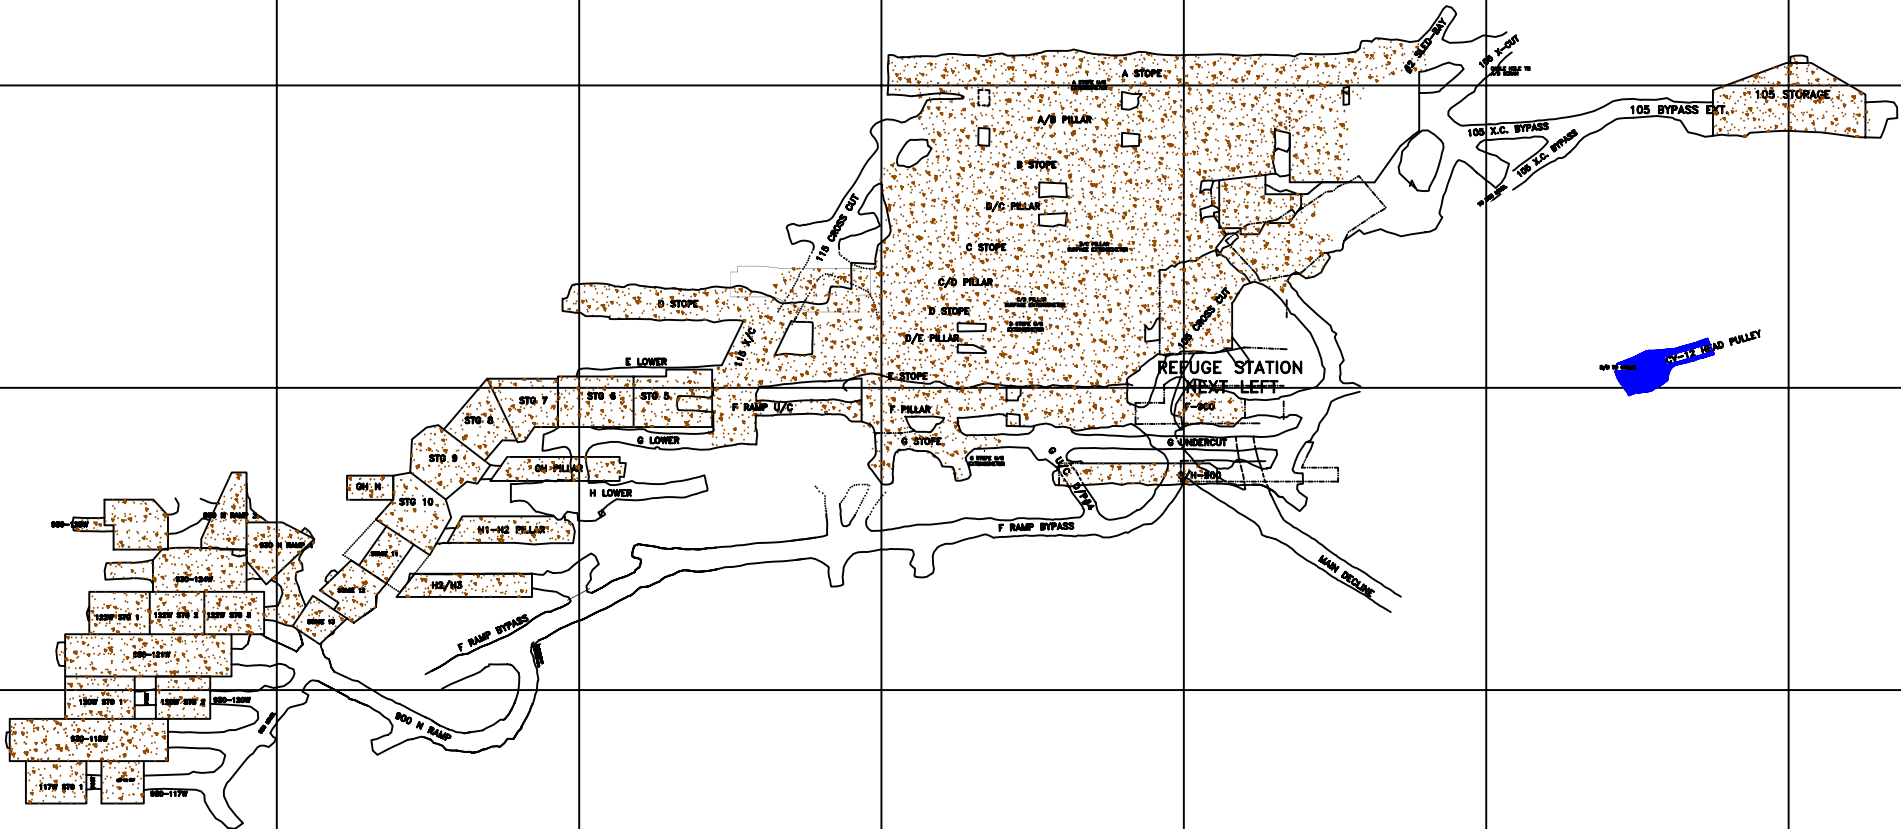


- MATERIALS PLACED UNDERGROUND**
- MINE BACKFILL PLACED DURING MINE OPERATIONS
 - METALS CONTAMINATED SOILS
 - HYDROCARBON CONTAMINATED SOILS
 - OTHER WASTE MATERIALS STORAGE

DRAWN BY: J.A.		SCALE: 1:2500	
DATE: 09/20/04	BY: J.A.	DATE: 09/20/04	BY: J.A.

POLARIS MINE

930 LEVEL

FINAL MINE PLAN – AFTER MINE SEALED
as of December 31, 2004

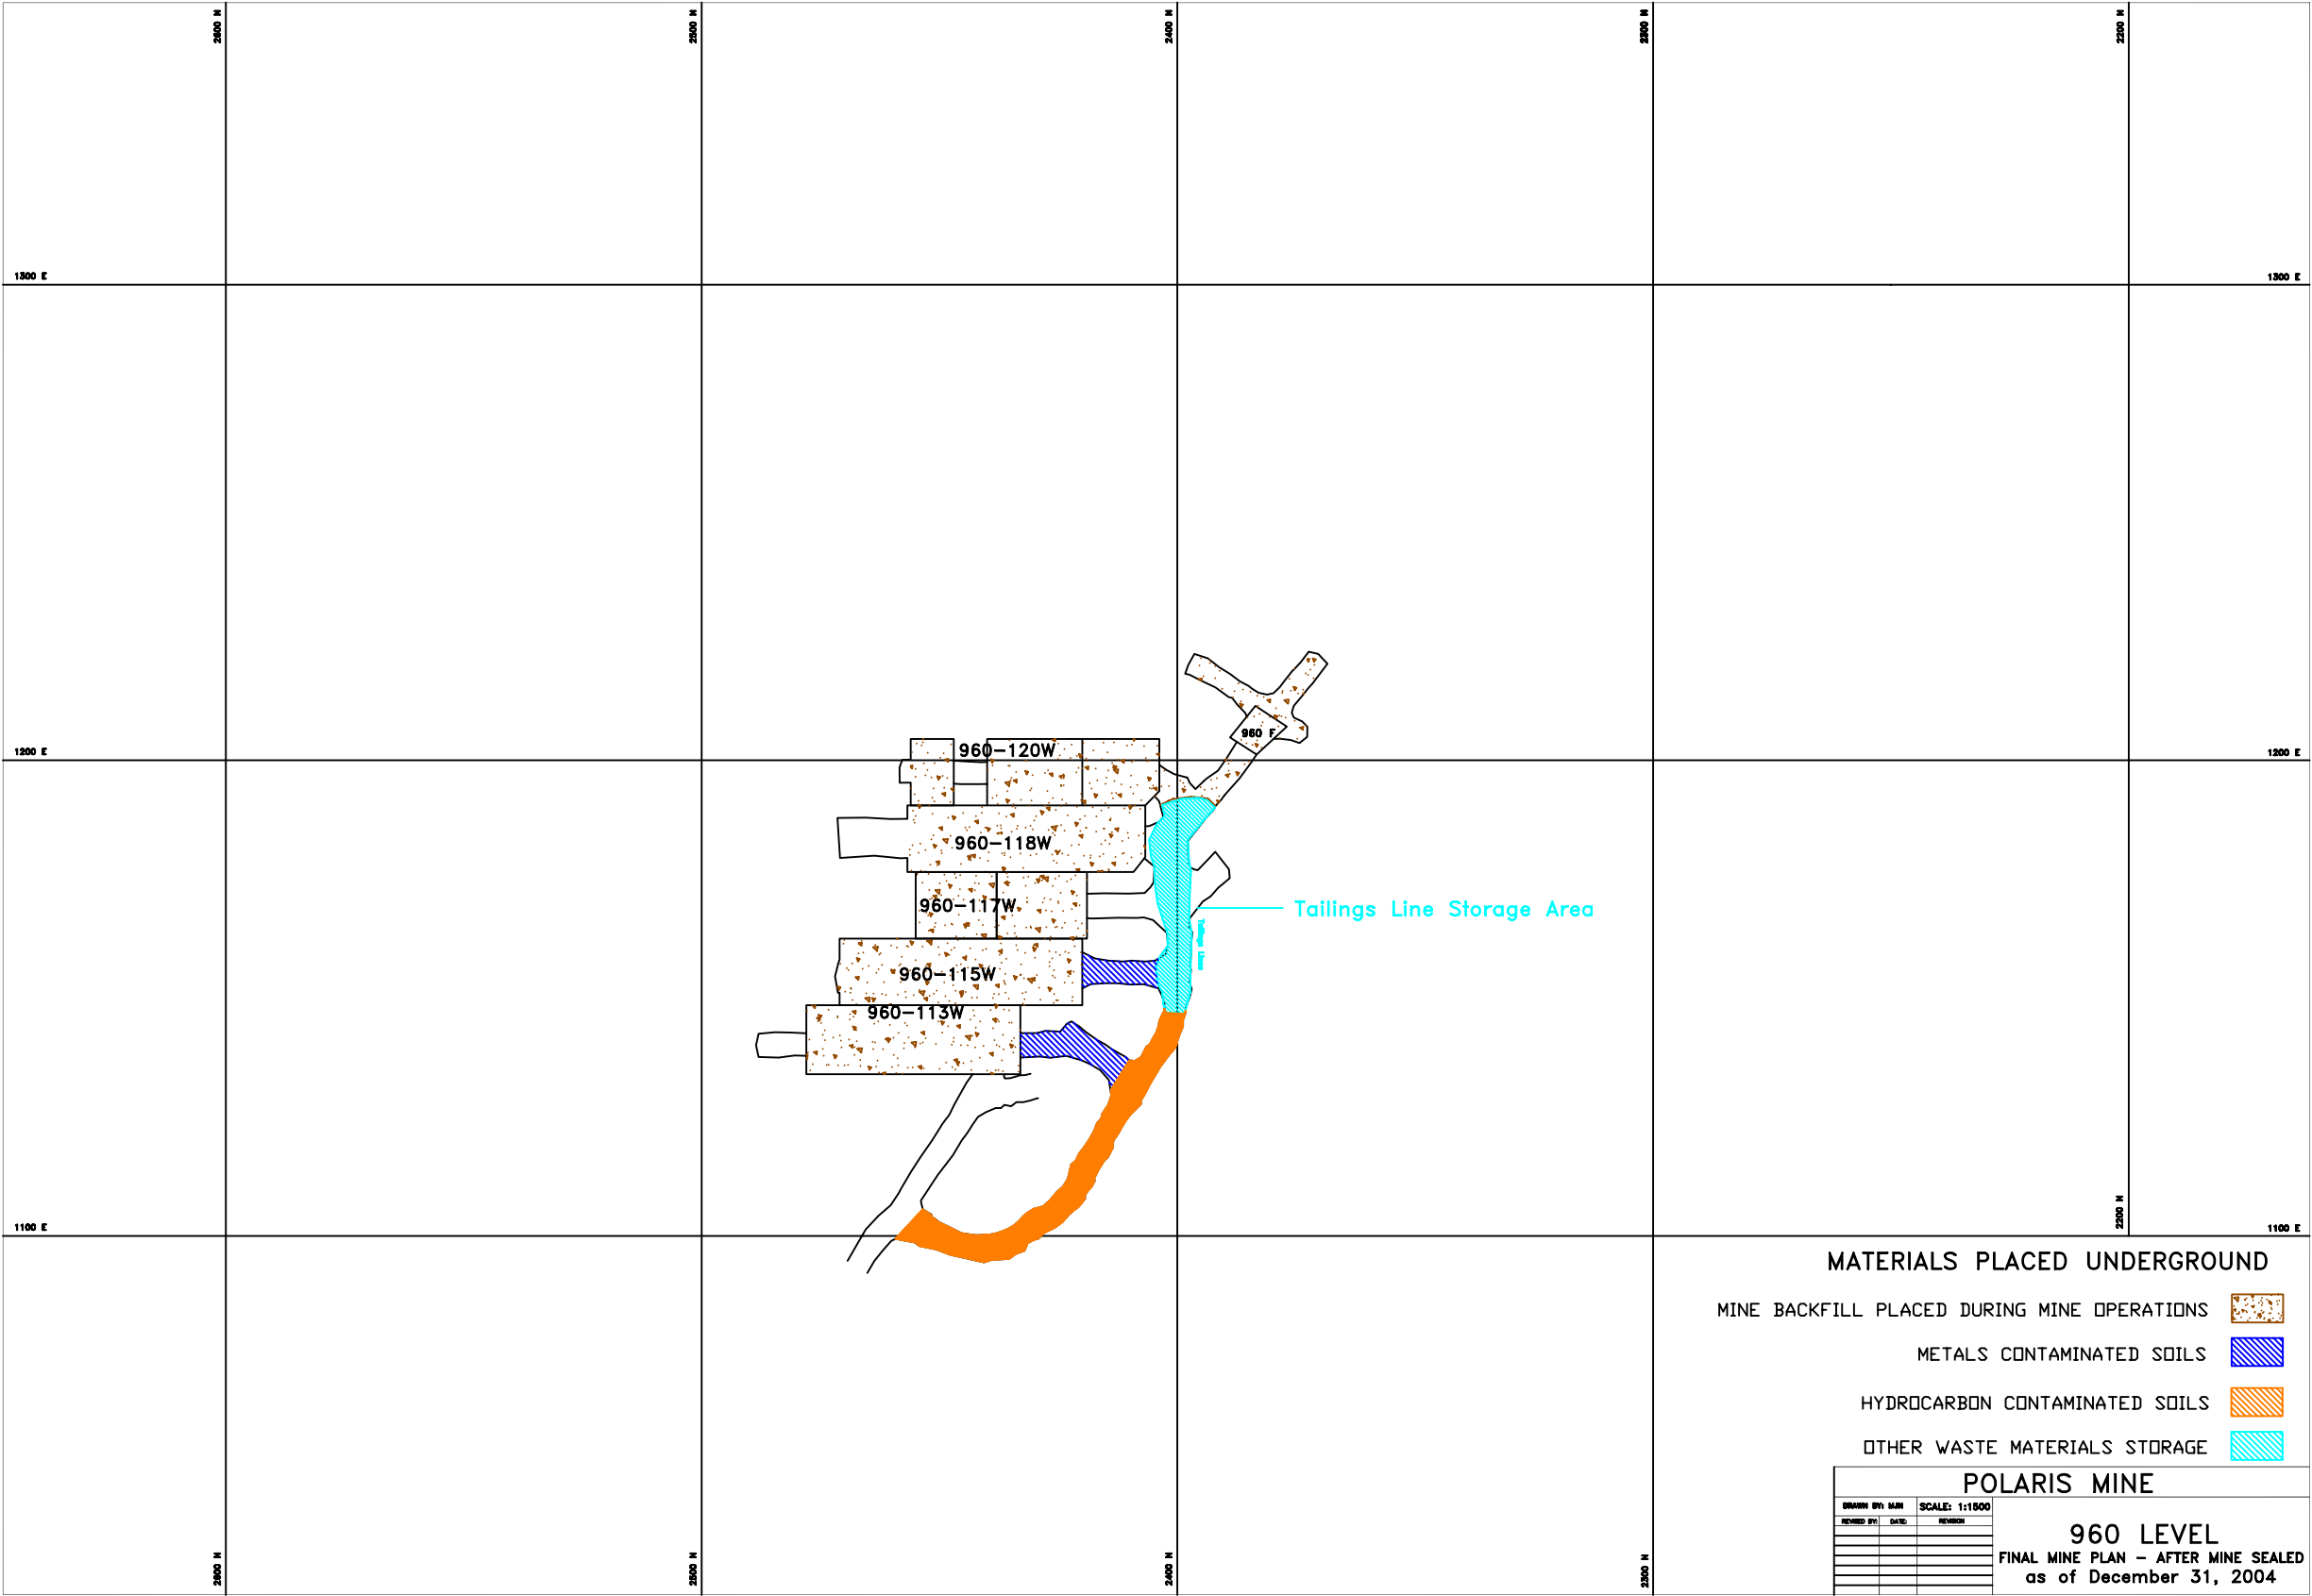

MATERIALS PLACED UNDERGROUND

- MINE BACKFILL PLACED DURING MINE OPERATIONS
- METALS CONTAMINATED SOILS
- HYDROCARBON CONTAMINATED SOILS
- OTHER WASTE MATERIALS STORAGE

DRAWN BY: MAM


SCALE: 1:1500

REVISION	DATE	REVISION

POLARIS MINE


960 LEVEL


FINAL MINE PLAN – AFTER MINE SEALED
as of December 31, 2004

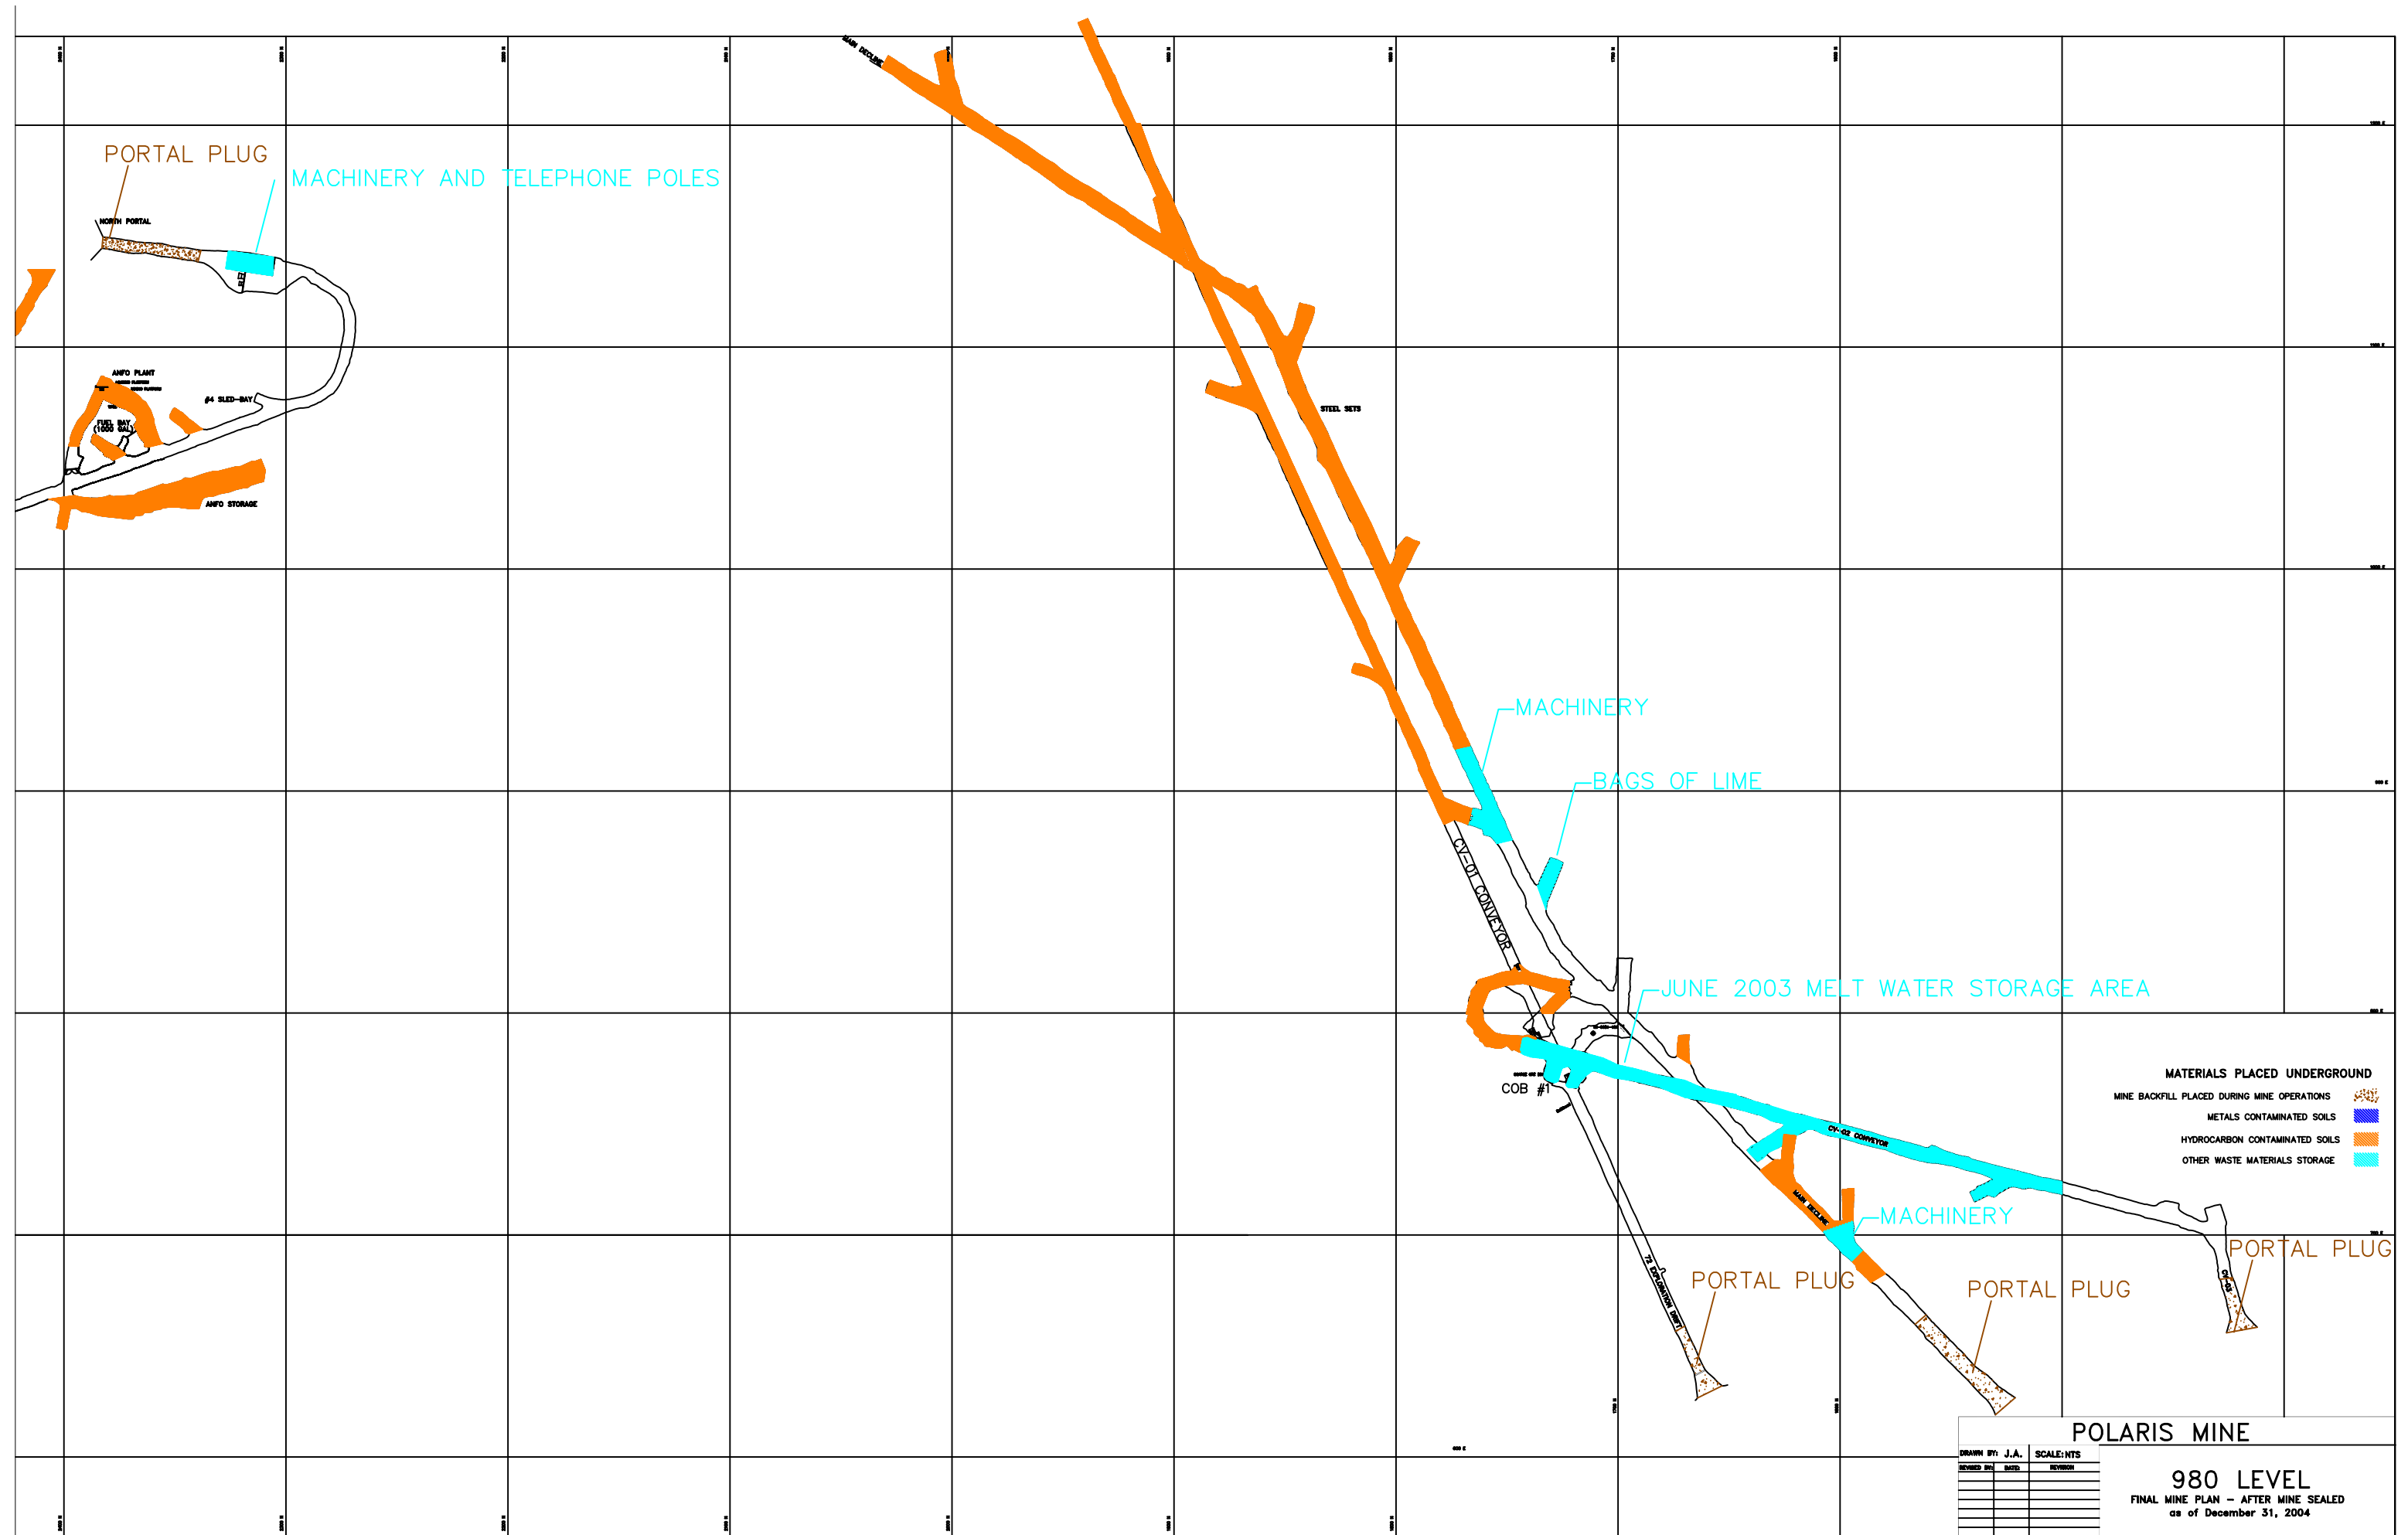


APPENDIX 12

ROCK TEMPERATURES SURROUNDING THE UNDERGROUND MINE WORKINGS

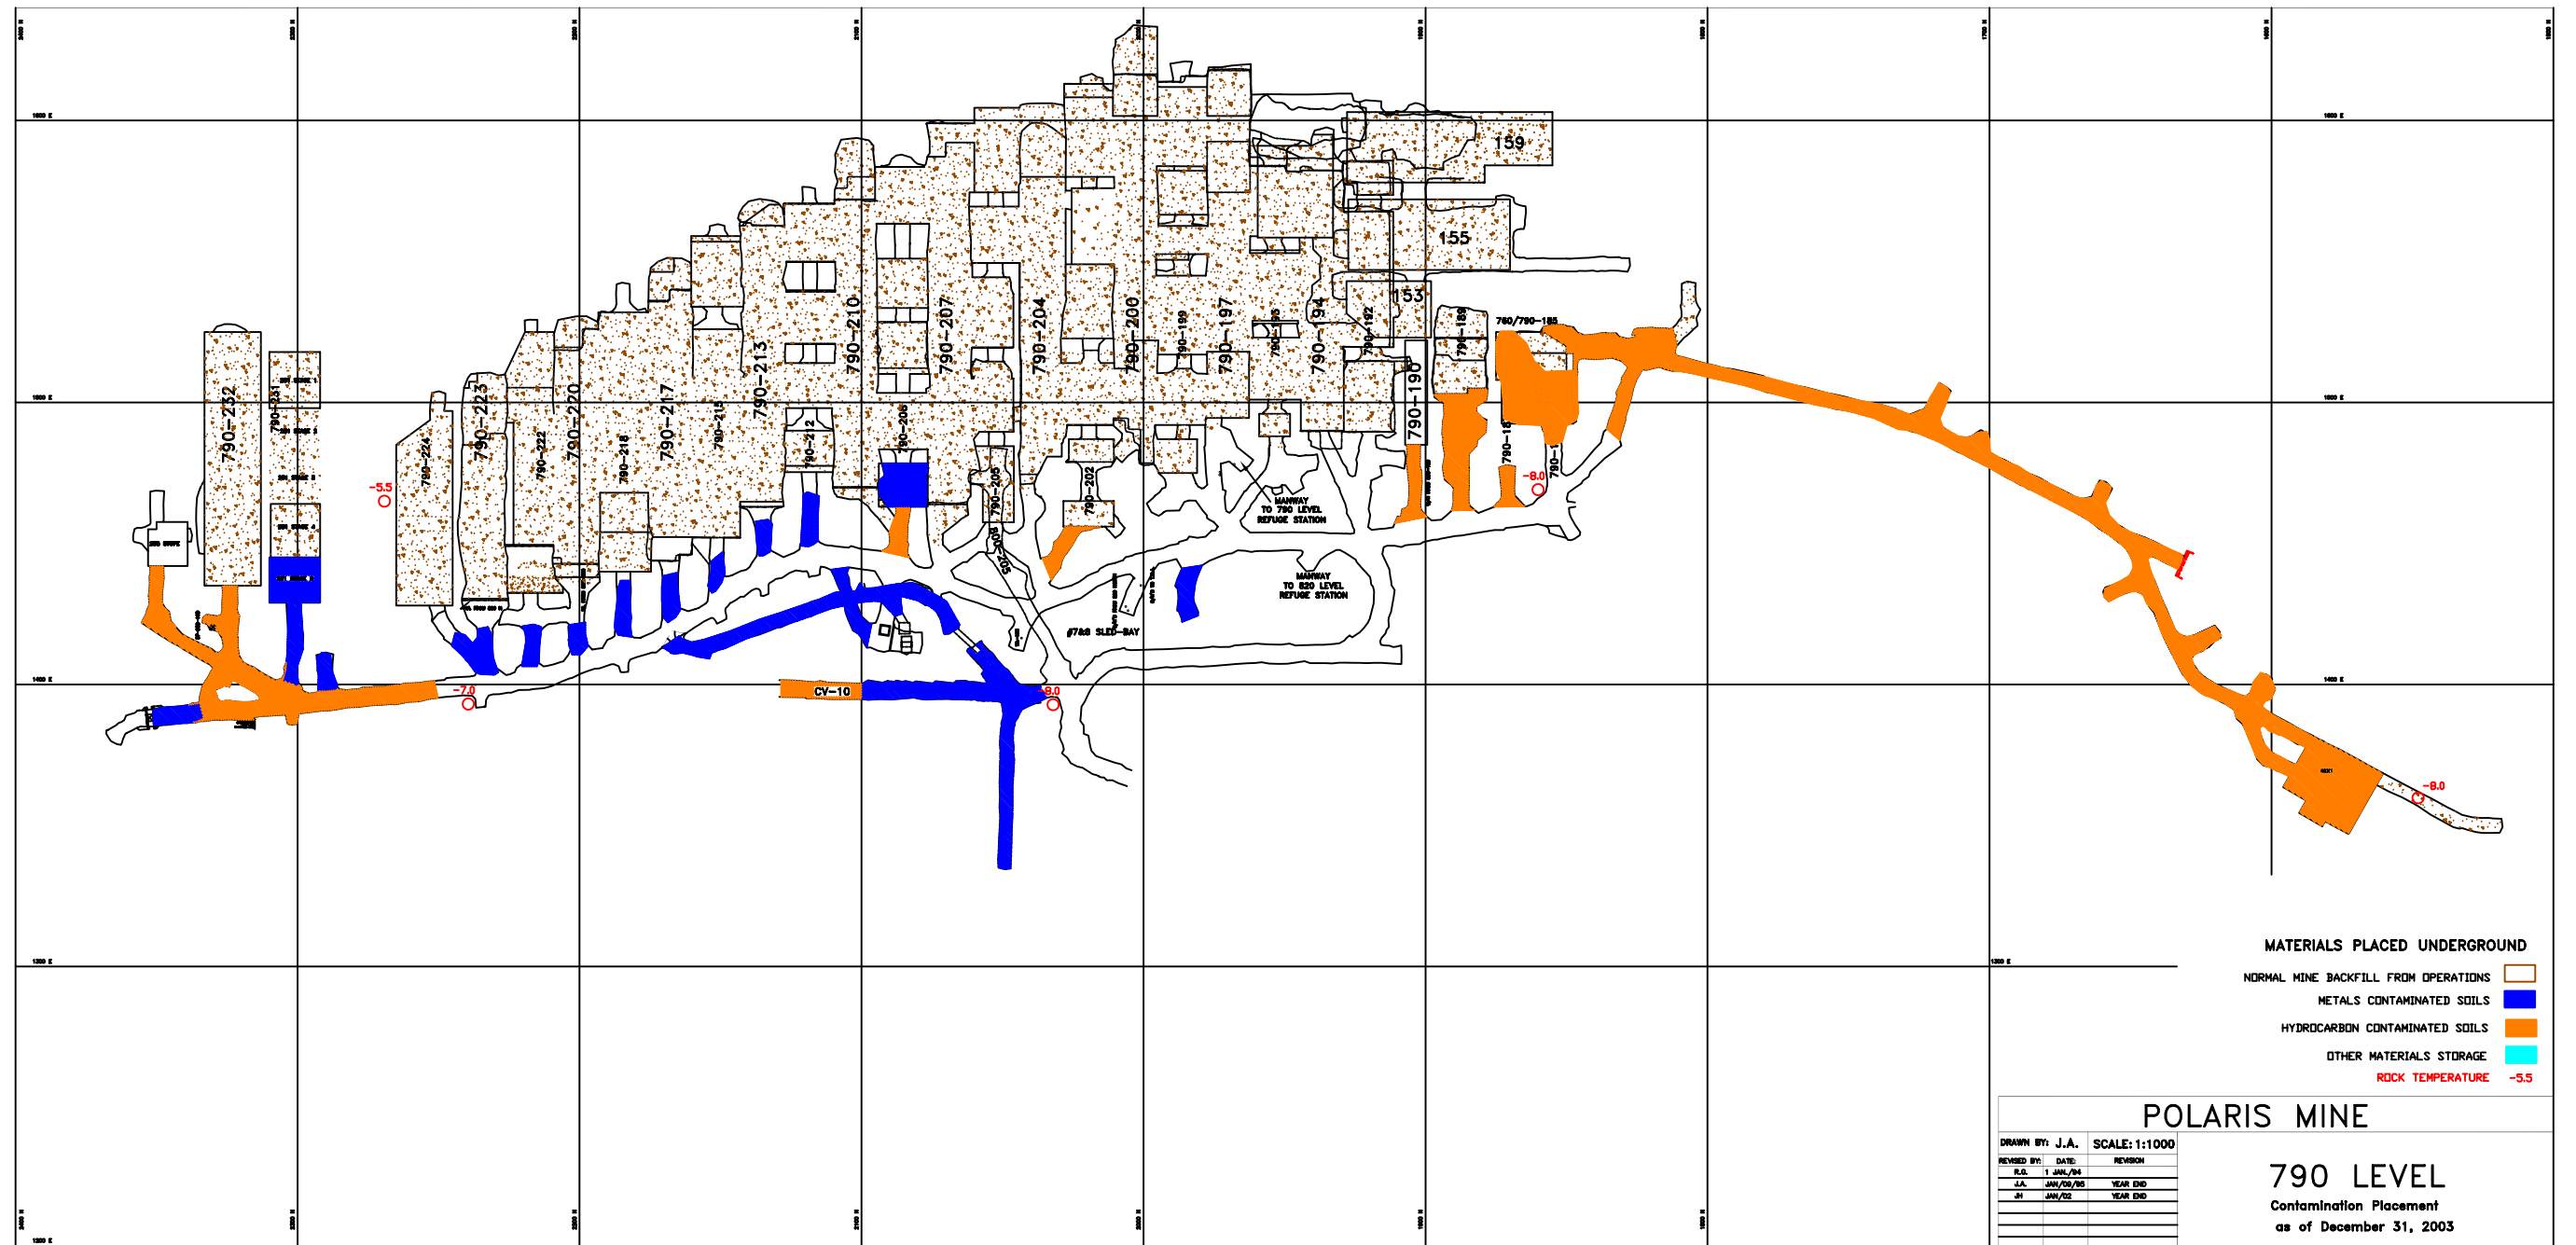


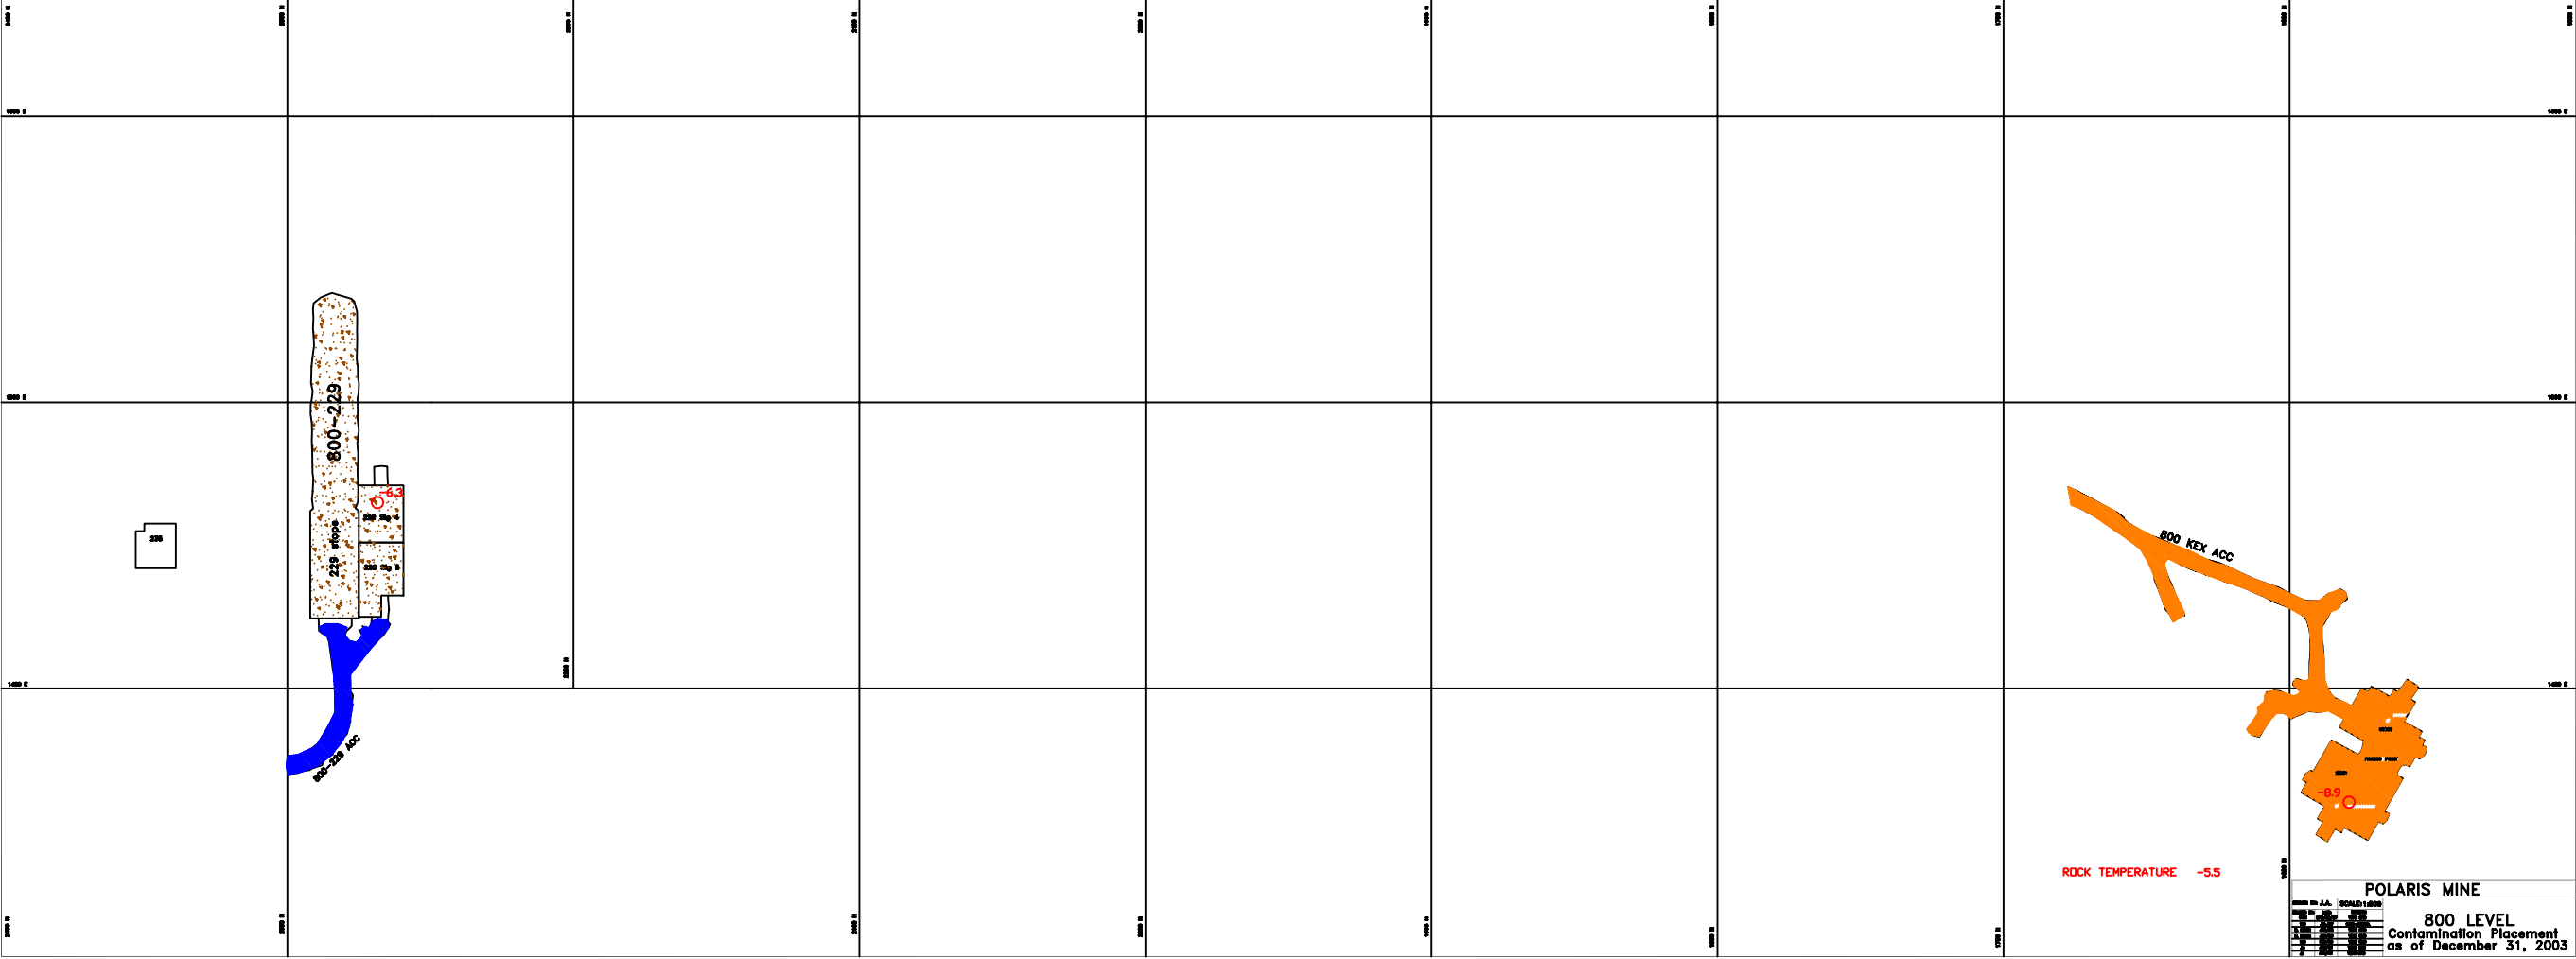


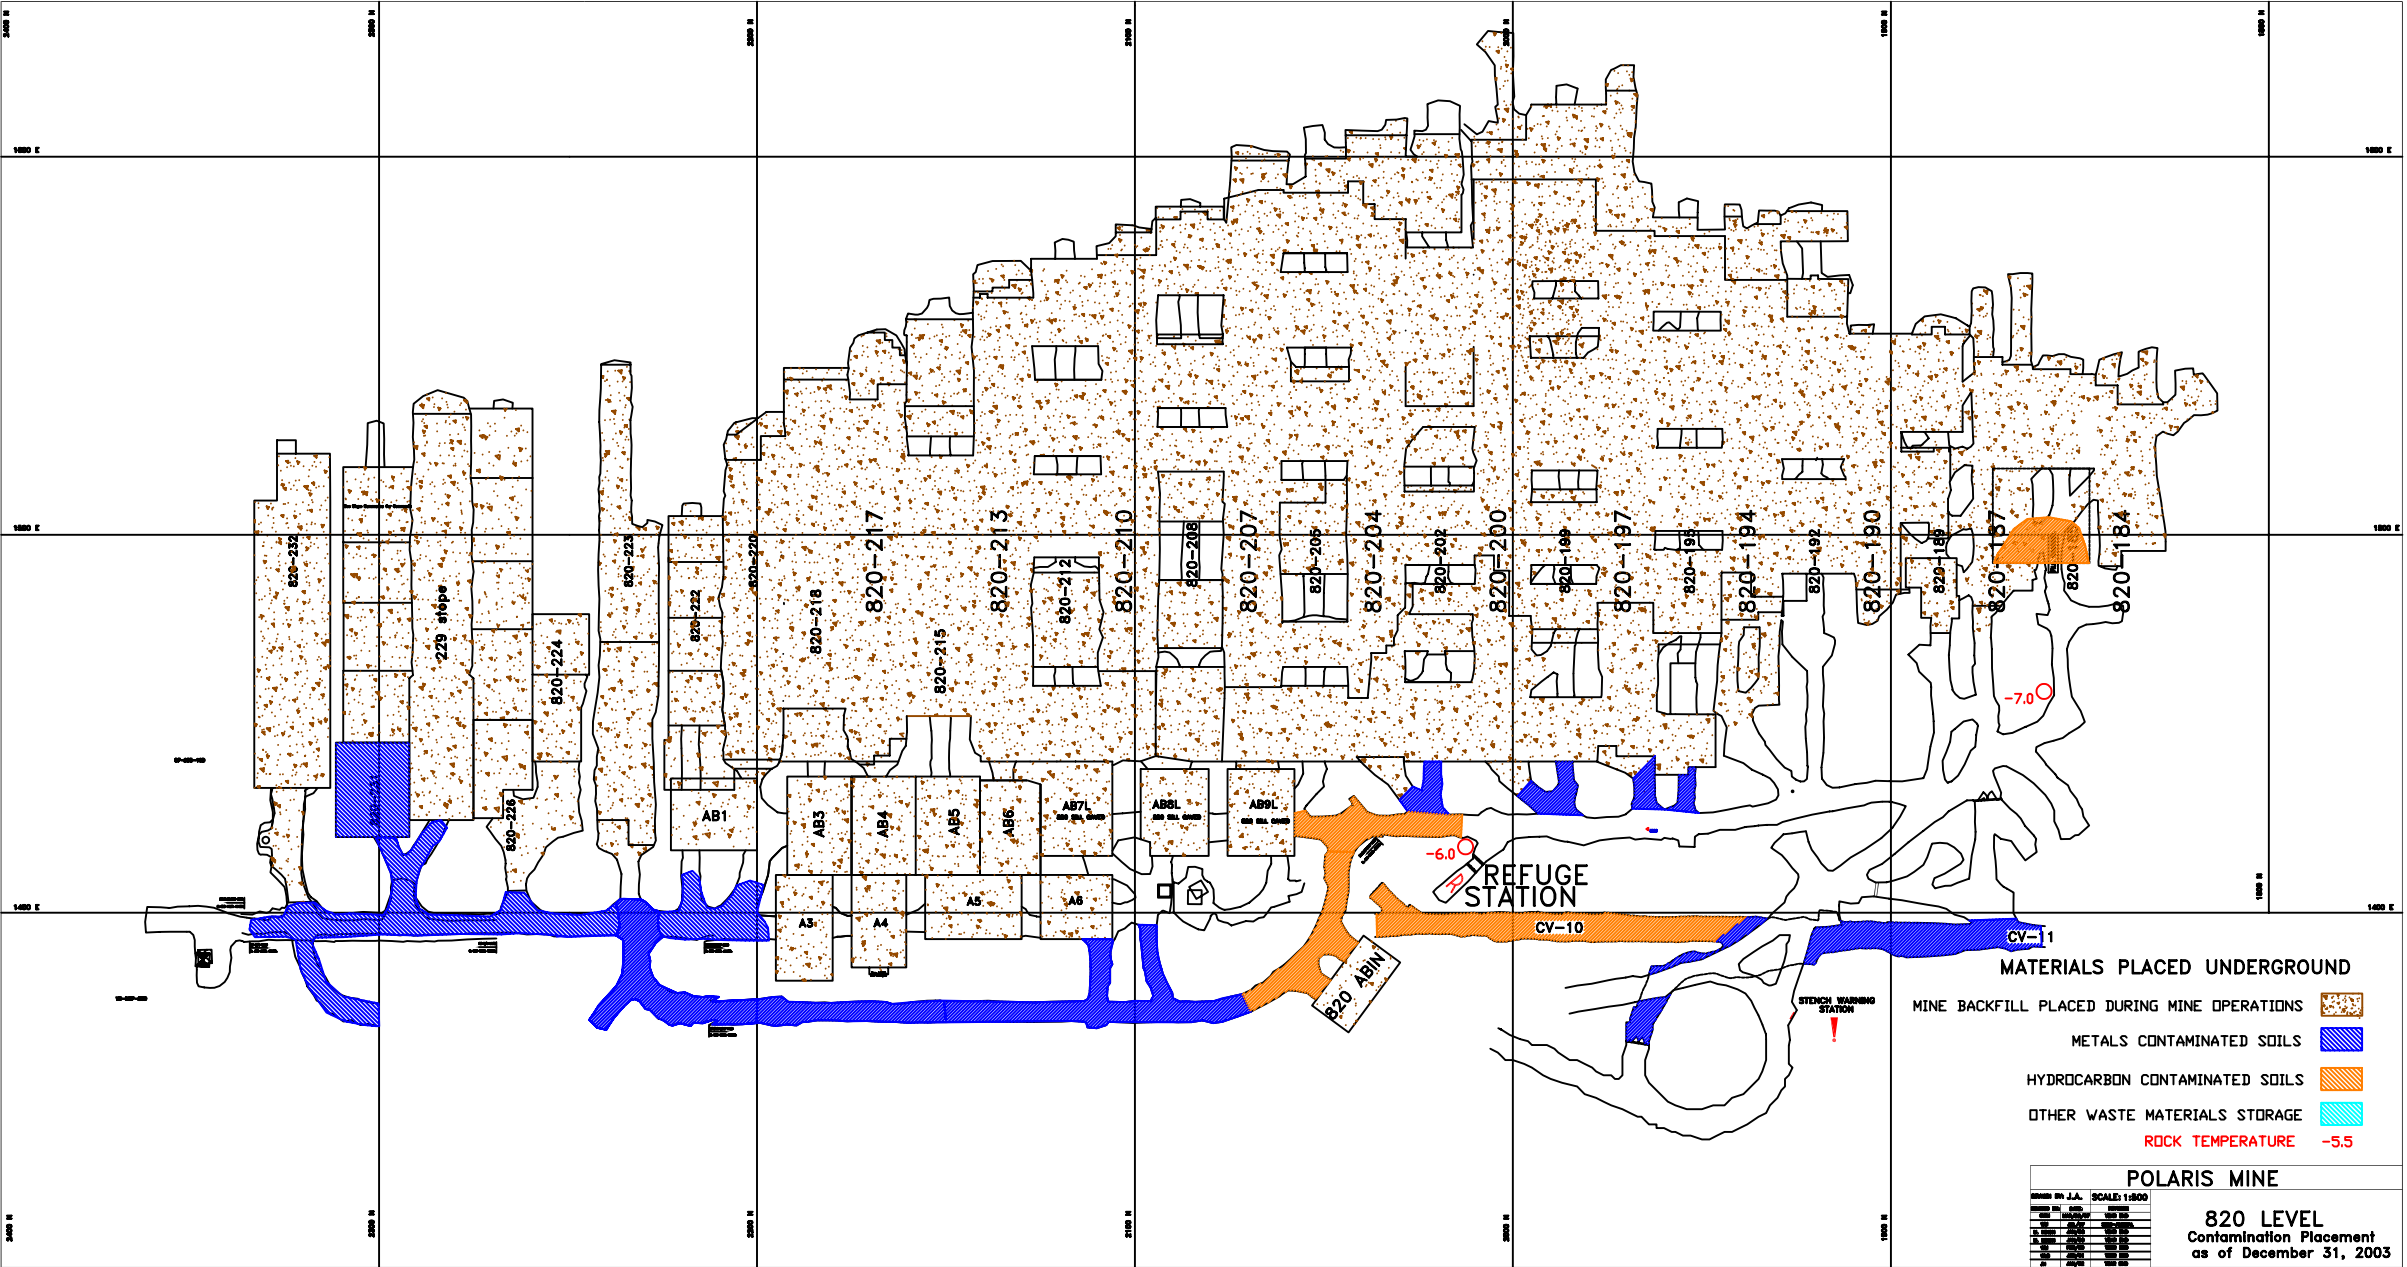






GRADE: J.A. SCALE: 1:500			

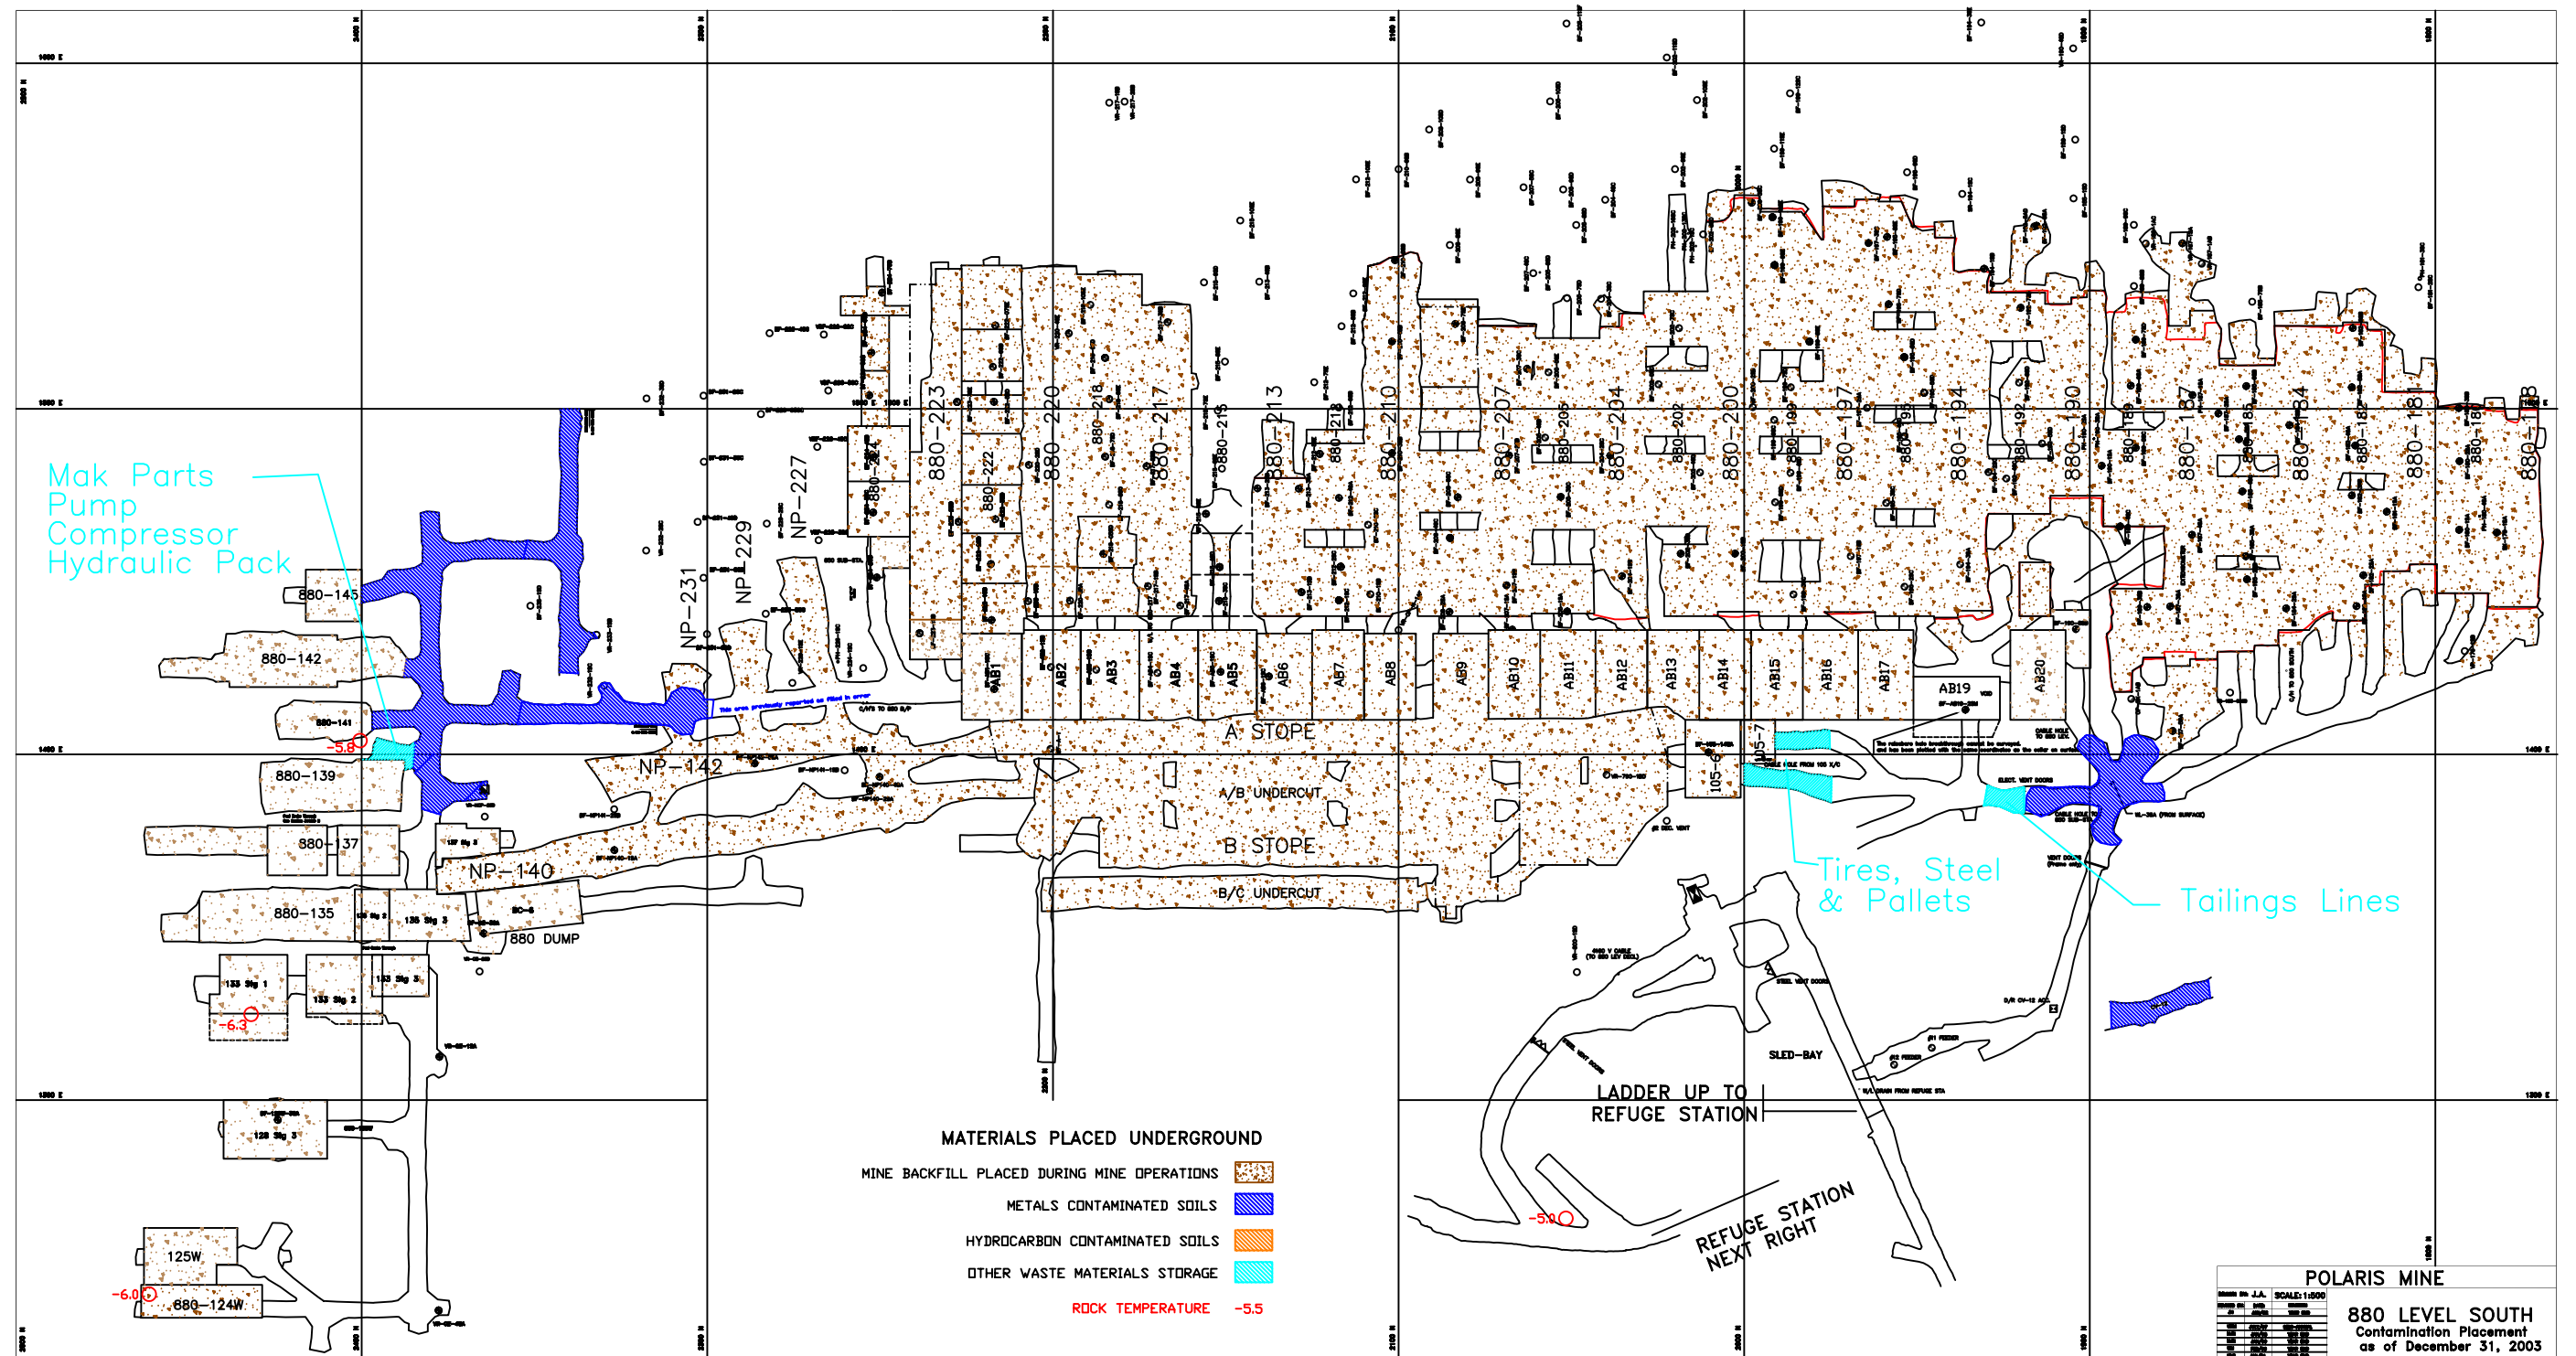


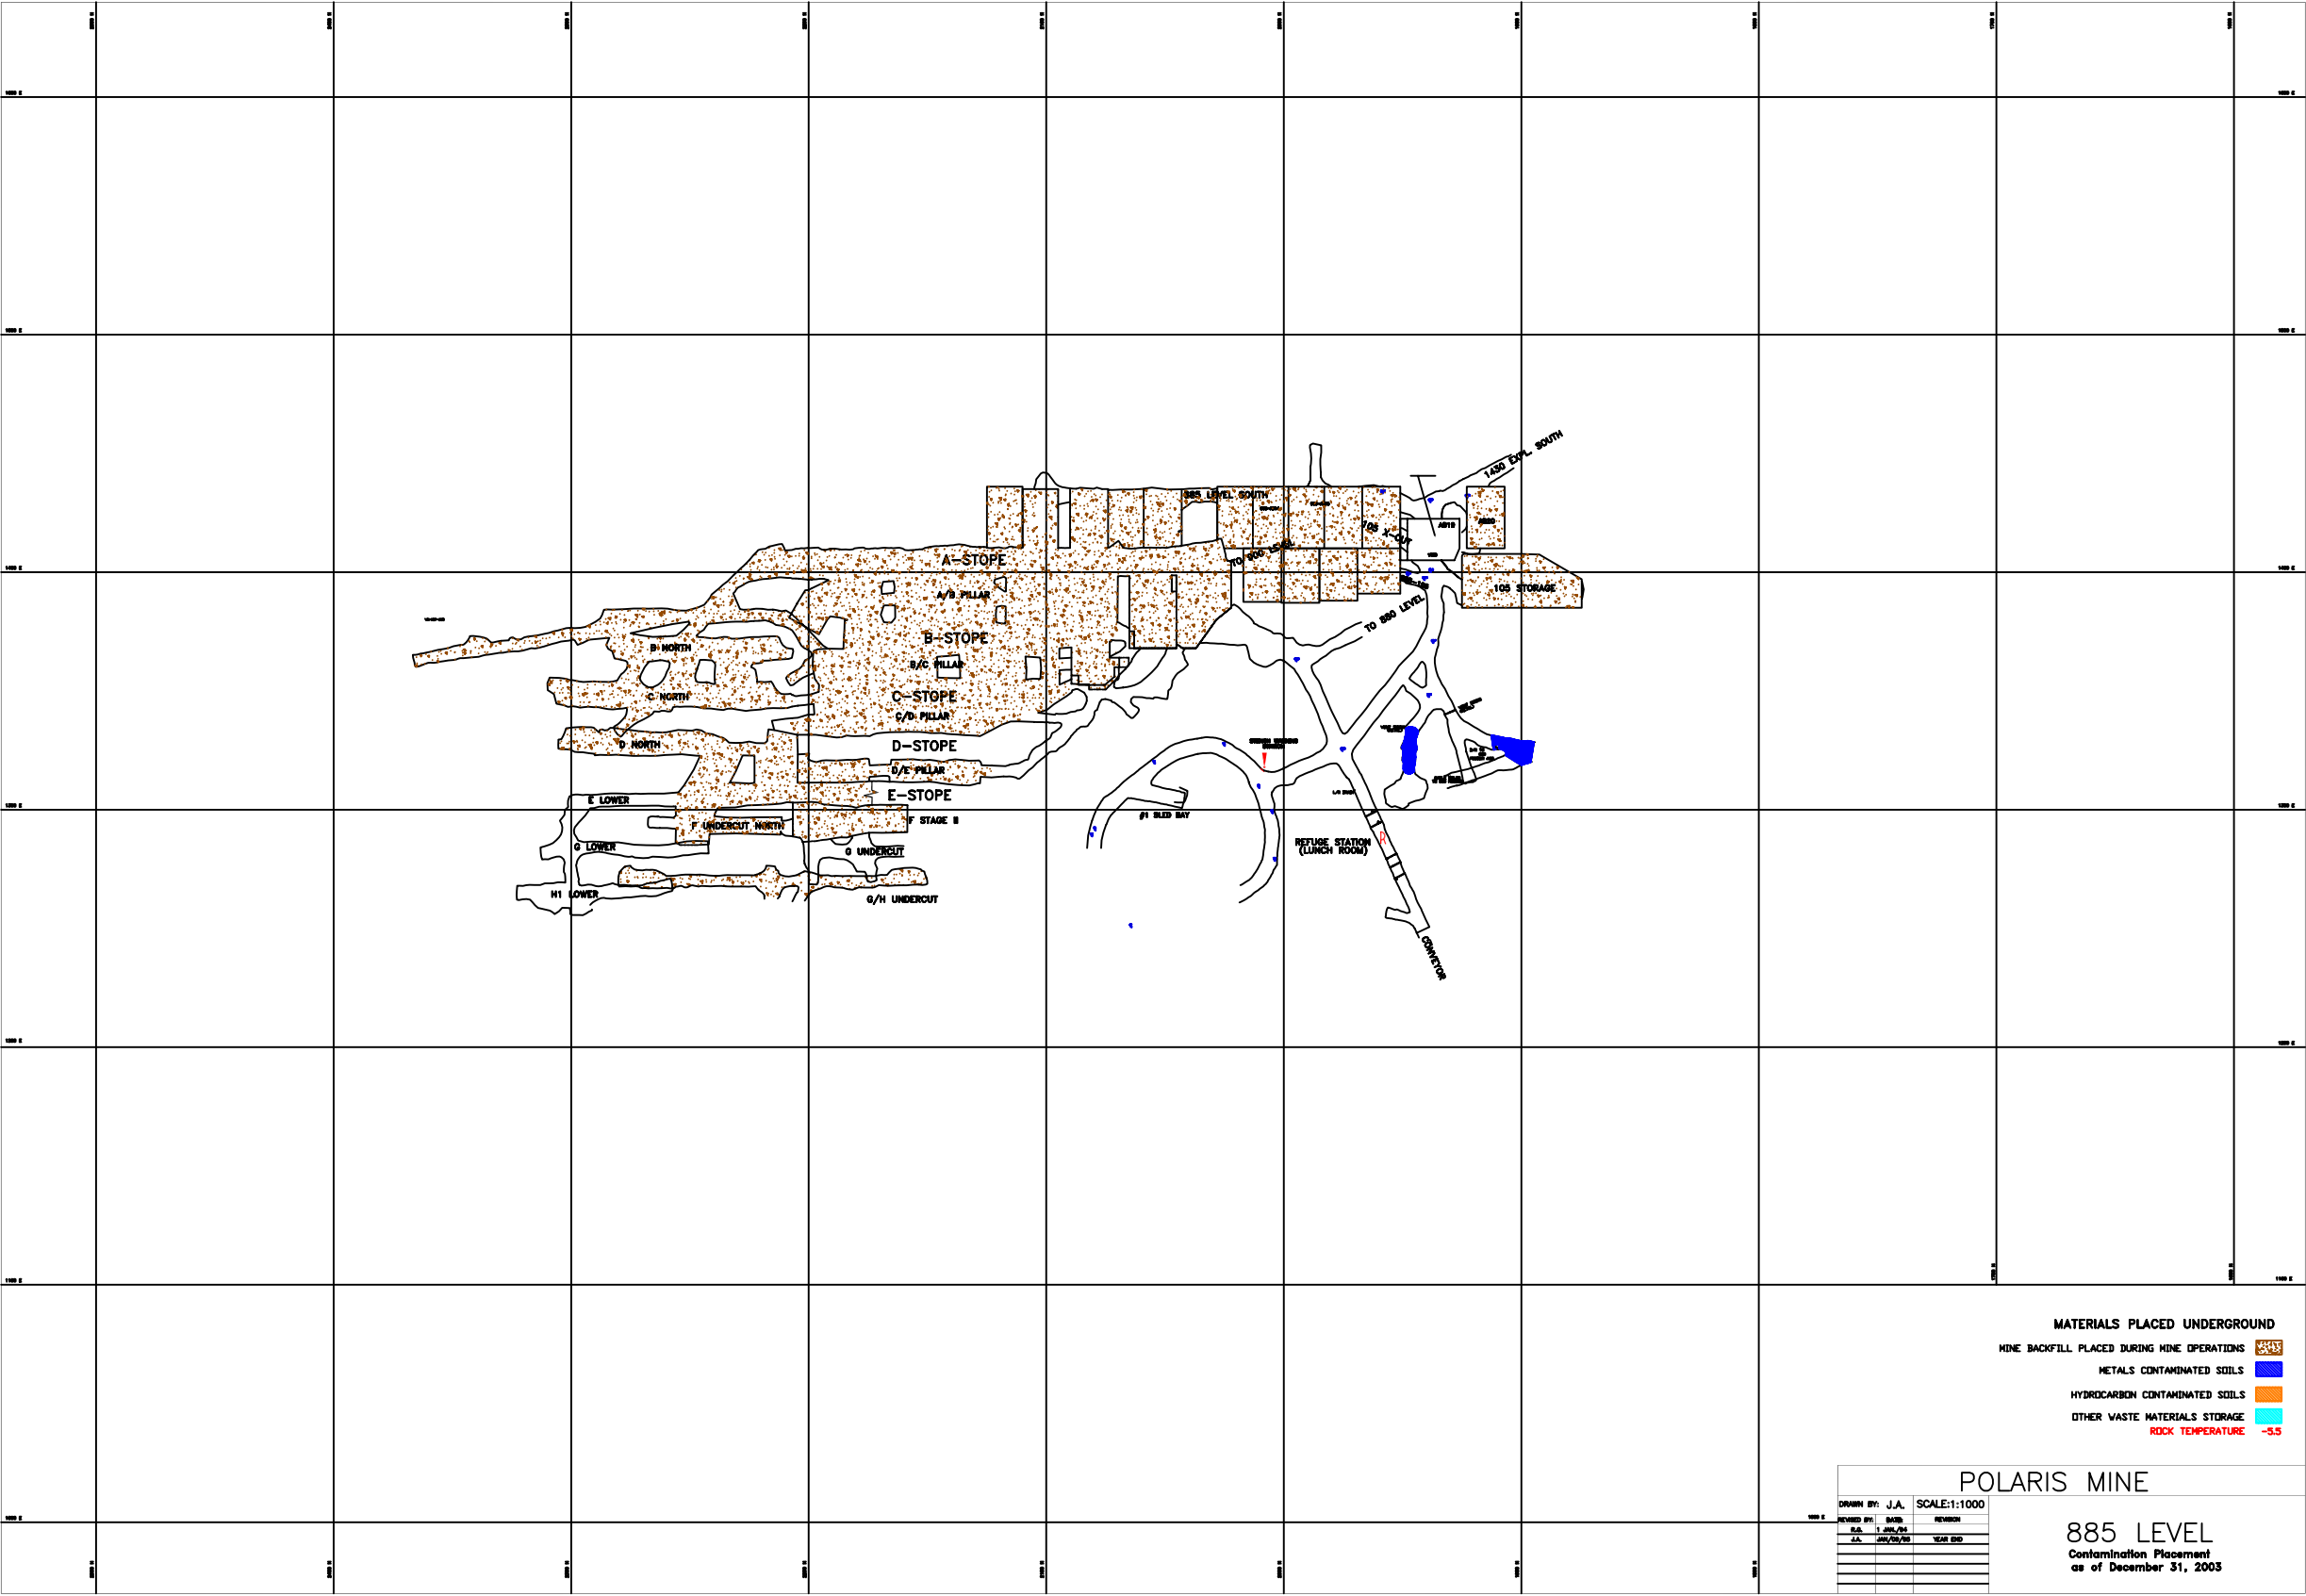


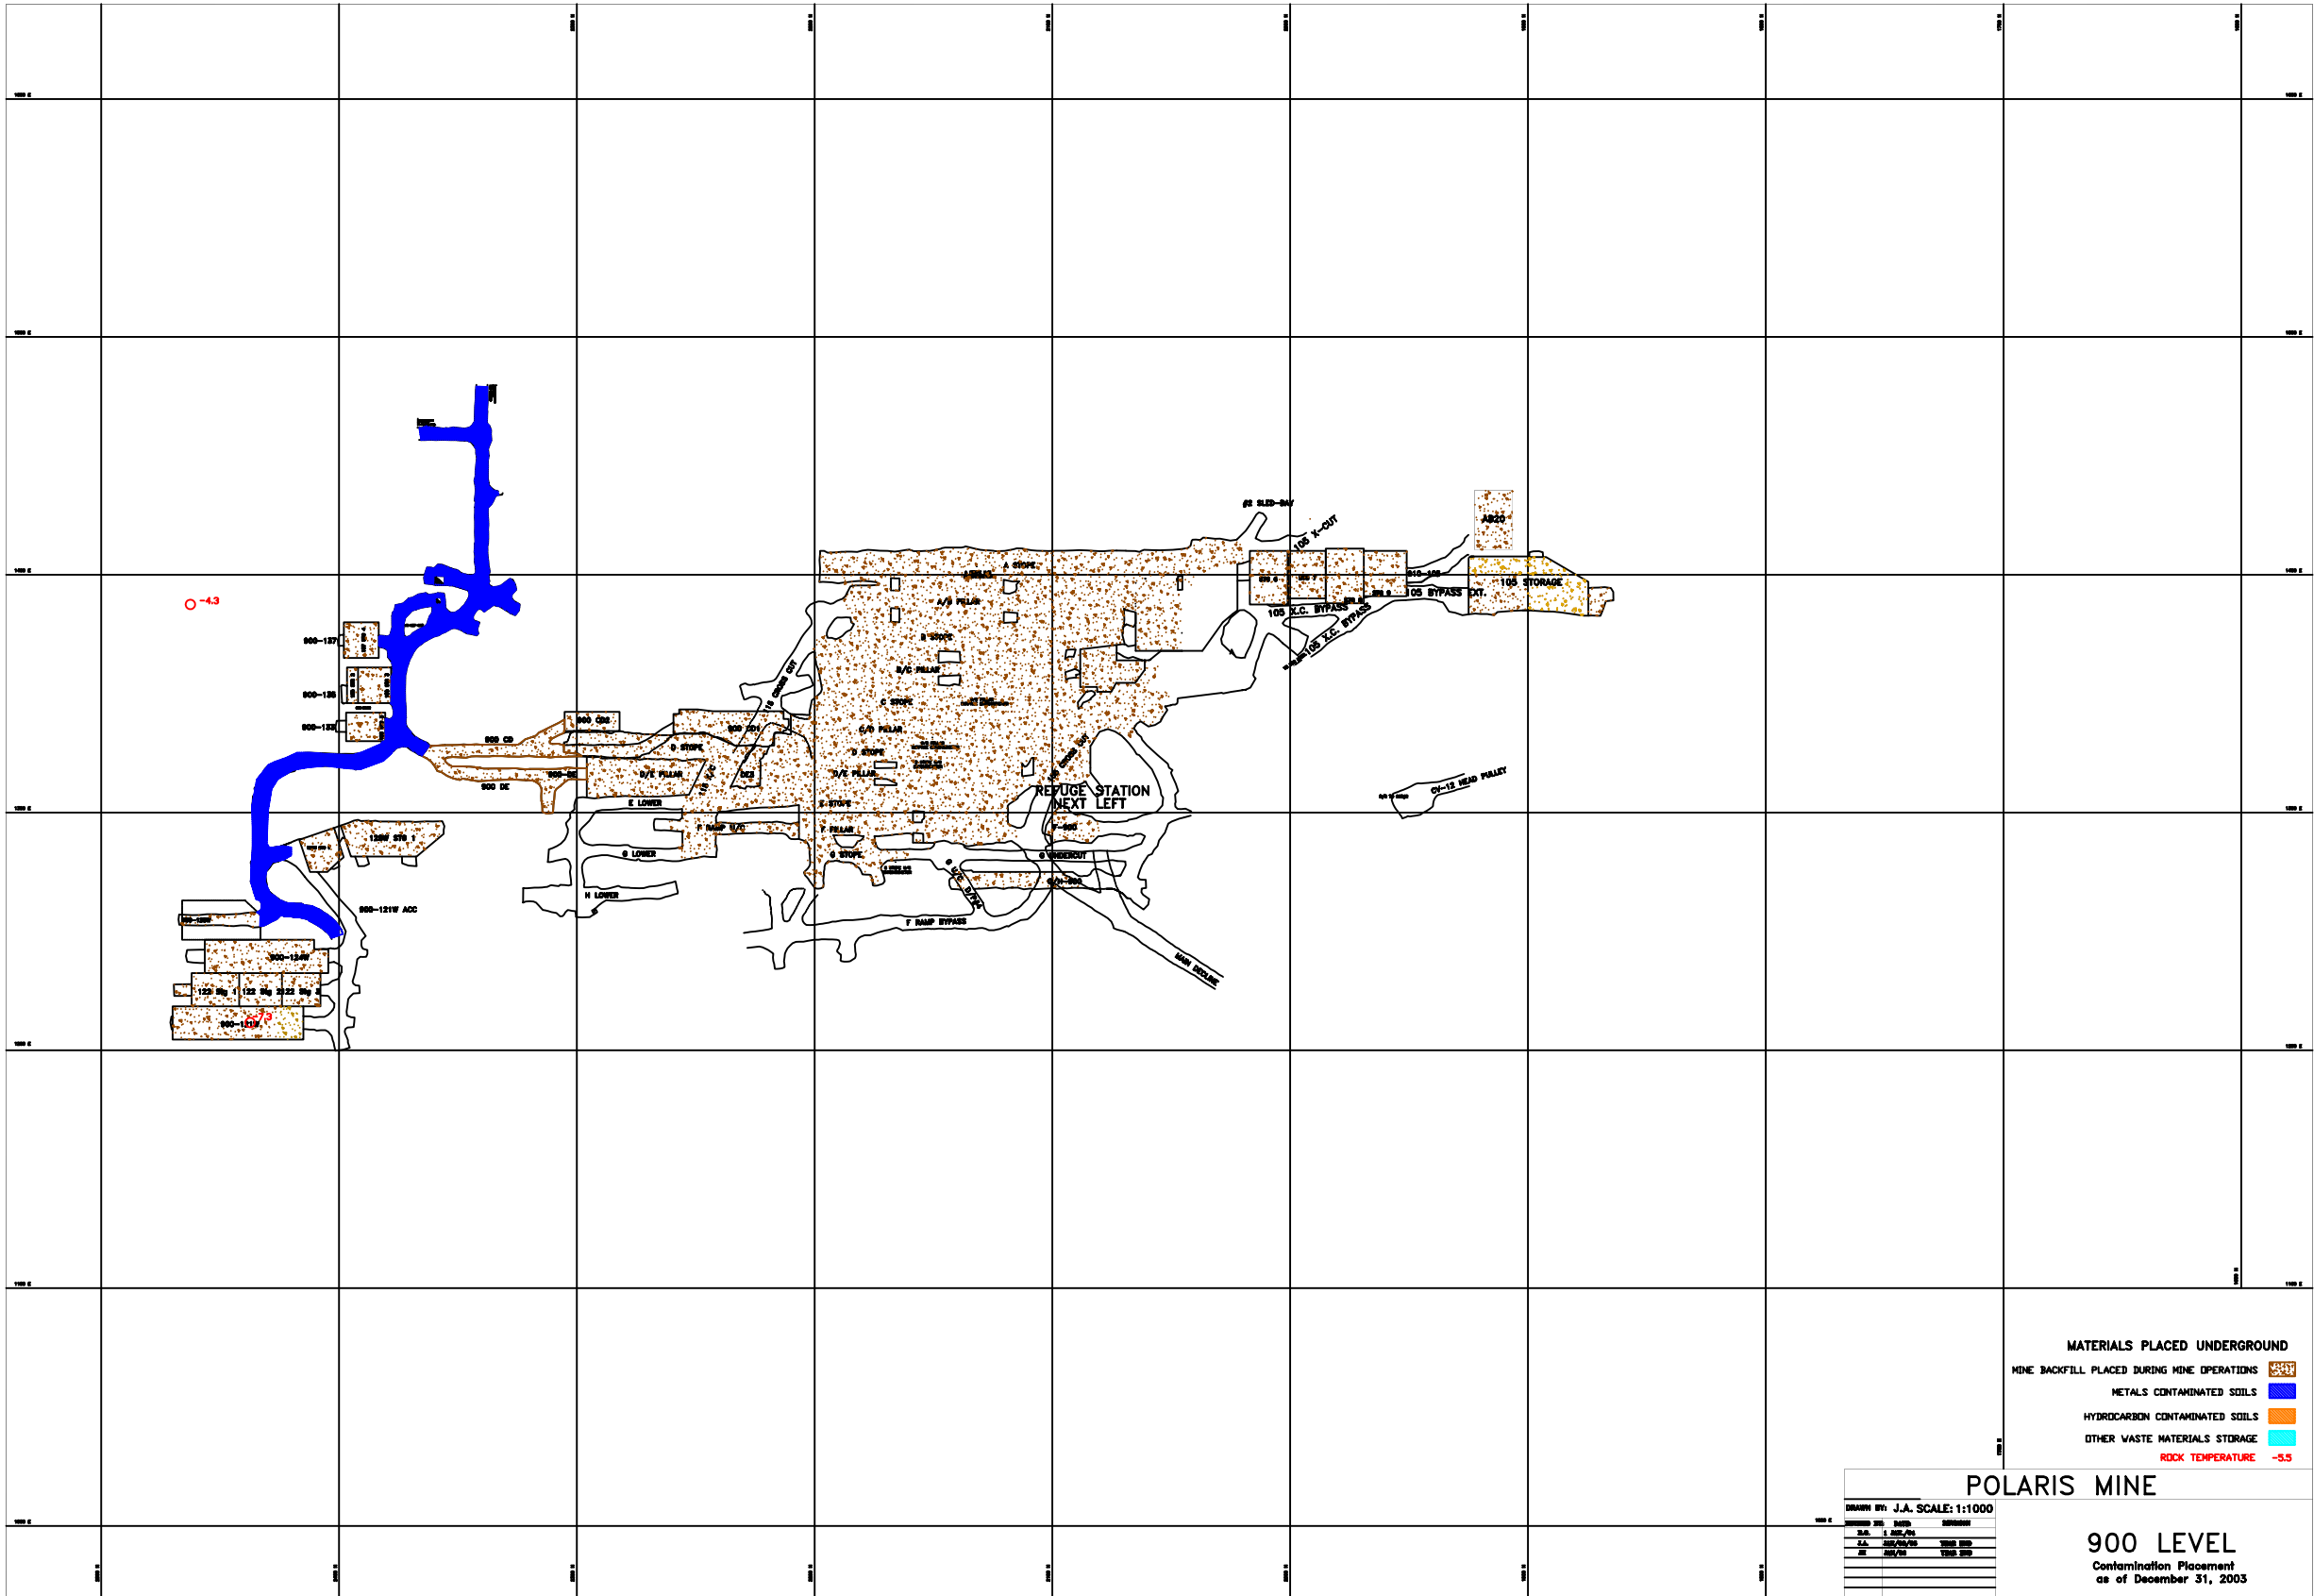

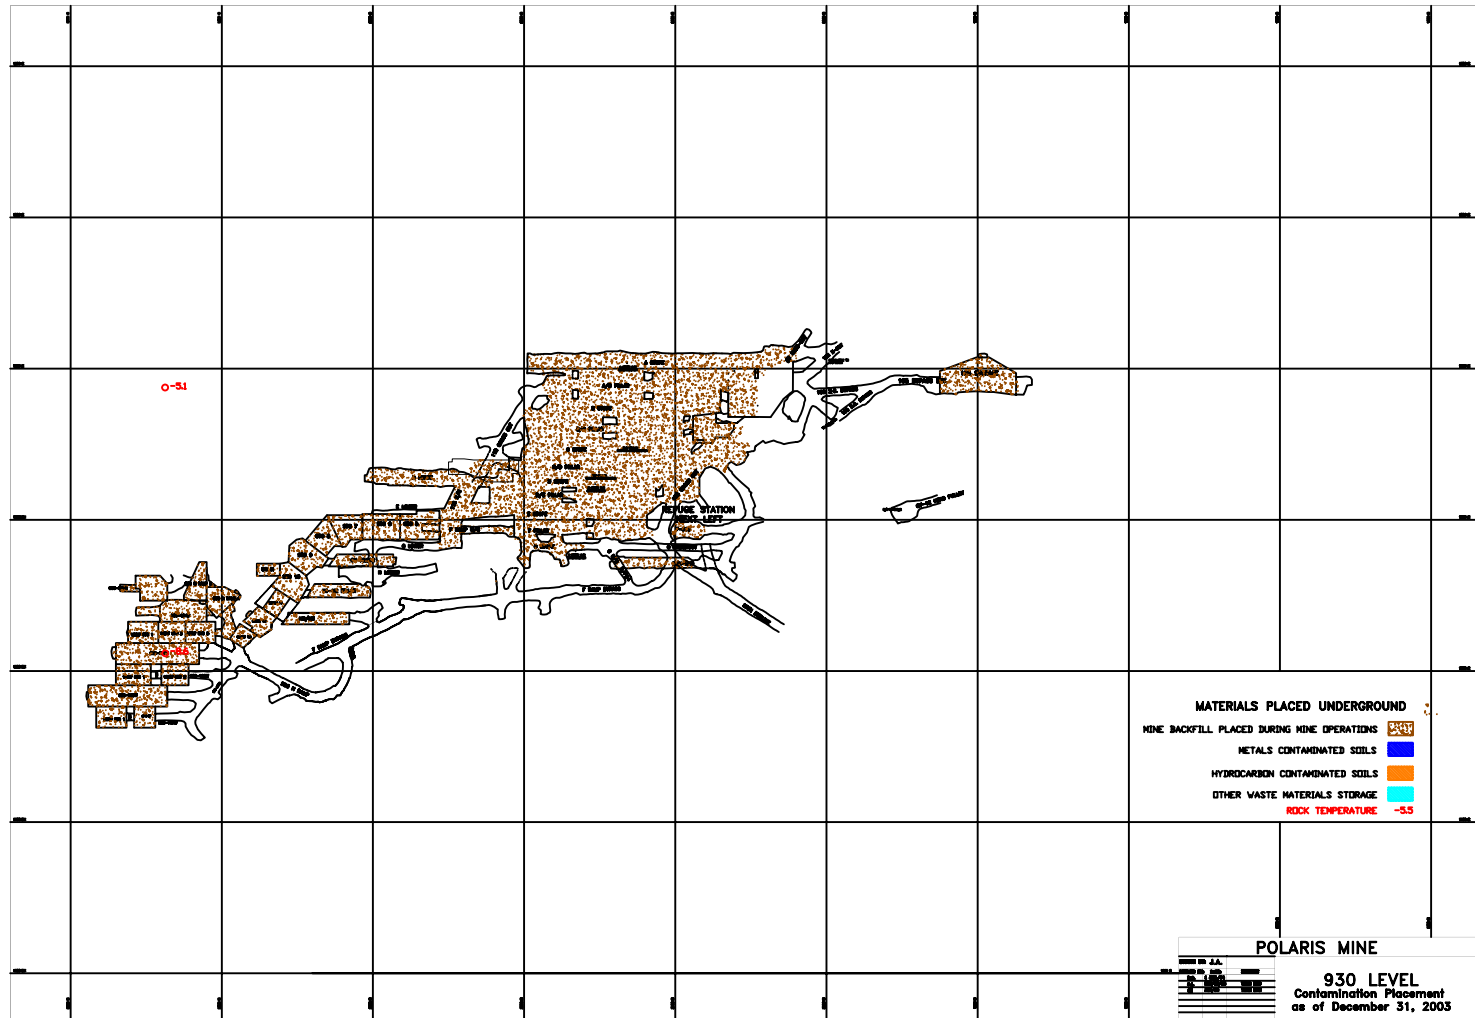

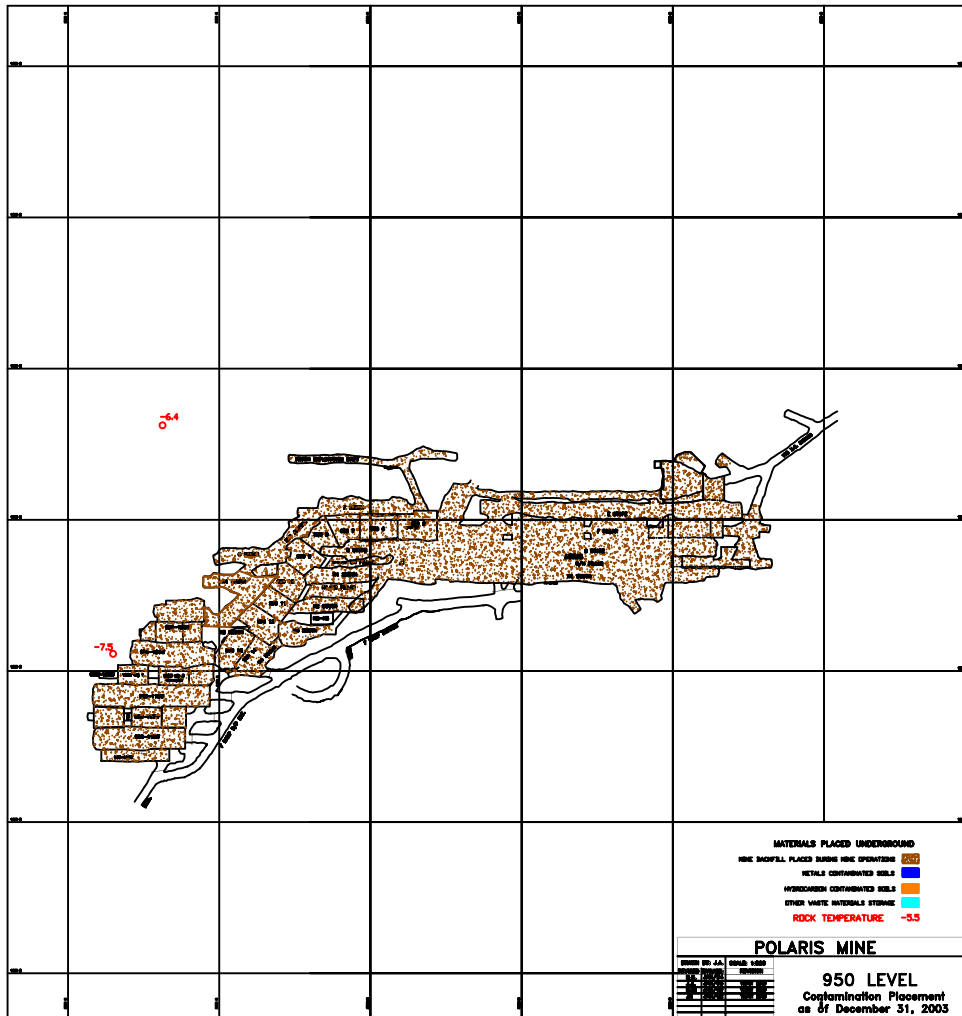

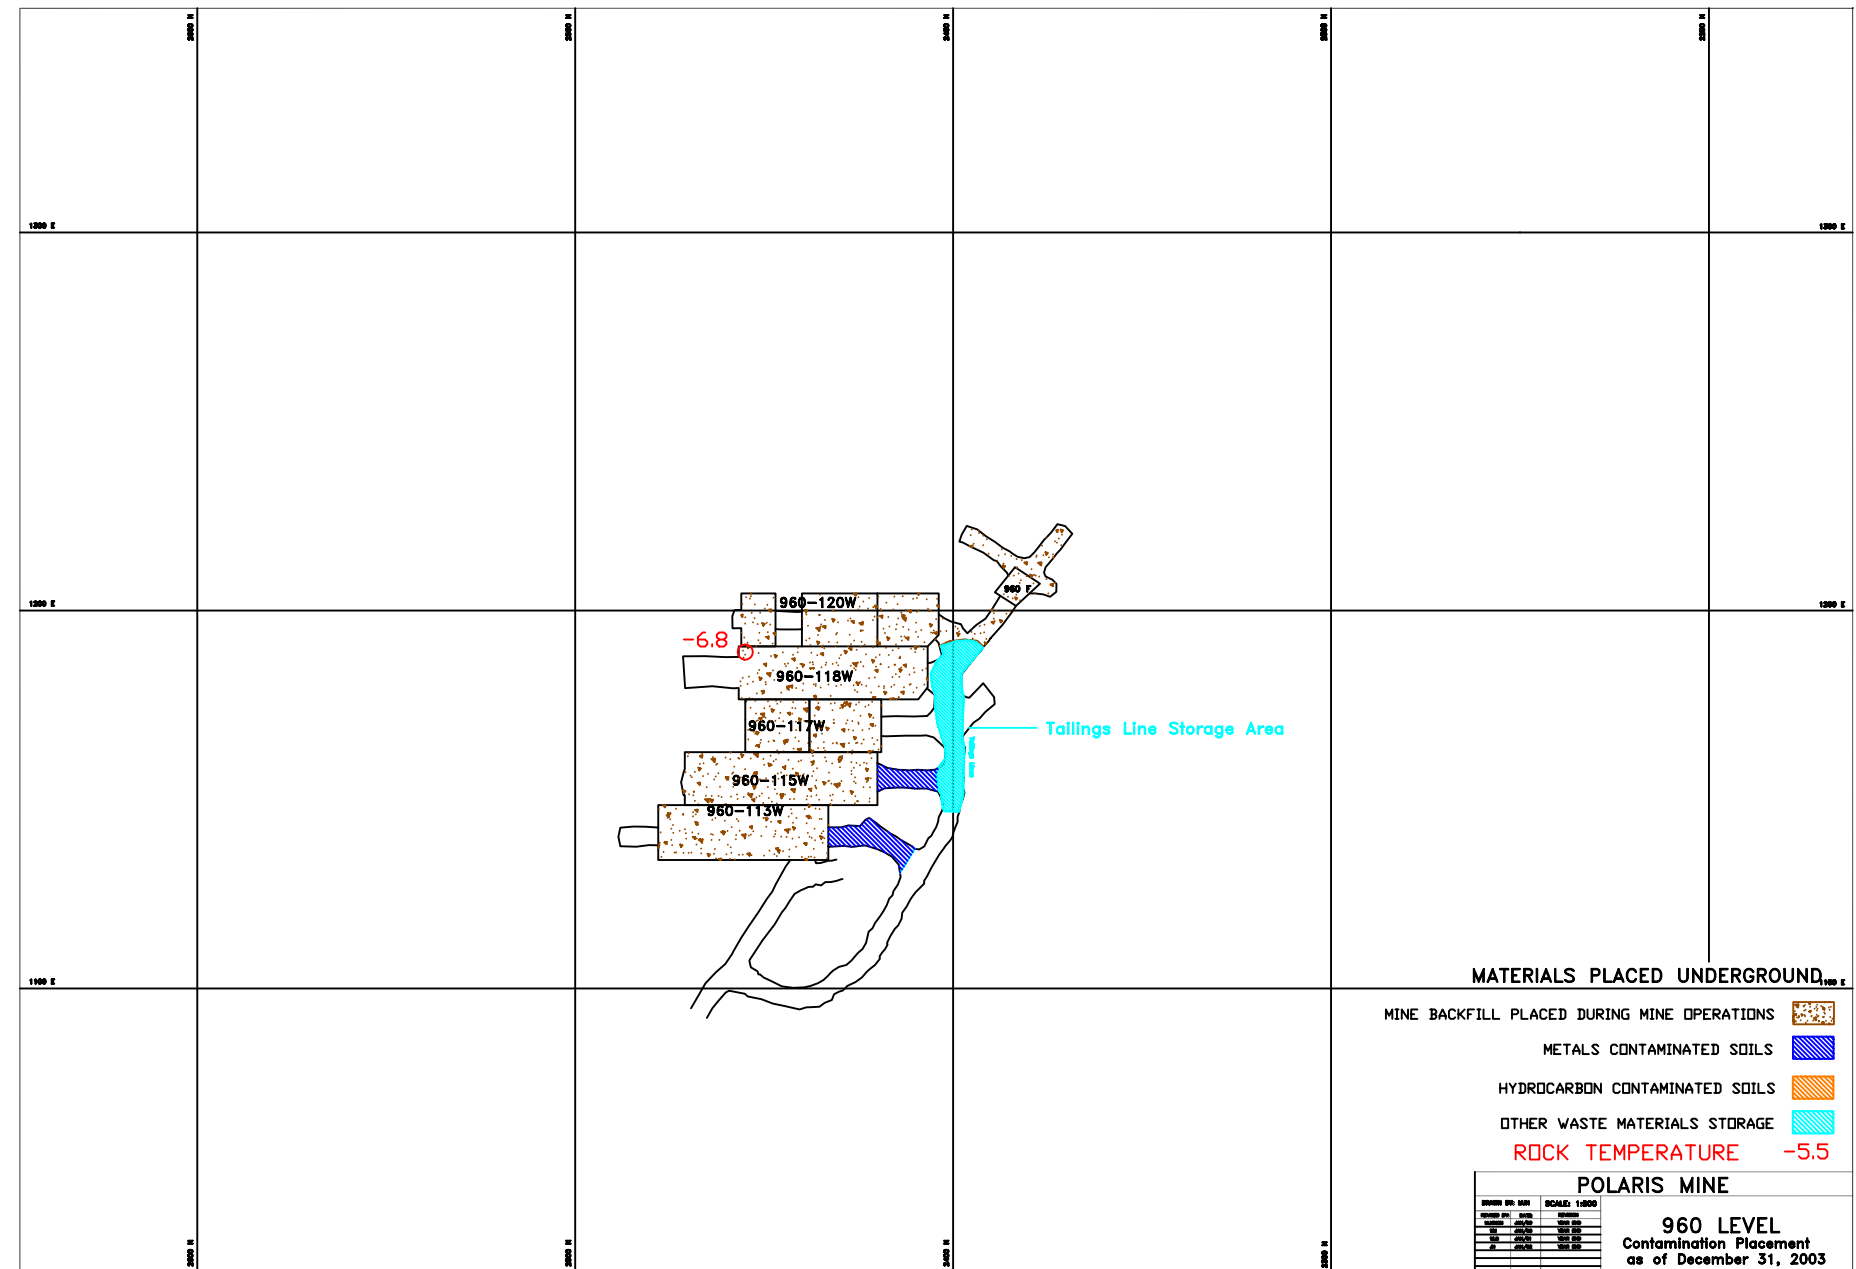

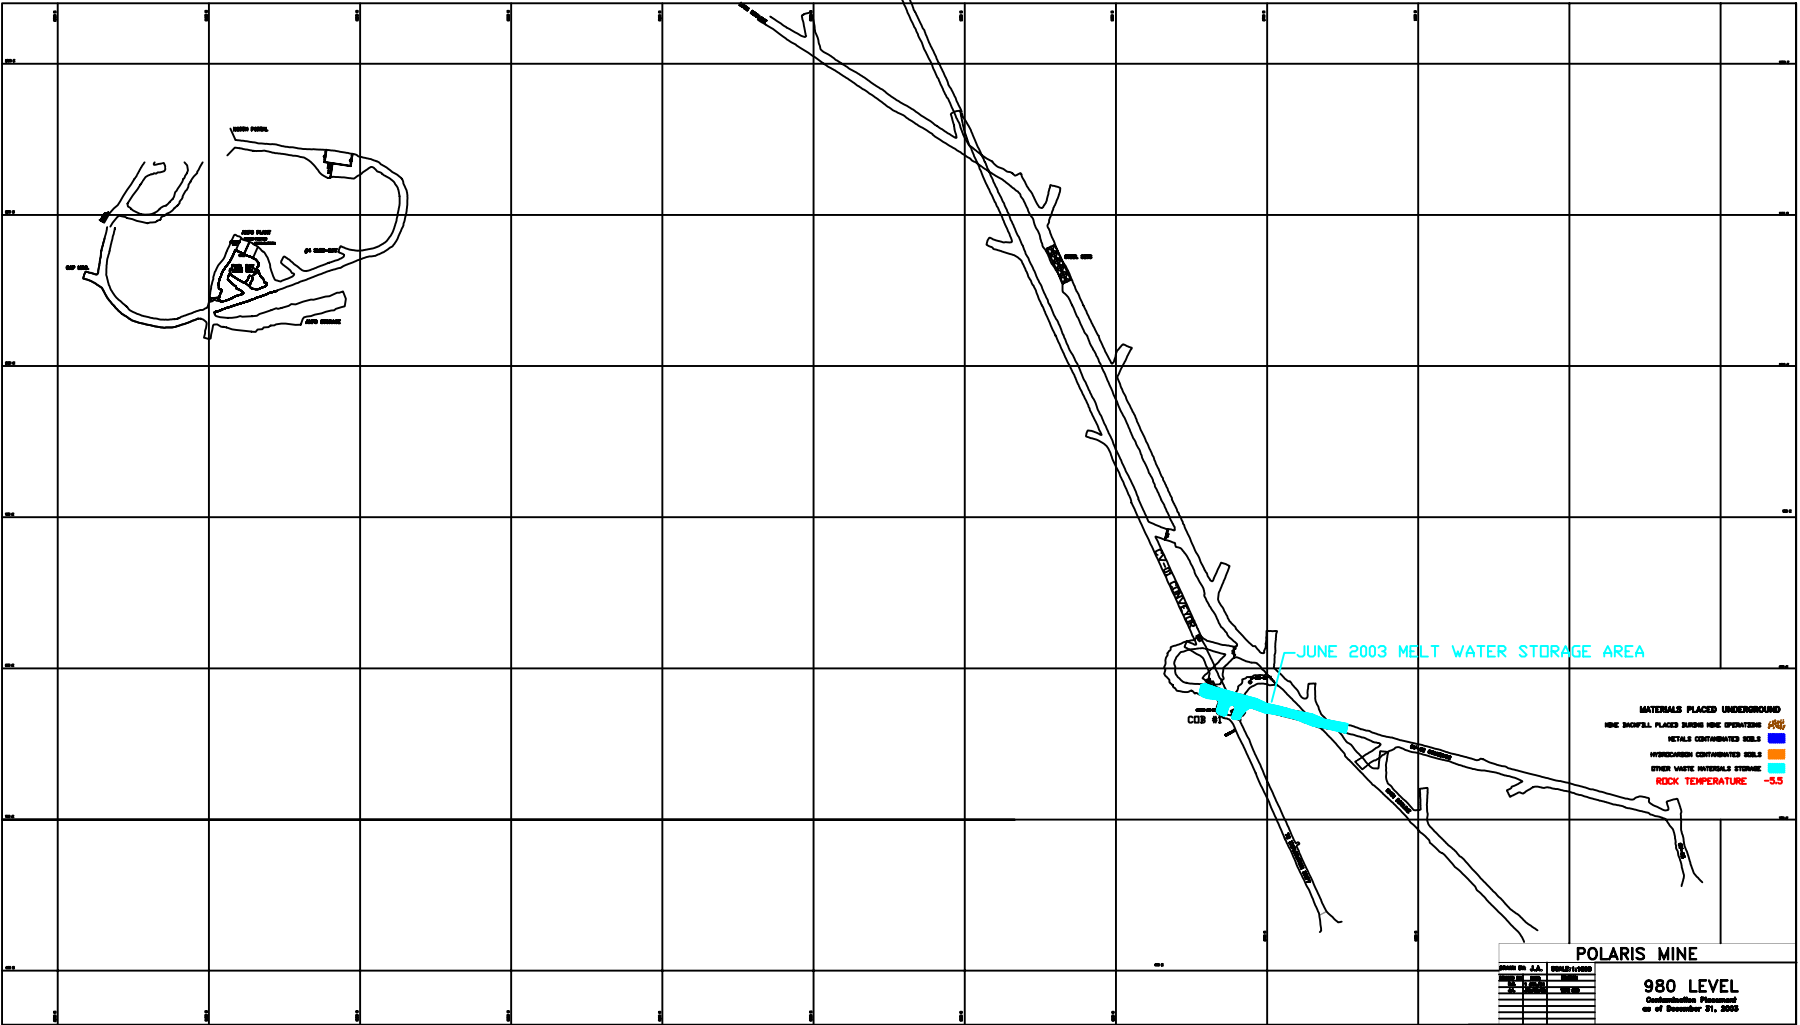

APPENDIX 13

GARROW LAKE EROSION MONITORING

2004 GARROW LAKE EROSION MONITORING PINS

The data recorded in the attached table for the Erosion monitoring pin at Station 10 on July 17, 2004 is incorrect. Not sure whether the wrong pin was measured or if the data was just incorrectly recorded.

However, there is sufficient data to compare 2004 data to 2003 data. There is no sign of erosion at any of the locations being monitored.

There were no pictures or measurements of the erosion pins taken in either June or September due to snow conditions around the lake. In July obtained pictures and measurements of three of the four pins and in August obtained measurements and photographs of all pins.

Pin measurements indicate no significant movements occurred during either of 2003 or 2004.

GARROW LAKE EROSION MONITORING PINS

Month	Distance (cm) - Top of Pin to Ground				Photographs Taken
	Stn. 8	Stn. 9	Stn. 10	Stn. 11	
Jul-03	56.5	45	61.5	50	Yes
Aug-03	56.5	45	61.5	50	Yes
Sep-03	56.5	44	61	50	Yes
Jun-04	n.a.	n.a.	n.a.	n.a.	No
17-Jul-04	57.0	n.a.	17.5	50.7	Yes (2 only)
18-Aug-04	56.5	45.1	61.5	50.7	Yes but can't locate
Sep-04	n.a.	n.a.	n.a.	n.a.	No

Station # 8 - Garrow Lake North

Quadrant

Station # 9 - Garrow Lake East

Quadrant

Station # 10 - Garrow Lake South

Quadrant

Station # 11 - Garrow Lake West

Quadrant


Note 1 - distance measured is along the side of the pin (not vertical distance)

Note 2 - "Not Available" - Can not measure pin as either buried in snow or obstructed by ice

JULY 2004 PHOTOGRAPHS



Erosion Pin Station # 8 – July 17, 2004

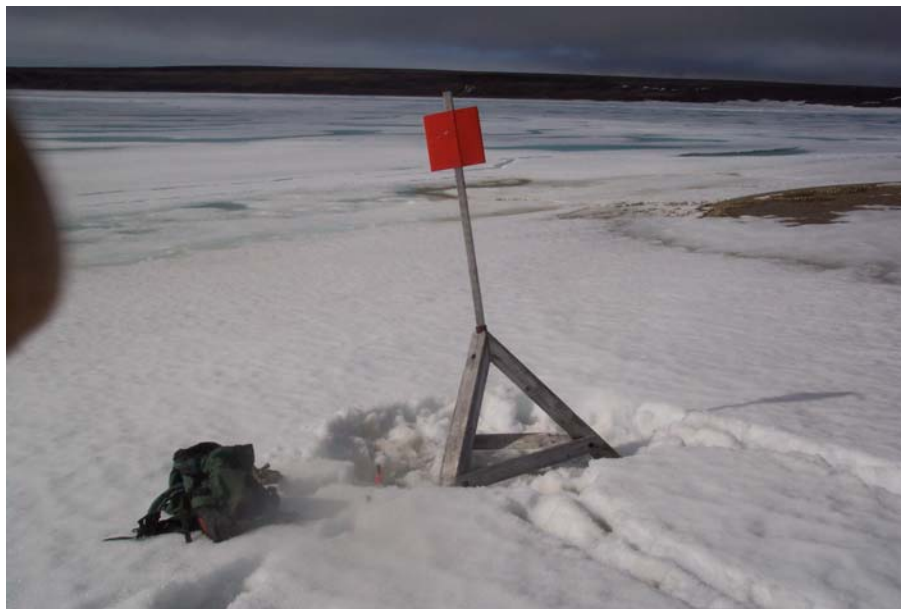

Erosion Pin Station #9 – July 17, 2004

JULY 2004 PHOTOGRAPHS




Erosion Pin # 11 – July 17, 2004

AUGUST 2004 PHOTOGRAPHS



Erosion Pin Station #8 - August 18, 2004

AUGUST 2004 PHOTOGRAPHS

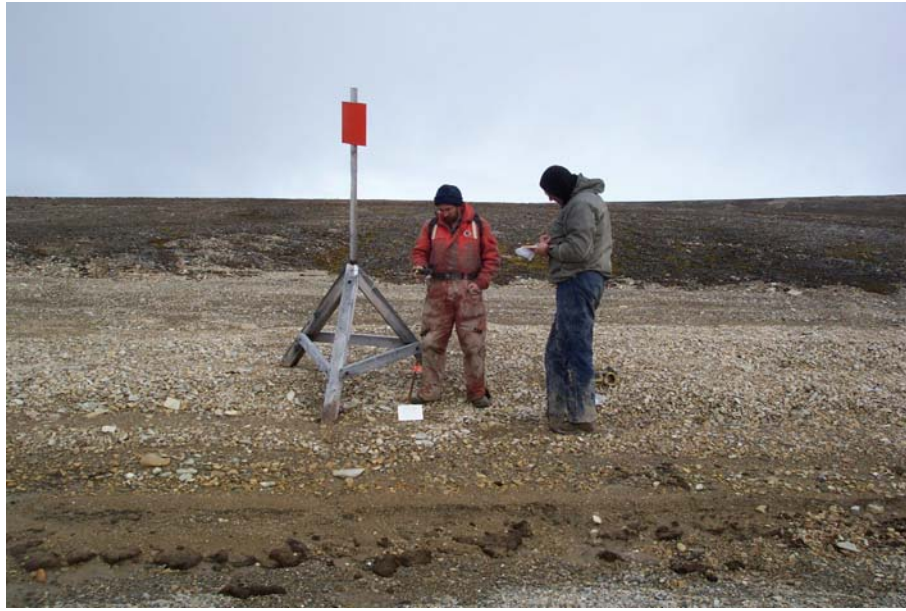

Erosion Pin Station #9 – August 18, 2004



Erosion Pin Station #10 – August 18, 2004

AUGUST 2004 PHOTOGRAPHS



Erosion Pin Station 11 – August 18, 2004

APPENDIX 14

GARROW CREEK EROSION MONITORING

GARROW CREEK EROSION MONITORING – POST DAM DECOMMISSIONING


Approvals for the decommissioning of the Garrow dam included monitoring requirements when there were surface flows the first summer the dam was decommissioned. Monitoring included:

1. Erosion Monitoring using rebar pins in the creek bed that are measured weekly during the period of flow,
2. TSS sampling weekly during the period of flow,
3. Photographic records of the creek flow from established locations weekly during the period of flow, and
4. Photographic record at regular intervals along the length of the creek once at the end of the discharge season to document conditions.

1. EROSION MONITORING PINS

Three rebar pins were placed into the creek channel to monitor for erosion of the creek bottom (see photographs below). One pin was placed near the outlet of Garrow Lake, one about midway between the lake and the ocean, and one near the outlet of the creek into the ocean.

Below are photographs of each of the three pins.

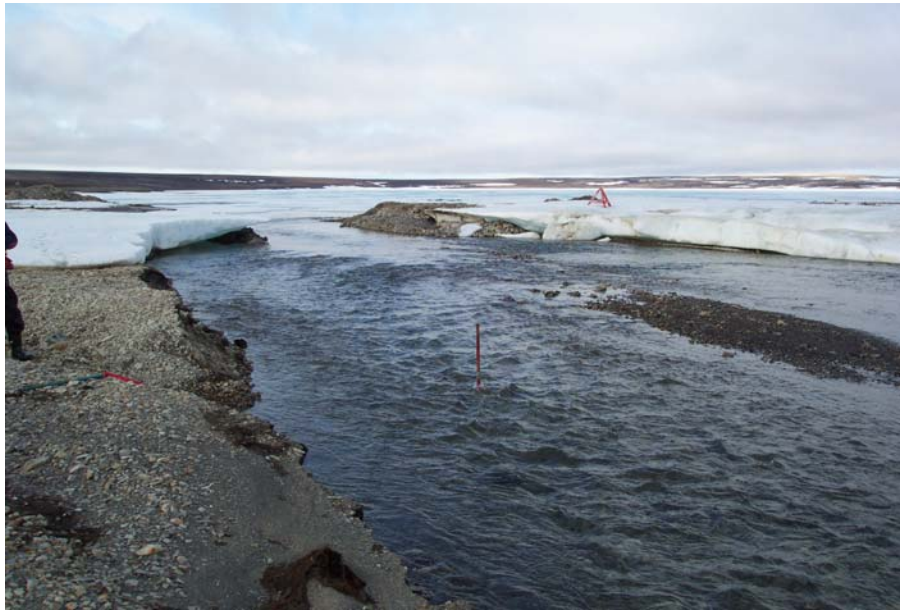

Station 12 – Near the outlet of Garrow Lake



Station 13 – Midway between Garrow Lake and the Ocean



Station 14 – Near the Outlet of the Creek into the Ocean

On a weekly basis starting on July 16th, measurements were taken from the top of the pin to the creek bottom. Any erosion of the channel bottom at the location of the pin would be identified by the distance from the top of the pin to the creek bed. The measurements taken during the flow period seem to suggest that the bed of the creek was dynamic and in the case of two of the three monitoring stations, indicated some deposition of material in the stream bed.

GARROW CREEK - EROSION MONITORING DURING DAM DECOMMISSIONING

Station	Location	Date	Height of Pin above Gnd/ Creek Bed (mm)	Height of Water above Creek Bed (mm)	Erosion since date set (mm)	UTM 14 Coords		Comments
12	Garrow Creek - near outlet of Garrow Lake	July 16 2004	1000	350		561605	8367448	Set erosion pin 2.5m east of west bank. Set at 5:00 pm. See photo
		July 20 2004	980	280	20			
		July 27 2004	980	100	20			
		August 3 2004	995	30	5			
		August 10, 2004	995	35	5			
		August 17, 2004	1000	30	0			
		August 21, 2004	1000	30	0			Wavebreak channel plugged to control flow. Water from lake is not flowing into creek.
13	Garrow Creek - midway between Garrow Lake and Garrow Bay	July 16 2004	830	370		561730	8366764	Set erosion pin 9.0 m east of west bank. Set at 5:00 pm. See photo
		July 20 2004	800	260	30			see photo
		July 20 2004	800	110	30			
		August 3 2004	790	25	40			
		August 10, 2004	785	65	45			
		August 17, 2004	790	70	40			
		August 21, 2004	805	80	25			
14	Near mouth of Garrow Garrow Creek discharging into Garrow Bay	July 17 2004	550	300		561925	8366248	Set erosion pin approx. 50 ft from mouth of Garrow Bay. Set at 5:00 pm See photo
		July 20 2004	550	420	0			see photo
		July 24 2004	535	40	15			
		August 3 2004	530	30	20			
		August 10, 2004	530	25	20			
		August 17, 2004	530	25	20			
		August 21, 2004	535	25	15			

2. TSS MEASUREMENTS

On a weekly basis, TSS samples were taken from the Final Discharge Point (designated under MMER). The samples were analyzed by ALS Laboratories in Vancouver. The samples were submitted along with the routine weekly and monthly sampling required under the MMER requirements.

On July 6th, 2004 the TSS results exceeded permit and MMER criteria. This was reported to Environment Canada. At the same time as the TSS sample was collected, samples were also collected for Total Metals and Acute Toxicity. The results indicated that the TSS was not caused by mobilization of tailings but rather from erosion of the creek channel. All metals concentrations in the water were compliant with the Water Licence and MMER criteria. Additionally, the Acute Toxicity testing for Rainbow Trout and *Daphnia magna* show there was no acute toxicity. All other TSS sampling events during the discharge season were compliant with the Water Licence and the MMER.

TSS MONITORING OF GARROW CREEK At Station 12

Date	TSS	ALS Sample #
6-Jul-08	117	U5572
13-Jul-04	5.7	U5829
20-Jul-04	<3.0	U6161
27-Jul-04	<3.0	U6382
3-Aug-24	3.3	U6832
10-Aug-24	3	U6897
17-Aug-04	5.3	U7327
24-Aug-04	4.4	U7610
31-Aug-04	14.5	U7699
3-Sep-04	3.3	U8363
7-Sep-04	9.7	U7985

3. PHOTOGRAPHIC RECORD DURING DISCHARGE SEASON

The following photographs were generally taken from the same locations each time to provide a record of flow and creek channel changes that occurred over time during the 2004 discharge period. The requirement was to do this on a weekly basis but this was done on a more frequent basis through July when the flow was at its highest. It is evident from the photographs that some erosion of the channel occurred during the peak flows. The dam was decommissioned prior to spring melt and more water than anticipated was initially released as the ice on the lake and in the channel melted.



July 5 2004



July 6 2004





July 7 2004



July 8 2004



July 9 2004



July 10 2004





July 11 2004





July 12 2004



July 14 2004



July 15 2004



July 20 2004



July 25 2004



July 26 2004



July 30 2004



Aug 3 2004





Aug 10 2004





Aug 17 2004



4. PHOTOGRAPHIC RECORD OF CREEK CHANNEL NEAR END OF DISCHARGE SEASON

The monitoring program also included the requirement to take a series of photographs along the complete length of Garrow Creek channel once flow for the season had been concluded. Due to weather conditions, the channel would have been under snow before all water had ceased flowing so the photography was done near the end of July when flow was low and before snow covered the landscape. A series of survey markers were set up every 100 metres along the length of the channel starting at Garrow Lake outflow origin through to where the creek discharges into the ocean. The following photographs are identified by the distance from the origin of the creek flow.

GARROW CREEK

PHOTOGRAPHIC RECORD OF
CONDITIONS ALONG THE ENTIRE
LENGTH OF CREEK JULY 26, 2004
NEAR THE END OF DISCHARGE SEASON

STATION 0 +00



STATION 0 +100



STATION 0 +200



STATION 0 +300



STATION 0 +400



STATION 0 +500




STATION 0 +600



STATION 0 +700




STATION 0 +800

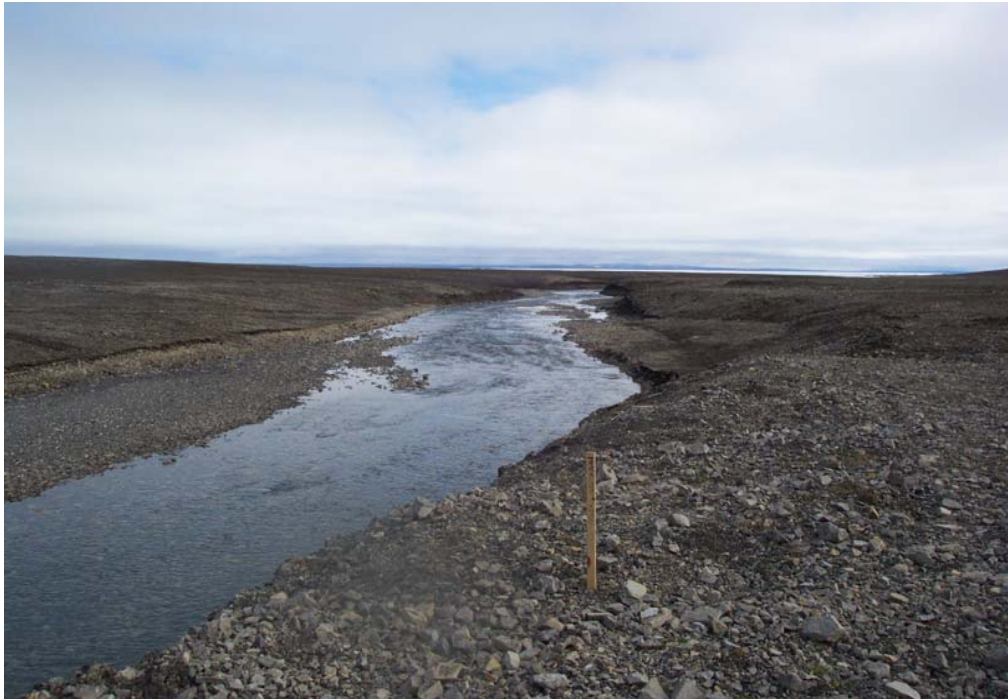

STATION 0 +900




STATION 0 +1000

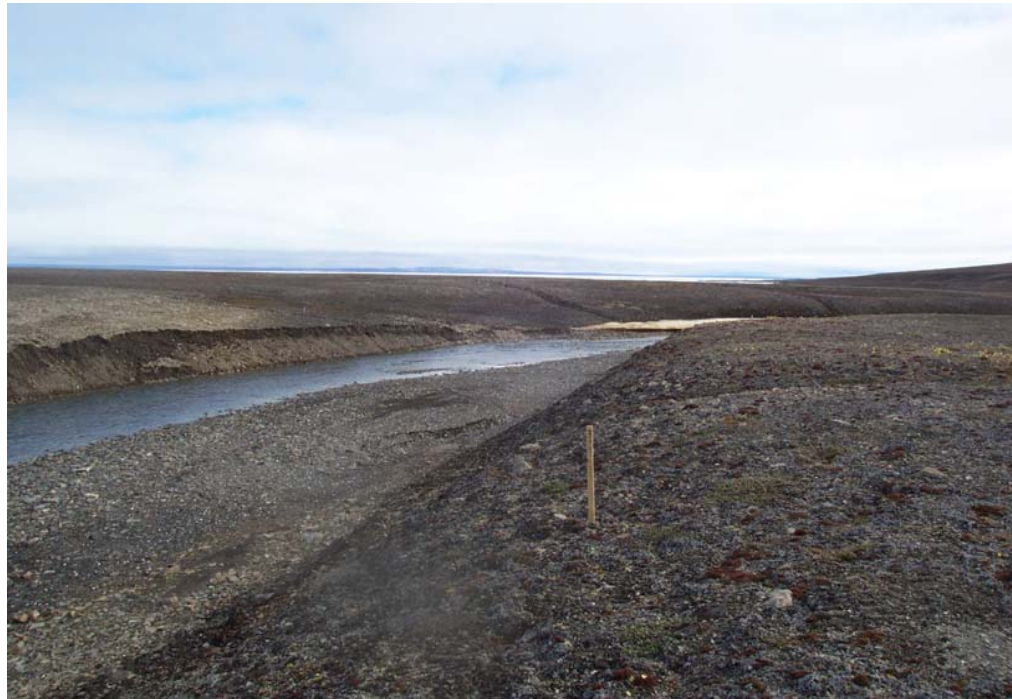

STATION 0 +1100



STATION 0 +1200

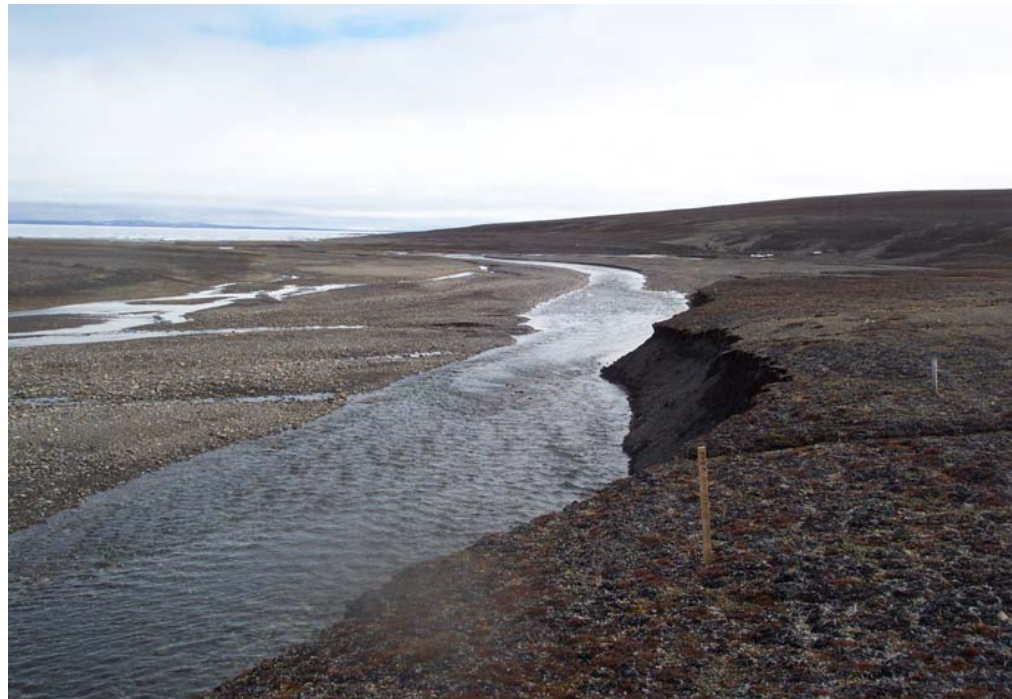

STATION 0 +1300



STATION 0 +1400



STATION 0 +1500



STATION 0 +1600



STATION 0 +1700



STATION 0 +1800

