


1	!	!			<u>!</u>	
340.5						pag 9
			2 7			
		HI COMES	Salvan 3			
		, ujecesco:	B HOPTIN			
man 6		No.				
		o/H UNDERCUT	E-STOPE  O-STOPE  O-S	A-31		
200 5			Tope:			100 t
		PT SLED BAY		T. S.		
- m-r		SCHIO.				
				7 3		
T. Common on July Com						
MATERIALS PLACED DURING HILL HETALS CONTAIN HETALS						Old 8
MATERIALS  E MACETIL PLACED D  WETW  HYDROCARD  OTHER VAS  ARIS MIN  ARIS MIN  Contamina as of De						
MATERIALS PLACED UNDERGROUND  NOW BACKFLL PLACED DURING WHICE DEPRATIONS  WETALS CONTANDATED SOILS  HYDROCARBON CONTANDATED SOILS  OTHER VASTE MATERIALS STIDAGE  OTHER VASTE MATERIALS STIDAGE  OTHER PROSERVATE MATERIALS STIDAGE  OTHER PROSERVATE MATERIALS STIDAGE  Contamination Proservation of December 31, 2003						

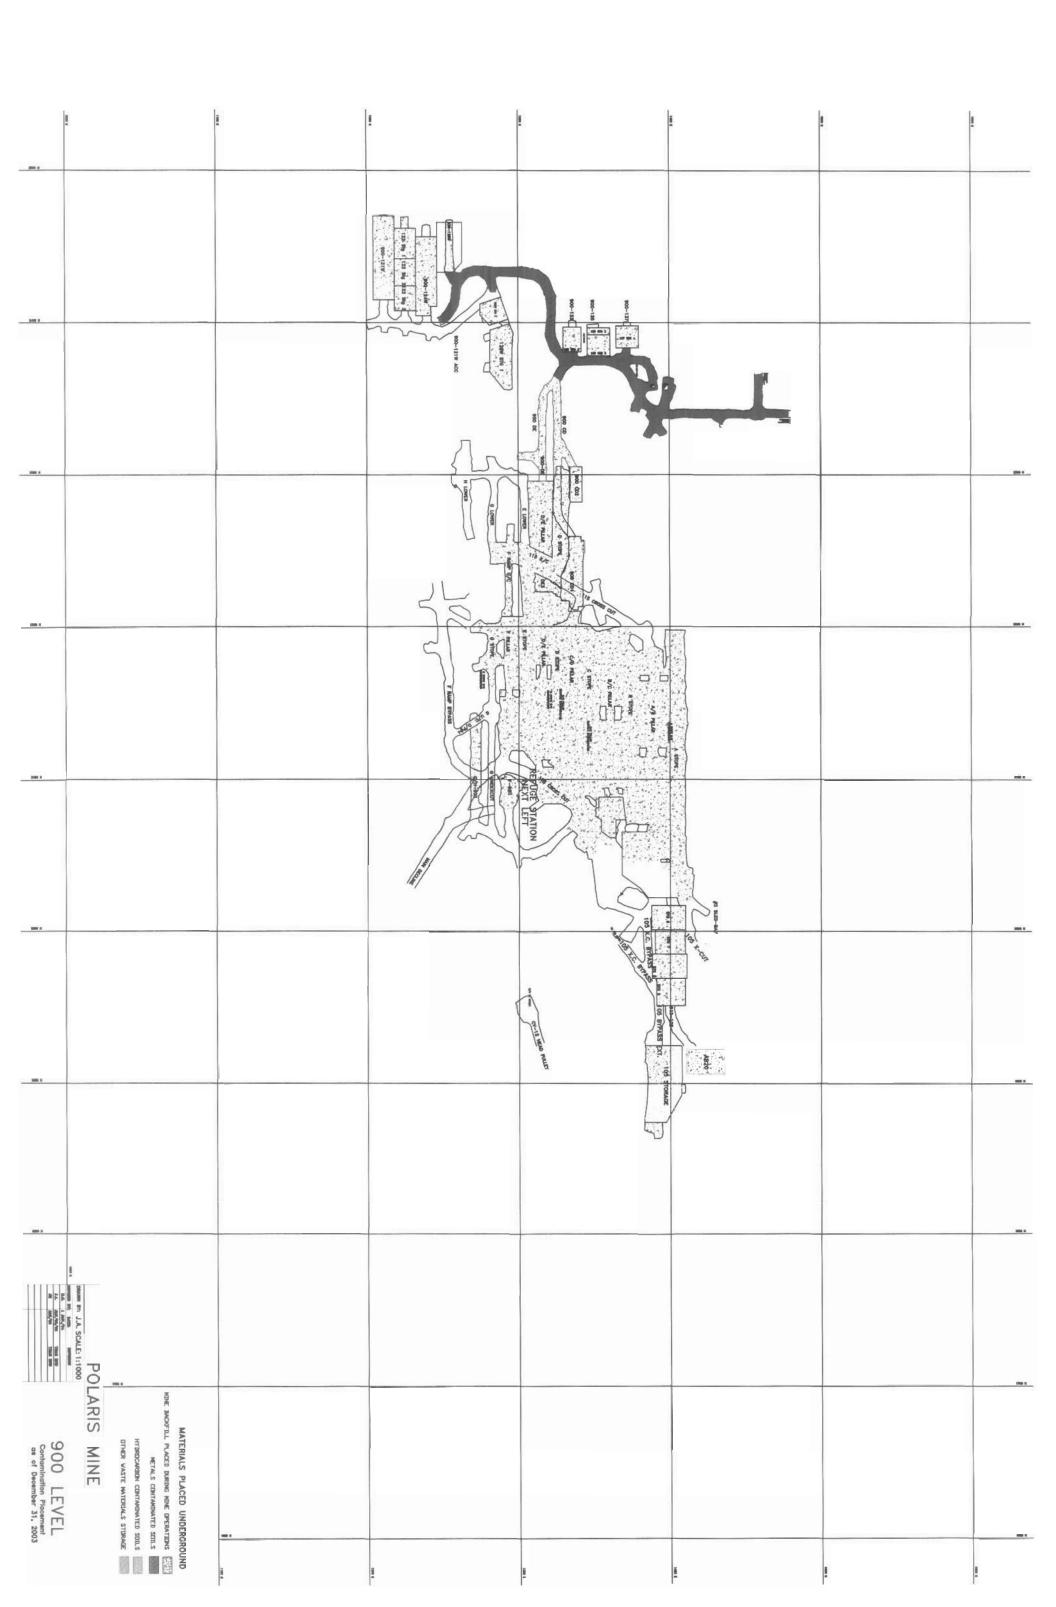

1		
M1		pas s
<b>**</b>		
MR E		700 t
POLARIS  ALL LANGE TO J.A.  BOOM TO J.A.  BOOM TO J.A.  Confor	MATERIALS PLACED UNDERGROUND MINE BACKFILL PLACED DURING MINE OPERATIONS METALS CONTAMINATED SOILS HYDROCARBON CONTAMINATED SOILS OTHER WASTE MATERIALS STORAGE	die s
ARIS MINE  930 LEVEL  Contamination Placement as of December 31, 2003	ALS PLACED UNDERGROUND CED DURING MINE OPERATIONS ETALS CONTAMINATED SOILS CARBON CONTAMINATED S	

		Ĭ.	1 1
	The mone		
MATERIALS PLA  HOME BACKFILL PLACED DURIN  DETALS OF  HYTROCARDON O  OTHER VASTE I  DOLLA PLACE  TOAT BOO  TOAT BOO			
MATERIALS PLACED UNDERGROUND  ME MACETIL PLACED DURING MINE DEPARTIONS SELS  METALS CONTAMINATED SELLS  METALS CONTAMINE  POLARIS MINE  POLARIS MINE  POLARIS MINE  Contamination Placement			

	8
3000 x	
	200 1
980-1-08g	
960-115W 960-115W	
	549 1
lings Lin	
fallings Line Storage Are	
	800 X
MINE BACK	
MATER HYDR	
MATERIALS PLACED UNDERGROUND MINE BACKFILL FLACED DURING MINE DPERATIONS HETALS CONTAMINATED SOILS HYDROCARBON CONTAMINATED SOILS OTHER VASTE MATERIALS STORAGE POLARIS MINE POLARIS MINE  BEACH 1000  960 LEVEL Conformation Placement as of December 31, 2003	
CCED UNDERGROUND  G NIDE DPERATIONS  GNITAMINATED SOILS  UNTAMINATED S	2000 W
MOTE NO 1. 4 AU	

