


## **APPENDIX 11**

### **RECORD OF PLACEMENT OF METALS / HYDROCARBON CONTAMINATED SOILS UNDERGROUND IN THE MINE**

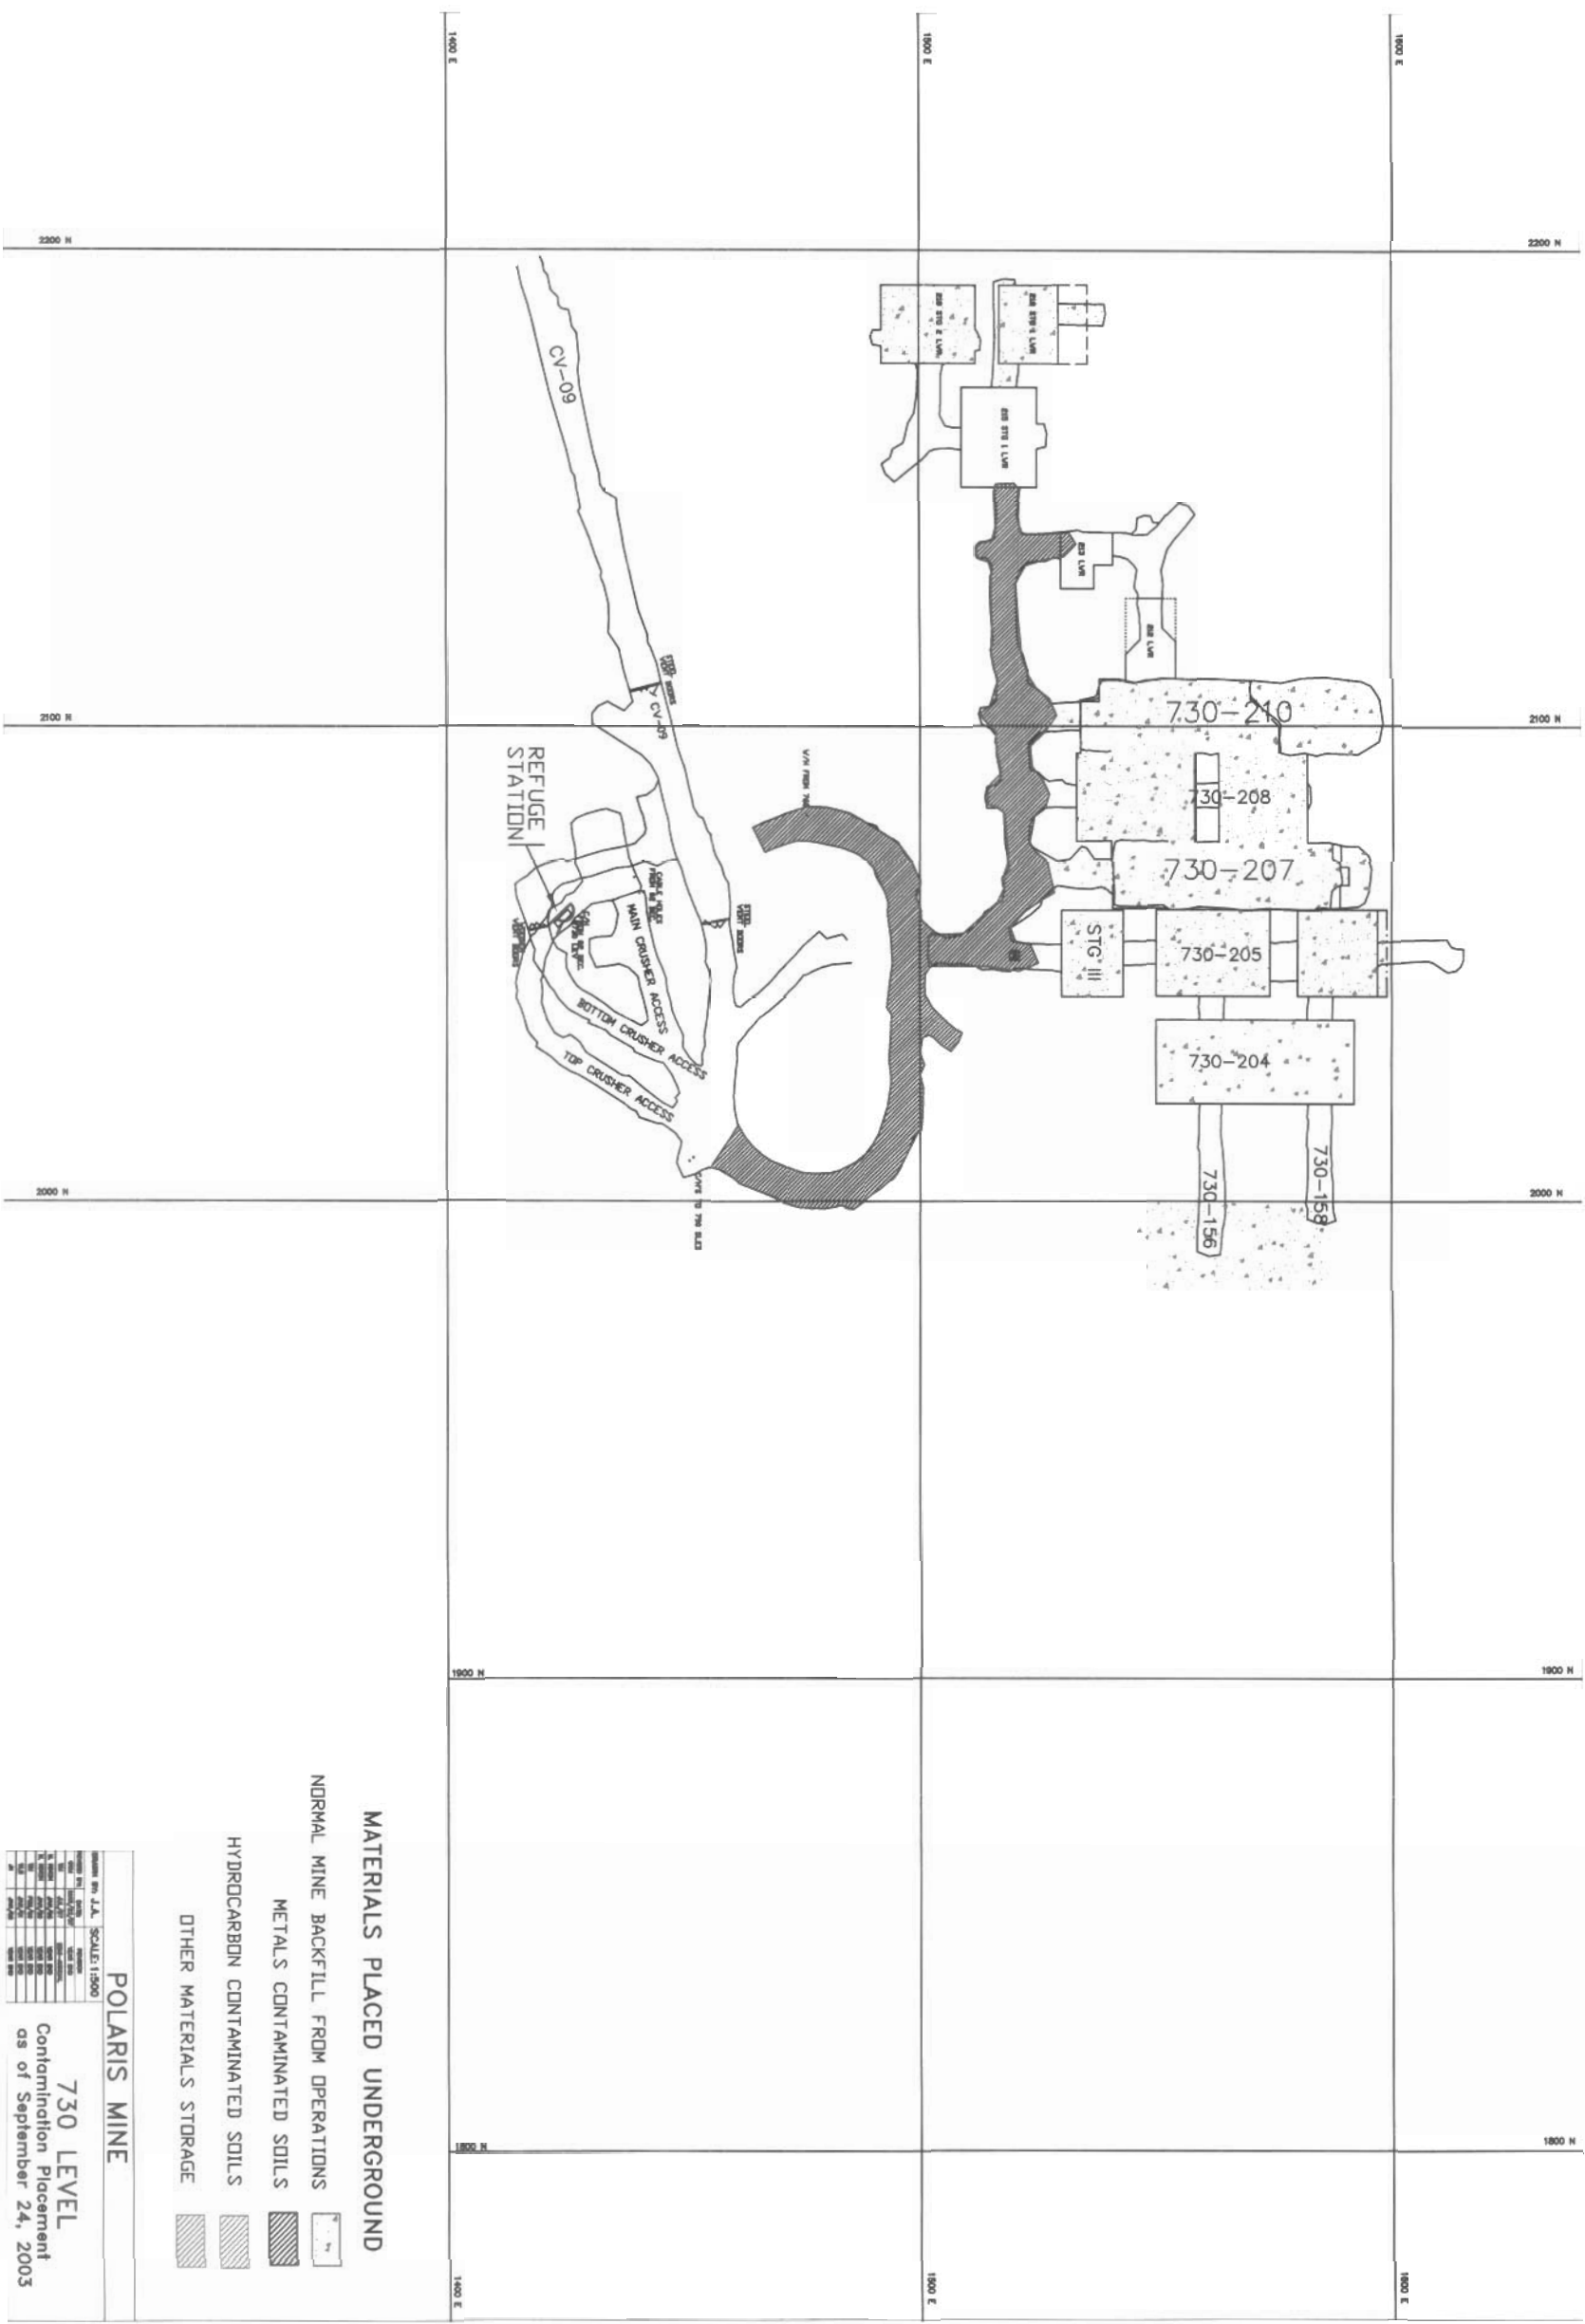

**POLARIS MINE**

**730 LEVEL**

Contamination Placement  
as of September 24, 2003

| SAMPLE NO. J.A. SCALE 1:500 |                  |
|-----------------------------|------------------|
