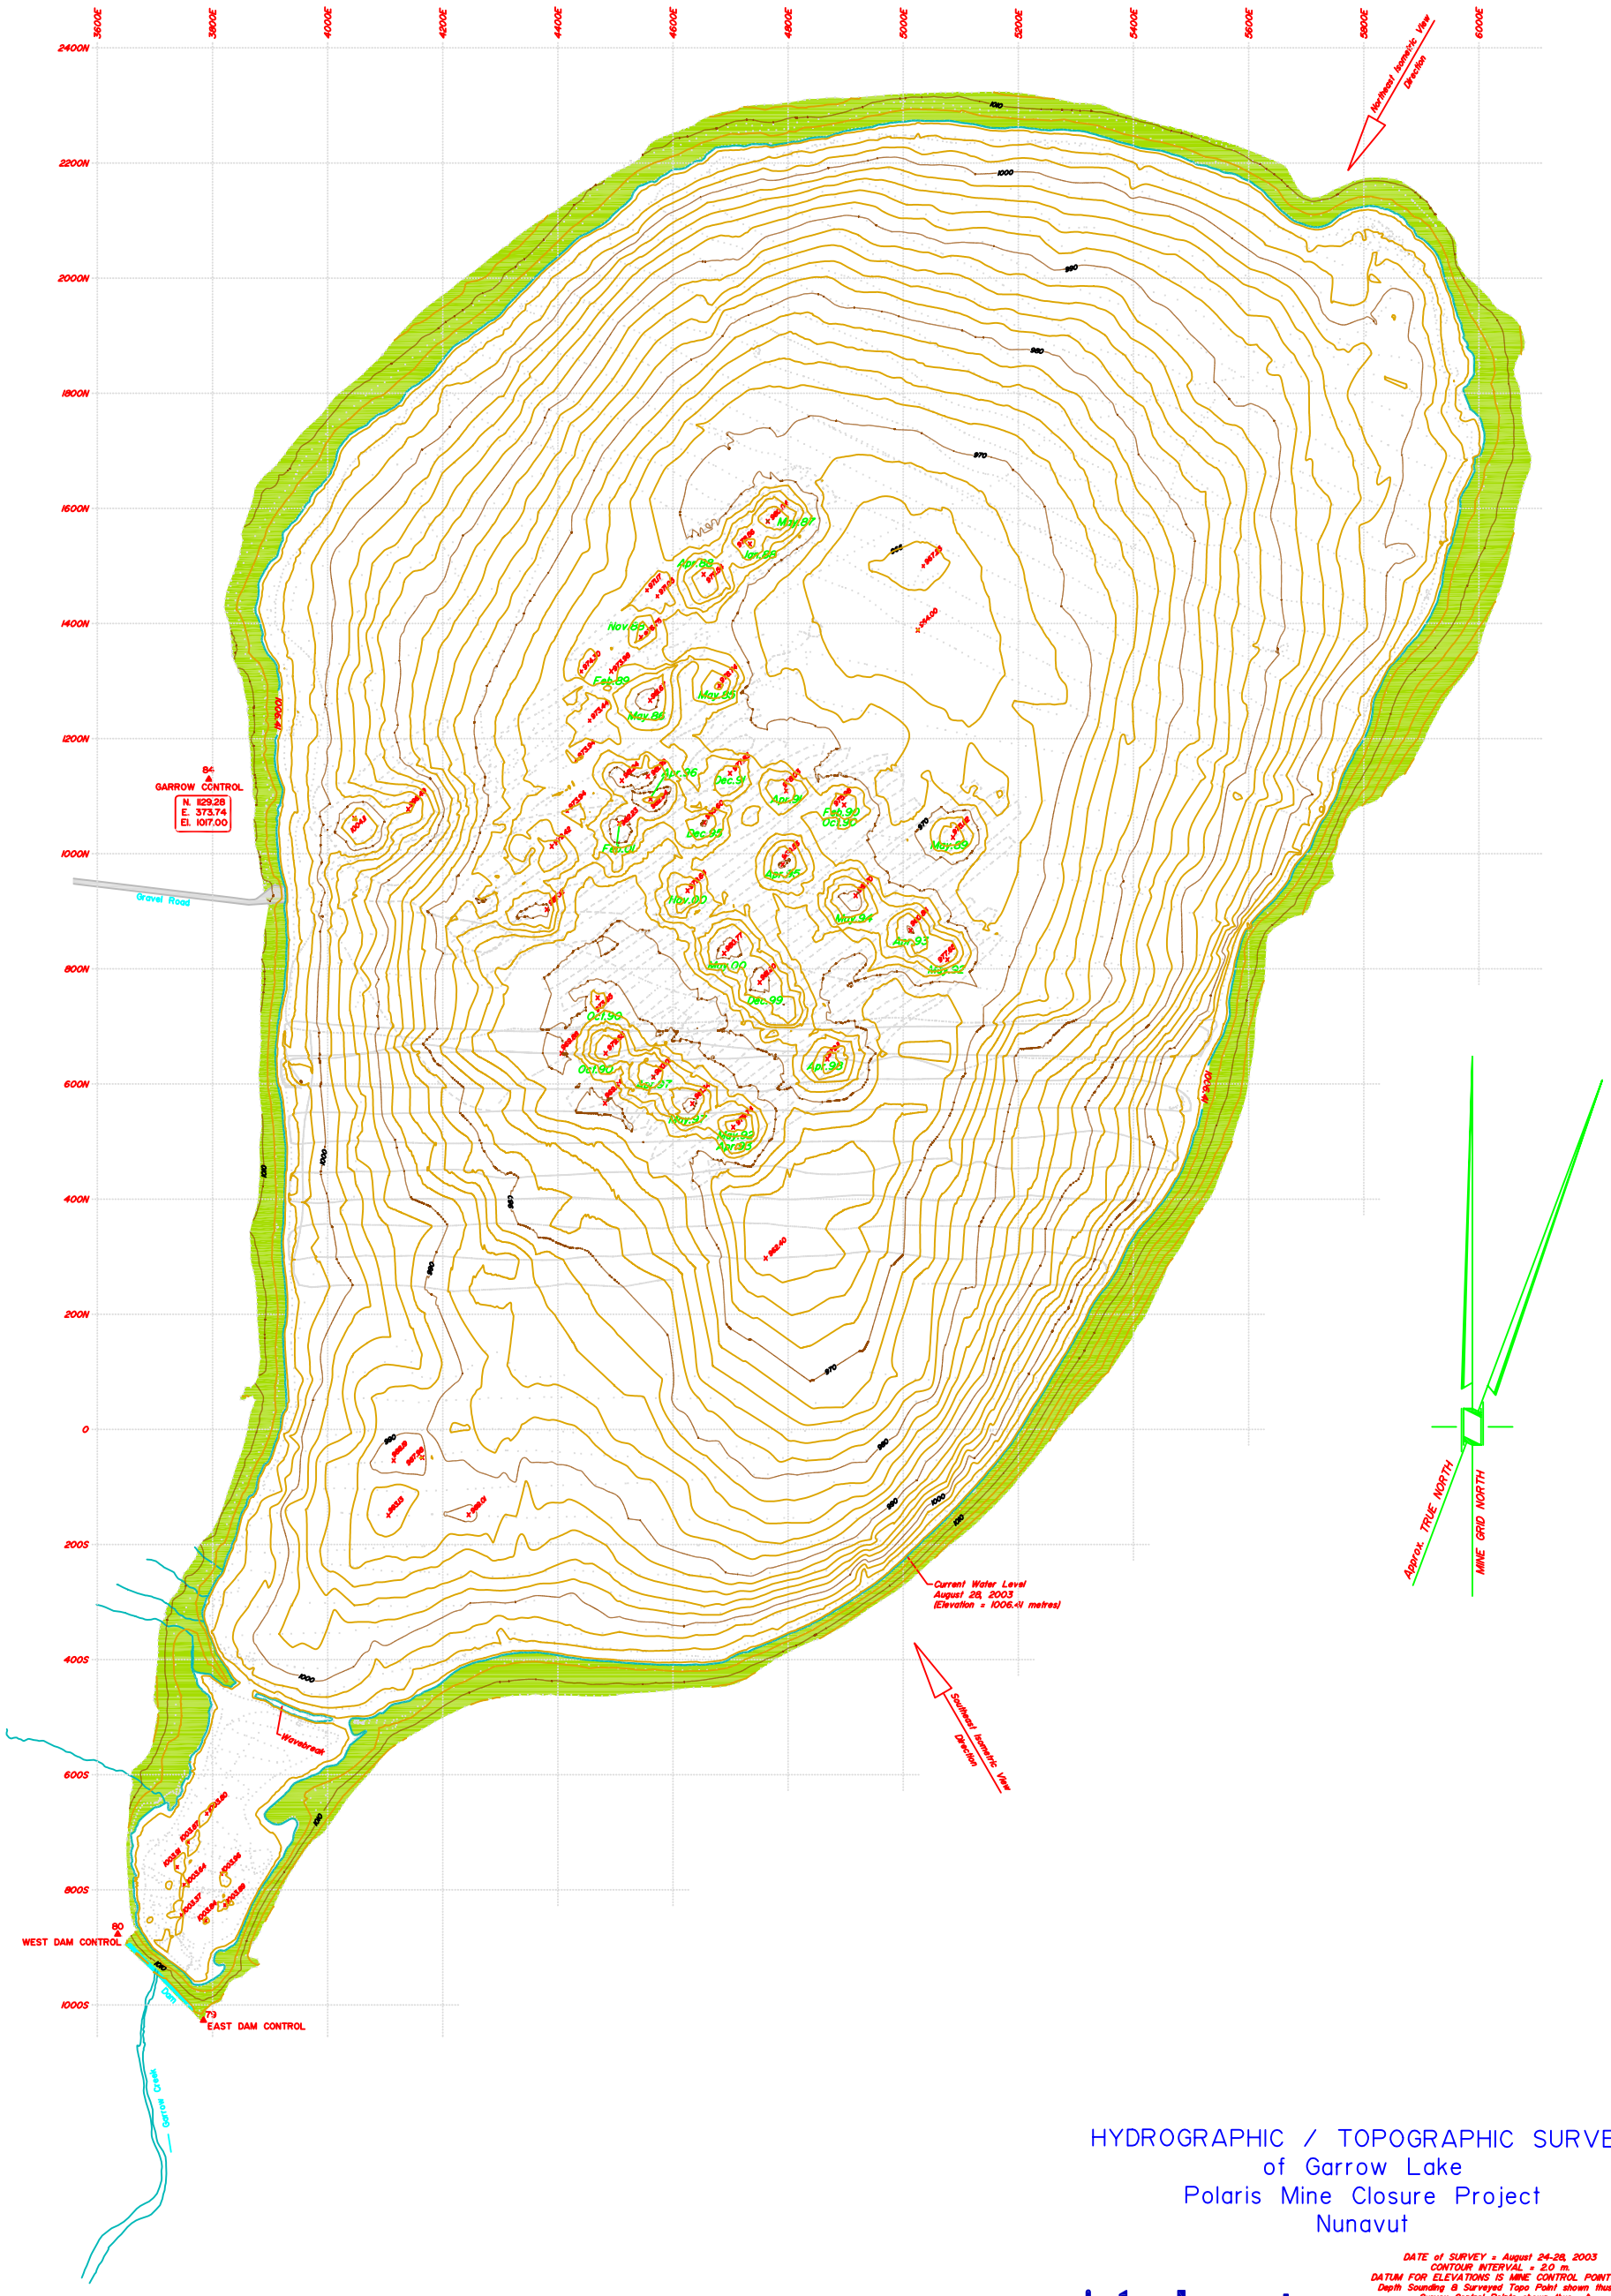

HYDROGRAPHIC / TOPOGRAPHIC SURVEY
of Garrow Lake
Polaris Mine Closure Project
Nunavut

DATE of SURVEY = August 24-28, 2003
CONTOUR INTERVAL = 2.0 m.
DATUM FOR ELEVATIONS IS MINE CONTROL POINT 84
Depth Sounding & Surveyed Topo Point shown thus.....
Survey Control Points shown thus..... ▲
Spot Elevation shown thus..... x (Typ.)
May.97 (typ.) indicates date of tailing pile derived from Teck Cominco records

This drawing is based on the Polaris Mine datum - Subtract 1000m from elevations to approximate geodetic elevation datum.

teckcominco

DATE	REVISIONS	DR/CK

FOCUS
Focus Surveys
A DIVISION OF THE FOCUS CORPORATION LTD.

Edmonton	(780) 466-6555
Calgary	(403) 269-2262
Grande Prairie	(780) 539-3222
Medicine Hat	(403) 527-3707
Regina	(306) 586-0837
Fort St.John	(250) 785-7776

Drawn by : KK	Chk'd by : MT
Date : October 16/03	Scale: 1:5000
Job : 322789-00	FILE No.
Dwg : 322789-00-TP2-0	