


Appendix A – Arial Photo and Drawings



Google earth



NOTES

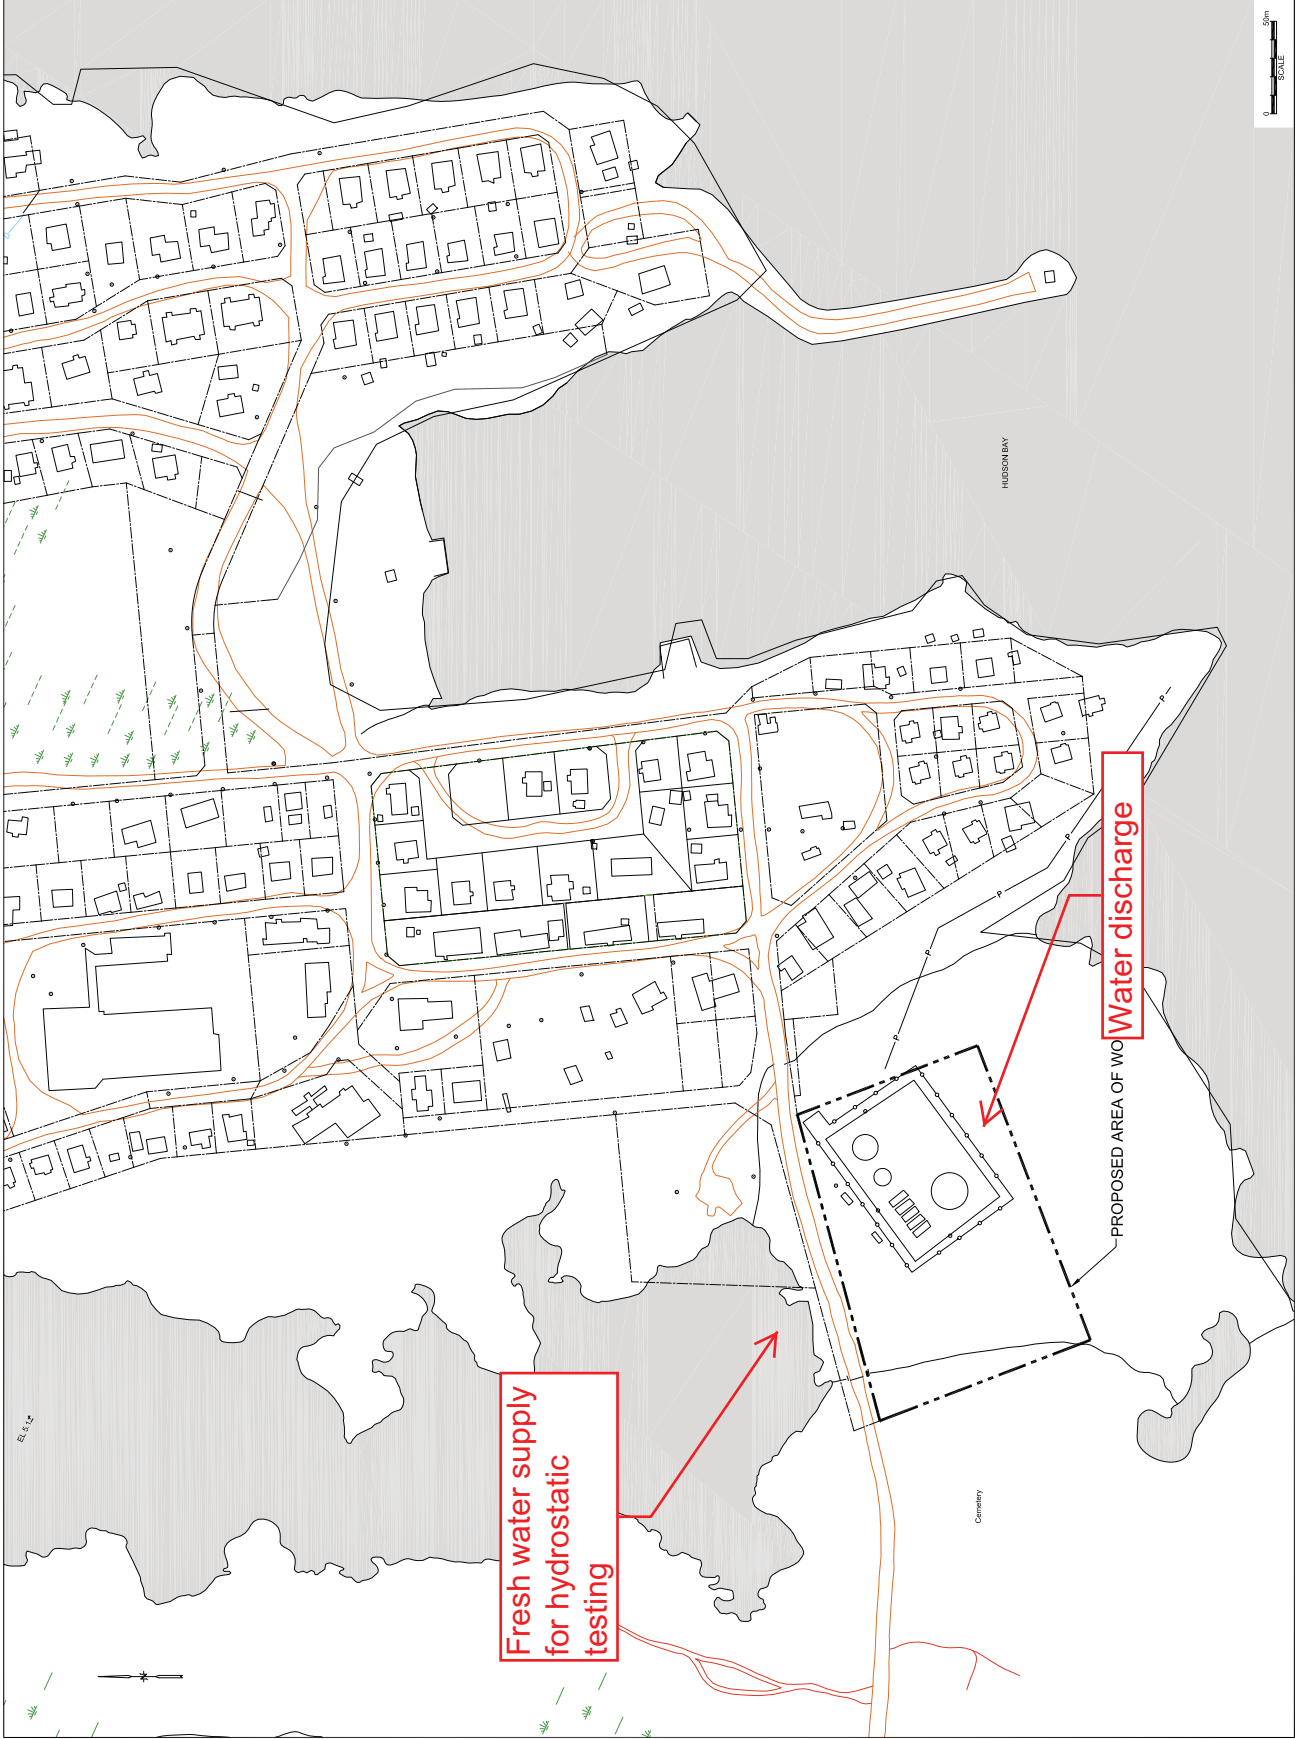

STAMP		STAMP	
ISSUED FOR TENDER		FEB 2013	
100% DESIGN ISSUED FOR REVIEW		SEPT 2012	
90% DESIGN ISSUED FOR REVIEW		JULY 2012	
APPROVAL		DATE	
DETAILS		DATE	
REVISIONS		DATE	
COASTLINE INFORMATION		AUG 2008	
DESCRIPTION		DATE	
REFERENCES		DATE	
PROJECT: CORAL HARBOUR FUEL STORAGE UPGRADES		DATE	
SITE ADDRESS: CORAL HARBOUR, NUNAVUT		DATE	
CLIENT: DEPARTMENT OF COMMUNITY GOVERNMENT SERVICES, GOVERNMENT OF NUNAVUT		DATE	
JOB No.: 122514827		DATE: 10/03/11	
DRAWN BY: MDC		APPROVED BY: BF	
DRAWING TITLE: MAIN SITE STORAGE FACILITY OVERALL SITE PLAN		DATE: 10/03/11	

01 C






STAMP

[illegible]

NOTES

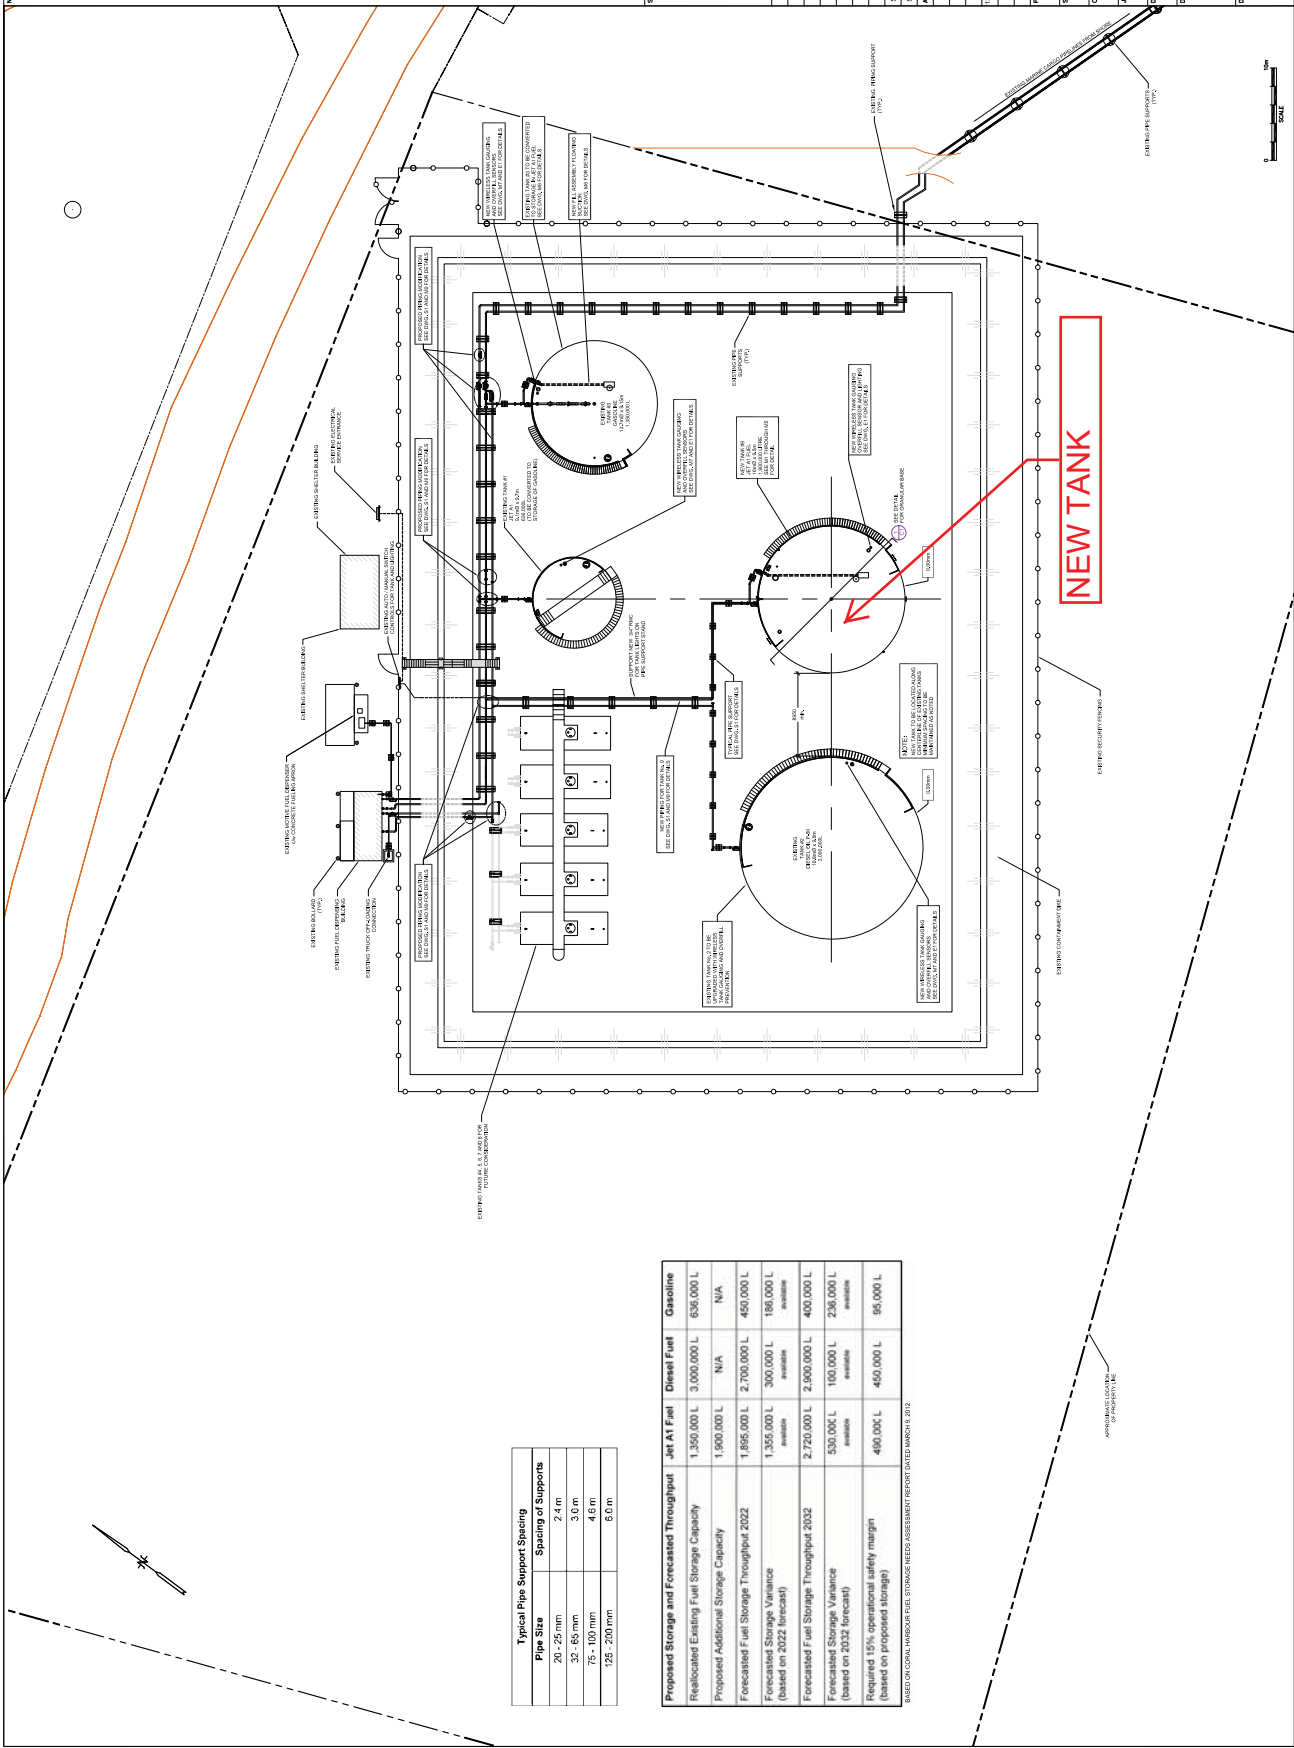

Typical Pipe Support Spacing	
Pipe Size	Spacing of Supports
20 - 25 mm	2.4 m
32 - 65 mm	3.0 m
75 - 100 mm	4.6 m
125 - 200 mm	6.0 m

Proposed Storage and Forecasted Throughput	Jet A1 Fuel	Diesel Fuel	Gasoline
Reallocated Existing Fuel Storage Capacity	1,350,000 L	3,000,000 L	636,000 L
Proposed Additional Storage Capacity	1,900,000 L	N/A	N/A
Forecasted Fuel Storage Throughput 2022	1,895,000 L	2,700,000 L	450,000 L
Forecasted Storage Variance (based on 2022 forecast)	1,355,000 L	300,000 L	186,000 L
Forecasted Storage Variance (based on 2032 forecast)	530,000 L	100,000 L	236,000 L

BASED ON CORAL HARBOUR FUEL STORAGE NEEDS ASSESSMENT REPORT DATED MARCH 10, 2012

STAMP	STAMP
ISSUED FOR TENDER	FEB 2013
100% DESIGN FOR REVIEW	SEPT 2012
90% DESIGN FOR REVIEW	JULY 2012
APPROVAL	DATE
REVISIONS	
NEW STORAGE OPTION #2	JAN 2012
DESCRIPTION	
DATE	
PROJECT	CORAL HARBOUR FUEL STORAGE UPGRADES
SITE ADDRESS	CORAL HARBOUR, NUNAVUT
CLIENT	DEPARTMENT OF COMMUNITY DEVELOPMENT SERVICES, GOVERNMENT OF NUNAVUT
JOB No.	122514887
SCALE	1:500
DATE	10/03/11
DESIGNED BY	SDC
APPROVED BY	BP
DRAWING TITLE	MAIN SITE STORAGE FACILITY PROPOSED SITE PLAN
DRAWING No.	03
REGION No.	C